
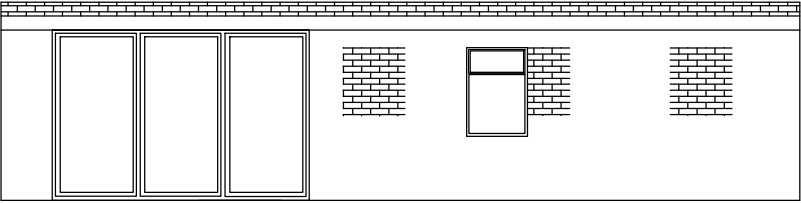 

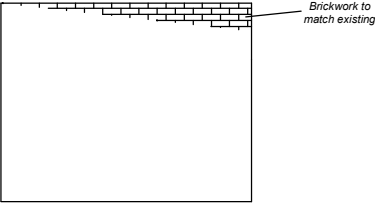


REV/NOTES:

Where building to the boundaries the adjacent owner is to be informed under the terms of the Party Wall Act 1996 and its provisions followed. Where building over boundaries the adjacent owner is to be served notice under section 65 of the Town & Country Planning Act 1990.

©This drawing and the works depicted are the copyright of ASB Property Consultants LTD and may not be reproduced or amended except by written permission of ASB Property Consultants LTD

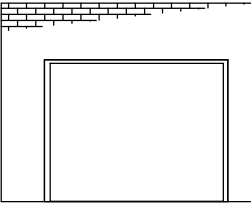

AS BUILT FRONT / REAR & SIDE ELEVATIONS
Scale 1:100

Application: HPA – Increase in height of existing outbuilding			
Client:	Mr Ricardo Martins	Date:	20 th Oct 2022
Site:	22 Dellfield Crescent Uxbridge, UB8 2ET	Drawn By:	Gurps Benning
Scale:	Refer to Drawing @ A3	Dwg.No:	ASB787 – 05HPA

ASB PROPERTY CONSULTANTS LTD
Planning consultants and Surveyors

Unit 1,
Gethclen House,
Dawley Road
Hayes, UB3 1EH

Tel : 07854 351 934 – 0208 212 7981
Email : asbpropertyconsultantsltd@hotmail.com

Copyright © 2022 ASB PROPERTY CONSULTANTS LTD
(All rights reserved)