





AS CONSTRUCTED PLANS AND ELEVATIONS

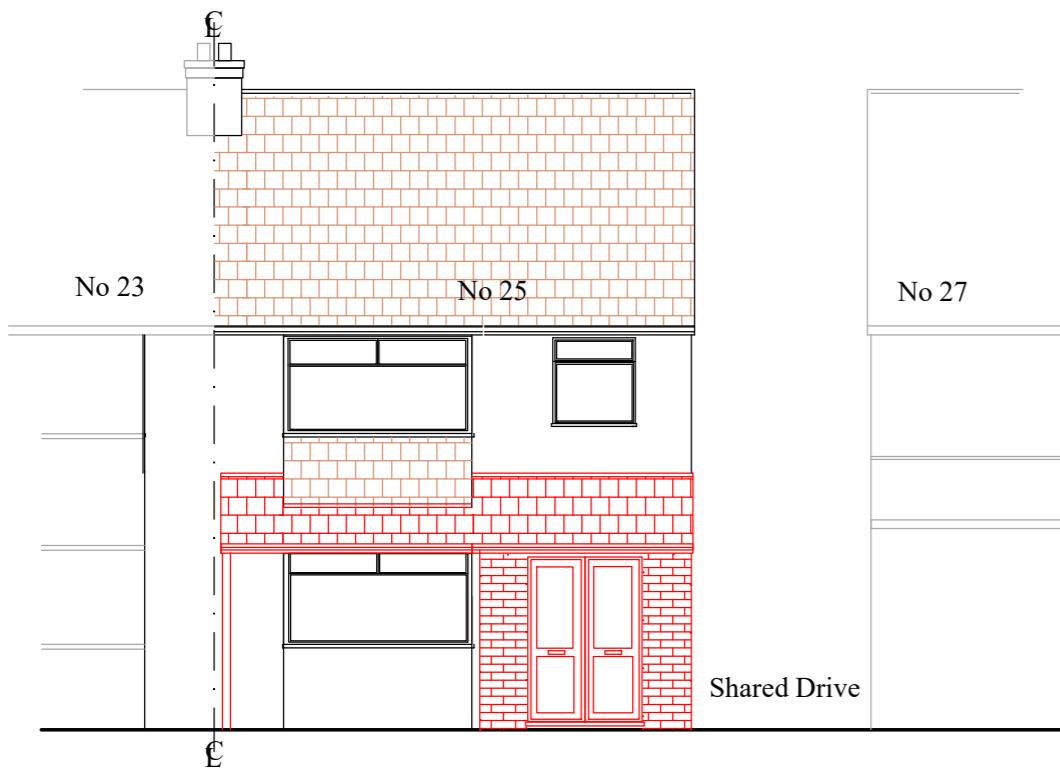


PROPOSED FRONT ELEVATION

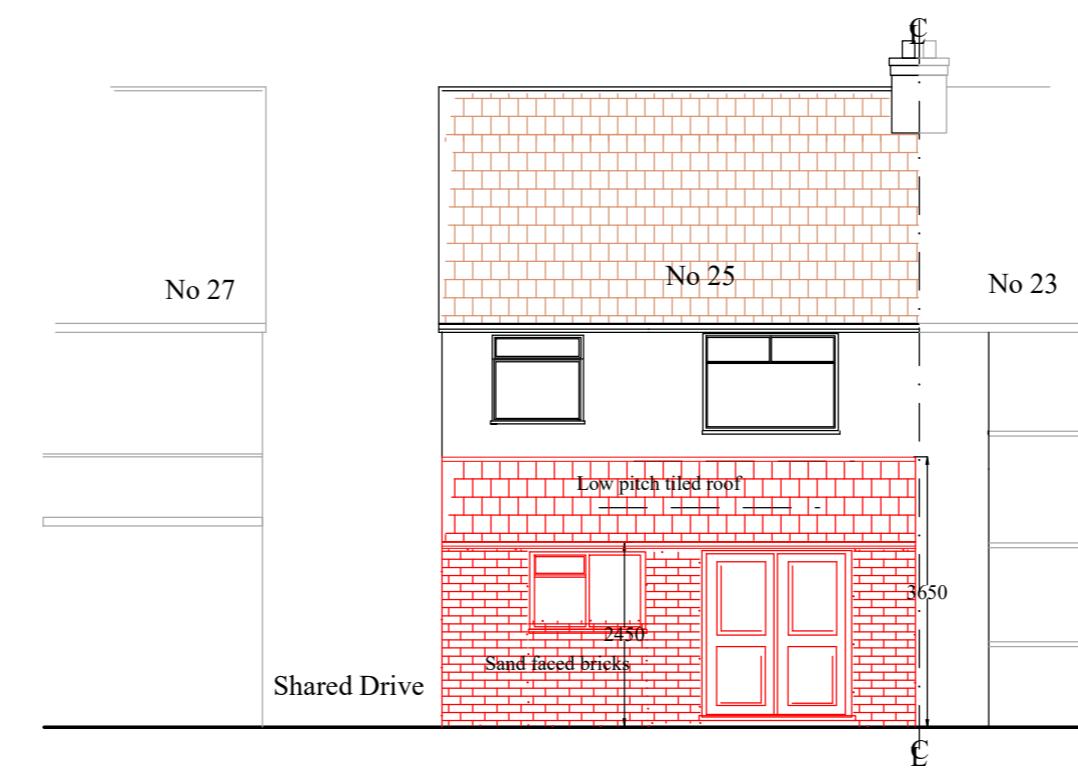


PROPOSED REAR ELEVATION

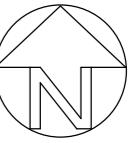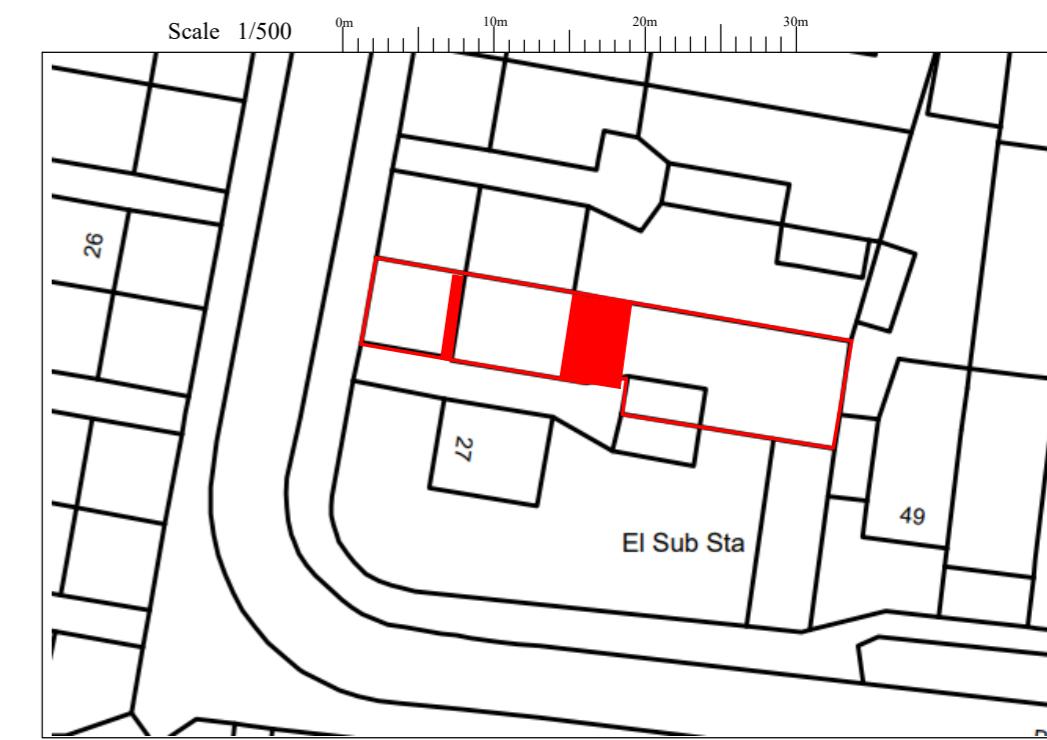


BLOCK PLAN

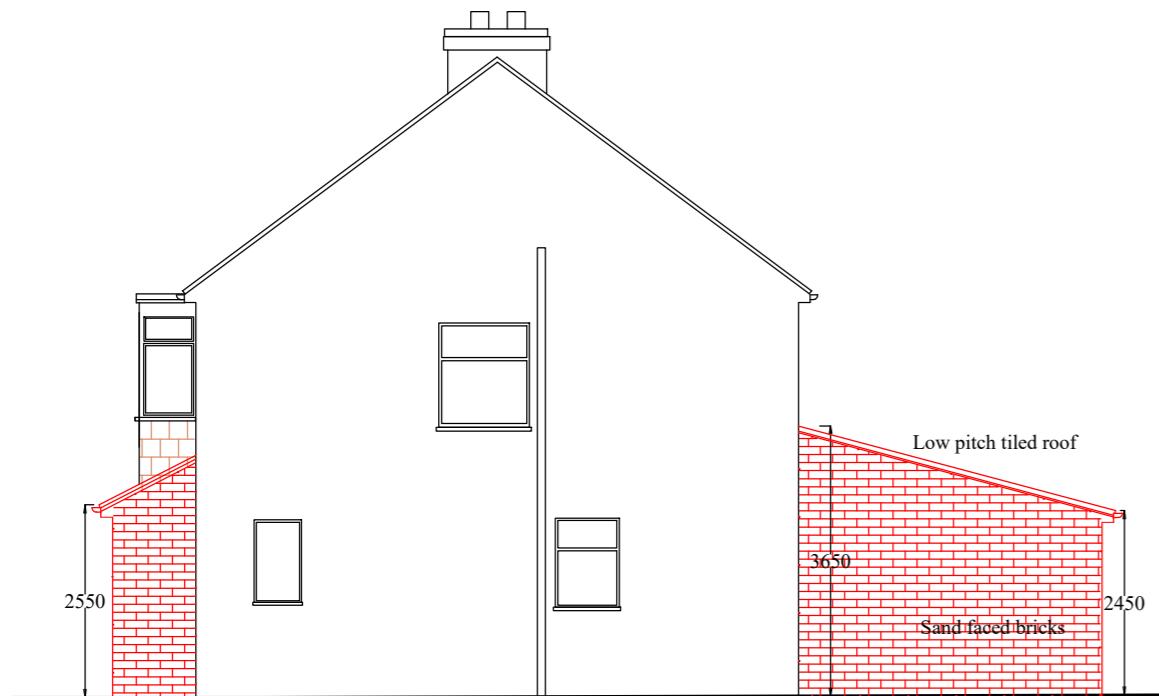


PROPOSED SIDE ELEVATION

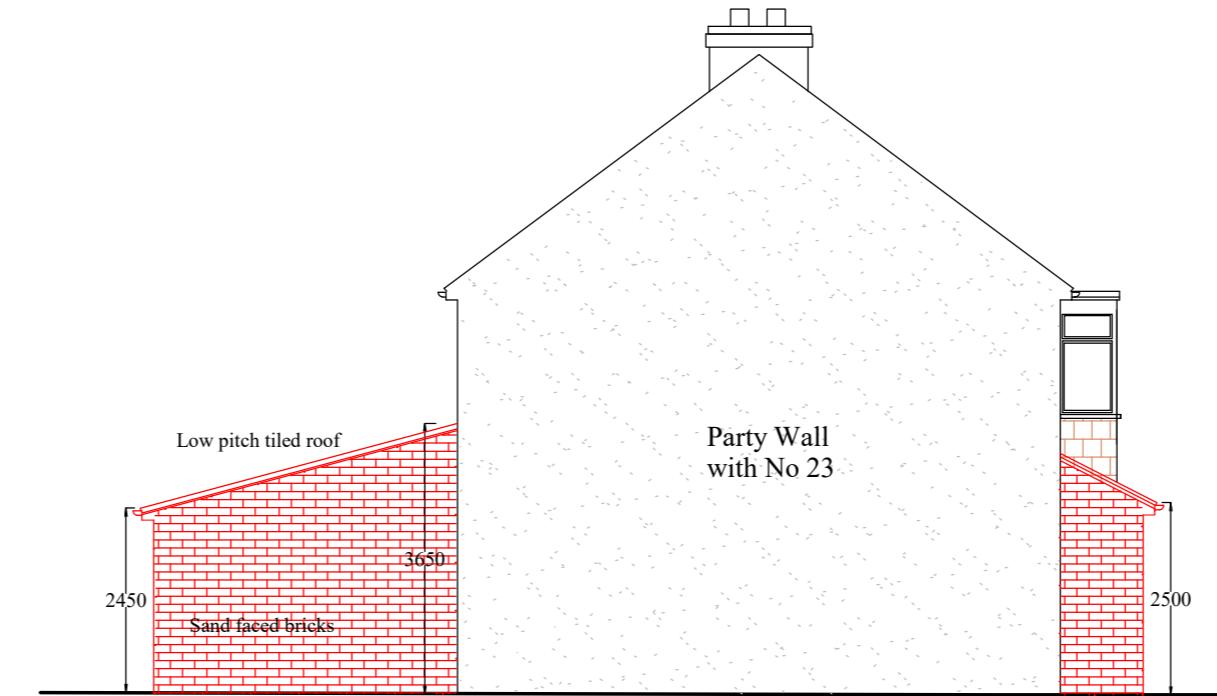


PROPOSED SIDE ELEVATION

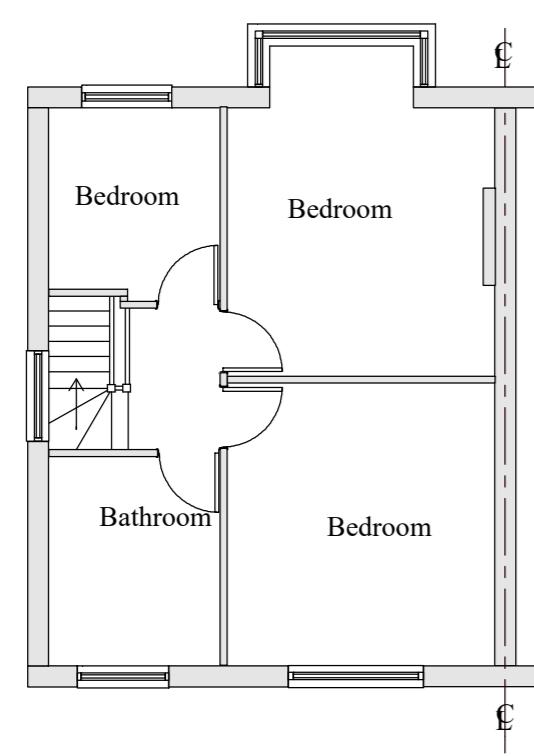


EXISTING FF PLAN

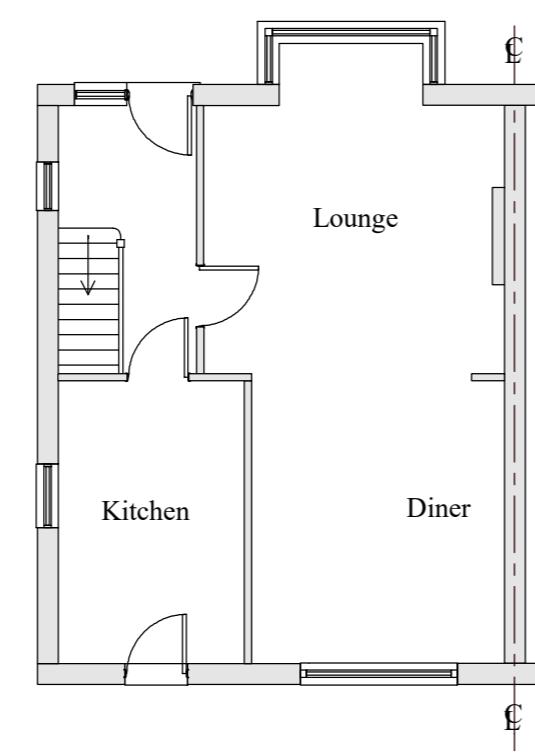

EXISTING GF PLAN

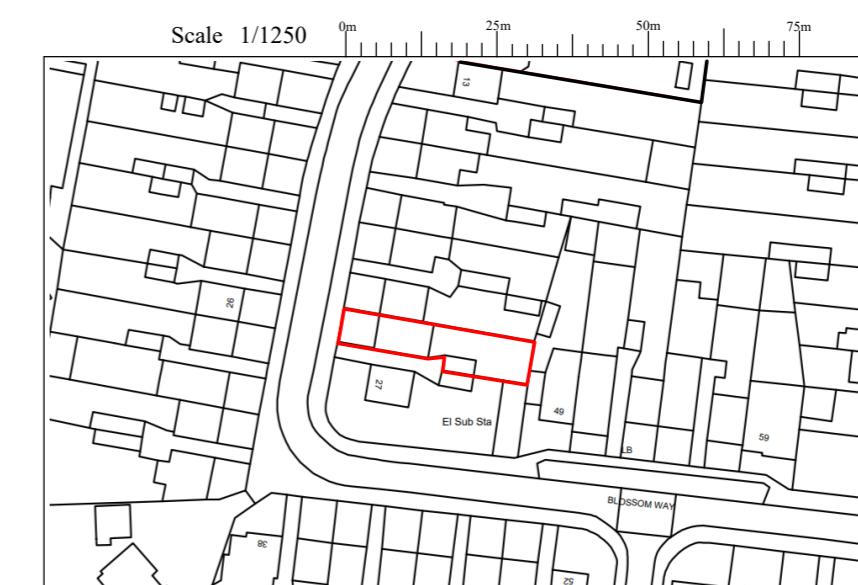

LOCATION PLAN 1/1250

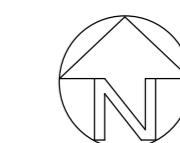

Notes:	1 Refer Drawing No B2501 for Notes	
Revision	Description	Date
Project:	25 Blossom Way, West Drayton, UB7 9HF	
Project Title:	Single Storey Rear Extension	
Drawing No:	B2501	Revision:
Date:	Nov 2022	Drawn by: AS
Scale:	1/100 @A2	Chkd by: MK