
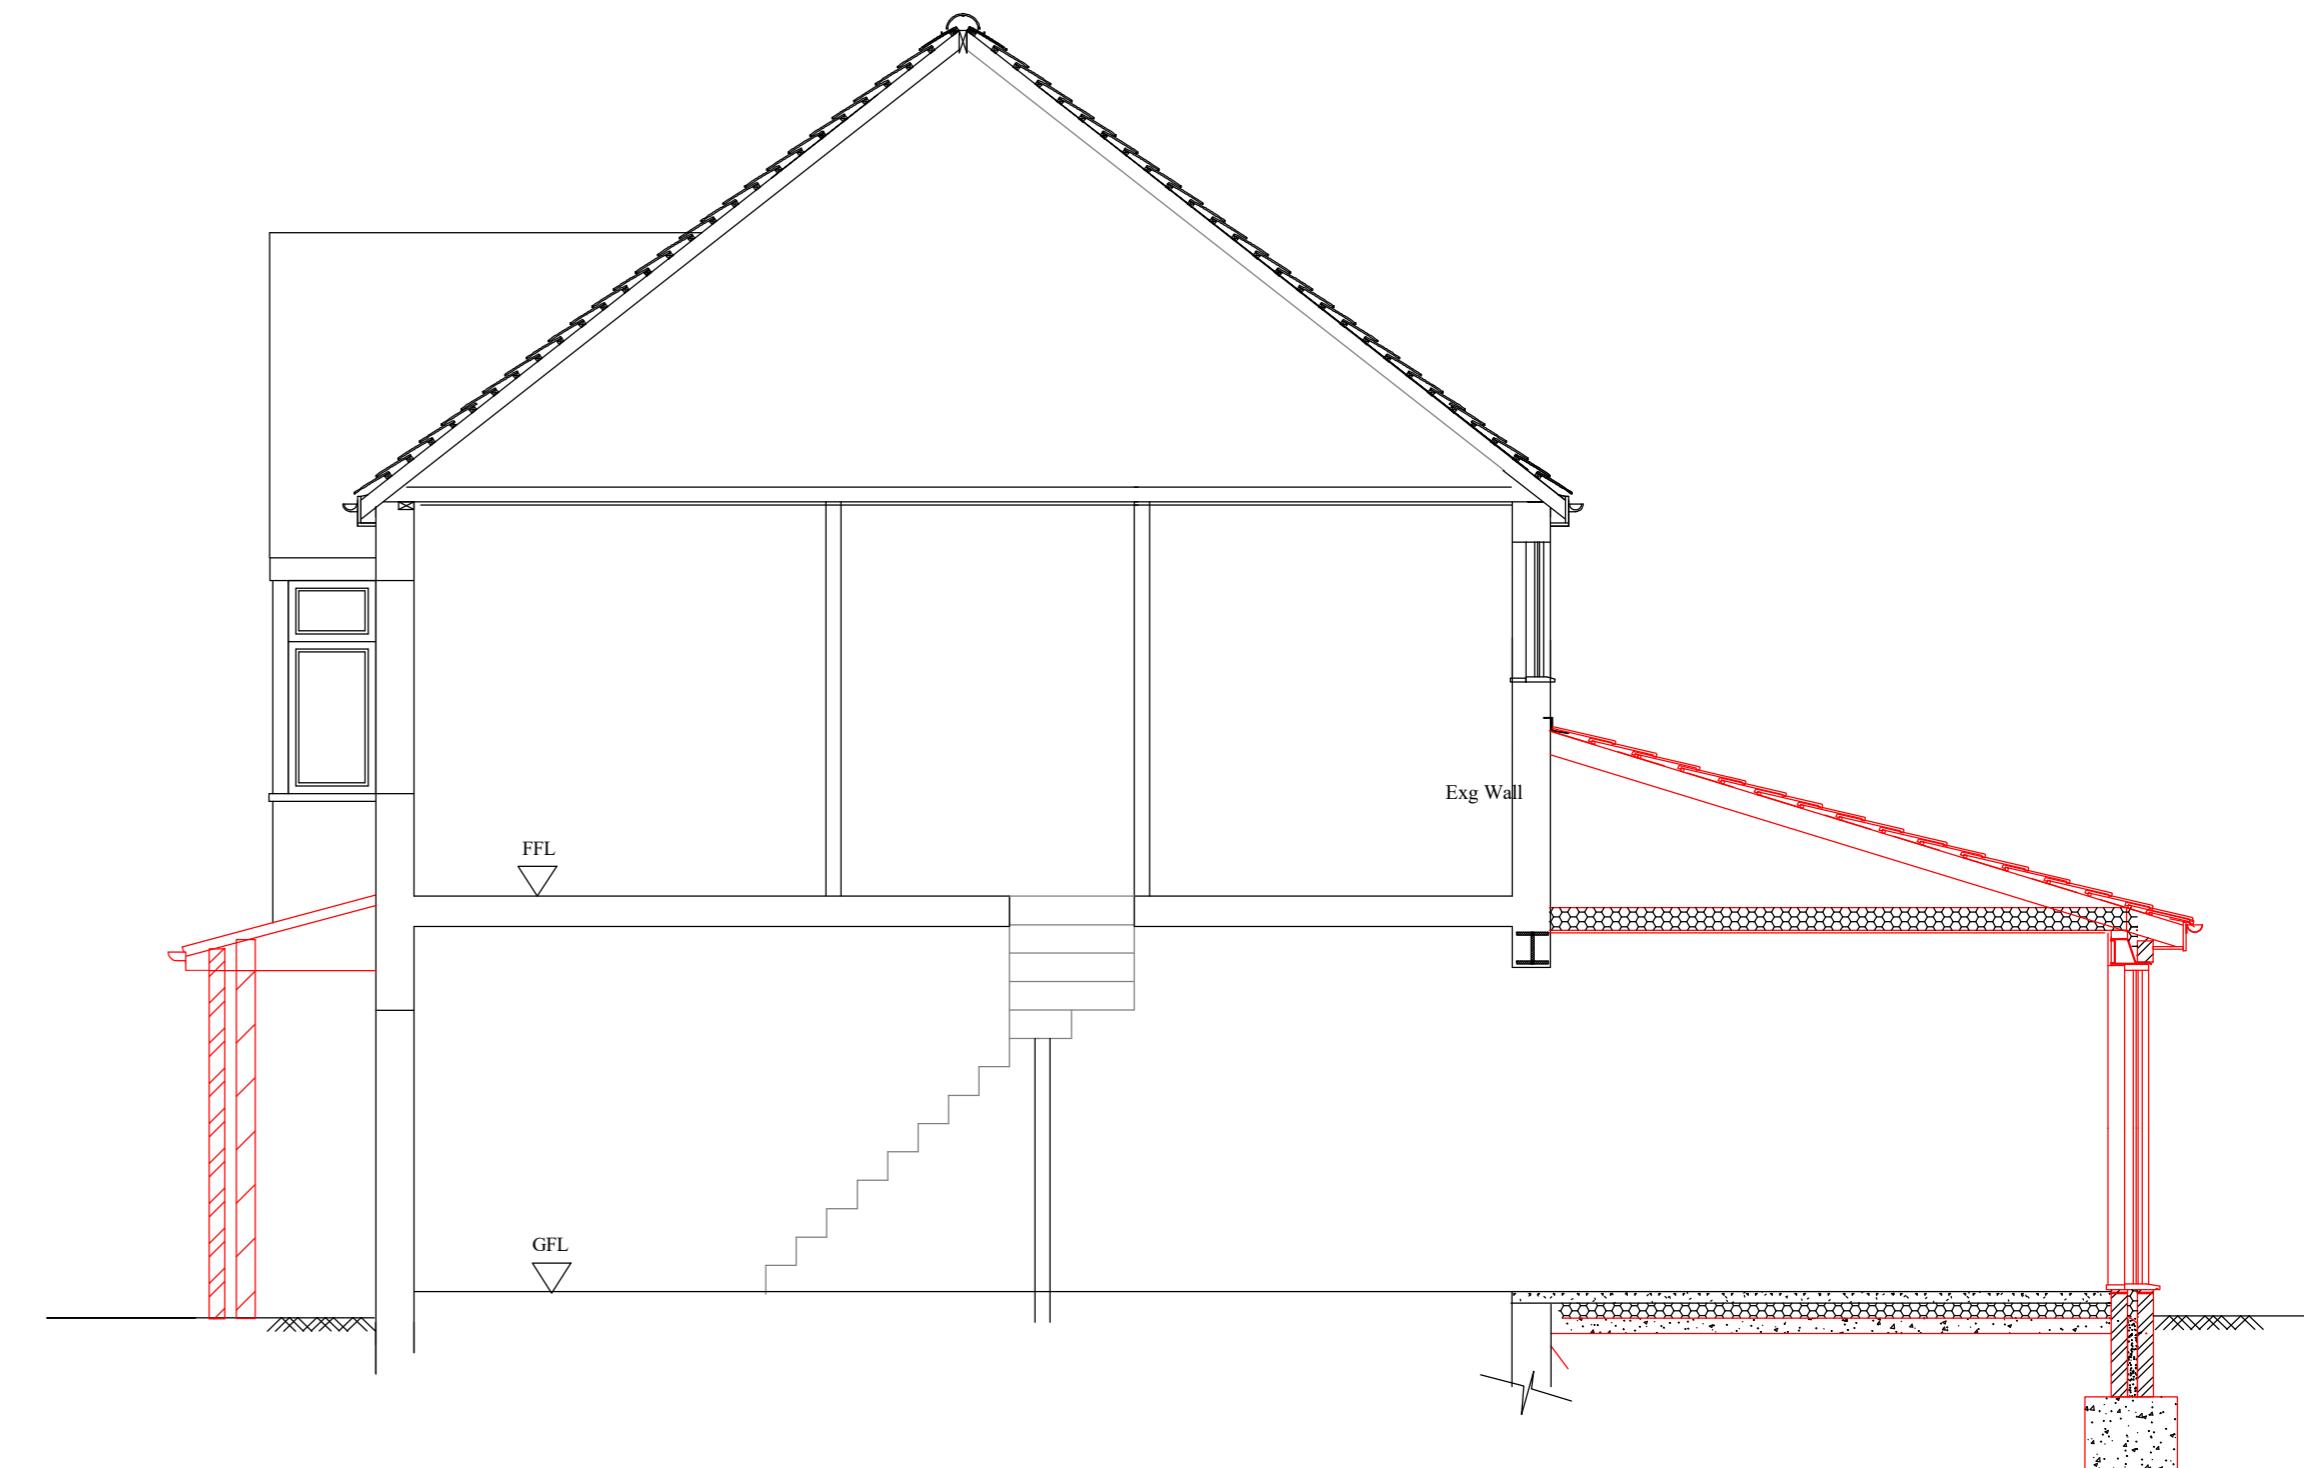


AS CONSTRUCTED PLANS AND ELEVATIONS

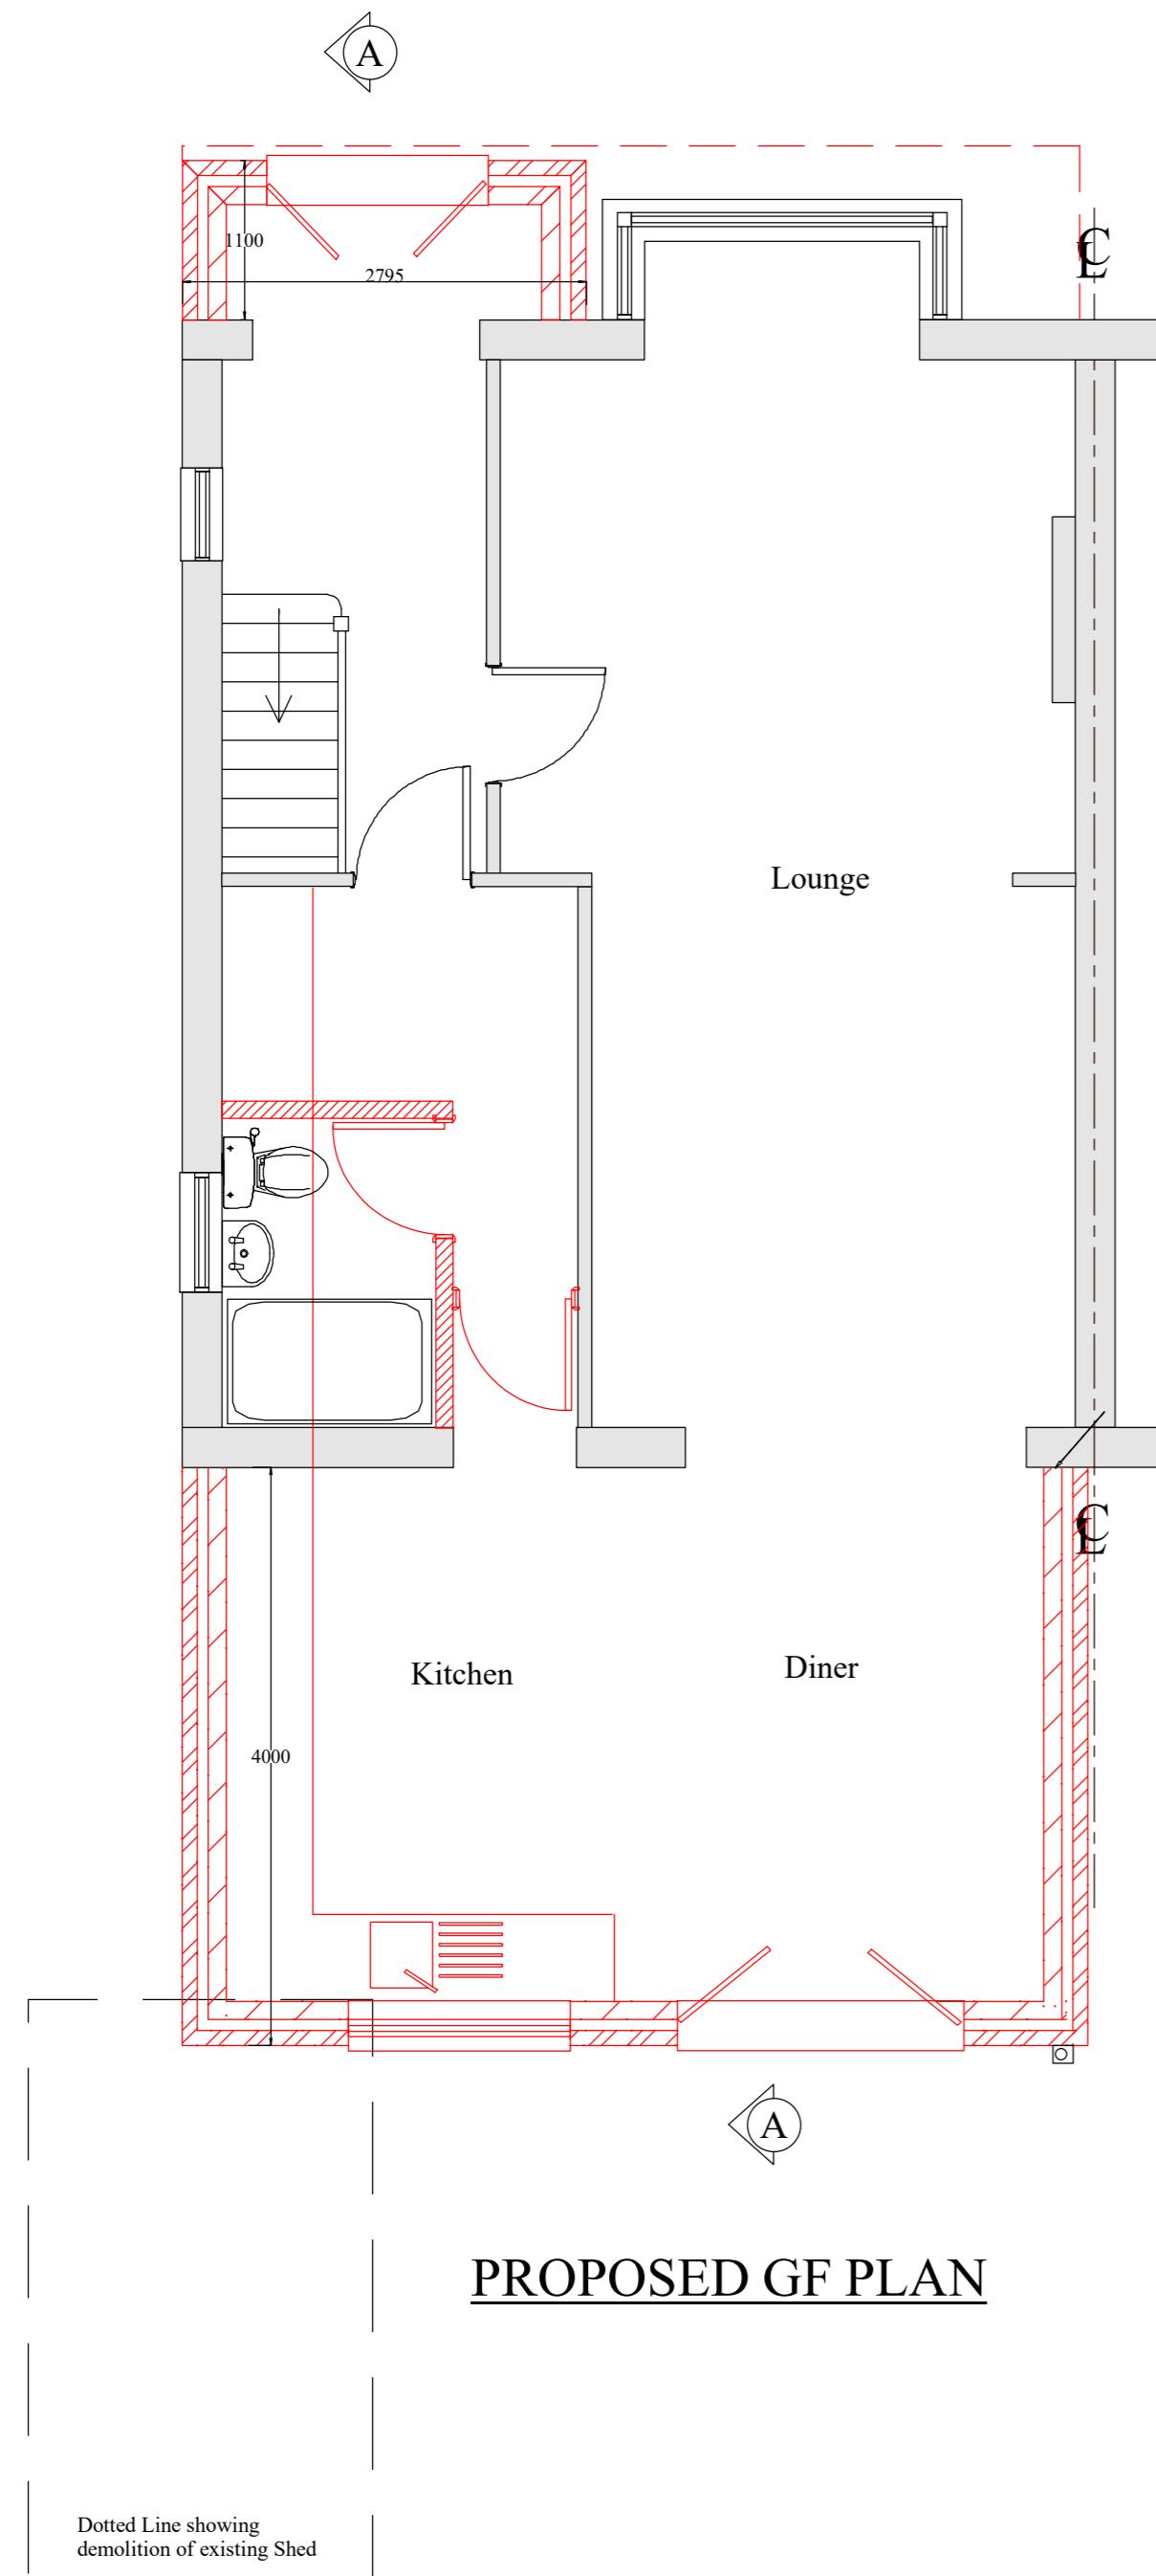

Notes:	1 Refer Drawing No B2501 for Notes	
Revision	Description	Date
Project:	25 Blossom Way, West Drayton, UB7 9HF	
Project Title:	Single Storey Rear Extension	
Drawing No:	B2502	Revision:
Date:	Nov 2022	Drawn by: AS
Scale:	1/50 @A2	Chkd by: MK