




SCALE 1:200 0 4M 8M 12M 16M 20M
 SCALE 1:500 0 10M 20M 30M 40M 50M
 SCALE 1:1250 0 25M 50M 75M 100M 125M

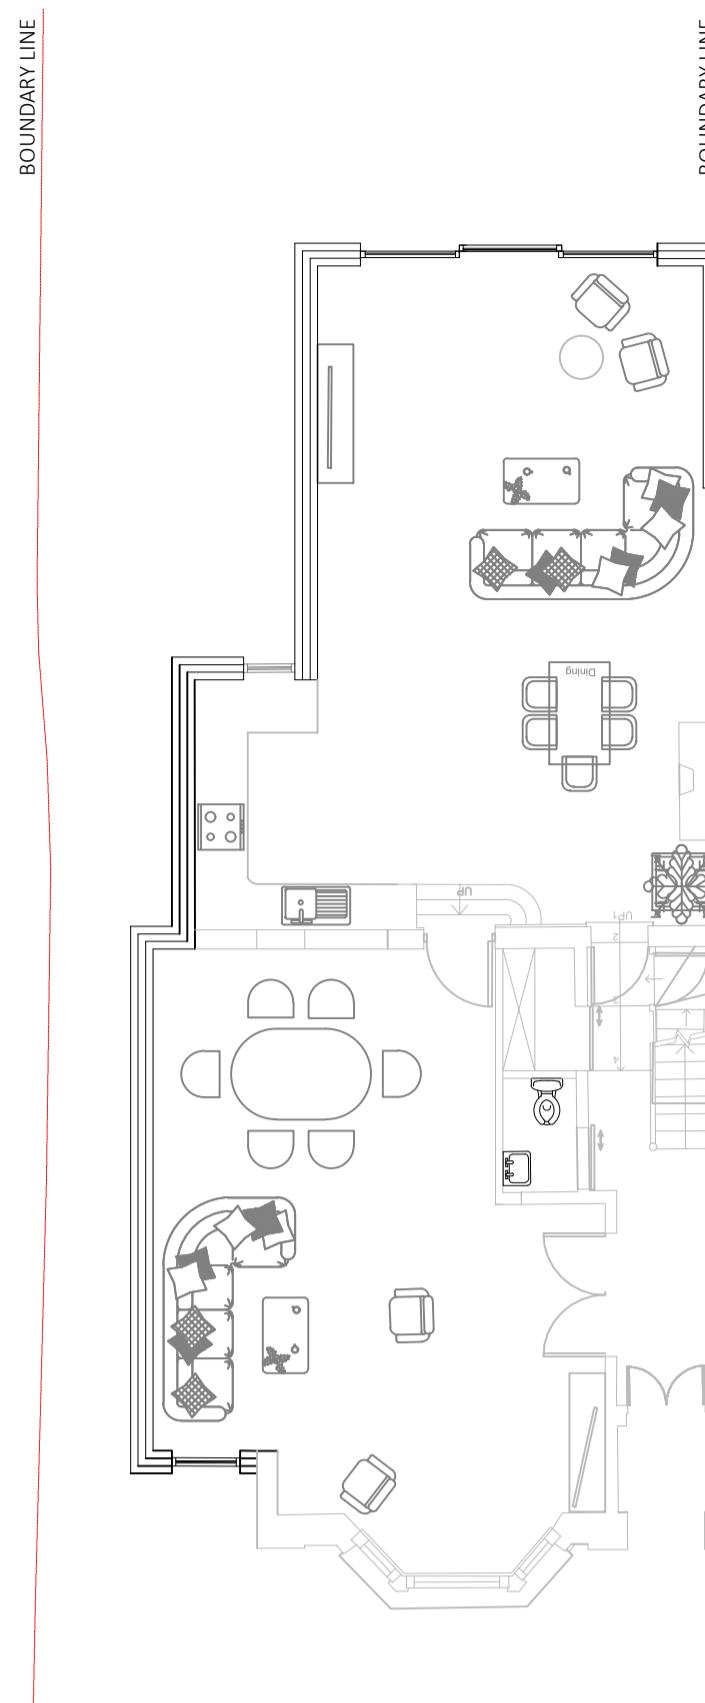


GROUND FLOOR - PREVIOUSLY APPROVED
(SCALE 1:100)

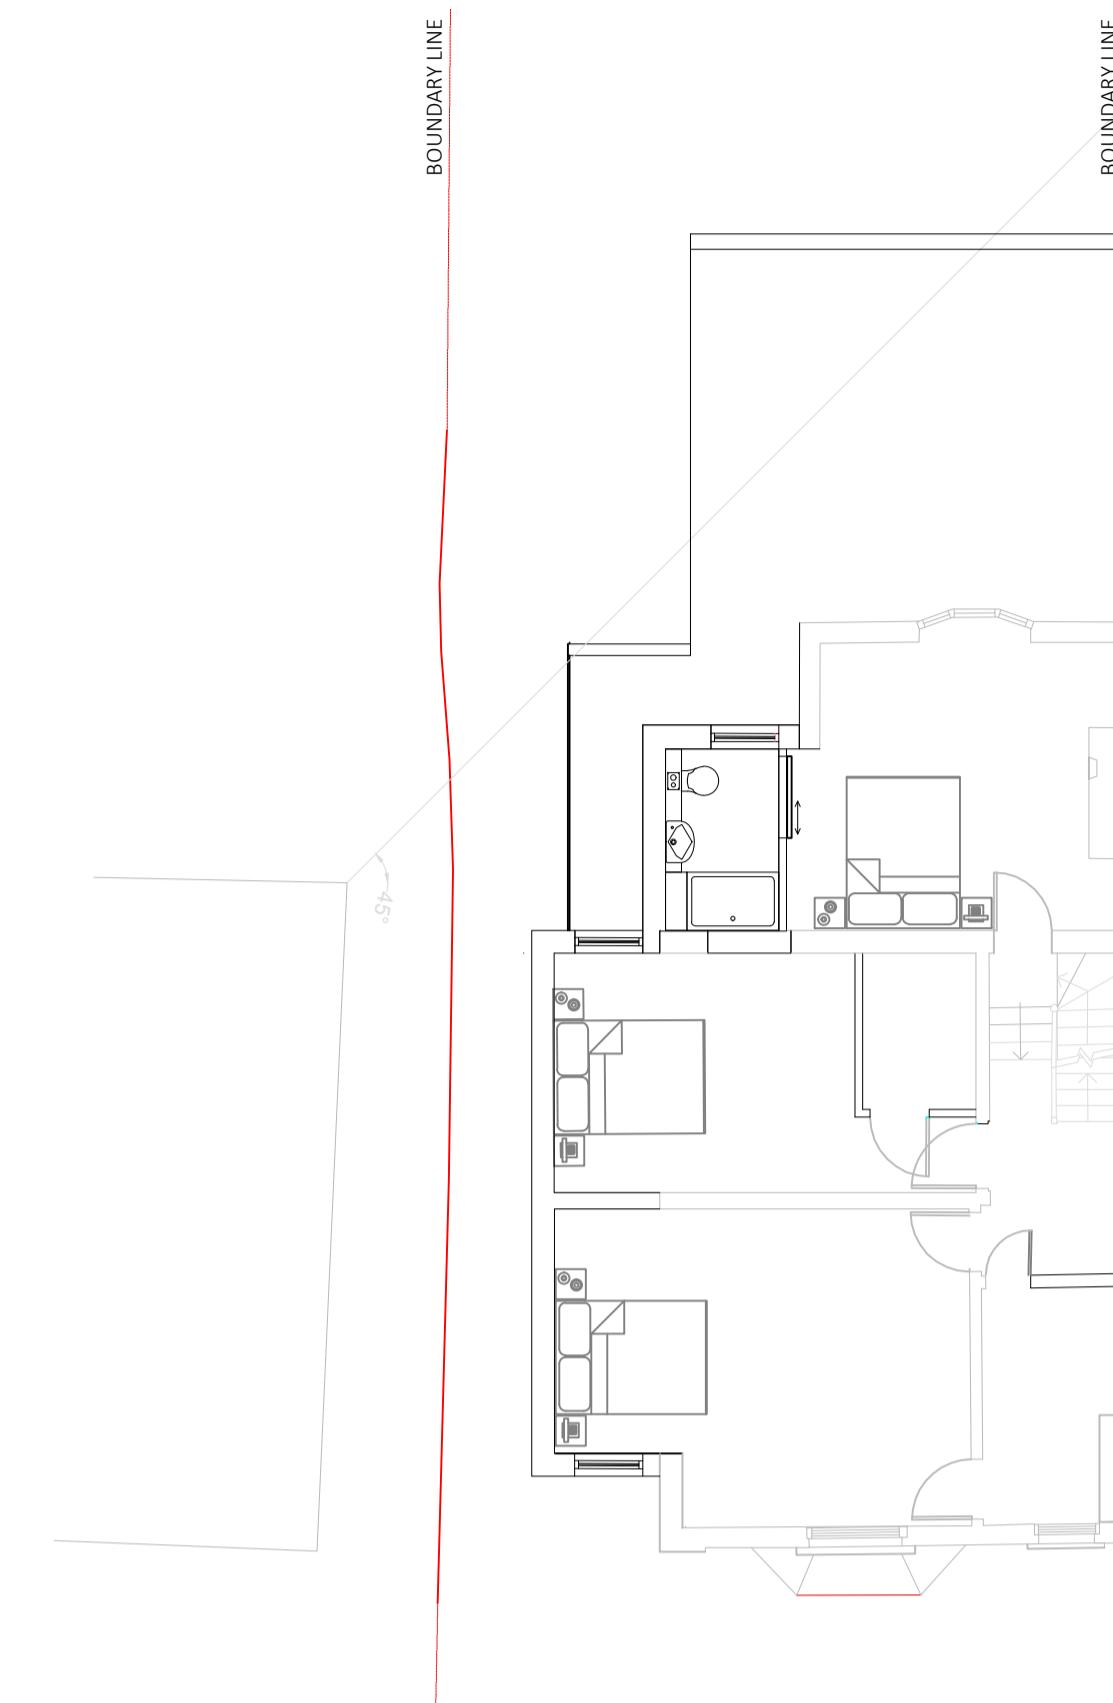

FIRST FLOOR PLAN - PREVIOUSLY APPROVED
(SCALE 1:100)

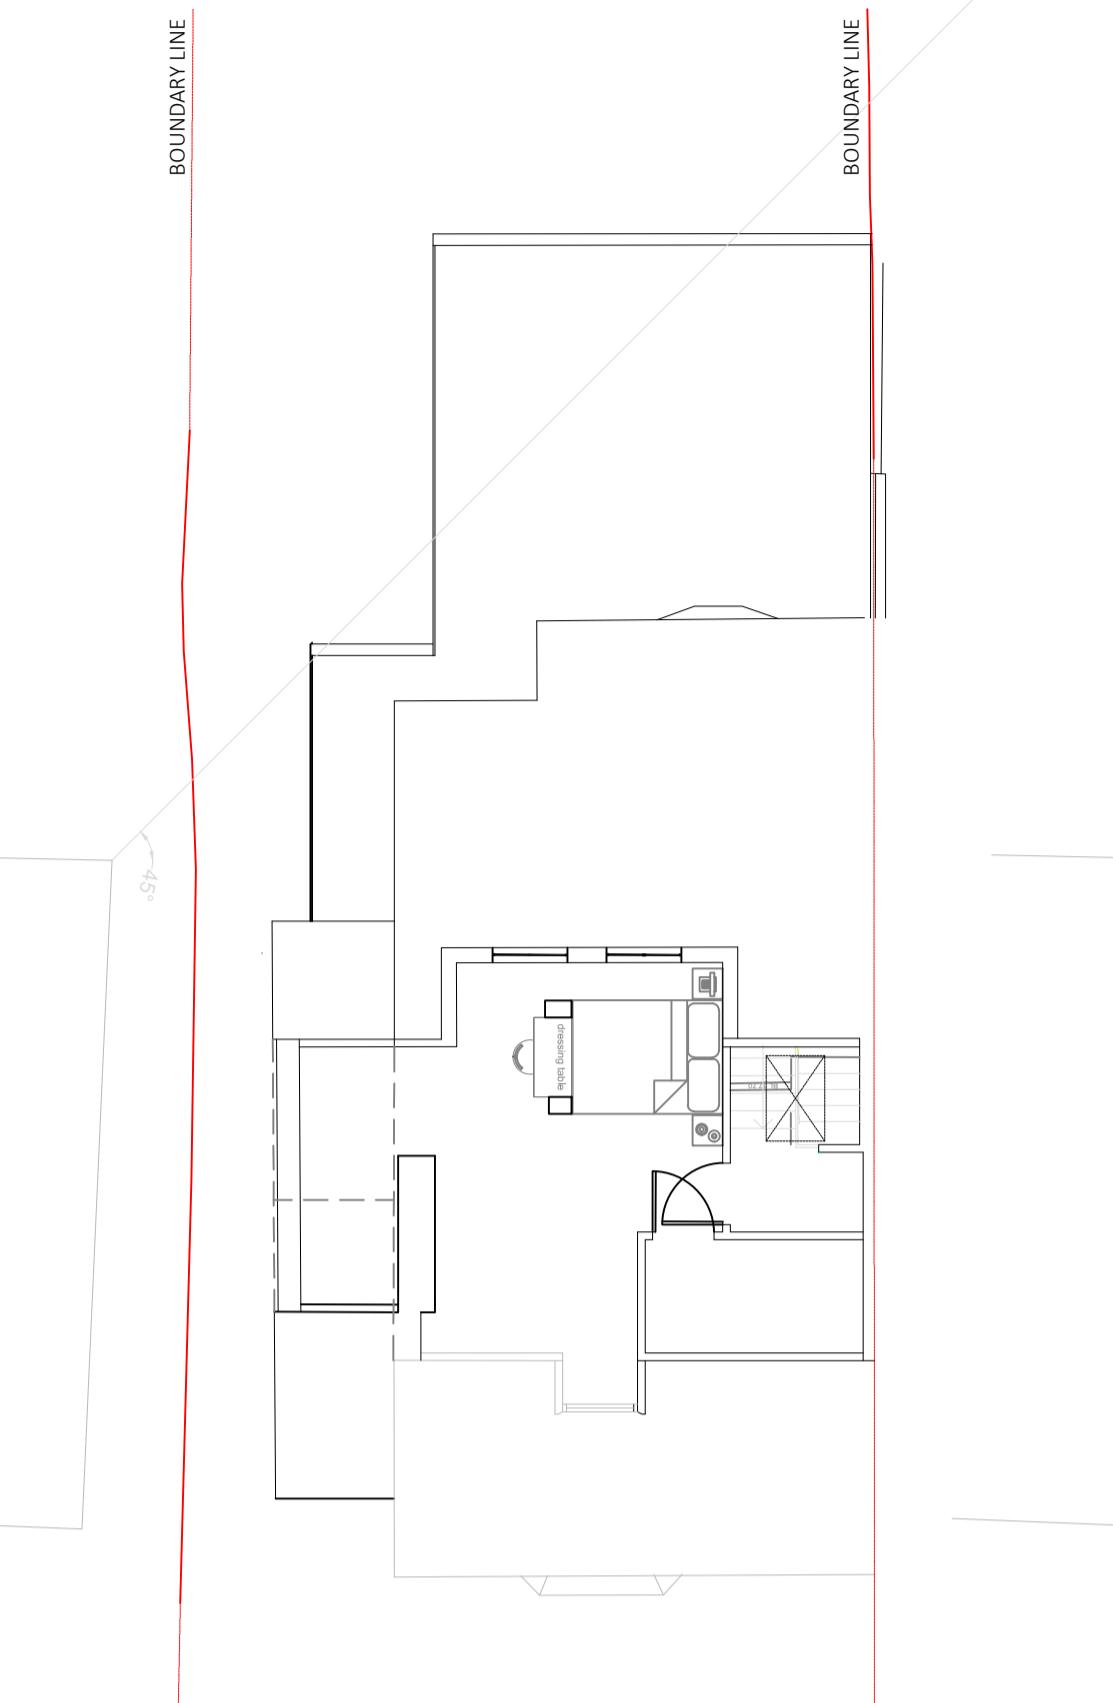

LOFT FLOOR - PREVIOUSLY APPROVED
(SCALE 1:100)

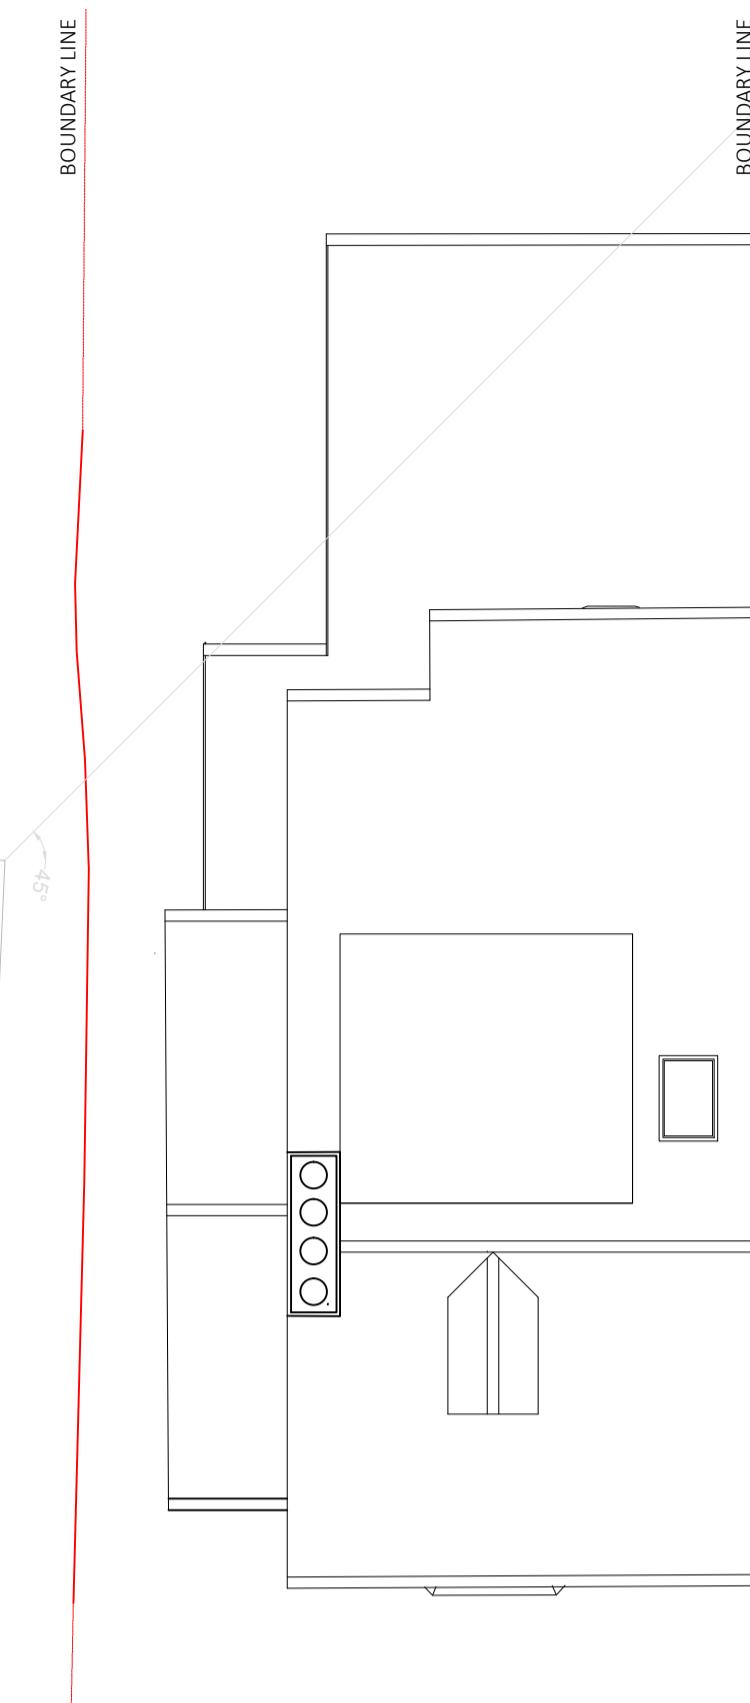

ROOF PLAN - PREVIOUSLY APPROVED
(SCALE 1:100)




LOCATION PLAN
(SCALE 1:1250)




FRONT ELEVATION - PREVIOUSLY APPROVED
(SCALE 1:100)



REAR ELEVATION - PREVIOUSLY APPROVED
(SCALE 1:100)

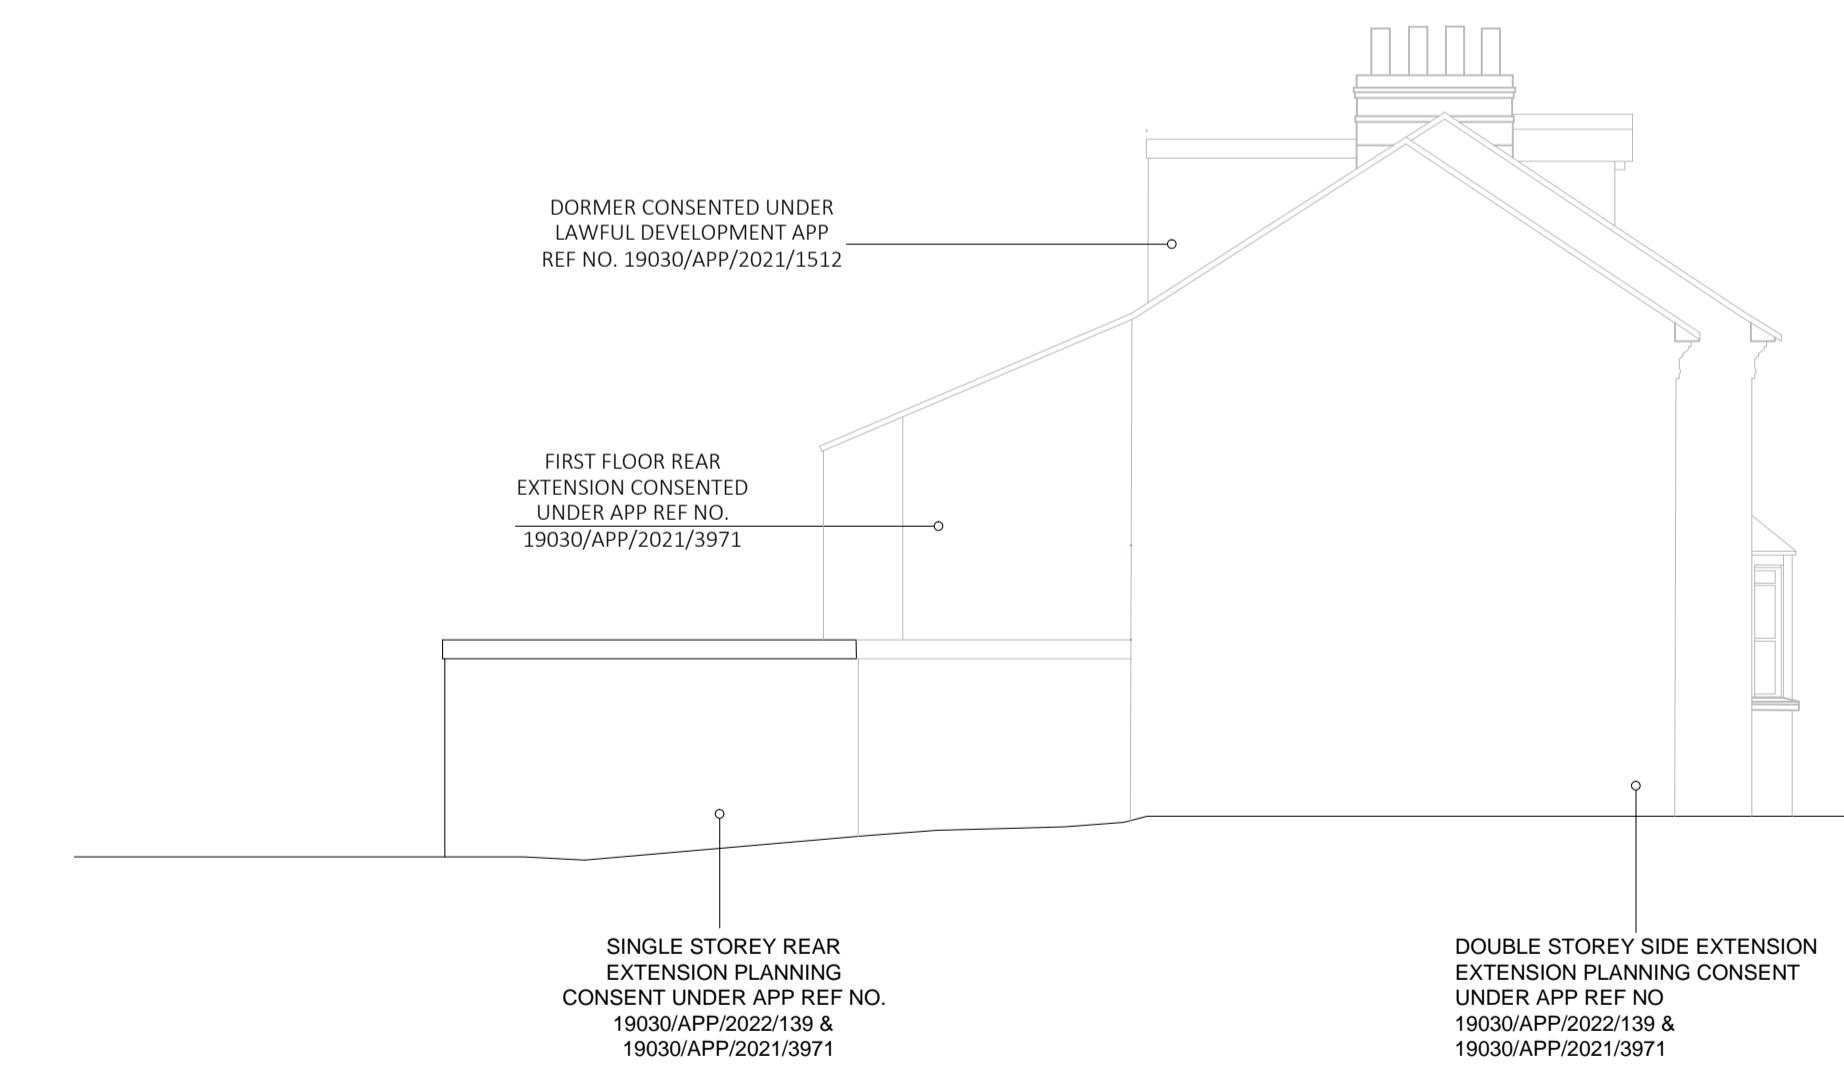

SIDE ELEVATION - PREVIOUSLY APPROVED
(SCALE 1:100)

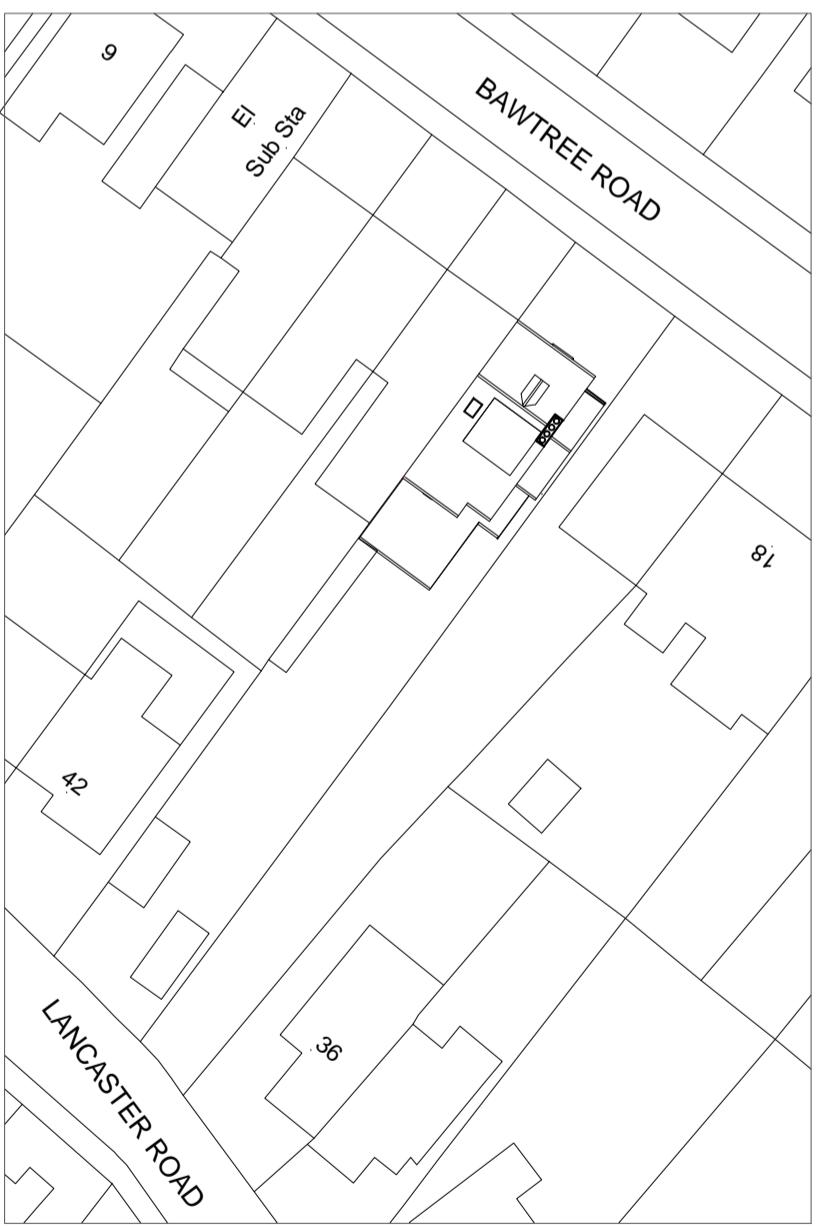

SITE PLAN AS BUILT
(SCALE 1:500)

NOT APPROVED FOR CONSTRUCTION

All measurements to be checked on site and not scaled from this drawing.
 All works to the satisfaction of local authority inspector.
 No deviation from these drawing what so ever.

DESCRIPTION
 PREVIOUSLY APPROVED PLANS AND ELEVATIONS

PLANNING REFERENCES
 19030/APP/2022/139
 19030/APP/2021/3971
 19030/APP/2021/1512

SITE ADDRESS:
 14 BAWTREE ROAD
 UXBRIDGE
 UB8 1PU

REVISIONS	
DATE: 17-05-2023	DRAWN BY:
SCALE: 1:100, 1:500, 1:1250 @ A1	CHECKED BY:
DRAWING TITLE: PLANNING	DRAWING NUMBER: BAWTREE/14/2023/A