




GROUND FLOOR PLAN AS BUILT
(SCALE 1:100)

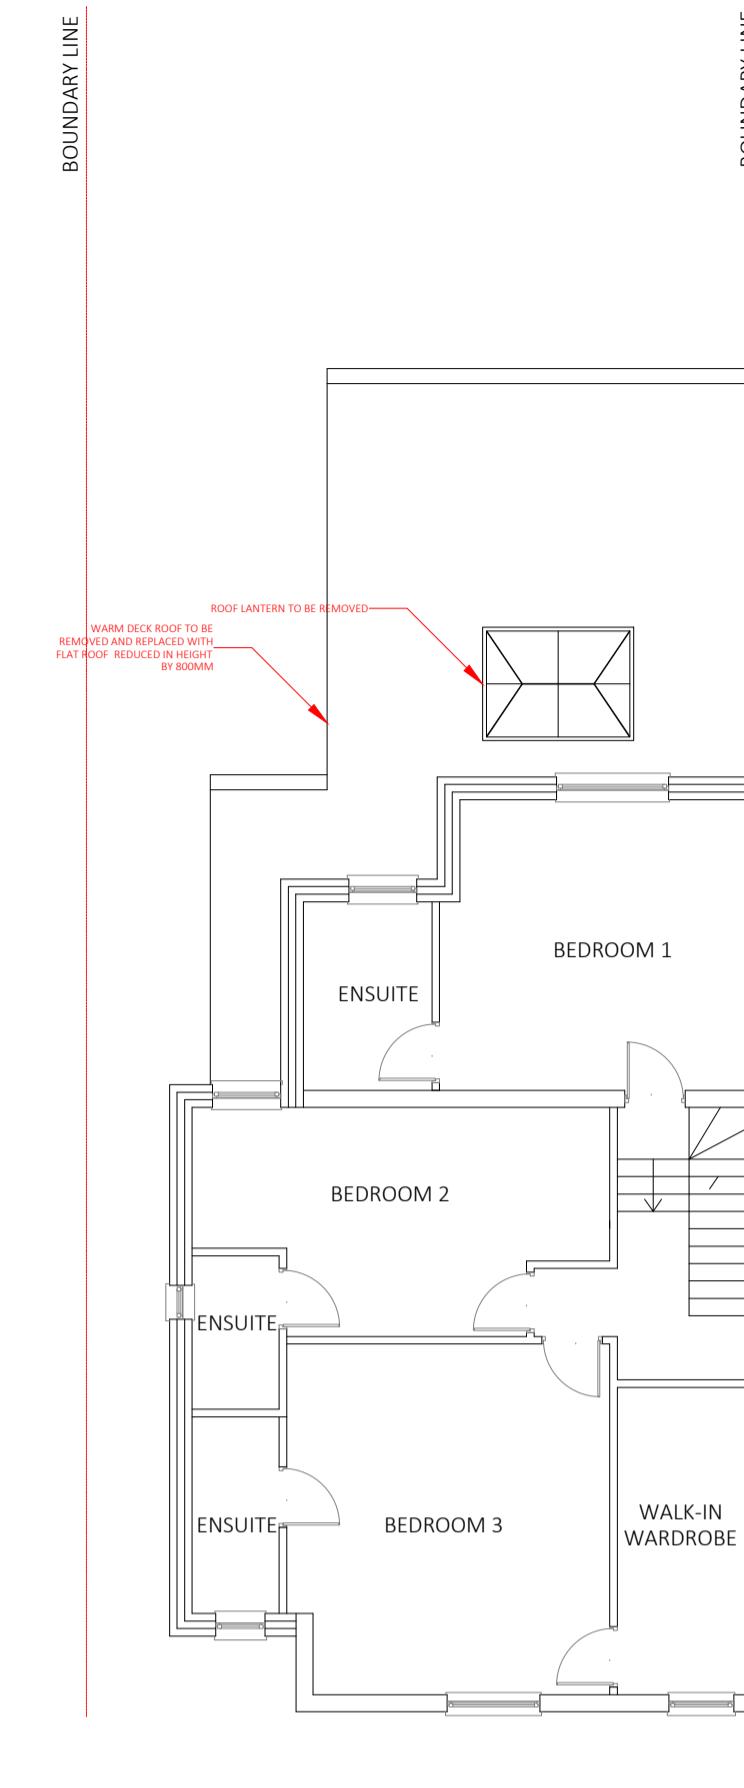

FIRST FLOOR PLAN AS BUILT
(SCALE 1:100)

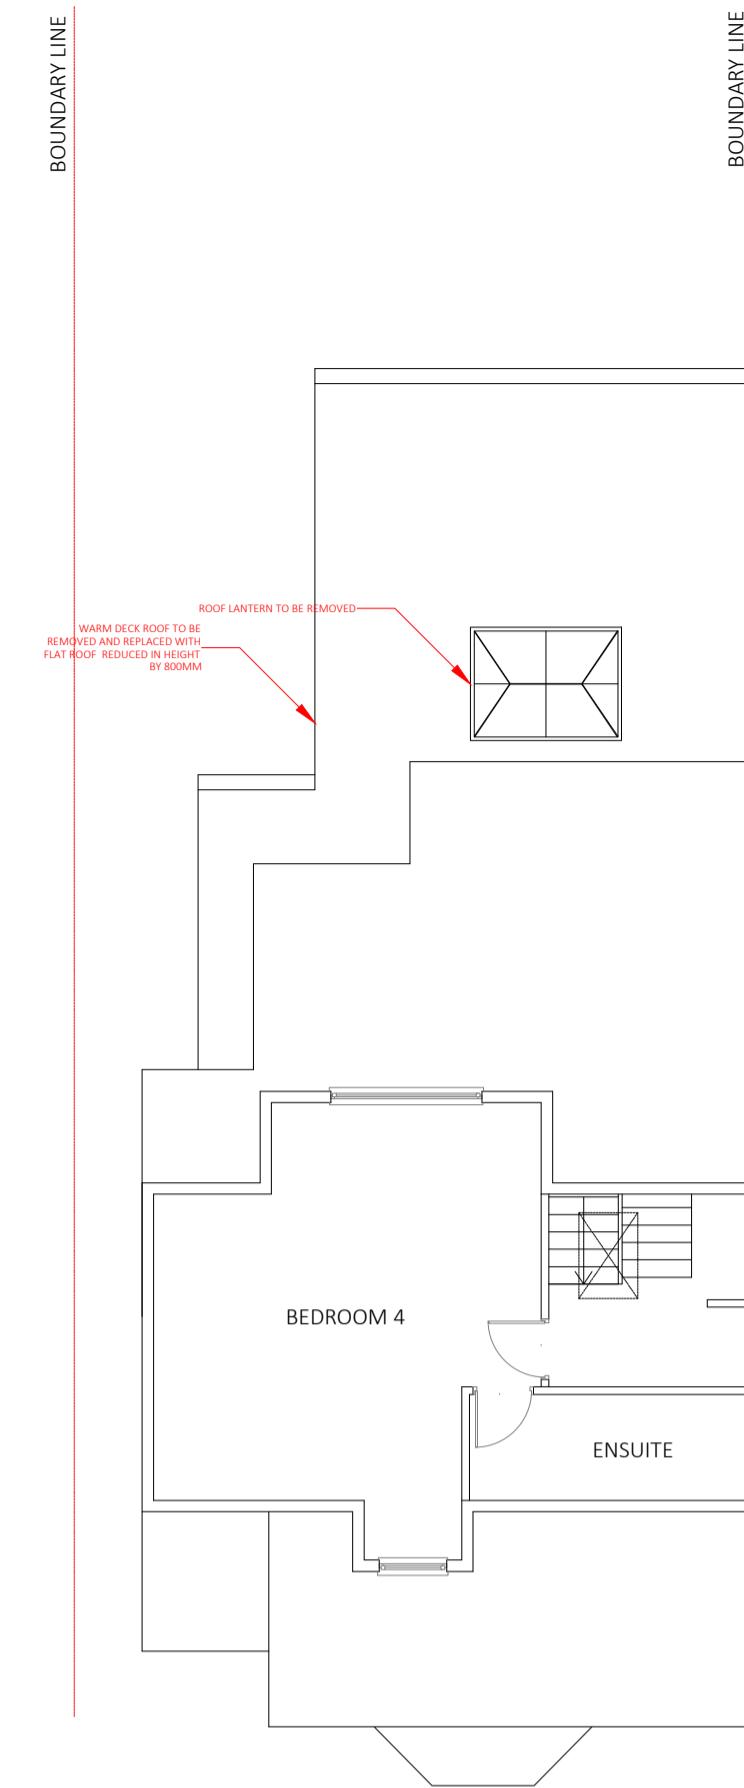


SECOND FLOOR PLAN AS BUILT
(SCALE 1:100)

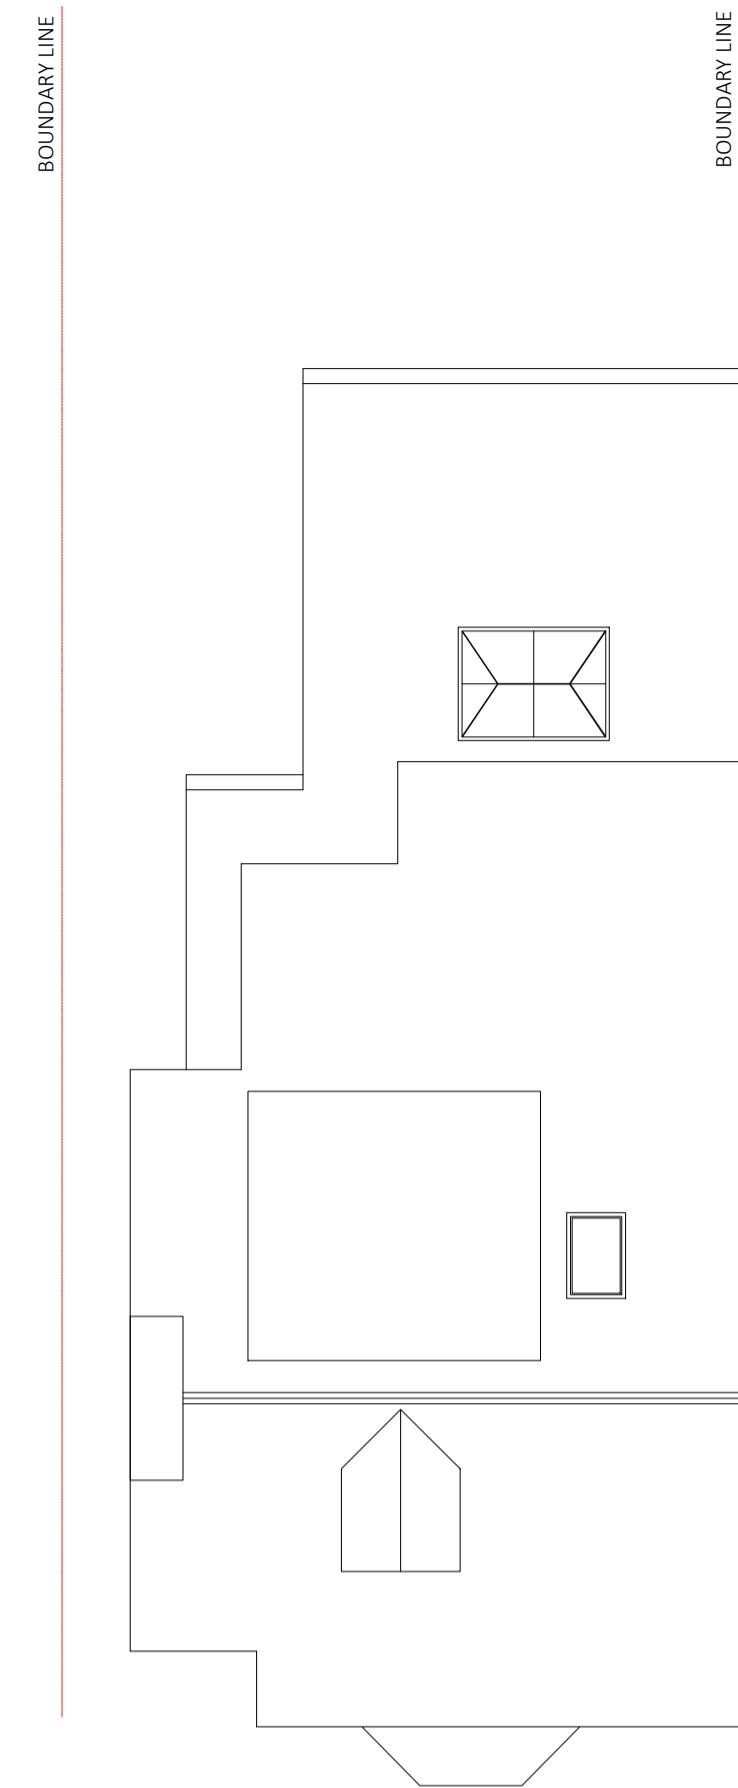


ROOF PLAN AS BUILT
(SCALE 1:100)




LOCATION PLAN
(SCALE 1:1250)

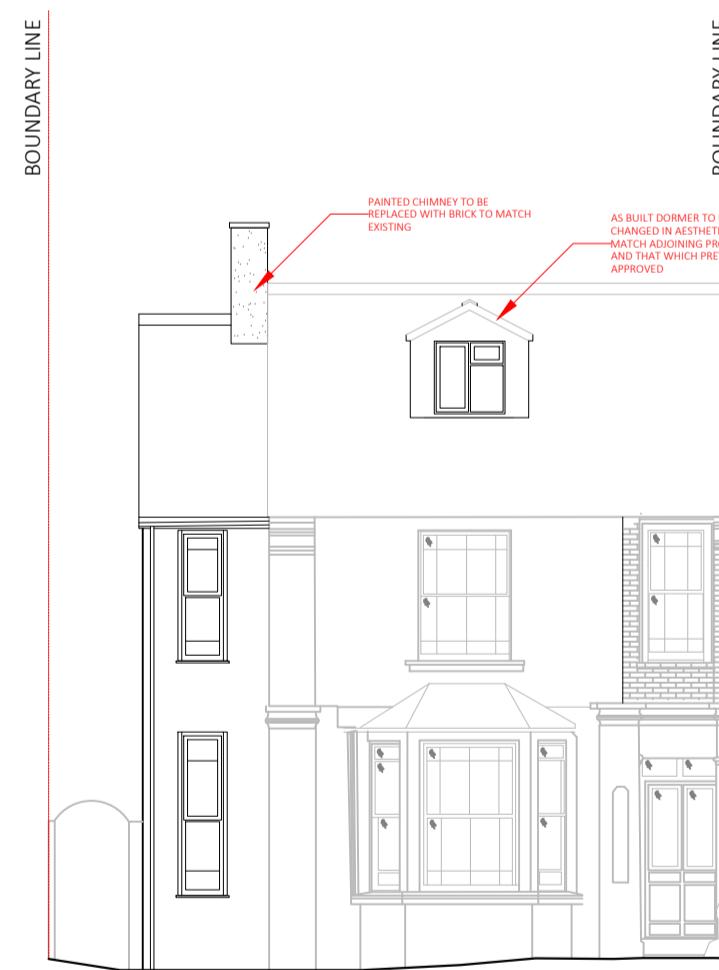


FRONT ELEVATION AS BUILT
(SCALE 1:100)

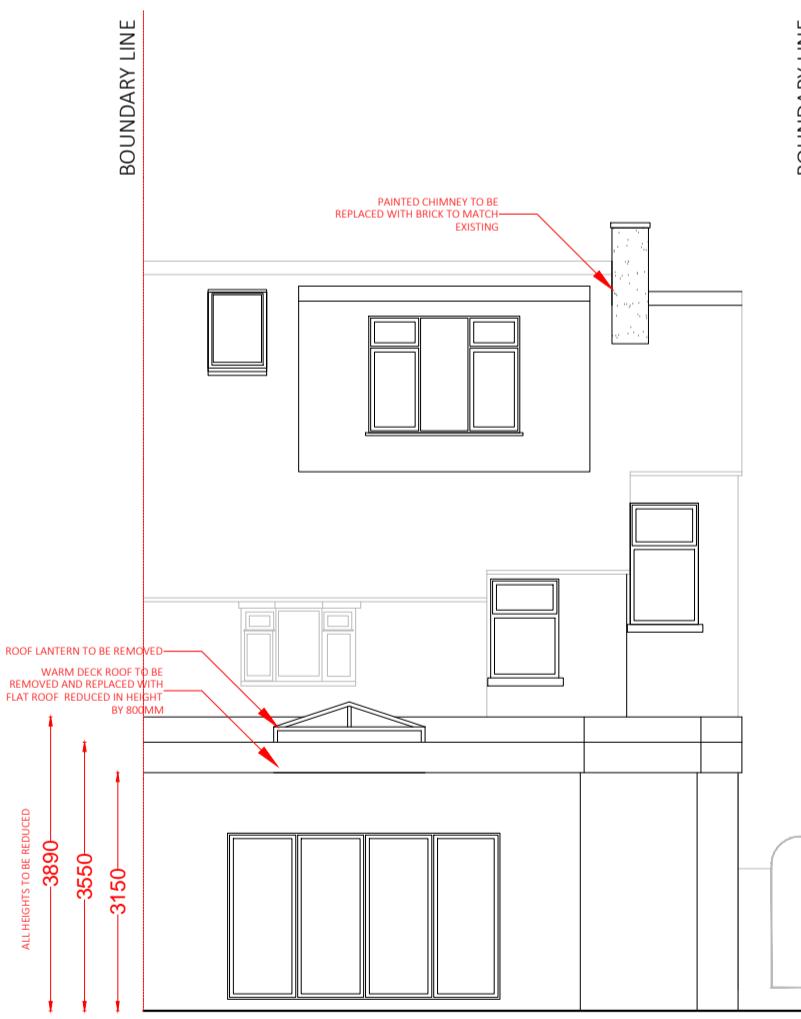

REAR ELEVATION AS BUILT
(SCALE 1:100)

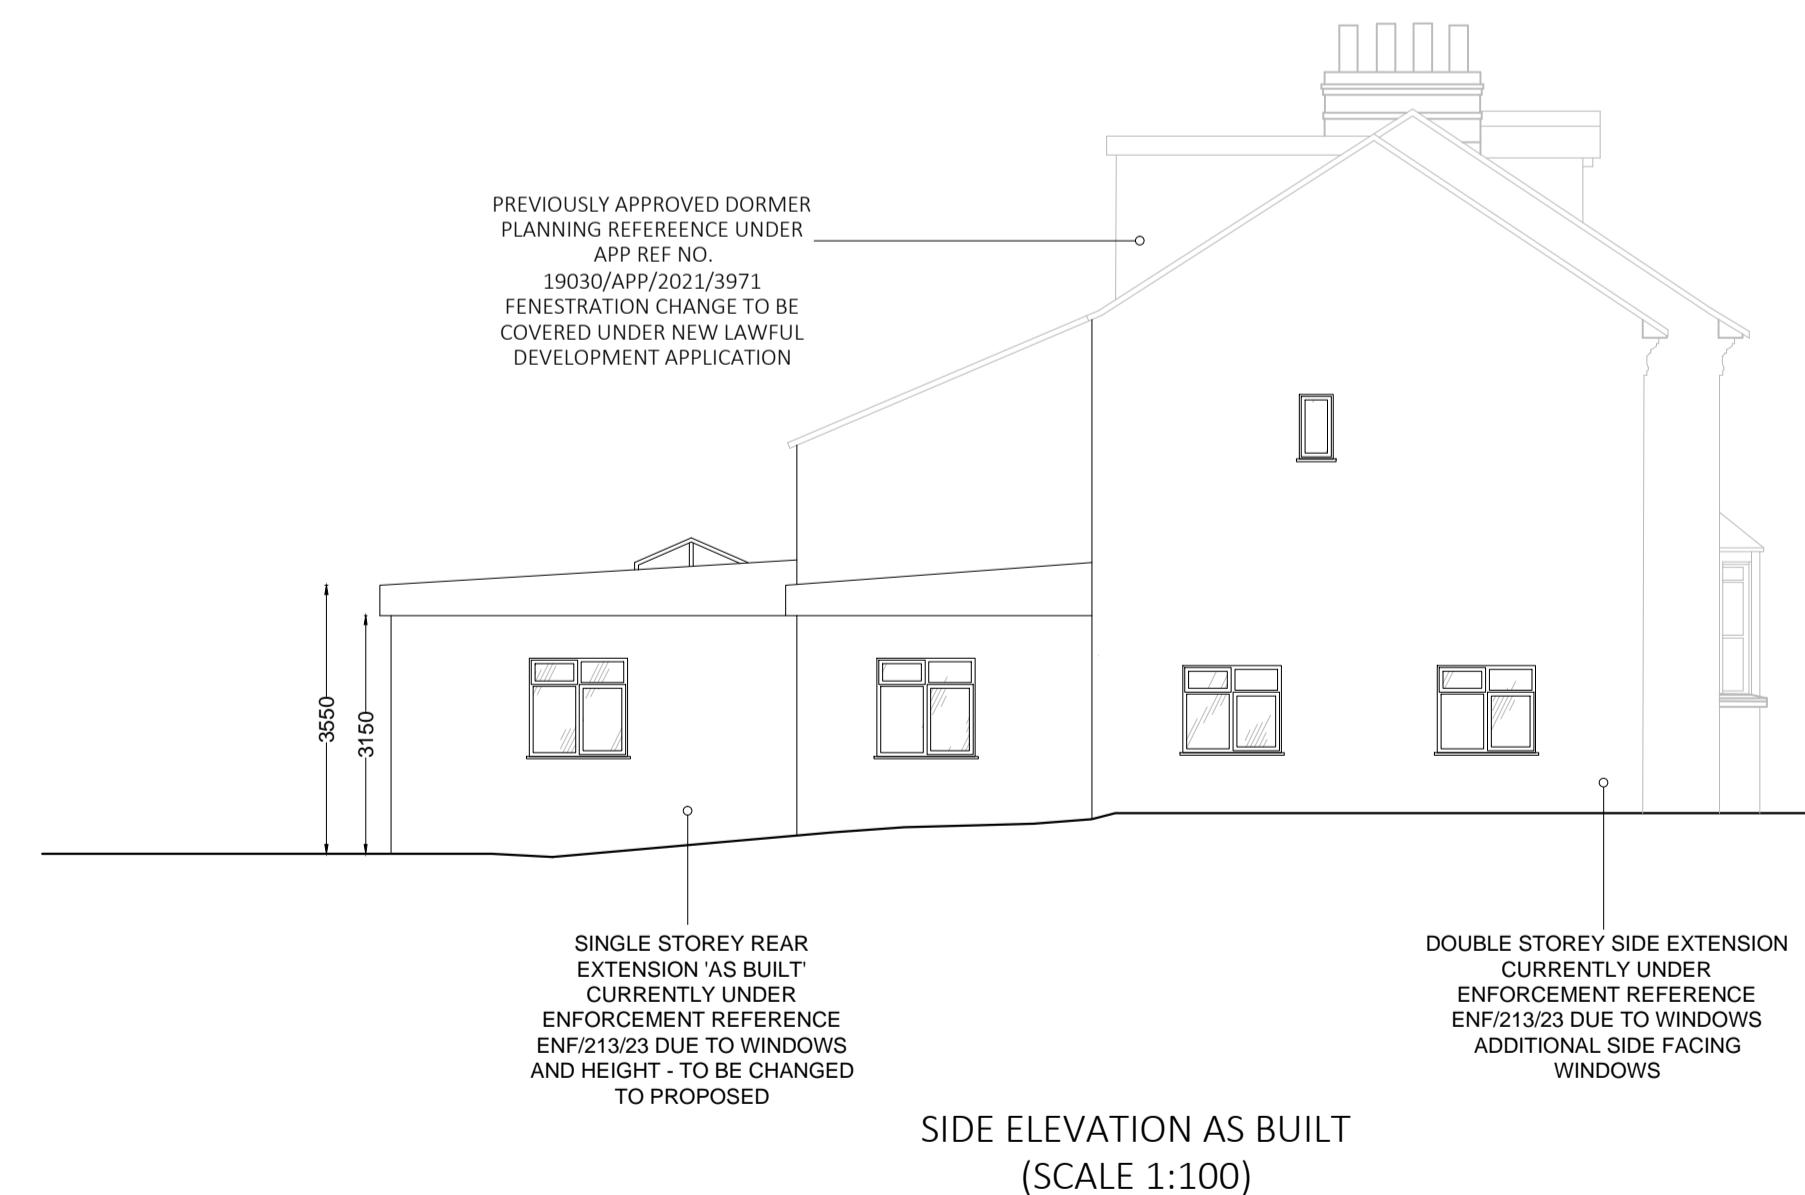

SIDE ELEVATION AS BUILT
(SCALE 1:100)

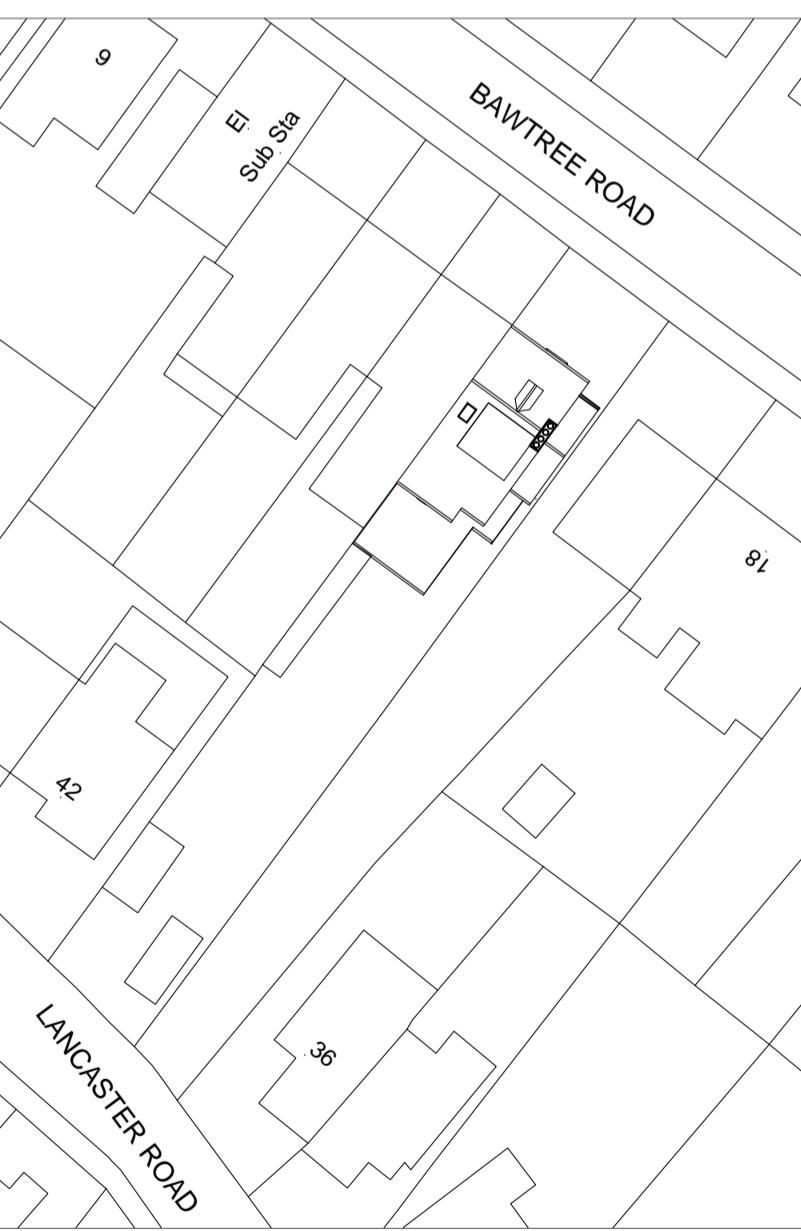

SITE PLAN AS BUILT
(SCALE 1:500)

NOT APPROVED FOR CONSTRUCTION

All measurements to be checked on site and not scaled from this drawing.
All works to the satisfaction of local authority inspector.
No deviation from these drawing what so ever.

DESCRIPTION
'AS BUILT' PLANS & ELEVATIONS

PLANNING REFERENCES
ENFORCEMENT ACTION ENF/213/22

SITE ADDRESS:
14 BAWTREE ROAD
UXBRIDGE
UB8 1PU

REVISIONS	
DATE: 17-05-2023	DRAWN BY:
SCALE: 1:100, 1:500, 1:1250 @ A1	CHECKED BY:
DRAWING TITLE: PLANNING	DRAWING NUMBER: BAWTREE/14/2023/C