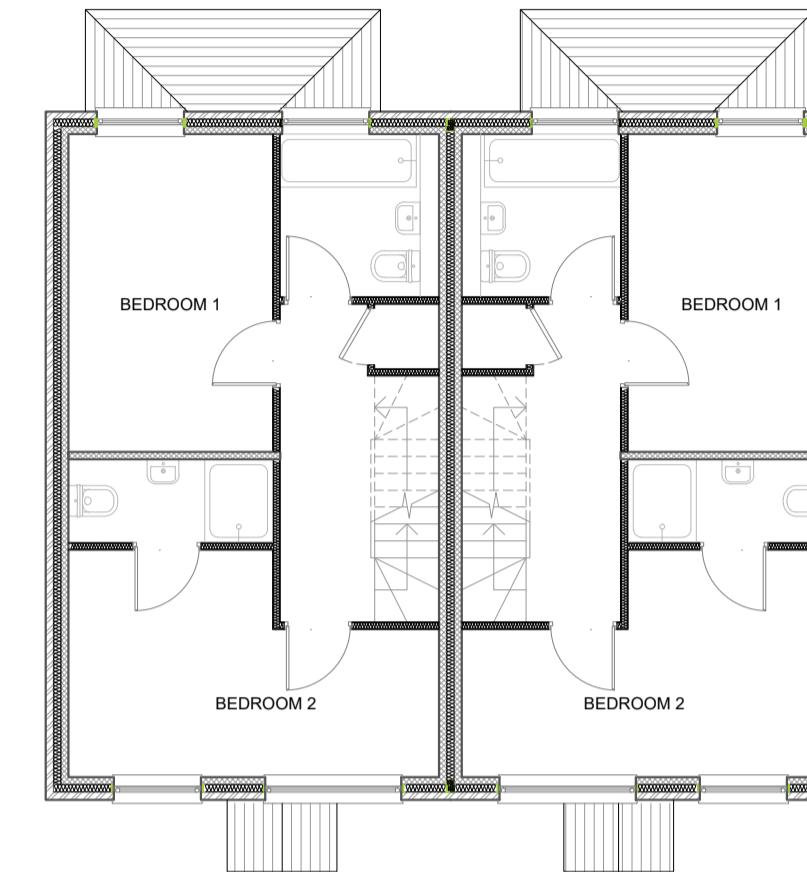
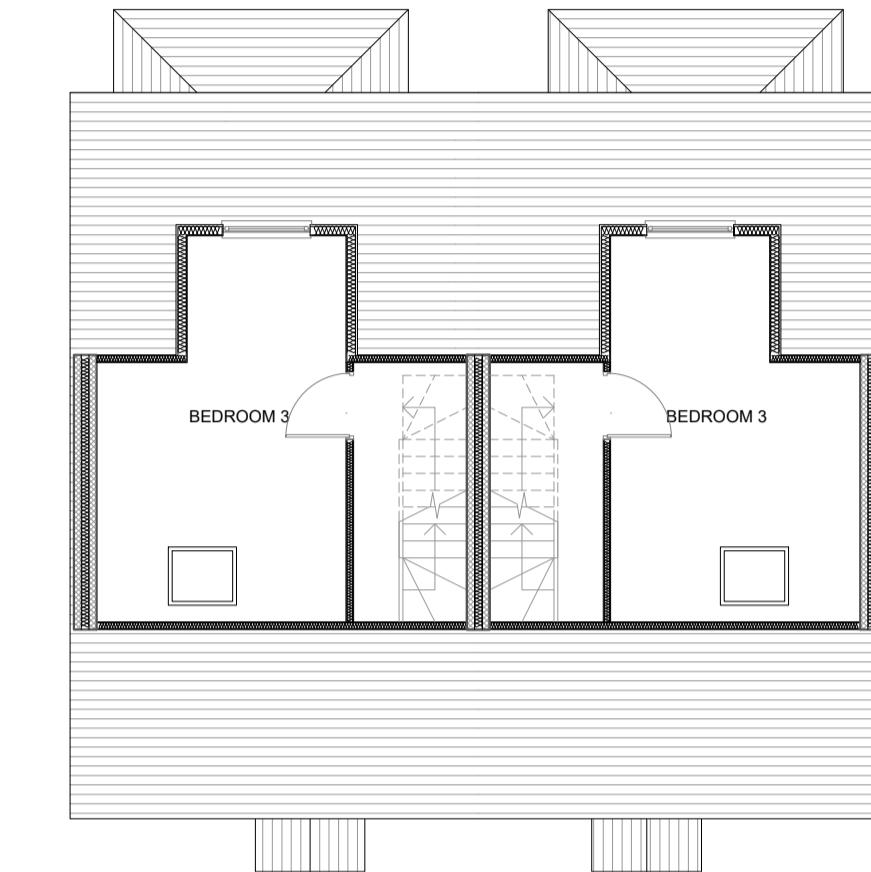
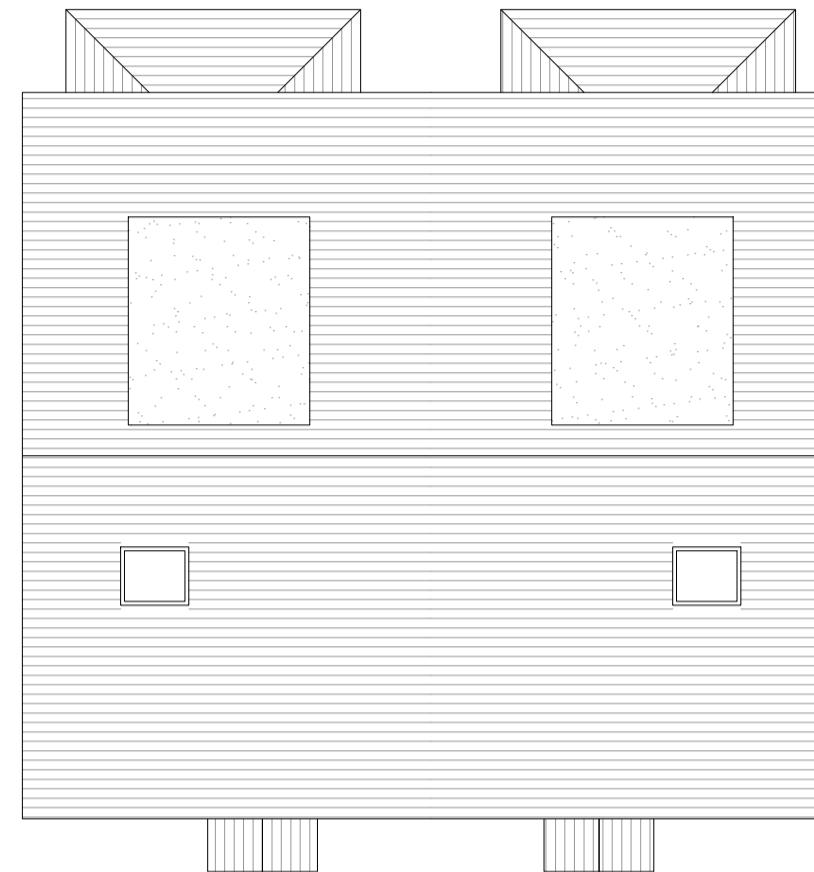
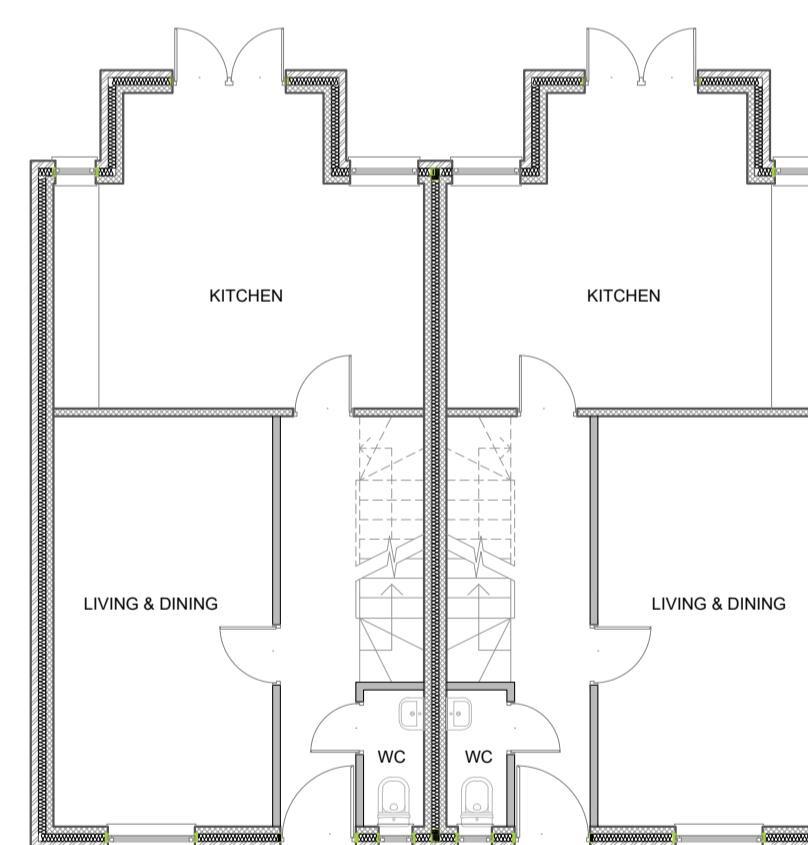
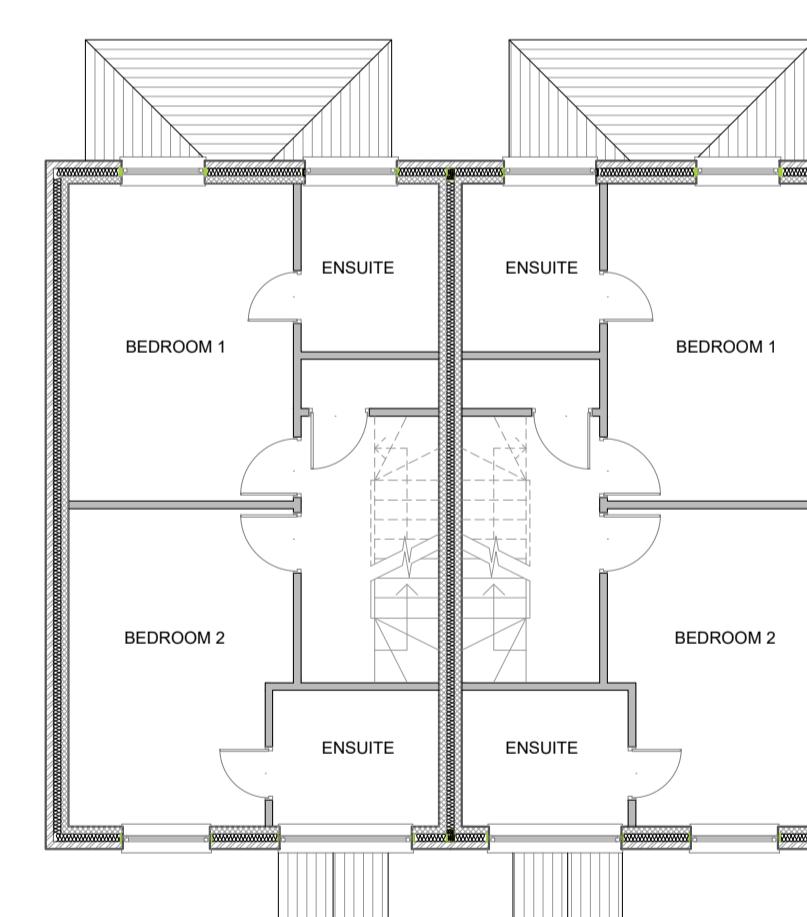
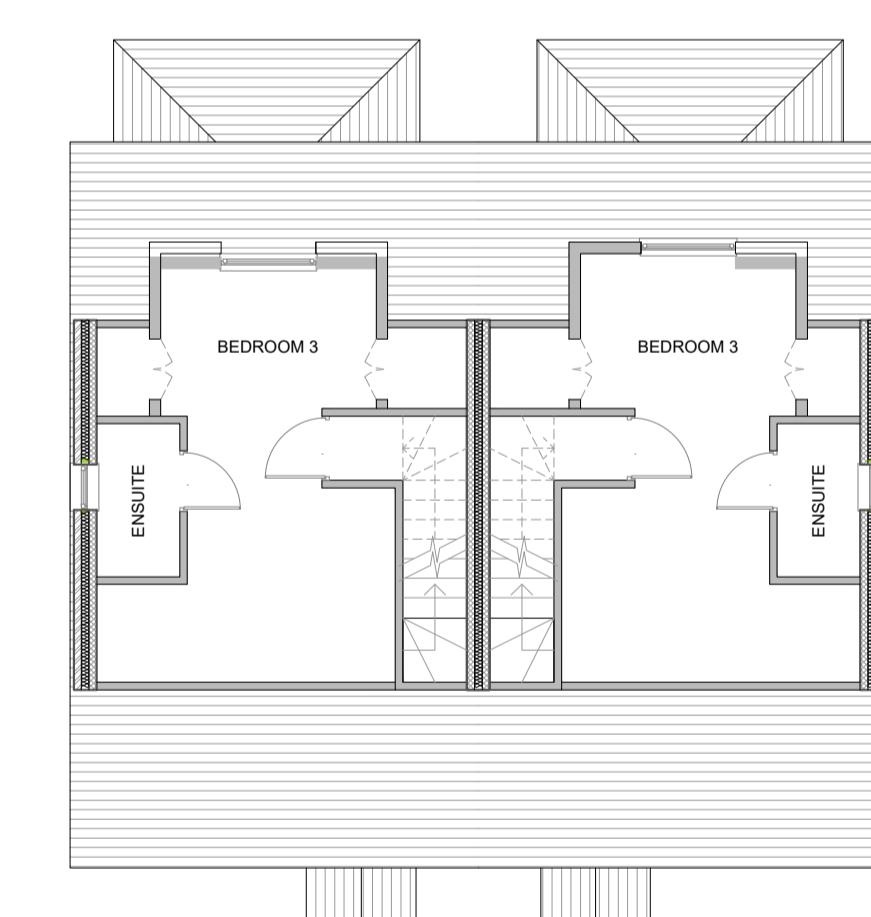
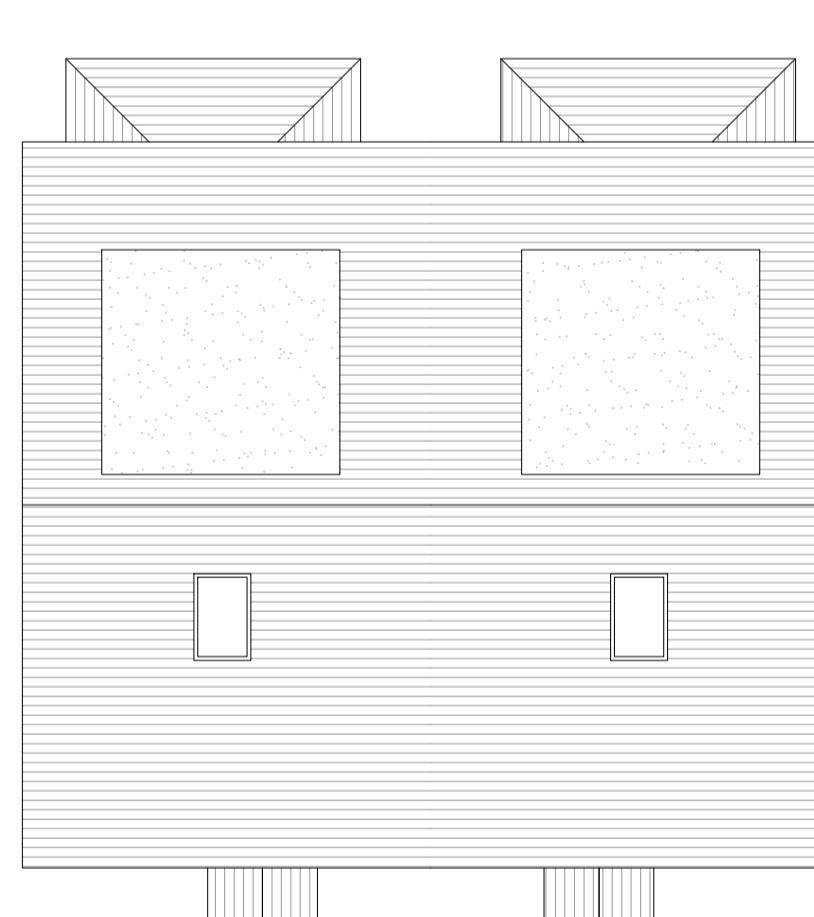
PROPOSED GROUND FLOOR PLAN
(SCALE 1:100)PROPOSED FIRST FLOOR PLAN
(SCALE 1:100)PROPOSED LOFT FLOOR PLAN
(SCALE 1:100)PROPOSED ROOF PLAN
(SCALE 1:100)PROPOSED GROUND FLOOR PLAN - 'AS BUILT'
(SCALE 1:100)FIRST FLOOR PLAN - 'AS BUILT'
(SCALE 1:100)PROPOSED LOFT FLOOR PLAN - 'AS BUILT'
(SCALE 1:100)PROPOSED ROOF PLAN - 'AS BUILT'
(SCALE 1:100)

NOT APPROVED FOR CONSTRUCTION

All measurements to be checked on site and not scaled from this drawing.
Any discrepancies to be reported to The White House Design LTD.
Party wall (etc) act 1997 to be agreed with adjoining neighbours prior to commencing.
All works to the satisfaction of local authority inspector.
No deviation from these drawing what so ever,
unless agreed in writing with The White House Design LTD.

DESCRIPTION

PREVIOUSLY APPROVED & AS BUILT PLANS

THE WHITE HOUSE DESIGN LTD

ARCHITECTURAL CONSULTANTS
& STRUCTURAL ENGINEERS
7 PROGRESS BUSINESS CENTRE
WHITTLE PARKWAY SLOUGH BERKSHIRE SL1 6DQ
TEL: 01628 660 444

SITE ADDRESS:

LAND BETWEEN 36 & 42 LANCASTER ROAD
UXBRIDGE
UB8 1AR

REVISIONS

DATE: 04-10-2023

DRAWN BY: KKC

SCALE: 1:100 @ A1

CHECKED BY:

DRAWING TITLE: PLANNING

DRAWING NUMBER: KKC/LR/2023/Z2