



SCALE BAR 1:100


SCALE BAR 1:200

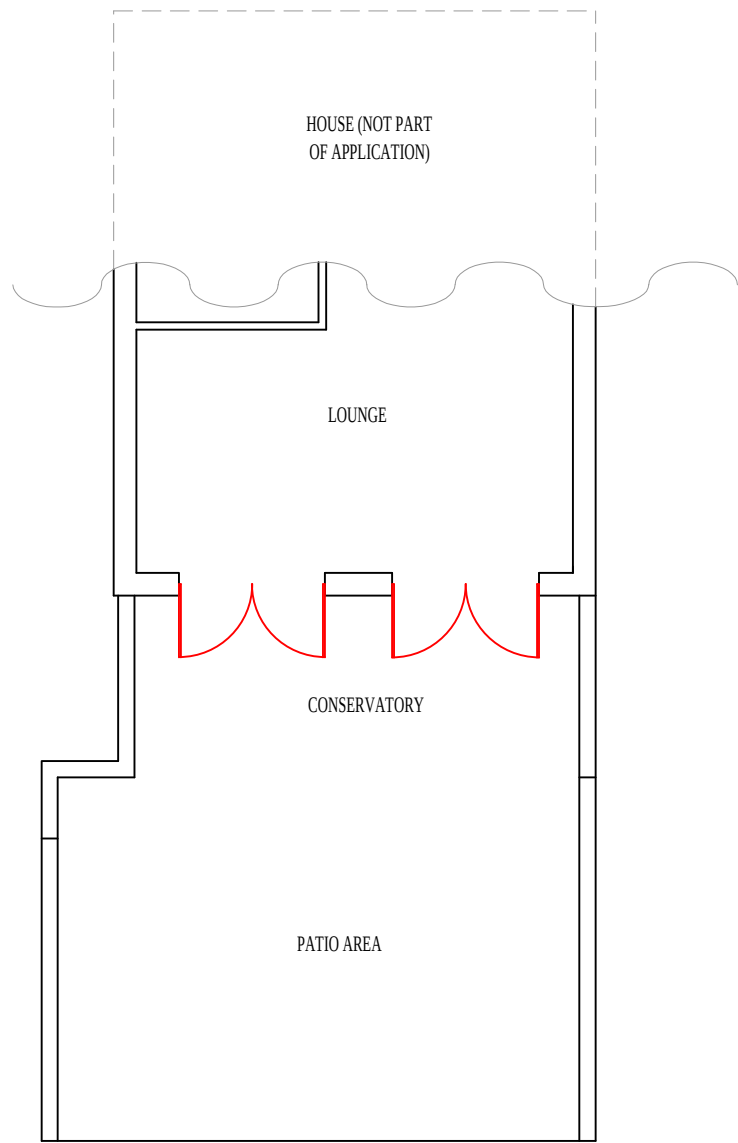

PRE-EXISTING FIRST FLOOR PLAN 1:100

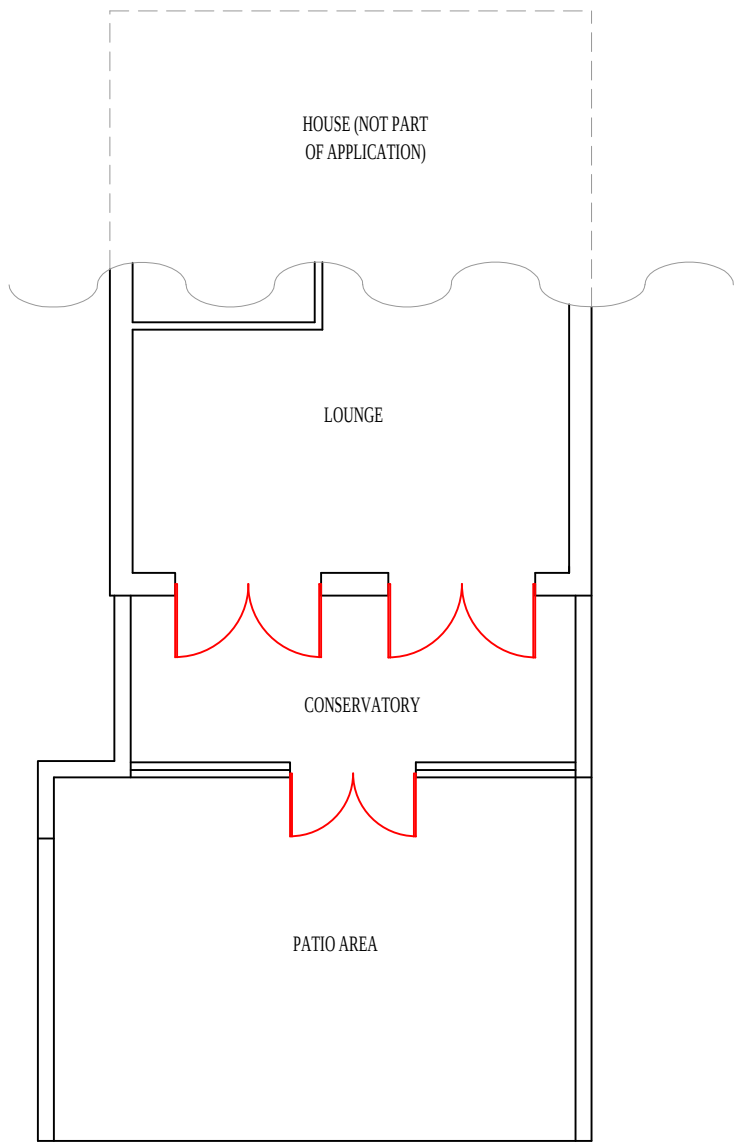


AS BUILT FIRST FLOOR PLAN 1:100

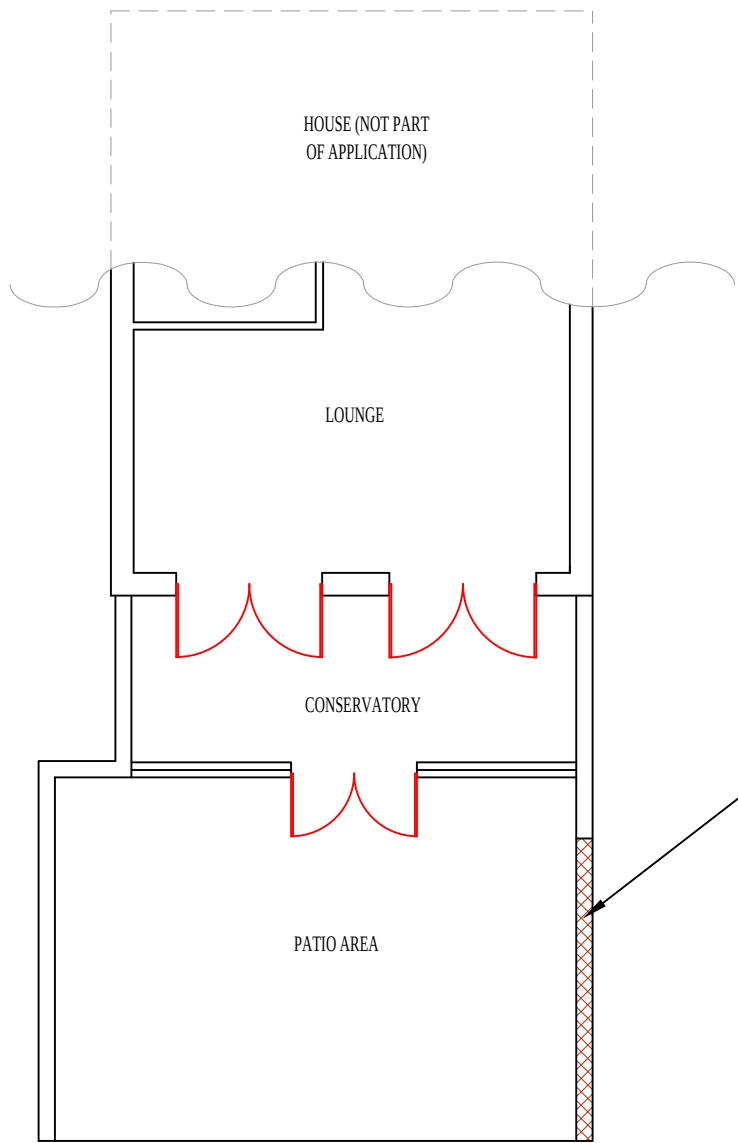

PROPOSED FIRST FLOOR PLAN 1:100




LOCATION PLAN 1:1250

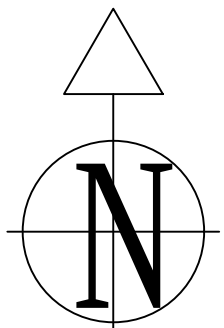


SITE PLAN 1:500




EXISTING REAR ELEVATION 1:100

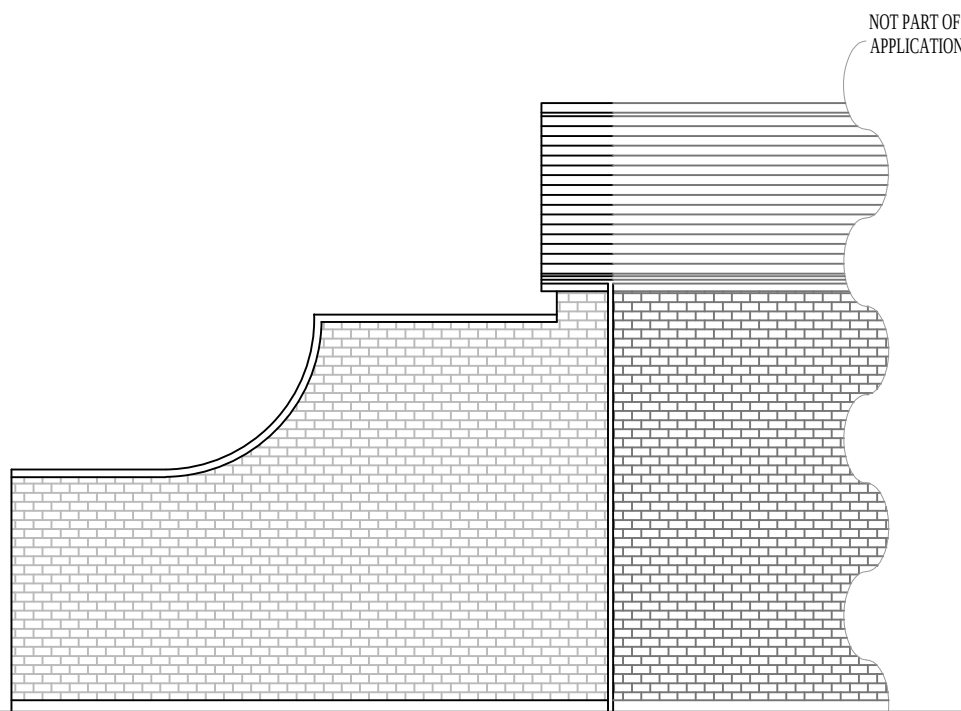

EXISTING SIDE ELEVATION 1:100

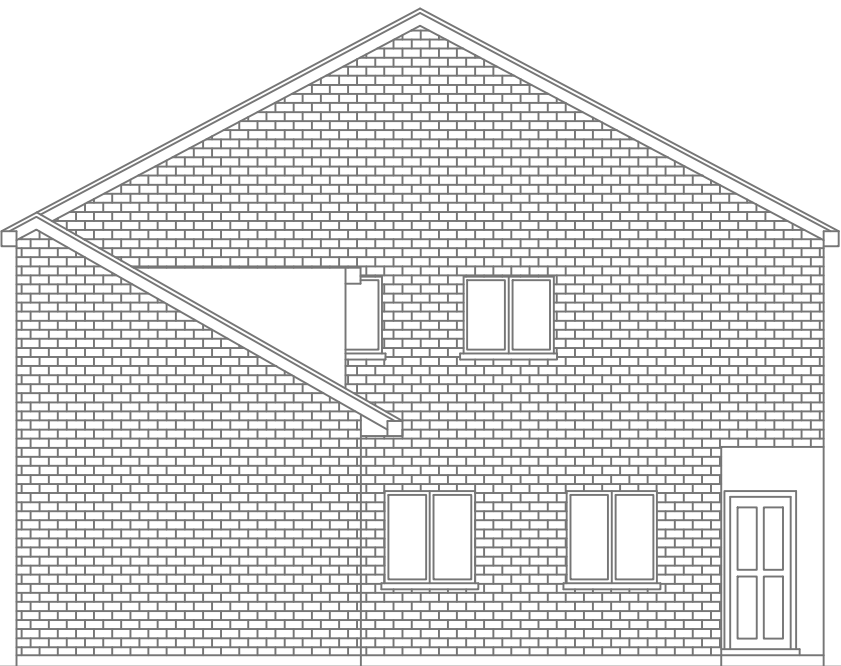


EXISTING FRONT ELEVATION 1:100

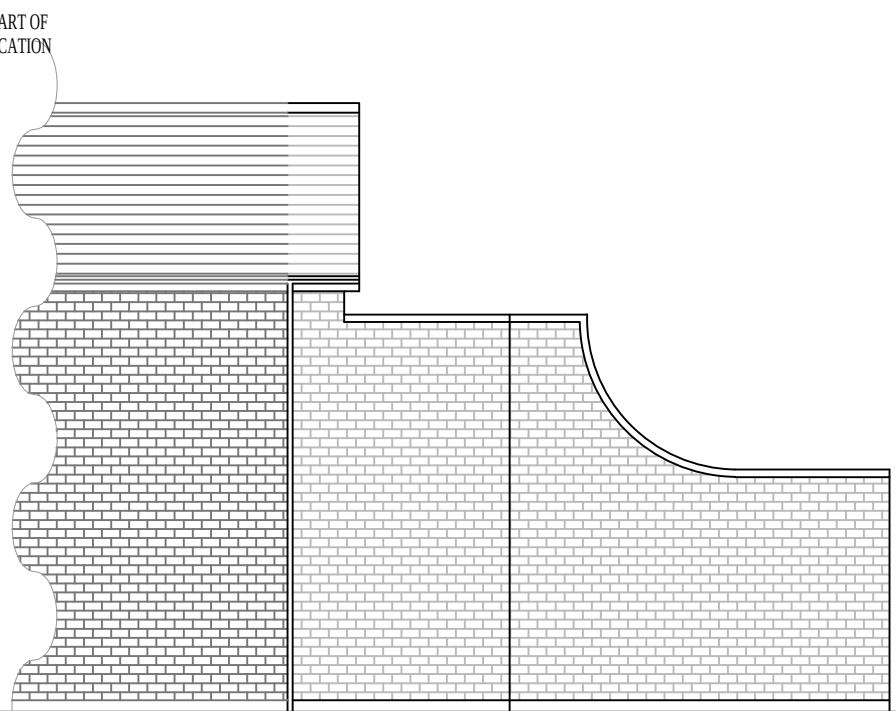


EXISTING SIDE ELEVATION 1:100




PROPOSED REAR ELEVATION 1:100

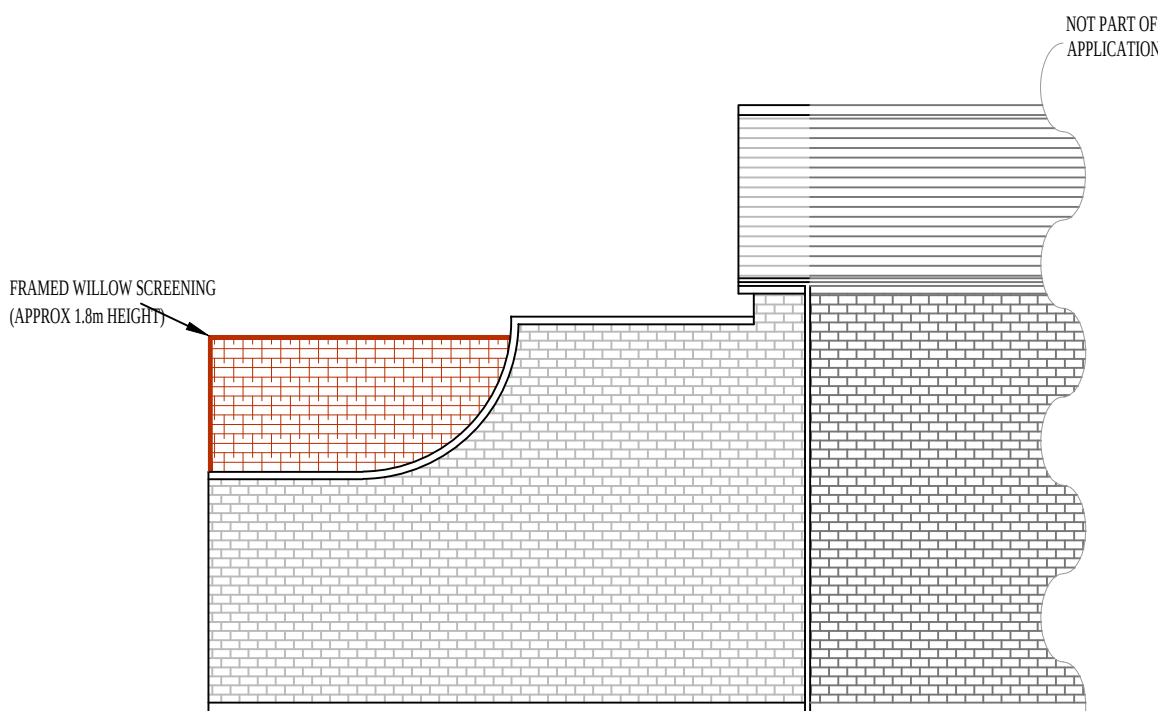

PROPOSED SIDE ELEVATION 1:100

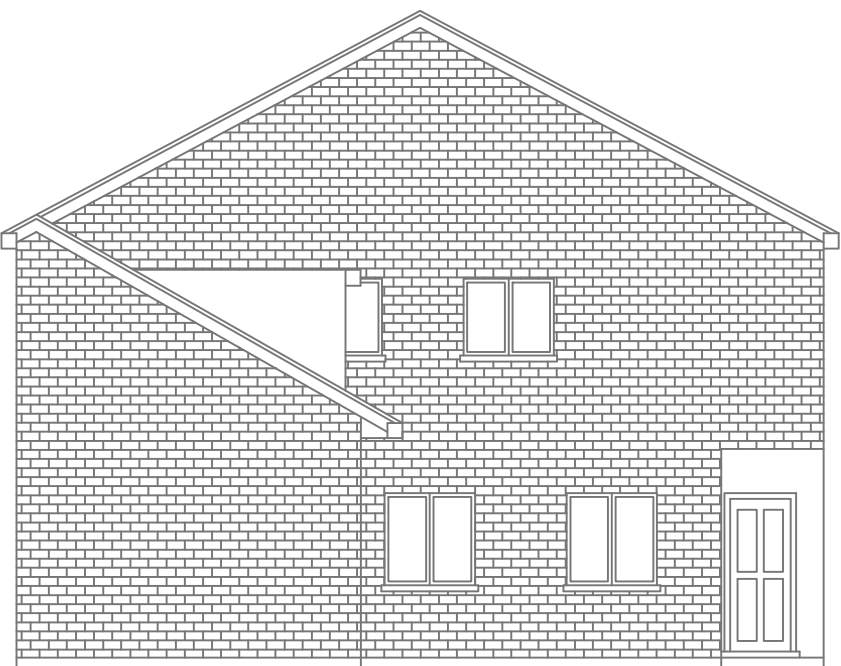

PROPOSED FRONT ELEVATION 1:100

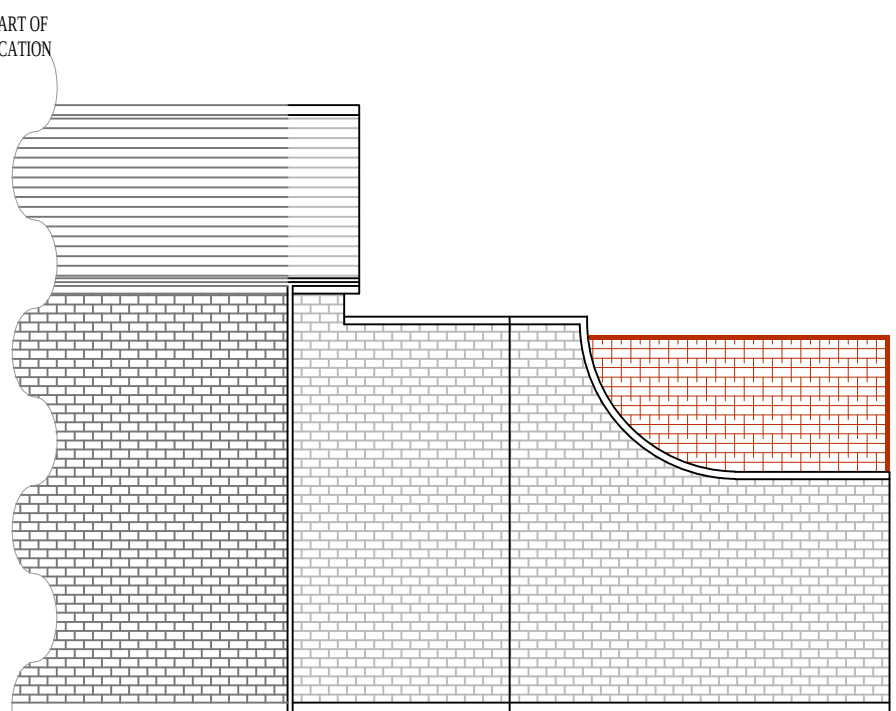

PROPOSED SIDE ELEVATION 1:100

SCALE BAR 1:500

SCALE BAR 1:1250



THE PILLARS
SLADE OAK LANE,
GERRARDS CROSS
BUCKINGHAMSHIRE, SL9 0QE
TEL : 01895 832 560
FAX : 01895 832 560
EMAIL : info@landmark-group.co.uk



RTPI
Chartered Town Planners



CIOB
THE CHARTERED INSTITUTE OF BUILDING



IN PARTNERSHIP
WITH LABC

CLIENT / JOB ADDRESS
13-15 SWAKELEYS ROAD
ICKENHAM
UXBRIDGE
UB10 8DF

DRAWING TITLE / DESCRIPTION
RETROSPECTIVE CONSENT FOR CONSERVATORY & NEW PROPOSED SCREENING

SUBMISSION / REF
PLANNING

DRAWING NO.
GSB/13-15/17

SCALE 1:100 / 500 / 1250
DRAWN BY AC & GSB
DATE 16/01/2017
CHECKED BY HM

REVISION	DESCRIPTION	DRAWN BY	DATE

NOTE : All measurements to be checked on site and not scaled from this drawing. Any discrepancies to be reported to Landmark Designs Ltd (a company limited by guarantee under the Companies Act 1996) to be agreed with adjoining neighbours prior to all work to the satisfaction of local authority inspector. No deviation from these drawings without the written agreement of the client and the architect.

DISCLAIMER:
THESE ARE THE PLANNING DRAWINGS AND SHOULD NOT BE USED FOR STRUCTURAL CALCULATIONS OR ANY ENGINEERING PURPOSES.

IMPORTANT NOTE:
ALL GUTTERS, FOUNDATIONS AND DOWNPIPES TO REMAIN WITHIN THE BOUNDARY LINES OF THE SUBJECT PROPERTY. ALL PLANS ARE SUBJECT TO FULL PLANS APPROVAL BY BUILDING CONTROL, NOT BUILDING NOTICE.