


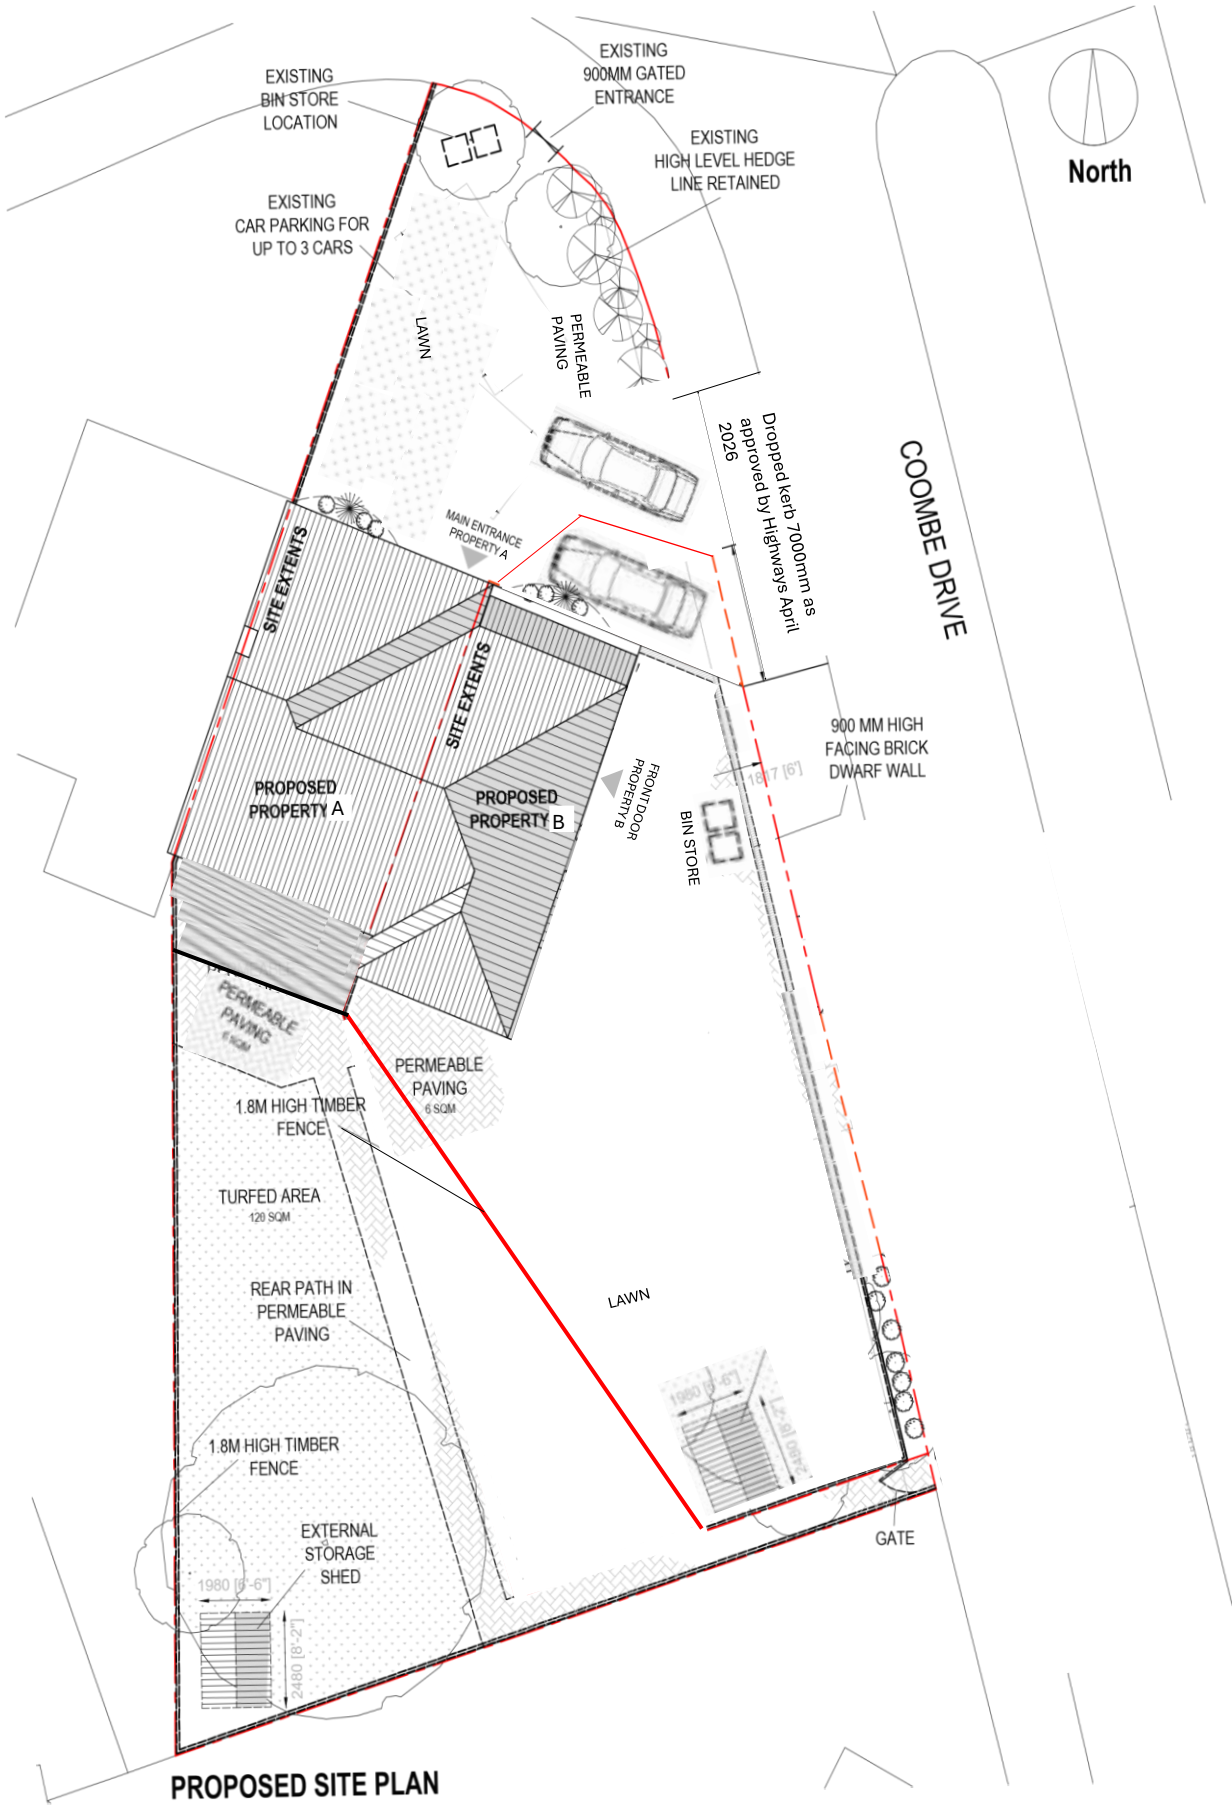

PROPOSED SITE PLAN

97 SOUTHBOURNE GARDENS, LONDON, HA4 9TA

Client: MR EDDY

Sheet Title: PROPOSED SITE PLAN

Drawn: M.W. **Checked:** S.K.

THIS DRAWING IS ISSUED FOR THE SOLE AND EXCLUSIVE USE OF THE NAMED RECIPIENT. DISTRIBUTION TO ANY THIRD PARTY IS ON THE STRICT UNDERSTANDING THAT NO LIABILITY IS ACCEPTED BY WWW.ARCPLAN.CO.UK FOR ANY DISCREPANCIES, ERRORS OR OMISSIONS THAT MAY BE PRESENT AND NO GUARANTEE IS OFFERED AS TO THE ACCURACY OF THE INFORMATION SHOWN. THIS DRAWING IS FOR REFERENCE ONLY. PLEASE REPORT ANY DISCREPANCIES TO THE DESIGNER BEFORE ANY WORKS COMMENCE. ALL DIMENSIONS TO BE CHECKED ON SITE BEFORE ANY WORKS COMMENCE. ARCPLAN.CO.UK 2023. COPYRIGHT RESERVED.

WWW.ARCPLAN.CO.UK - 231023-PP-PROSP-01

Scale: VARIOUS @ A4

Date: 19-10-23

Revision:

Drawing Stage	
FEASIBILITY	TENDER
PLANNING	CONSTRUCTION
BUILDING REGULATIONS	AS BUILT

Notes:
Red Line = Site Boundary
Blue Line = Applicant Owned Site
As built survey undertaken by others.

Whatsapp Business: +447565824814
Link Tree (for all Socials): <https://linktr.ee/Arcplan>
Web: www.arcplan.co.uk
Telephone (By Appointment): +44 (0)330 1335860
Live Chat (10am - 6pm Mon-Fri): www.arcplan.co.uk
Enquiries Email: Design@arcplan.co.uk