


NOTES



The Contractor must verify all dimensions at the site before setting out, commencing work, or making any shop drawings. Any discrepancies must be reported to the Contract Administrator / Architect before proceeding.

This drawing to be used for estimating purposes only. The Contractor must not use this drawing for construction until the structural design has been carried out and confirmation given by Building Control that the design is acceptable. Architect's drawings to be used in conjunction with the structural drawings.


DO NOT SCALE FROM THIS DRAWING.

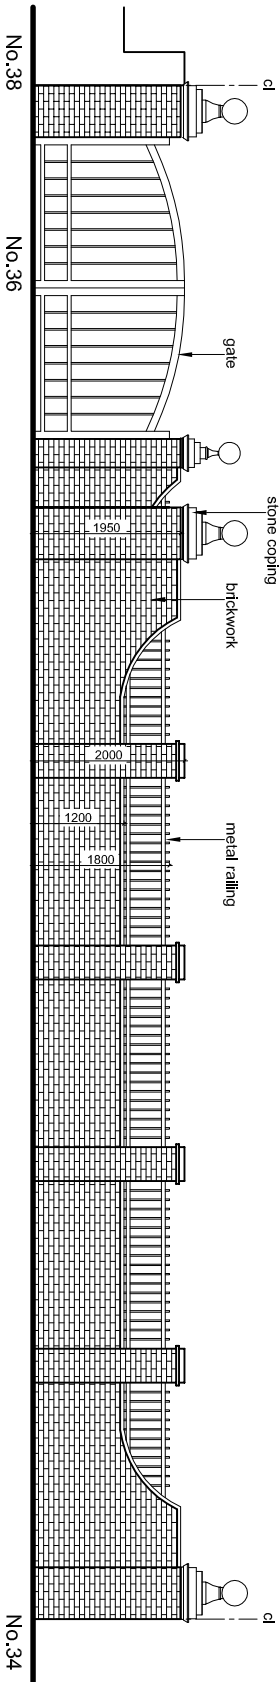


FRONT BOUNDARY WALL ELEVATION AS APPROVED
BY PLANNING PERMISSION
REF. 21033/APP/2020/778
SCALE 1:100

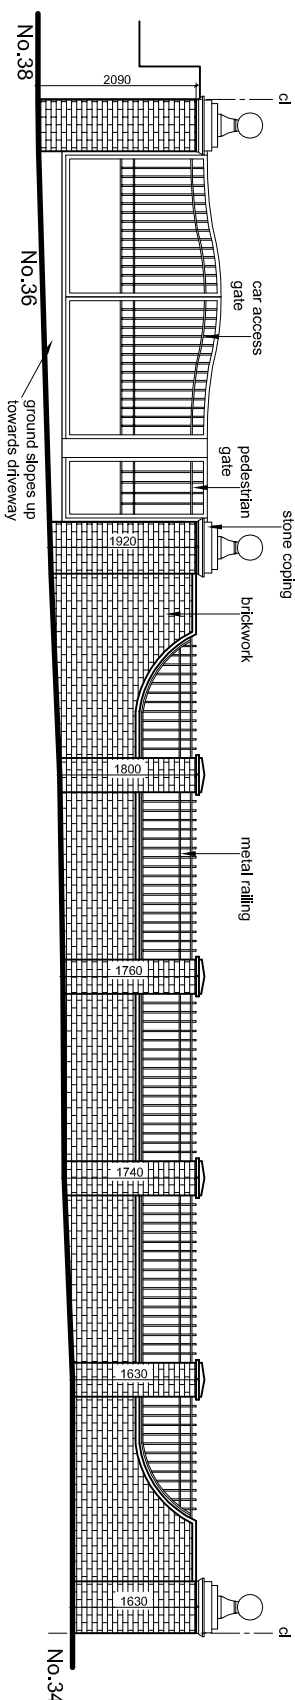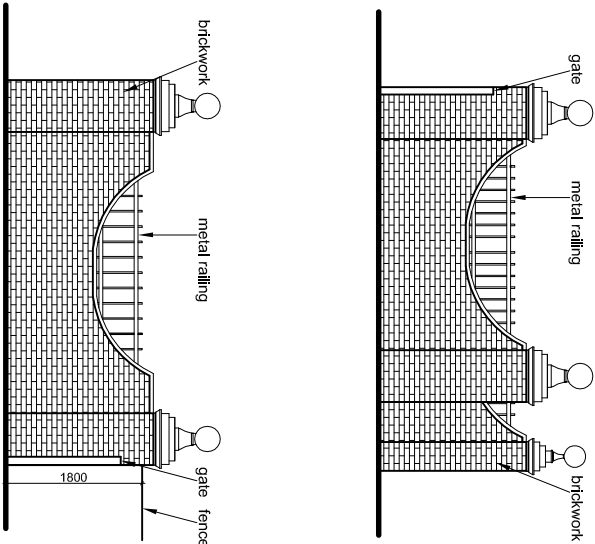

FRONT BOUNDARY WALL ELEVATION AS BUILT
SCALE 1:100

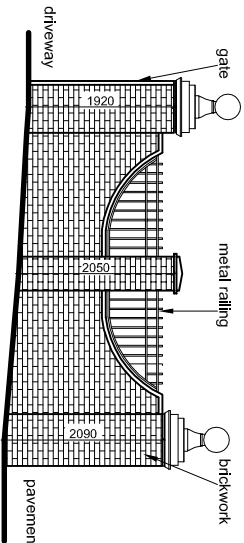

SIDE BOUNDARY WALL
ELEVATION AS BUILT
SCALE 1:100

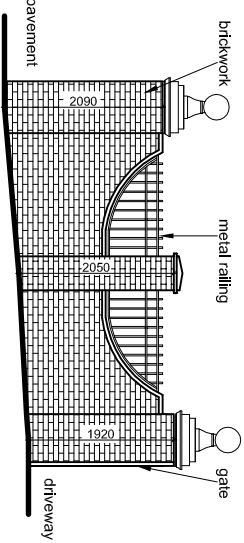

SIDE BOUNDARY WALL
ELEVATION AS BUILT
SCALE 1:100

PROJECT
36 VINE LANE, HILLINGDON UB10 0BA
NEW 5 BEDROOM HOUSE

GDC DESIGN LTD
CHARTERED ARCHITECT
Tel: 01895 610 932
Mob: 07976 732 636
g.g.callon11@btinternet.com



DESCRIPTION
FRONT BOUNDARY WALL ELEVATIONS

SCALE	DRAWN BY	CHECKED BY	DATE
1:50, 1:100 @ A3	JT	GC	20/01/2022
DRAWING No.	REV.		
36 VL / P1 / 12	B		