


NOTES:
All dimensions must be checked on site and not scaled from this drawing.

Bar Scale

0m 1m 2m 3m 4m 5m
1:50

0m 1m 2m 3m 4m 5m 6m 7m 8m 9m 10m
1:100


THIS DRAWING TO BE READ
IN CONJUNCTION WITH DRG
Nos 4547/01 & 03

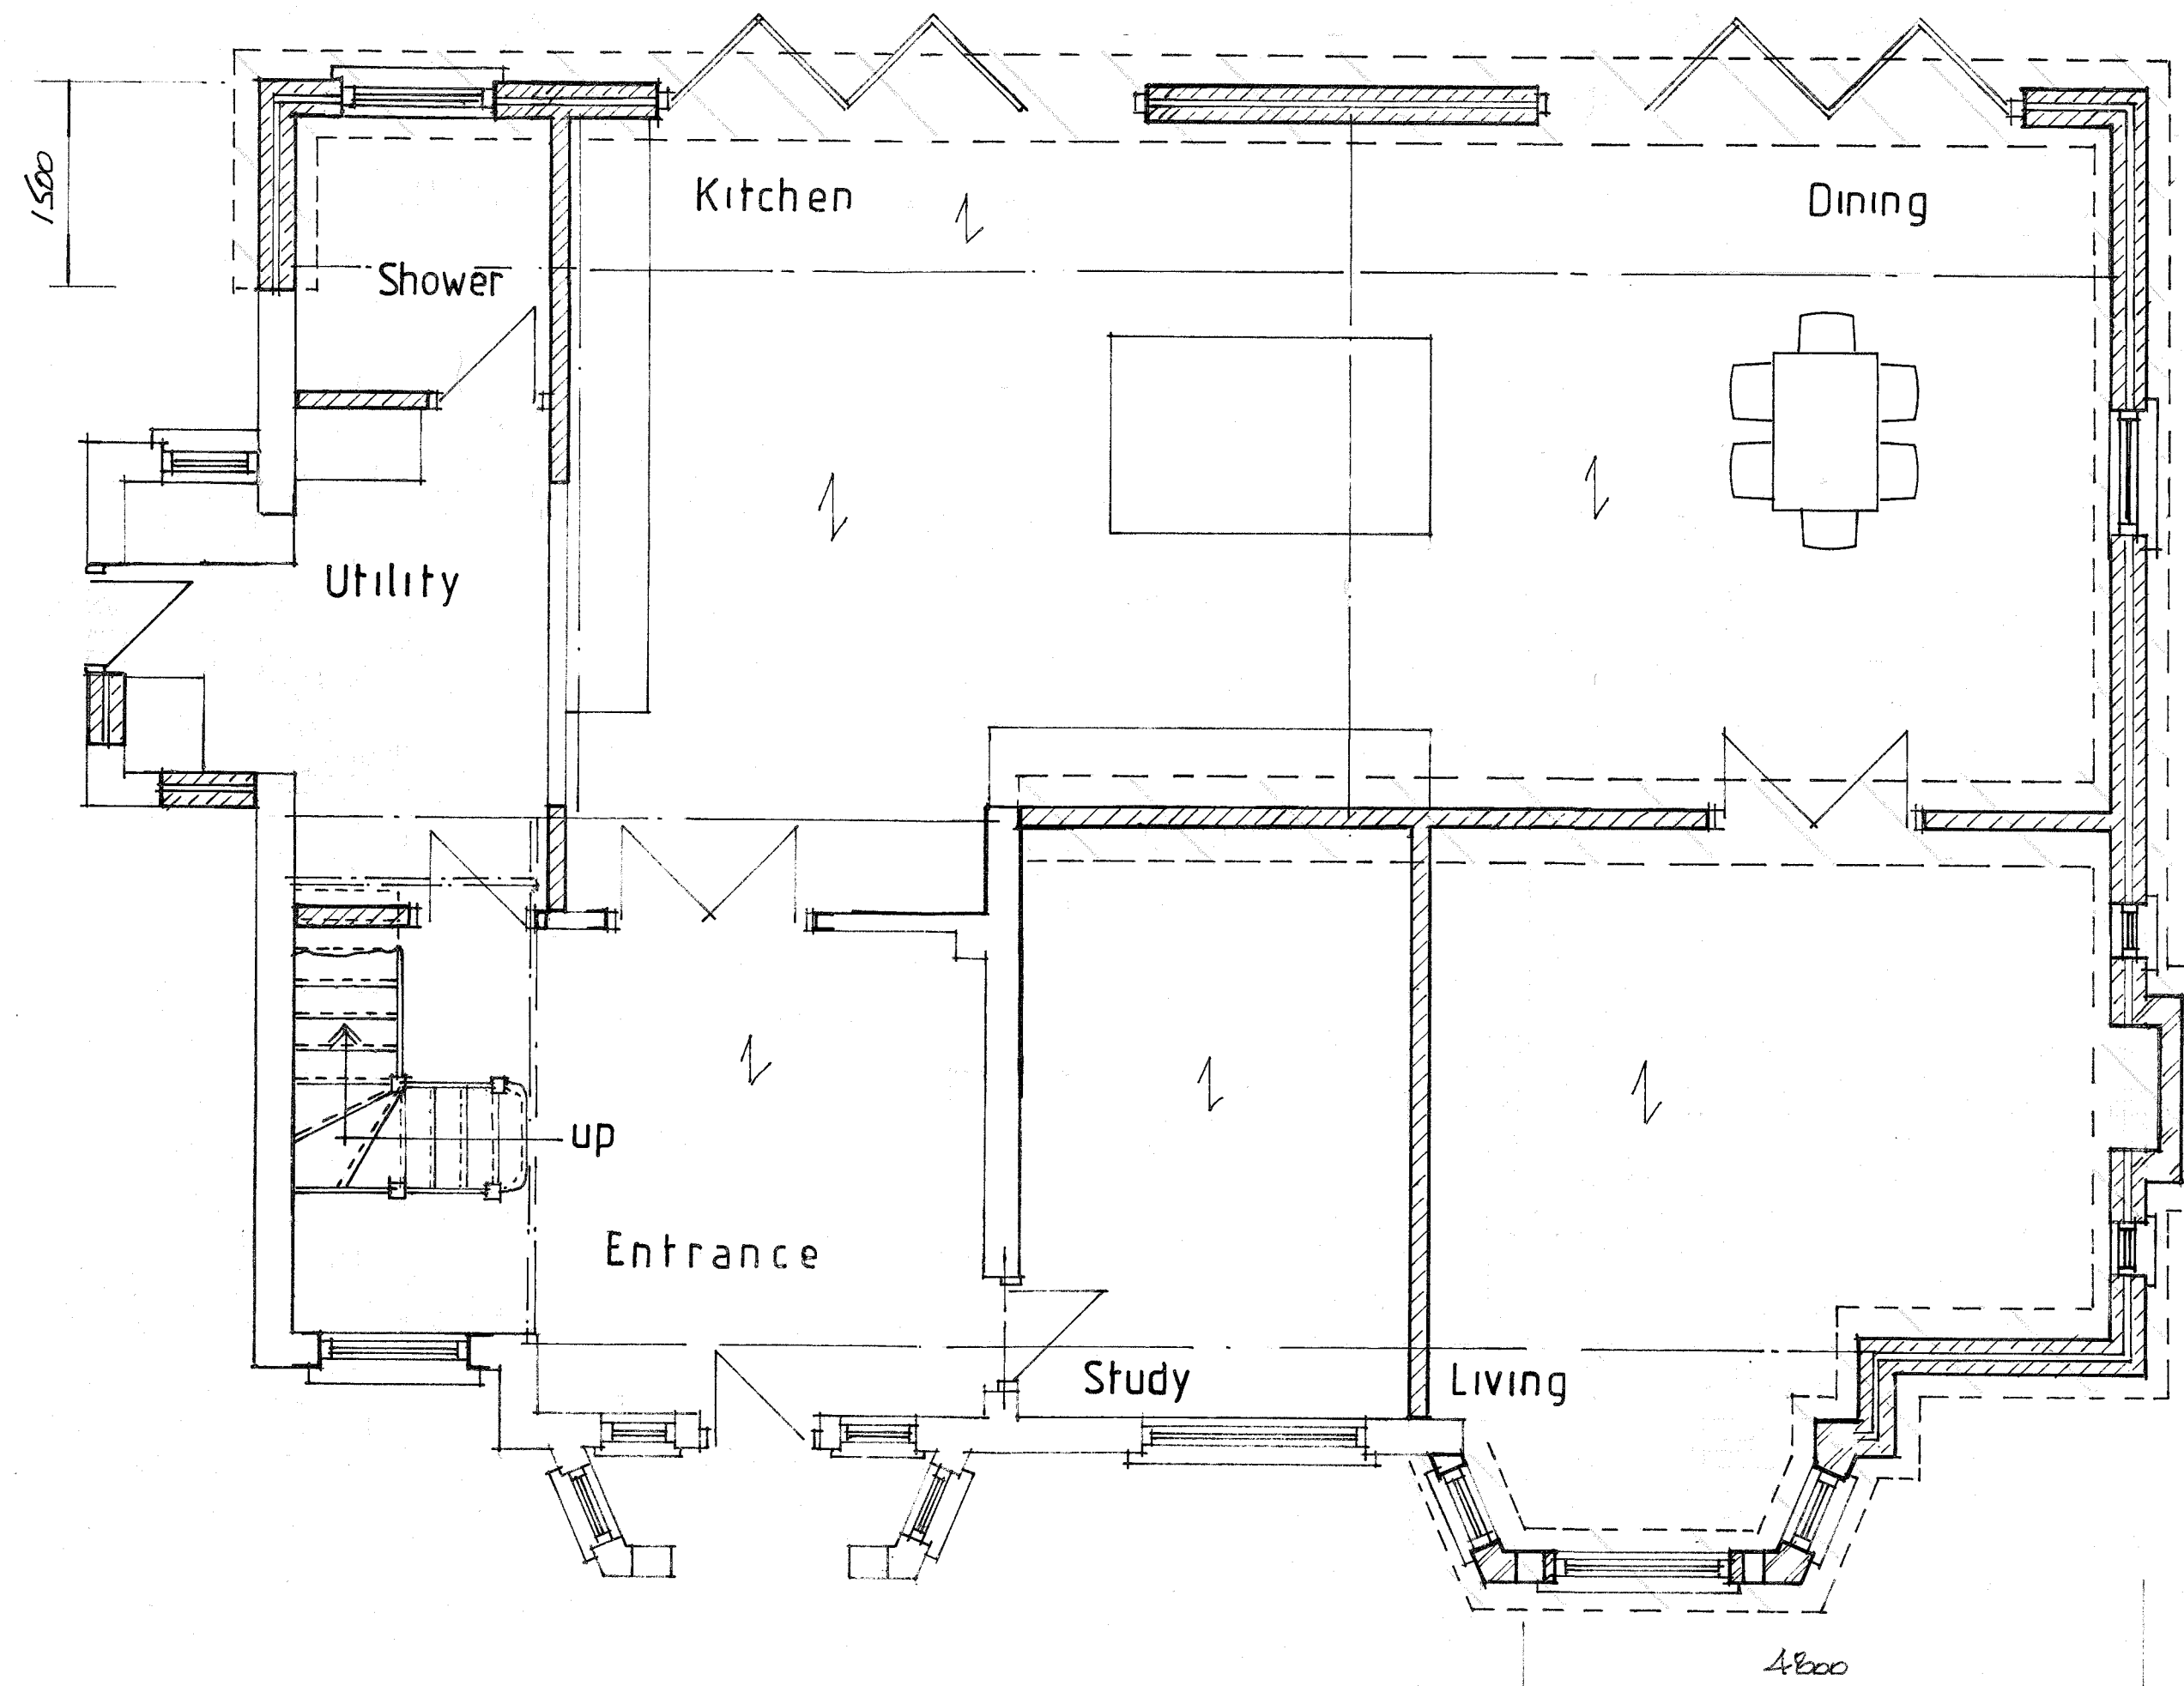


PROPOSED GROUND FLOOR PLAN

MATERIALS

Roof Tiles - Redland Rosemary (existing)
Weatherboard - White RAL9016 (data sheet attached)
Bricks - Reclaimed multi wire cut (slips) to match existing

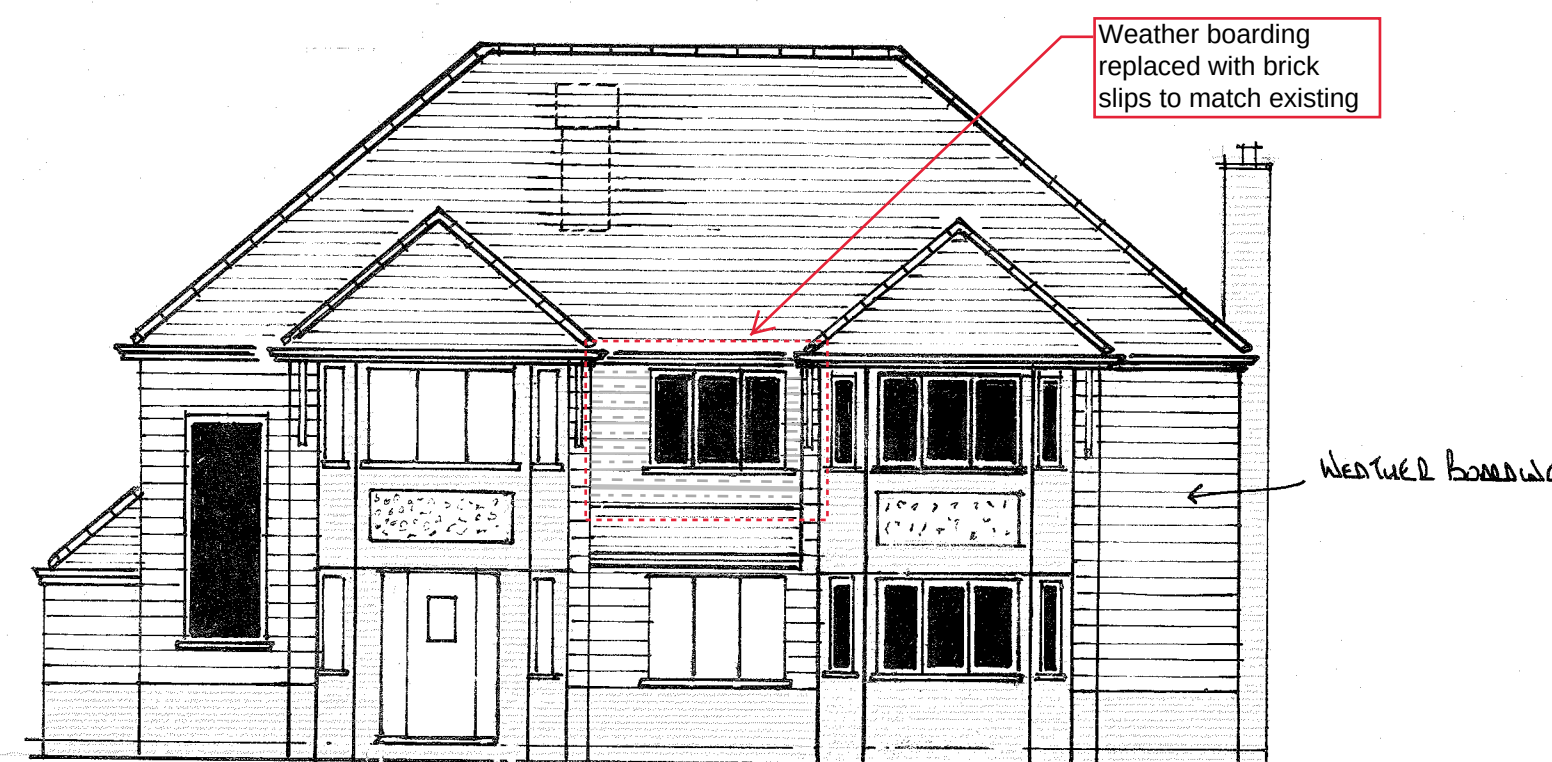


FRONT ELEVATION

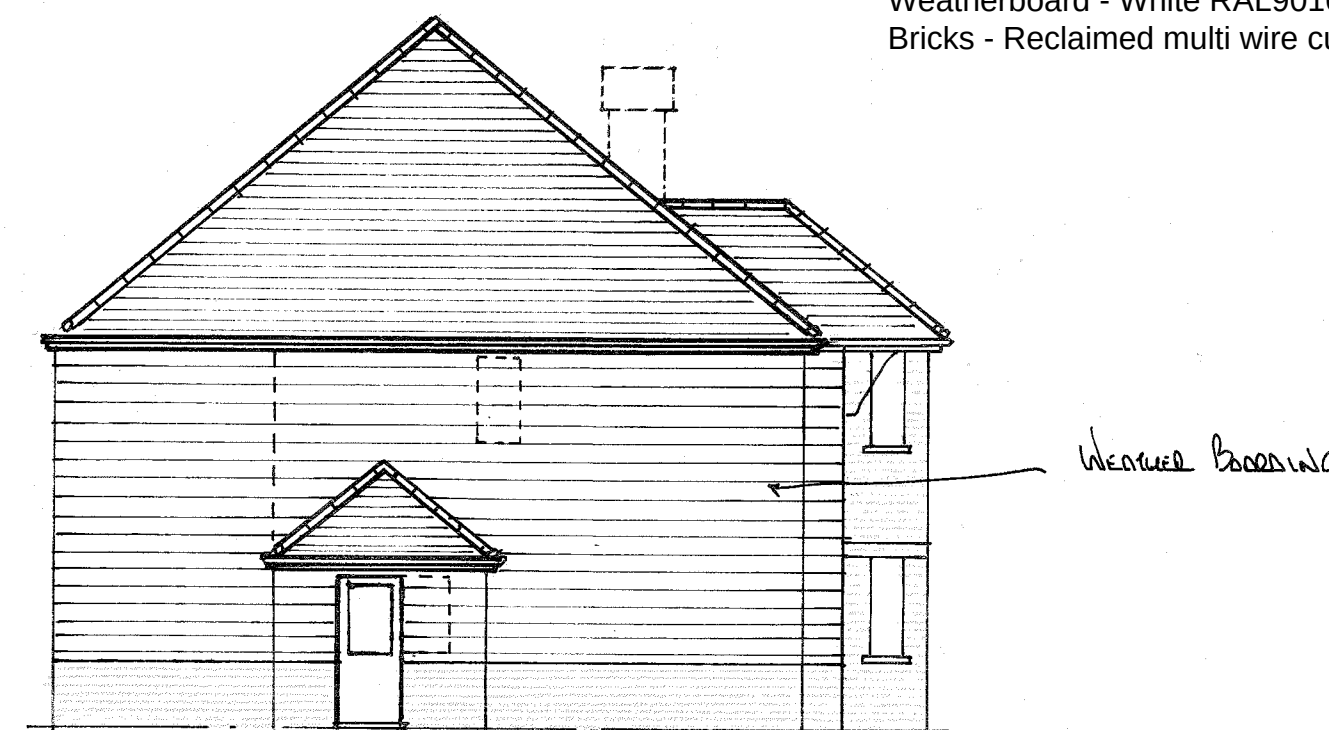


SIDE ELEVATION



REAR ELEVATION

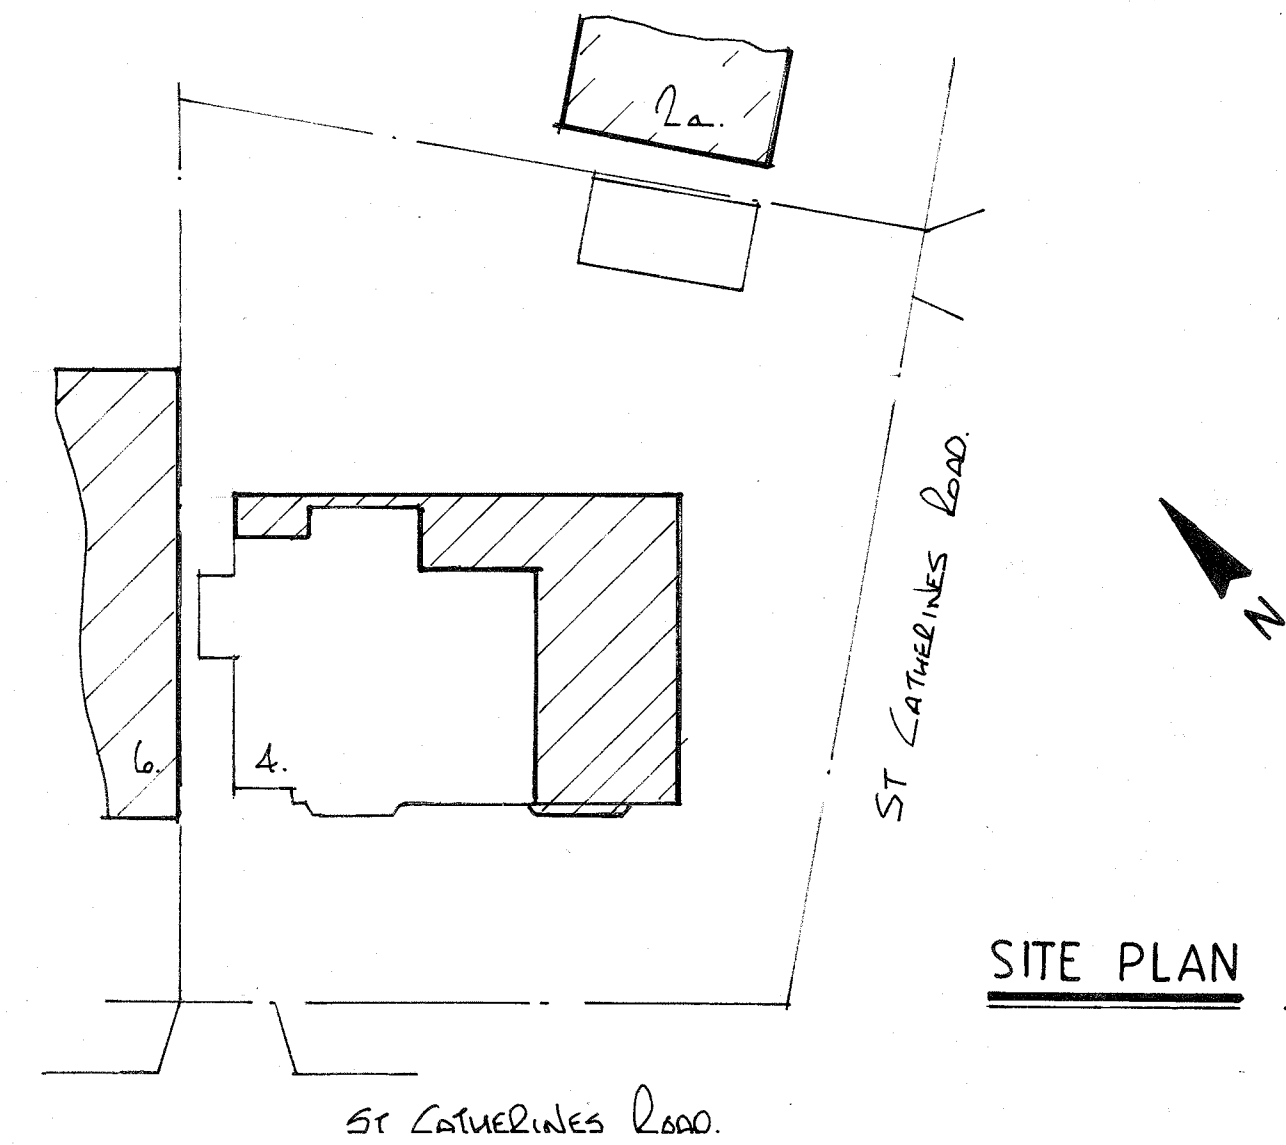

SITE PLAN scale 1:250

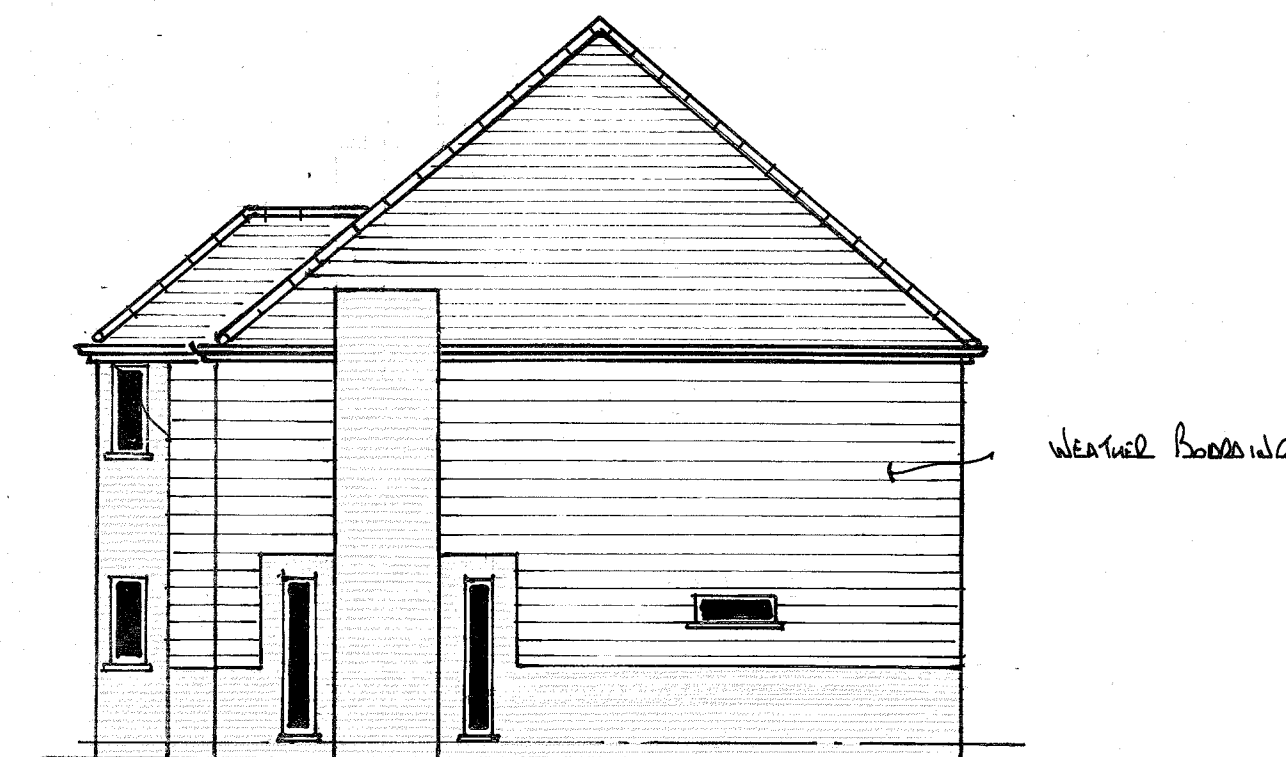

SIDE ELEVATION

C	JAN 2023	Materials annotations
B	Nov 2021	Rev'd to sort of built materials
A	Jul 2021	Rev'd to sort of built materials
	Date	Revisions

© copyright

Pottle & Co Ltd
Planning & Building Consultants

Suite A, 128 Manor Way
Ruislip, Middlesex, HA4 8HR

Tel: 01895 622800
www.pottle.uk.com

Client
MR P REYNOLDS

Job Title
4 ST CATHERINES ROAD
RUISLIP
MIDDX

Drawing Title
PROPOSED GROUND
FLOOR PLAN AND
ELEVATIONS
(as built materials)

Scale
1:50, 100, 250

Date
Dec 2021

Drawn by
GEL

Drg No.
4547/02

Rev.
C