



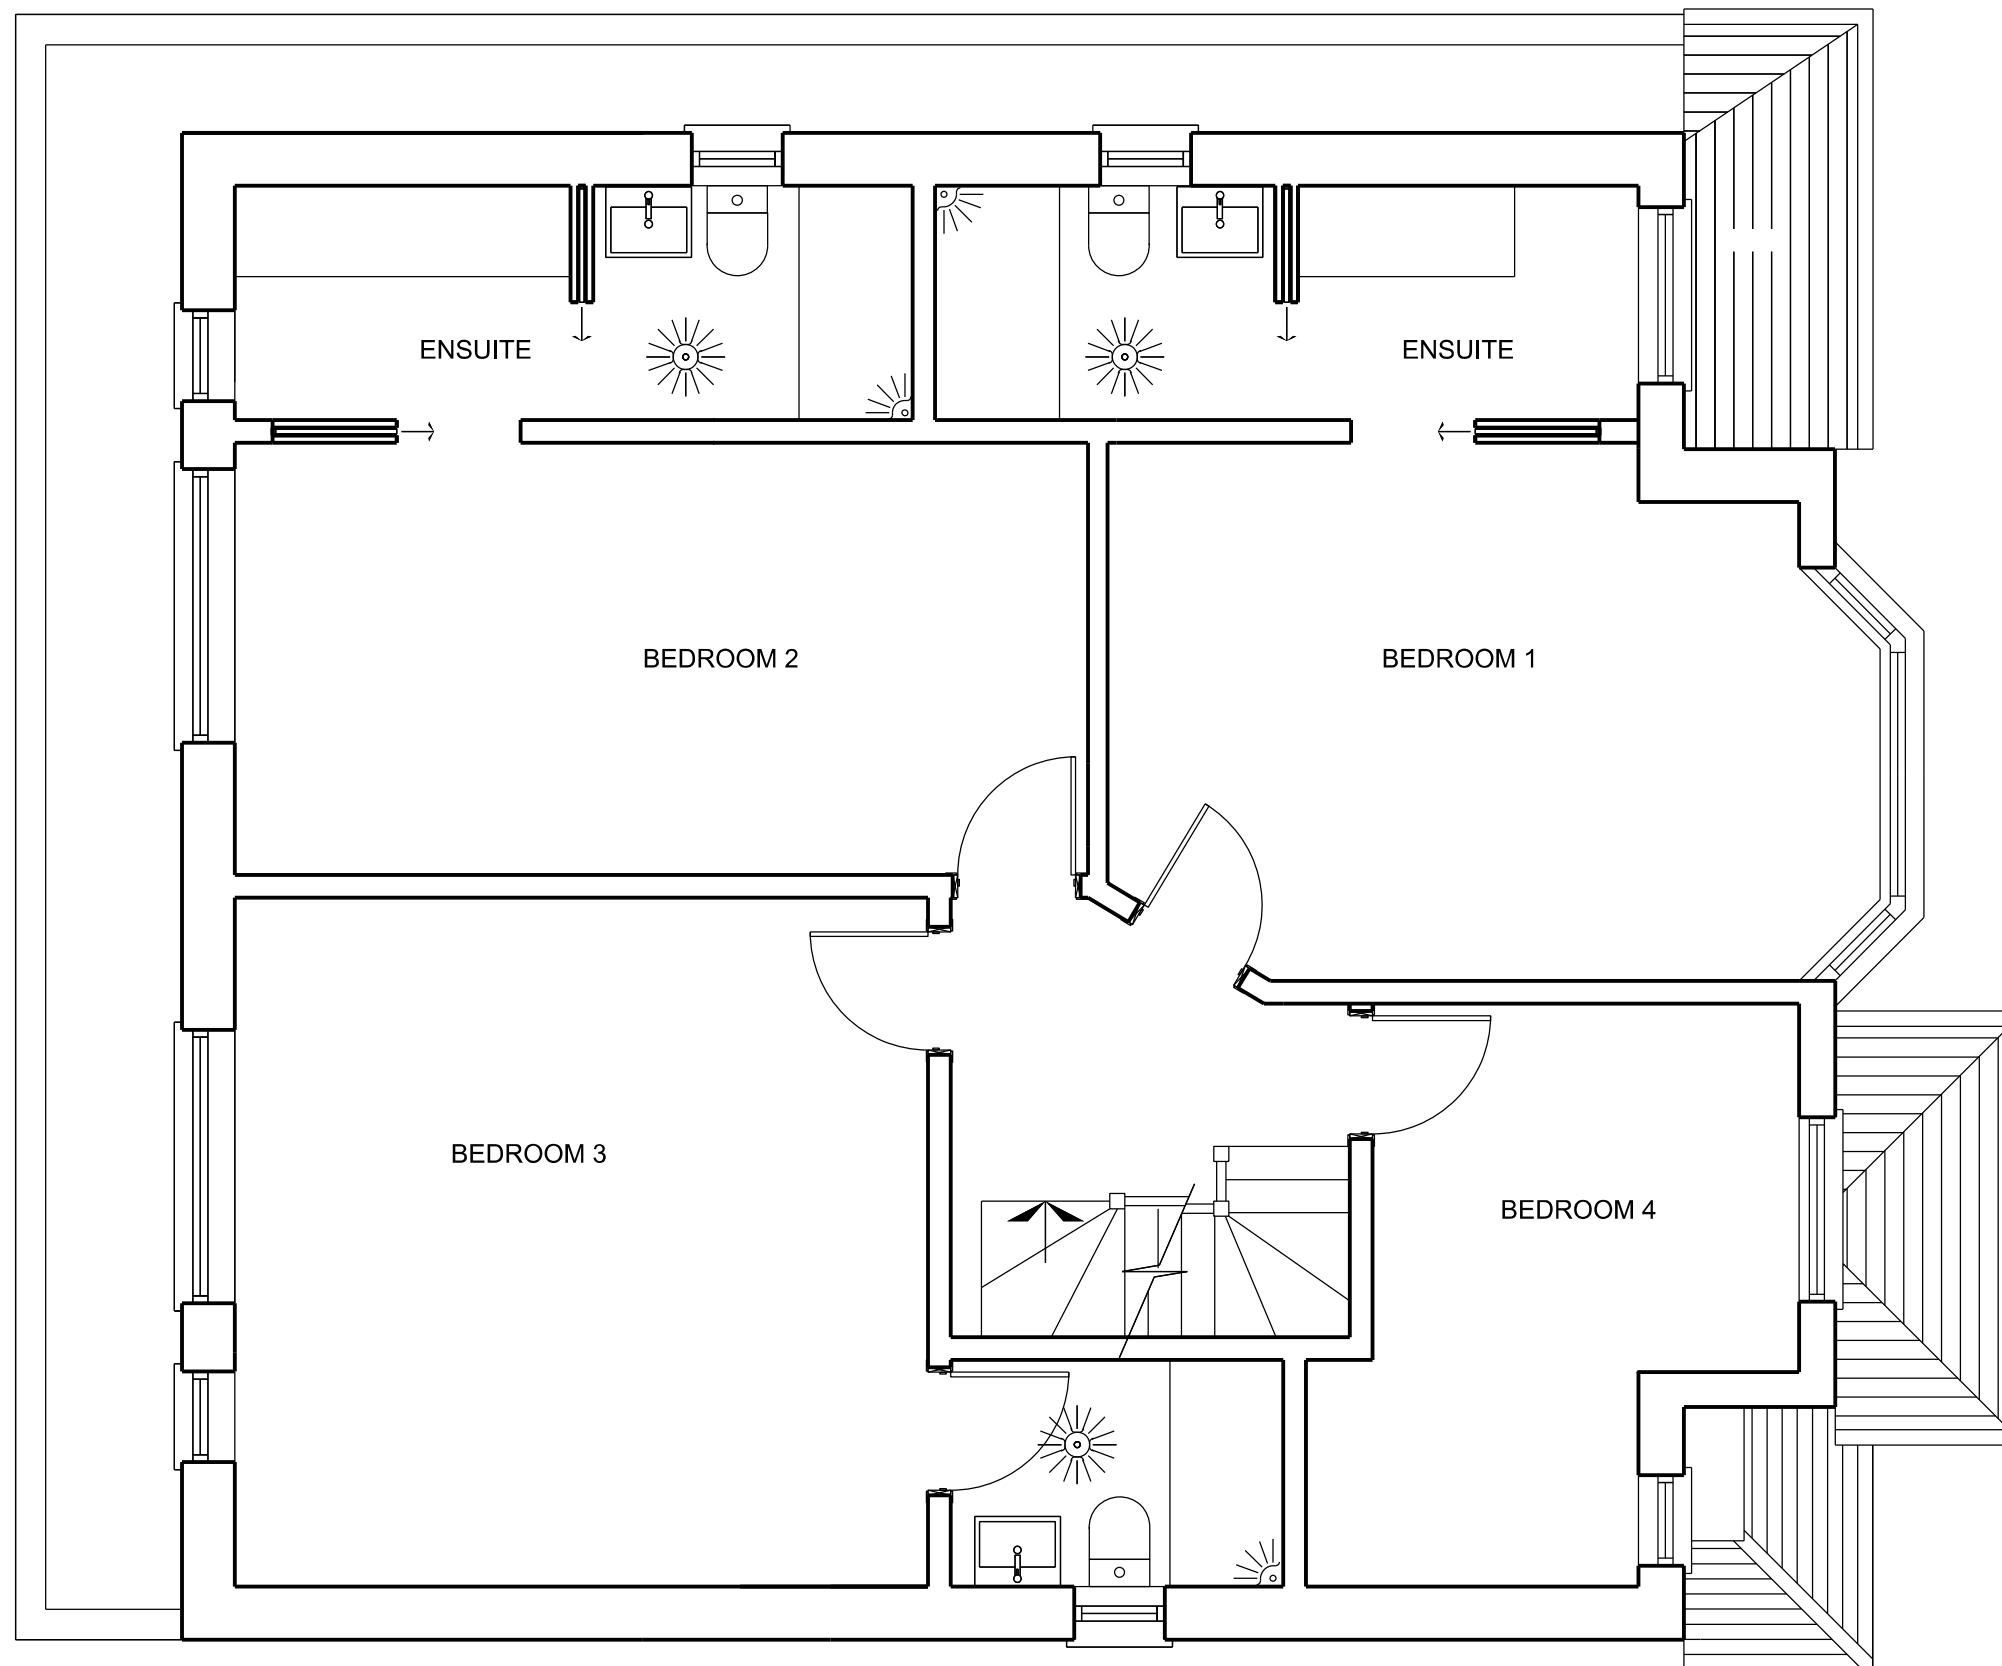

01

AS-BUILT FIRST FLOOR PLAN

SCALE 1:50

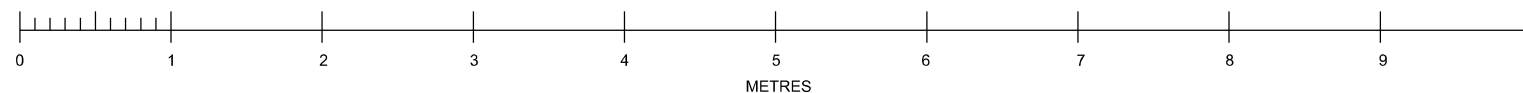

	18/11/2023	Planning
REV.	DATE	REASON FOR ISSUE
Project Address: 61 Thornhill Road		
Ickenham		
UB10 8SQ		
Description: As built on site.		
SCALE:	1:50@A3	ZUB1002