


01

AS-BUILT GROUND FLOOR PLAN

SCALE 1:50

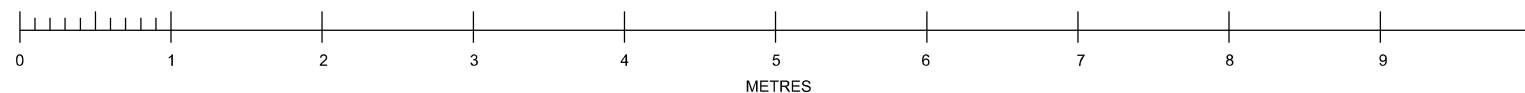

| | | |
|------------------------------------|------------|------------------|
| | | |
| | | |
| REV. | DATE | REASON FOR ISSUE |
| | 16/11/2023 | Planning |
| Project Address: 61 Thornhill Road | | |
| Ickenham | | |
| UB10 8SQ | | |
| Description: As built on site. | | |
| SCALE: 1:50@A3 | | |
| ZUB1001 | | |