


	16/11/2023	Planning
REV.	DATE	REASON FOR ISSUE
Project Address: 61 Thornhill Road		
Ickenham		
UB10 8SQ		
Description: As built on site.		
SCALE: 1:1250@A3		
ZUB1009		

02

LOCATION PLAN

SCALE 1:1250

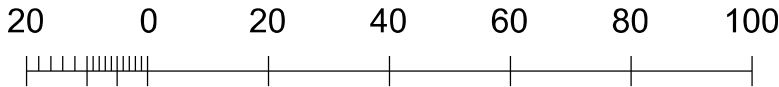

Metres