


01

AS-BUILT LOFT PLAN

SCALE 1:50

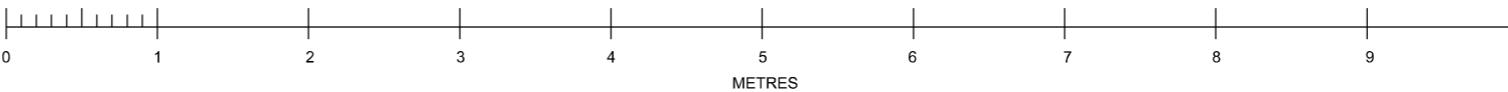

16/11/2023	Planning	
REV.	DATE	REASON FOR ISSUE
Project Address: 61 Thornhill Road Ickenham UB10 8SQ		
Description: As built on site.		
SCALE: 1:50@A3		
ZUB1003		