



01 AS-BUILT SIDE ELEVATION

SCALE 1:100

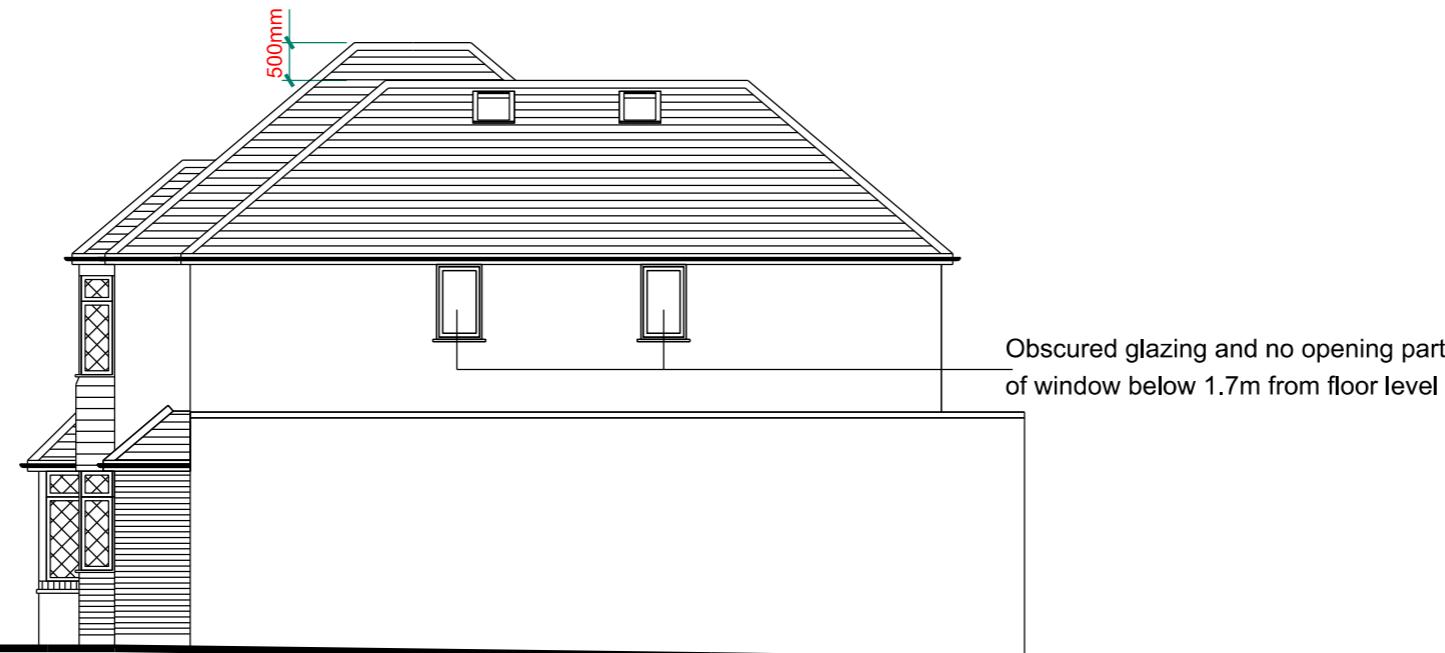

02 AS-BUILT SIDE ELEVATION

SCALE 1:100

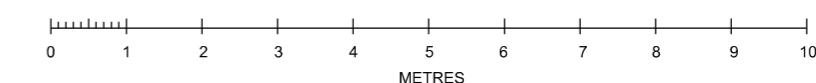

16/11/2023	Planning
REV.	DATE
REASON FOR ISSUE	
Project Address: 61 Thornhill Road Ickenham UB10 8SQ	
Description: As built on site.	
SCALE: 1:100@A3	
ZUB1006	