



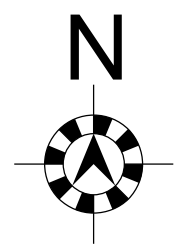

01 AS-BUILT SITE PLAN
SCALE 1:200

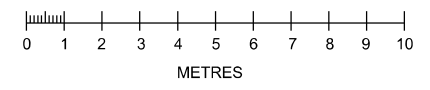

	18/11/2023	Planning
REV.	DATE	REASON FOR ISSUE
Project Address: 61 Thornhill Road		
Ickenham		
UB10 8SQ		
Description: As built on site.		
SCALE: 1:200@A3		
ZUB1007		