

PROJECT	DWG NO.	SCALE	DETAIL	09.02.2015	A	B	C	D	E	PROJECT NO.
NAMASTE LOUNGE, JOEL STREET, NORTHWOOD HILLS	02	1:100 @ A1	PROPOSED PLANS AND ELEVATIONS	ISSUED TO PLANNING DEPT. HILLINGDON						15.05
AS BUILT OUTDOOR SMOKING LOUNGE										




PR

Architecture ltd.


Chartered Architect

120, Pinner Road, Harrow, HA1 4JD.


Tel: 0208 357 2304

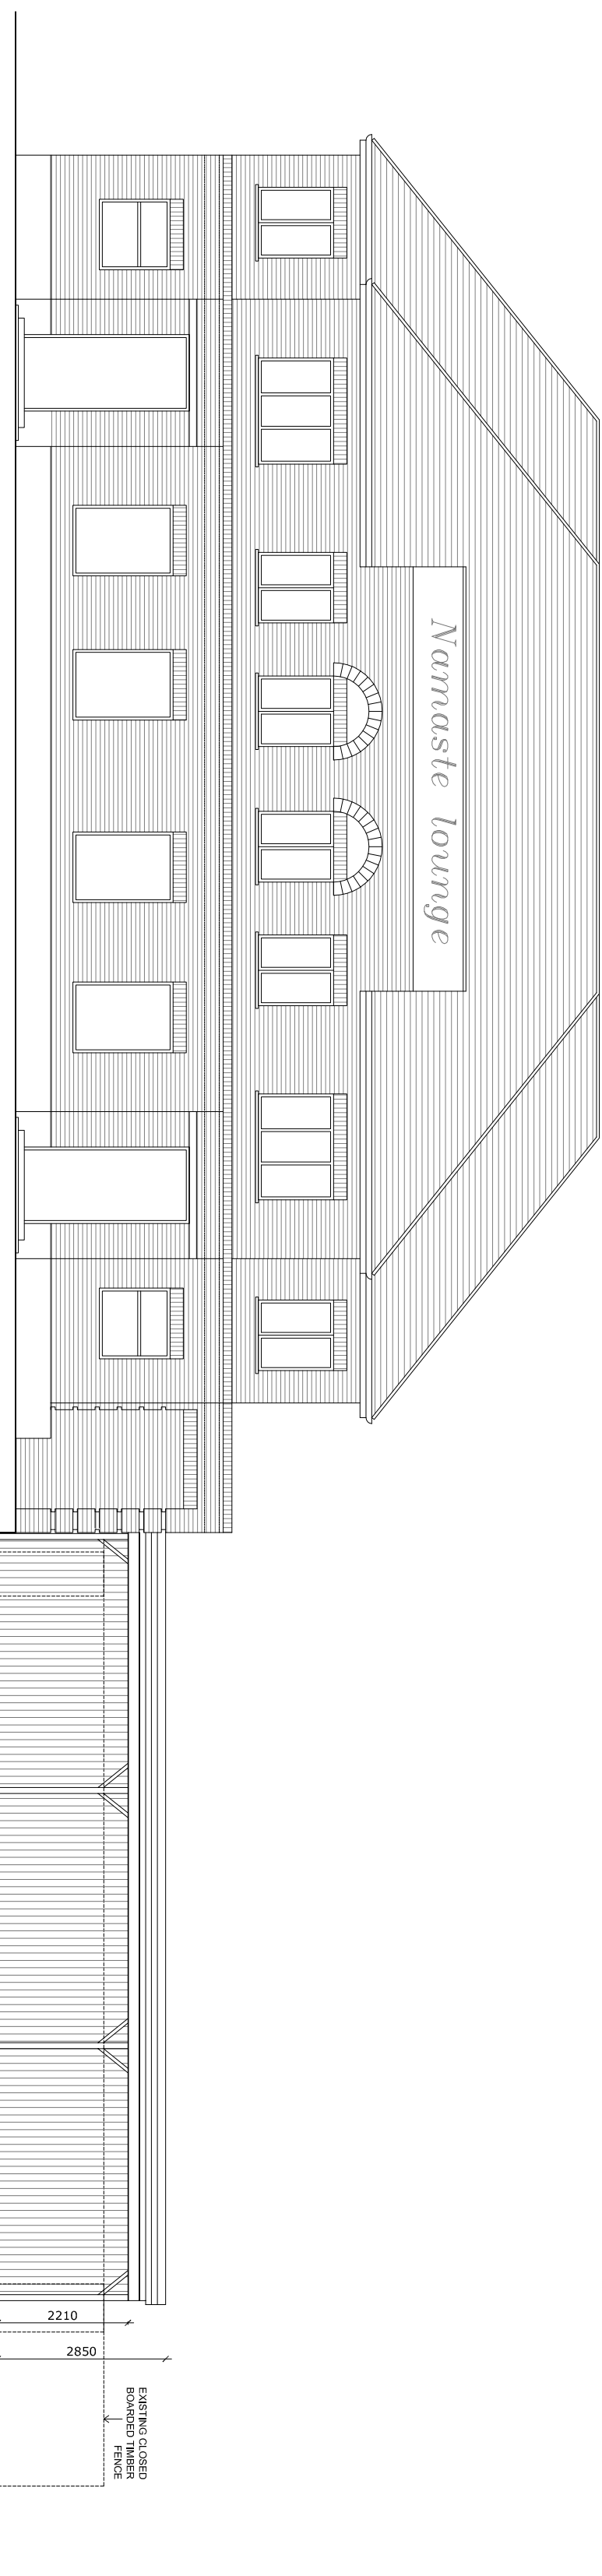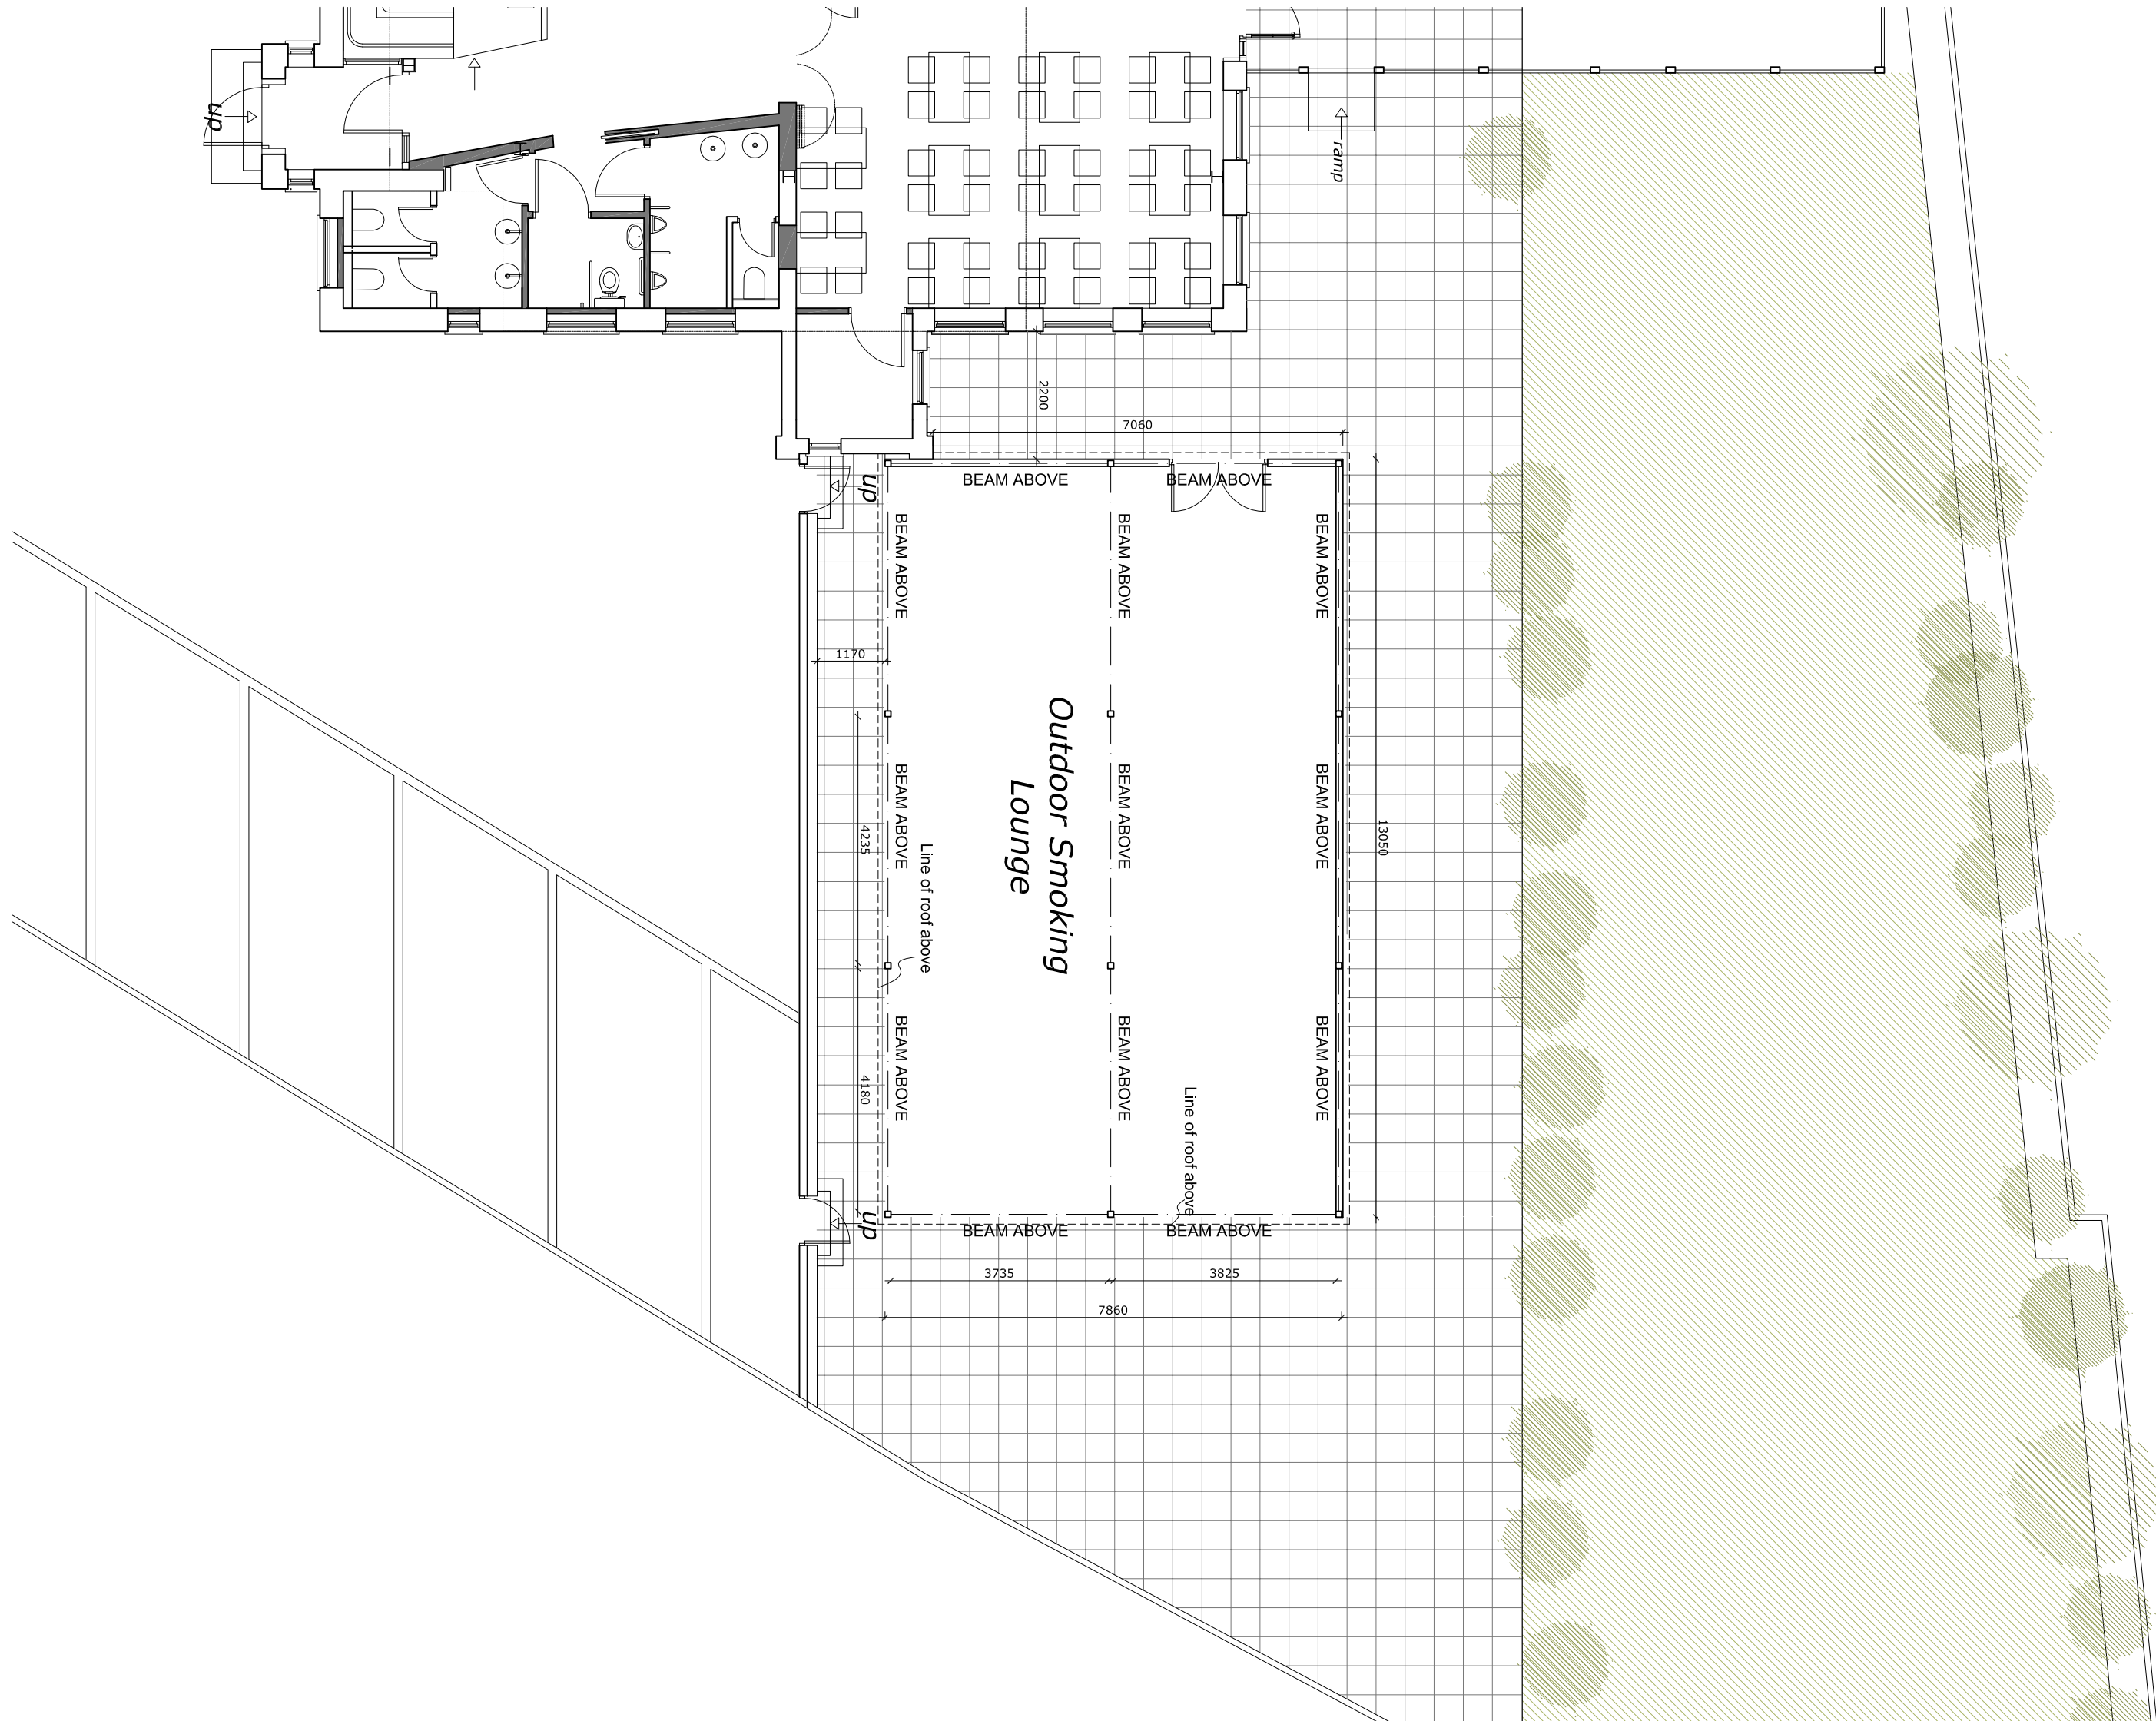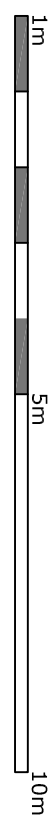


FRONT ELEVATION

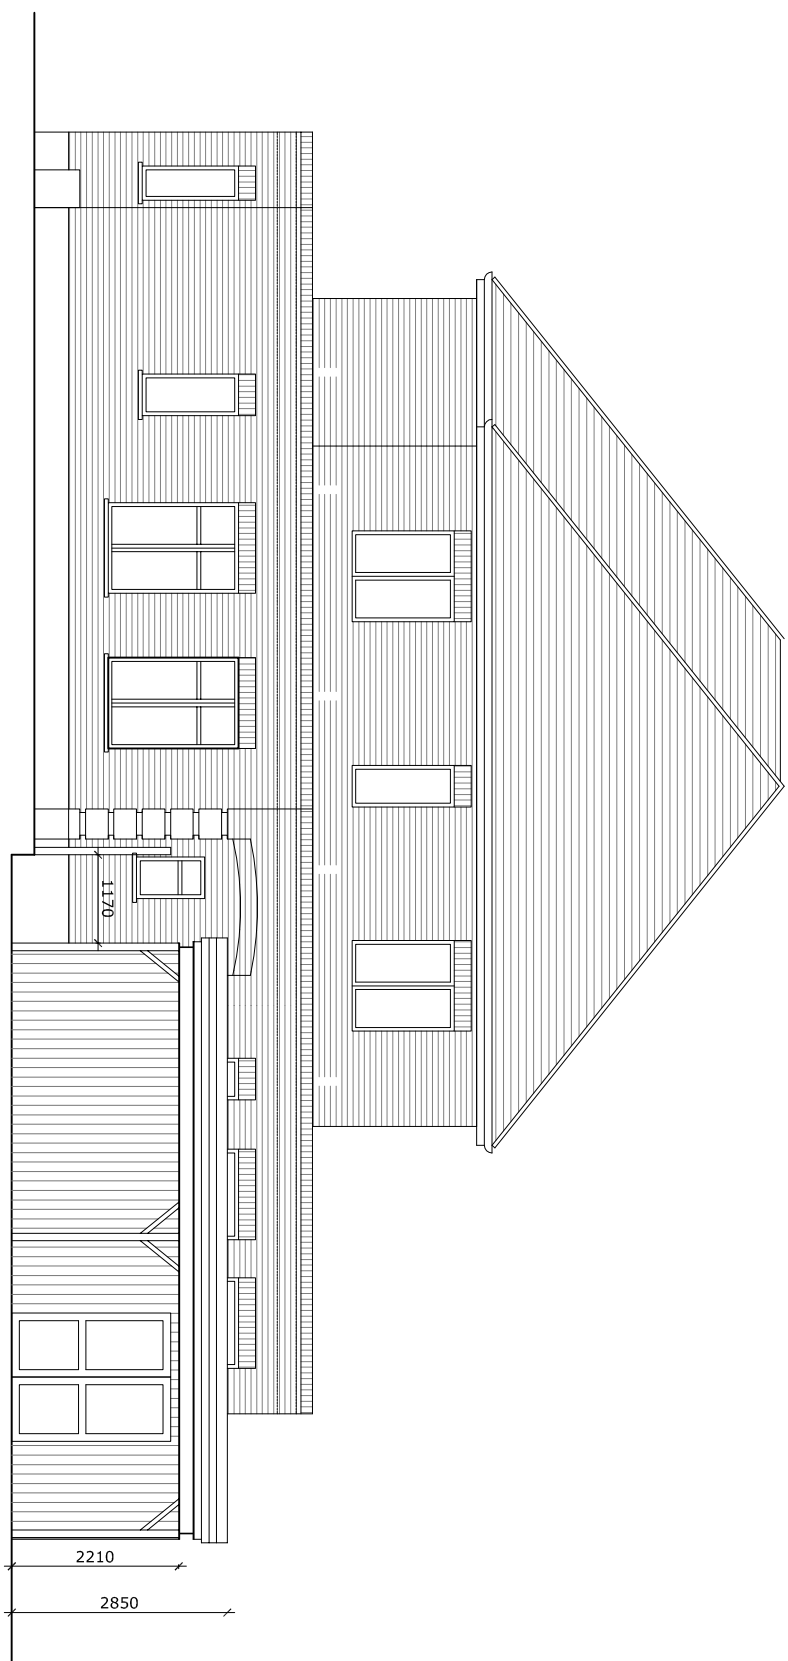


SIDE ELEVATION

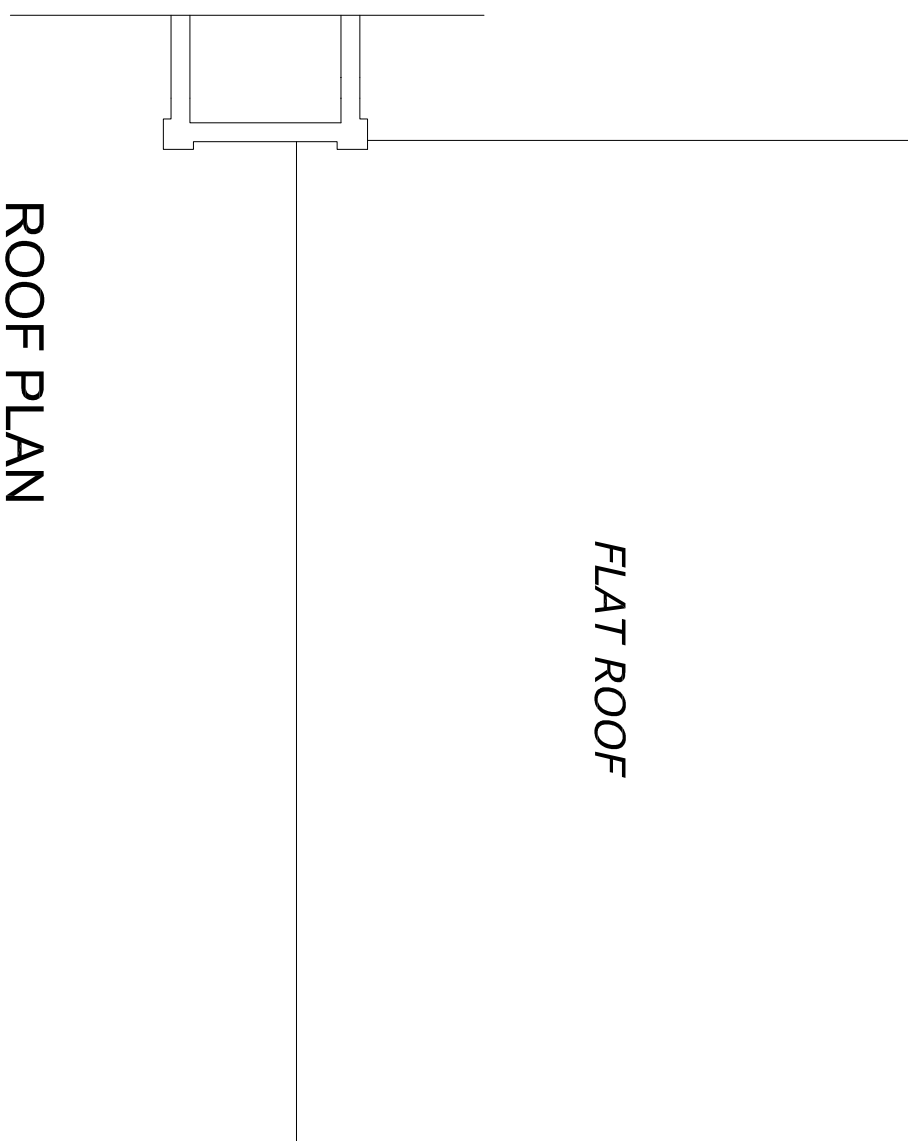

ROOF PLAN

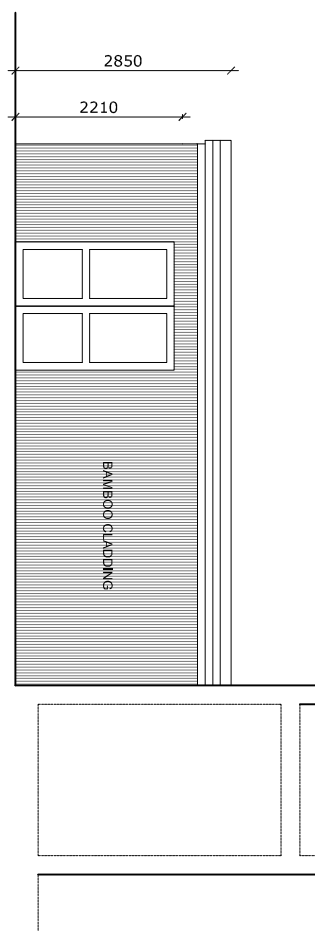

SIDE ELEVATION

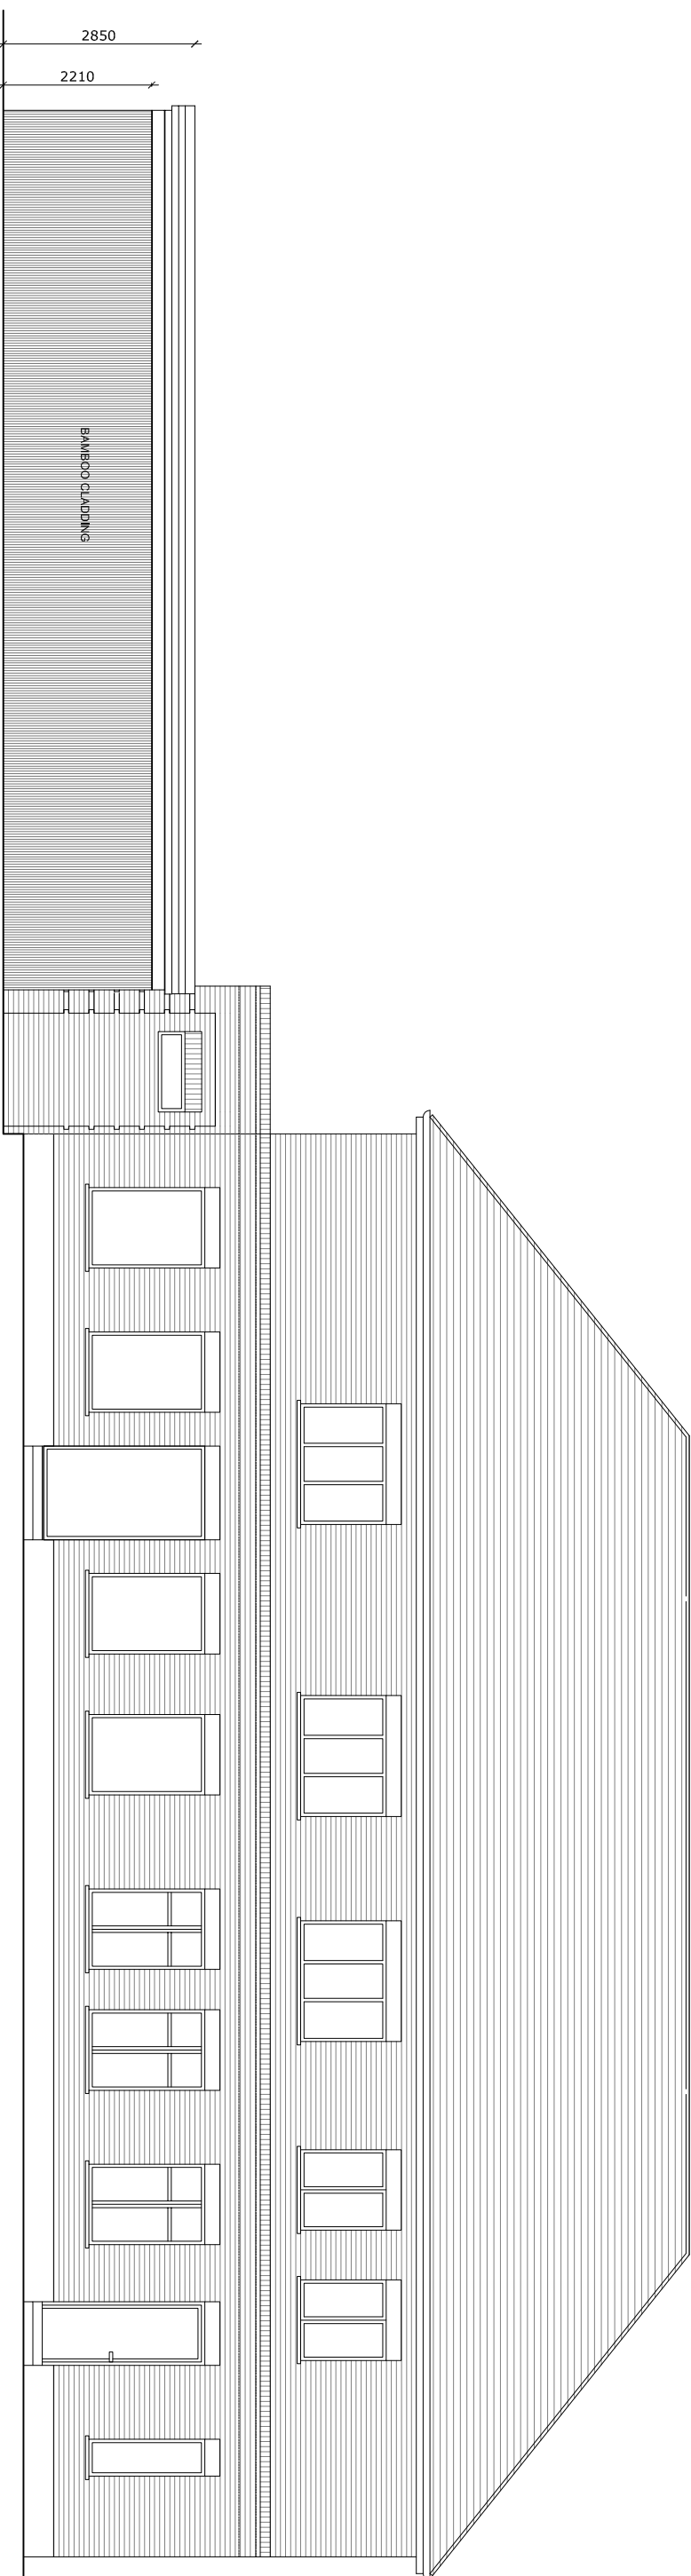

REAR ELEVATION