


Copyright in design and this drawing is the property of Resi and Design Squared.

Reproduction in whole or in part is forbidden without written sanction of Resi and Design Squared.

All dimensions to be cross-checked on site prior to completing a Building Regulations package, structural engineering, the party wall process and construction.

Print to scale (as actual size)

NOTES

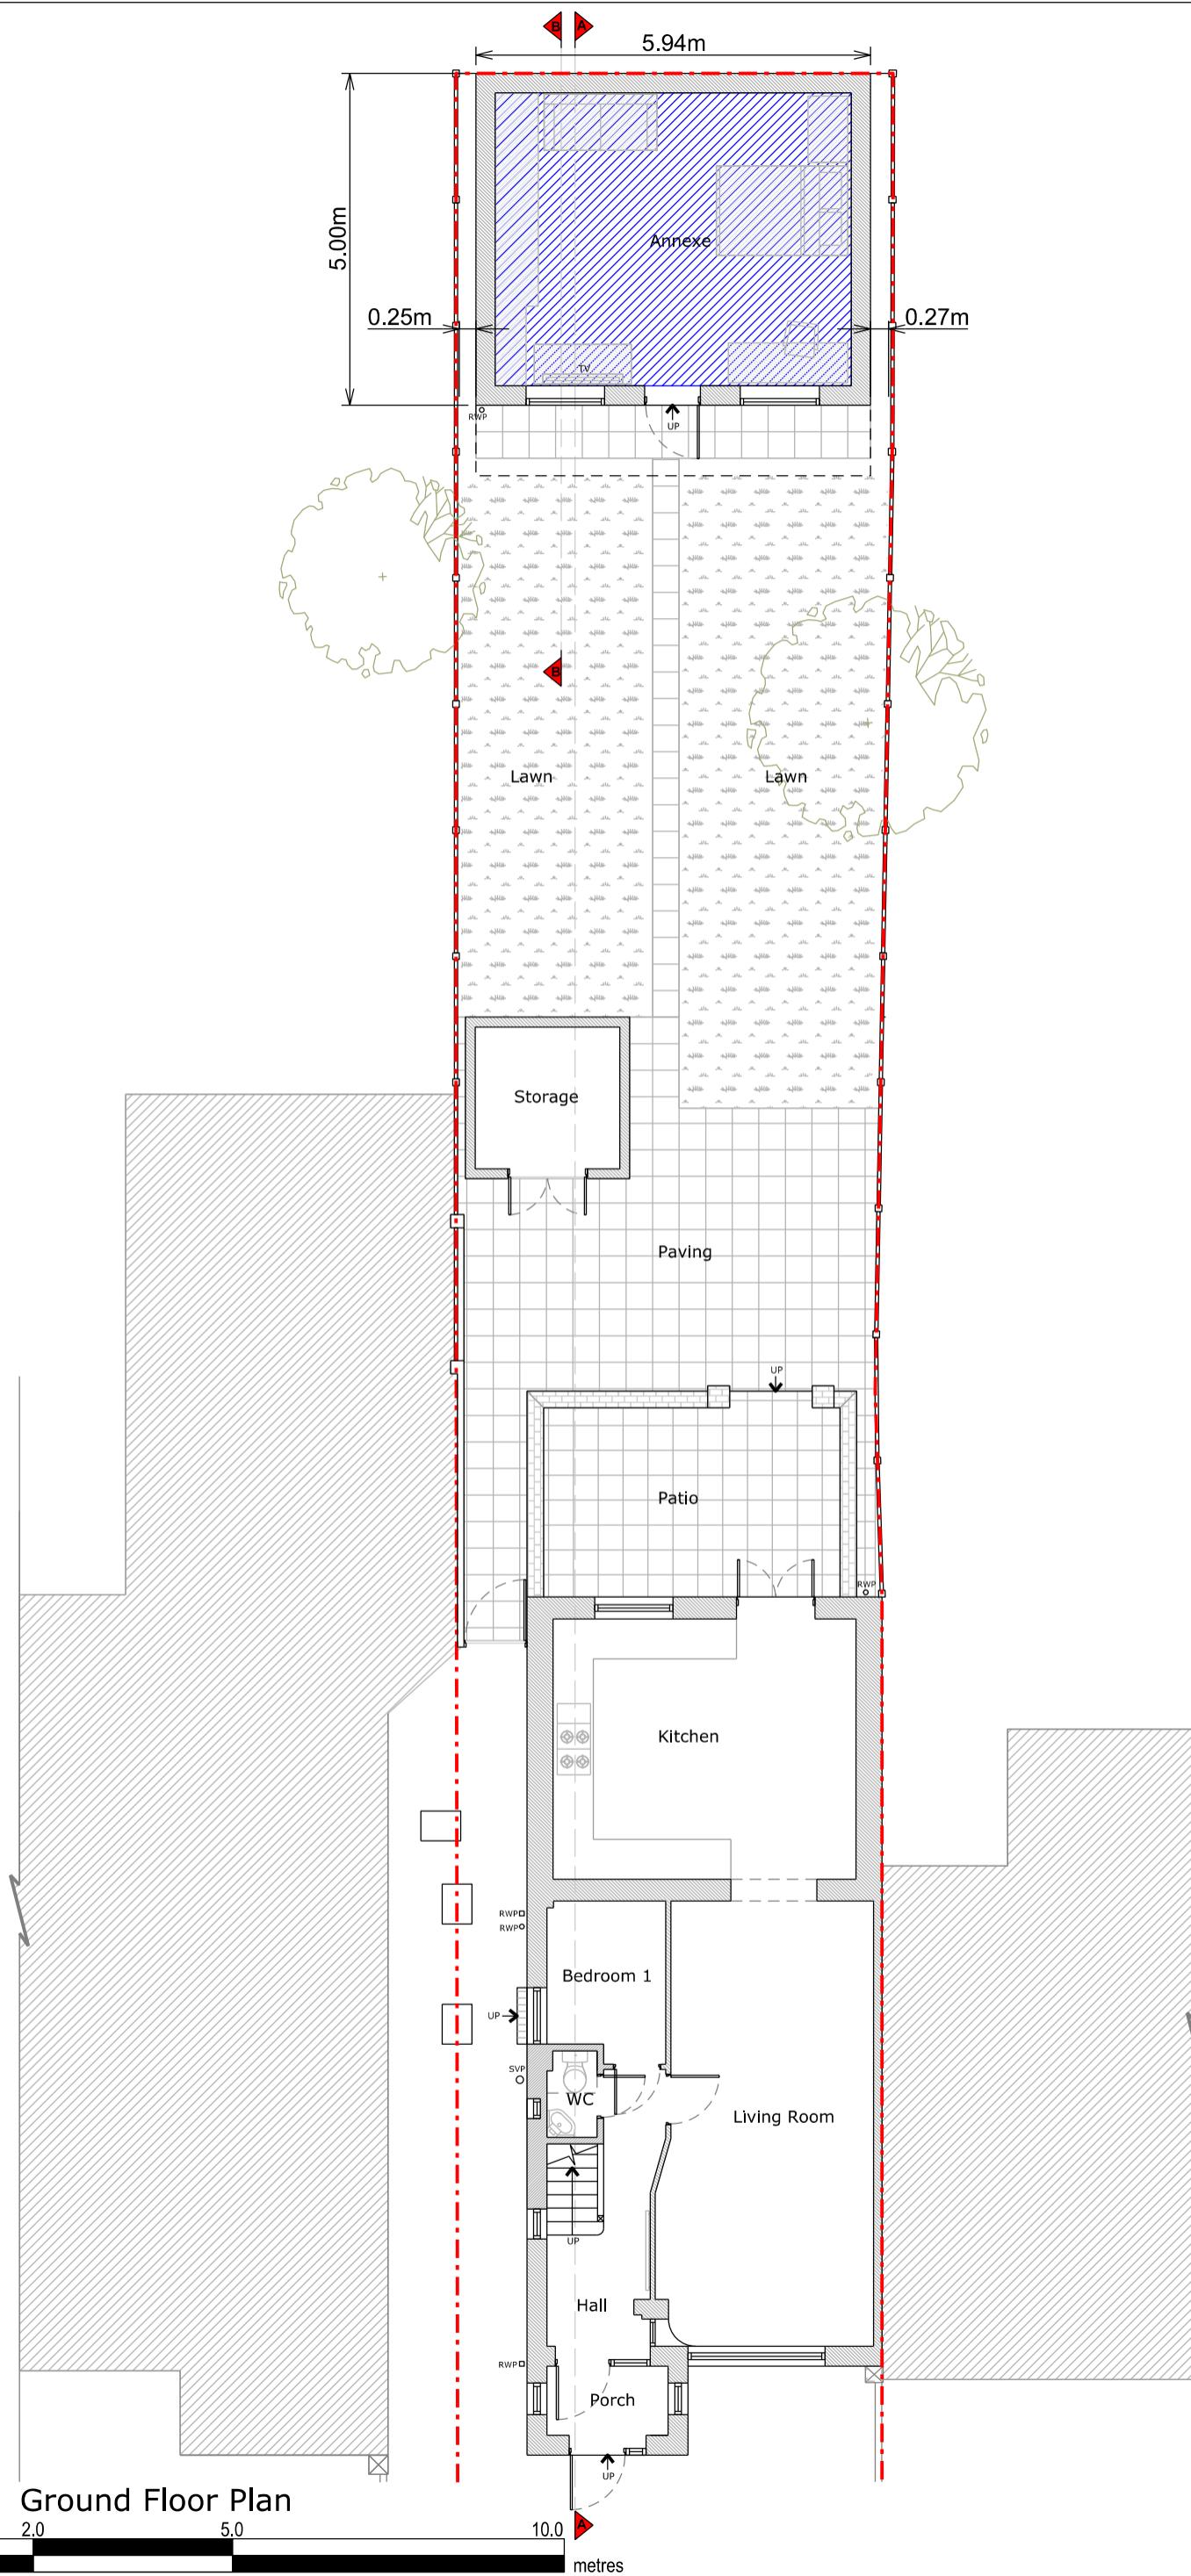

Revision

Rev	Notes	Date
- A	Preliminary Issue Planning	23/09/2024 21/10/2024

KEY

As - Built annexe	Boundary lines
Existing walls	Proposed beam
Existing removed	Proposed drainage
Proposed rooflight	1.8m head height
	1.5m head height

JOB TITLE

Lawful development certificate application for existing use of an outbuilding as a residential annexe at 9 Chaucer Avenue, Hayes UB4 0AP

STATUS	Planning
--------	----------

DRAWING TITLE	As - Built Ground Floor Plan
---------------	------------------------------

CLIENT	Gudria Choudrey
--------	-----------------

SCALE	1:100 at A3
DRAWN	LQ

DATE	Oct 2024
CHECKED	NS

DRAWING NO. 260502 - 01 - 101A

Copyright in design and this drawing is the property of Resi and Design Squared.

Reproduction in whole or in part is forbidden without written sanction of Resi and Design Squared.

All dimensions to be cross-checked on site prior to completing a Building Regulations package, structural engineering, the party wall process and construction.

Print to scale (as actual size)

NOTES

Revision

Rev	Notes	Date
- A	Preliminary Issue Planning	23/09/2024 21/10/2024

KEY

As - Built annexe	Boundary lines
Existing walls	Proposed beam
Existing removed	Proposed drainage
Proposed rooflight	1.8m head height
	1.5m head height

JOB TITLE

Lawful development certificate application for existing use of an outbuilding as a residential annexe at 9 Chaucer Avenue, Hayes UB4 0AP

STATUS

Planning

DRAWING TITLE

As - Built First Floor Plan

CLIENT

Gudria Choudrey


SCALE
1:100 at A3

DRAWN
LQ

DATE
Oct 2024

CHECKED
NS

DRAWING NO. 260502 - 01 - 102A

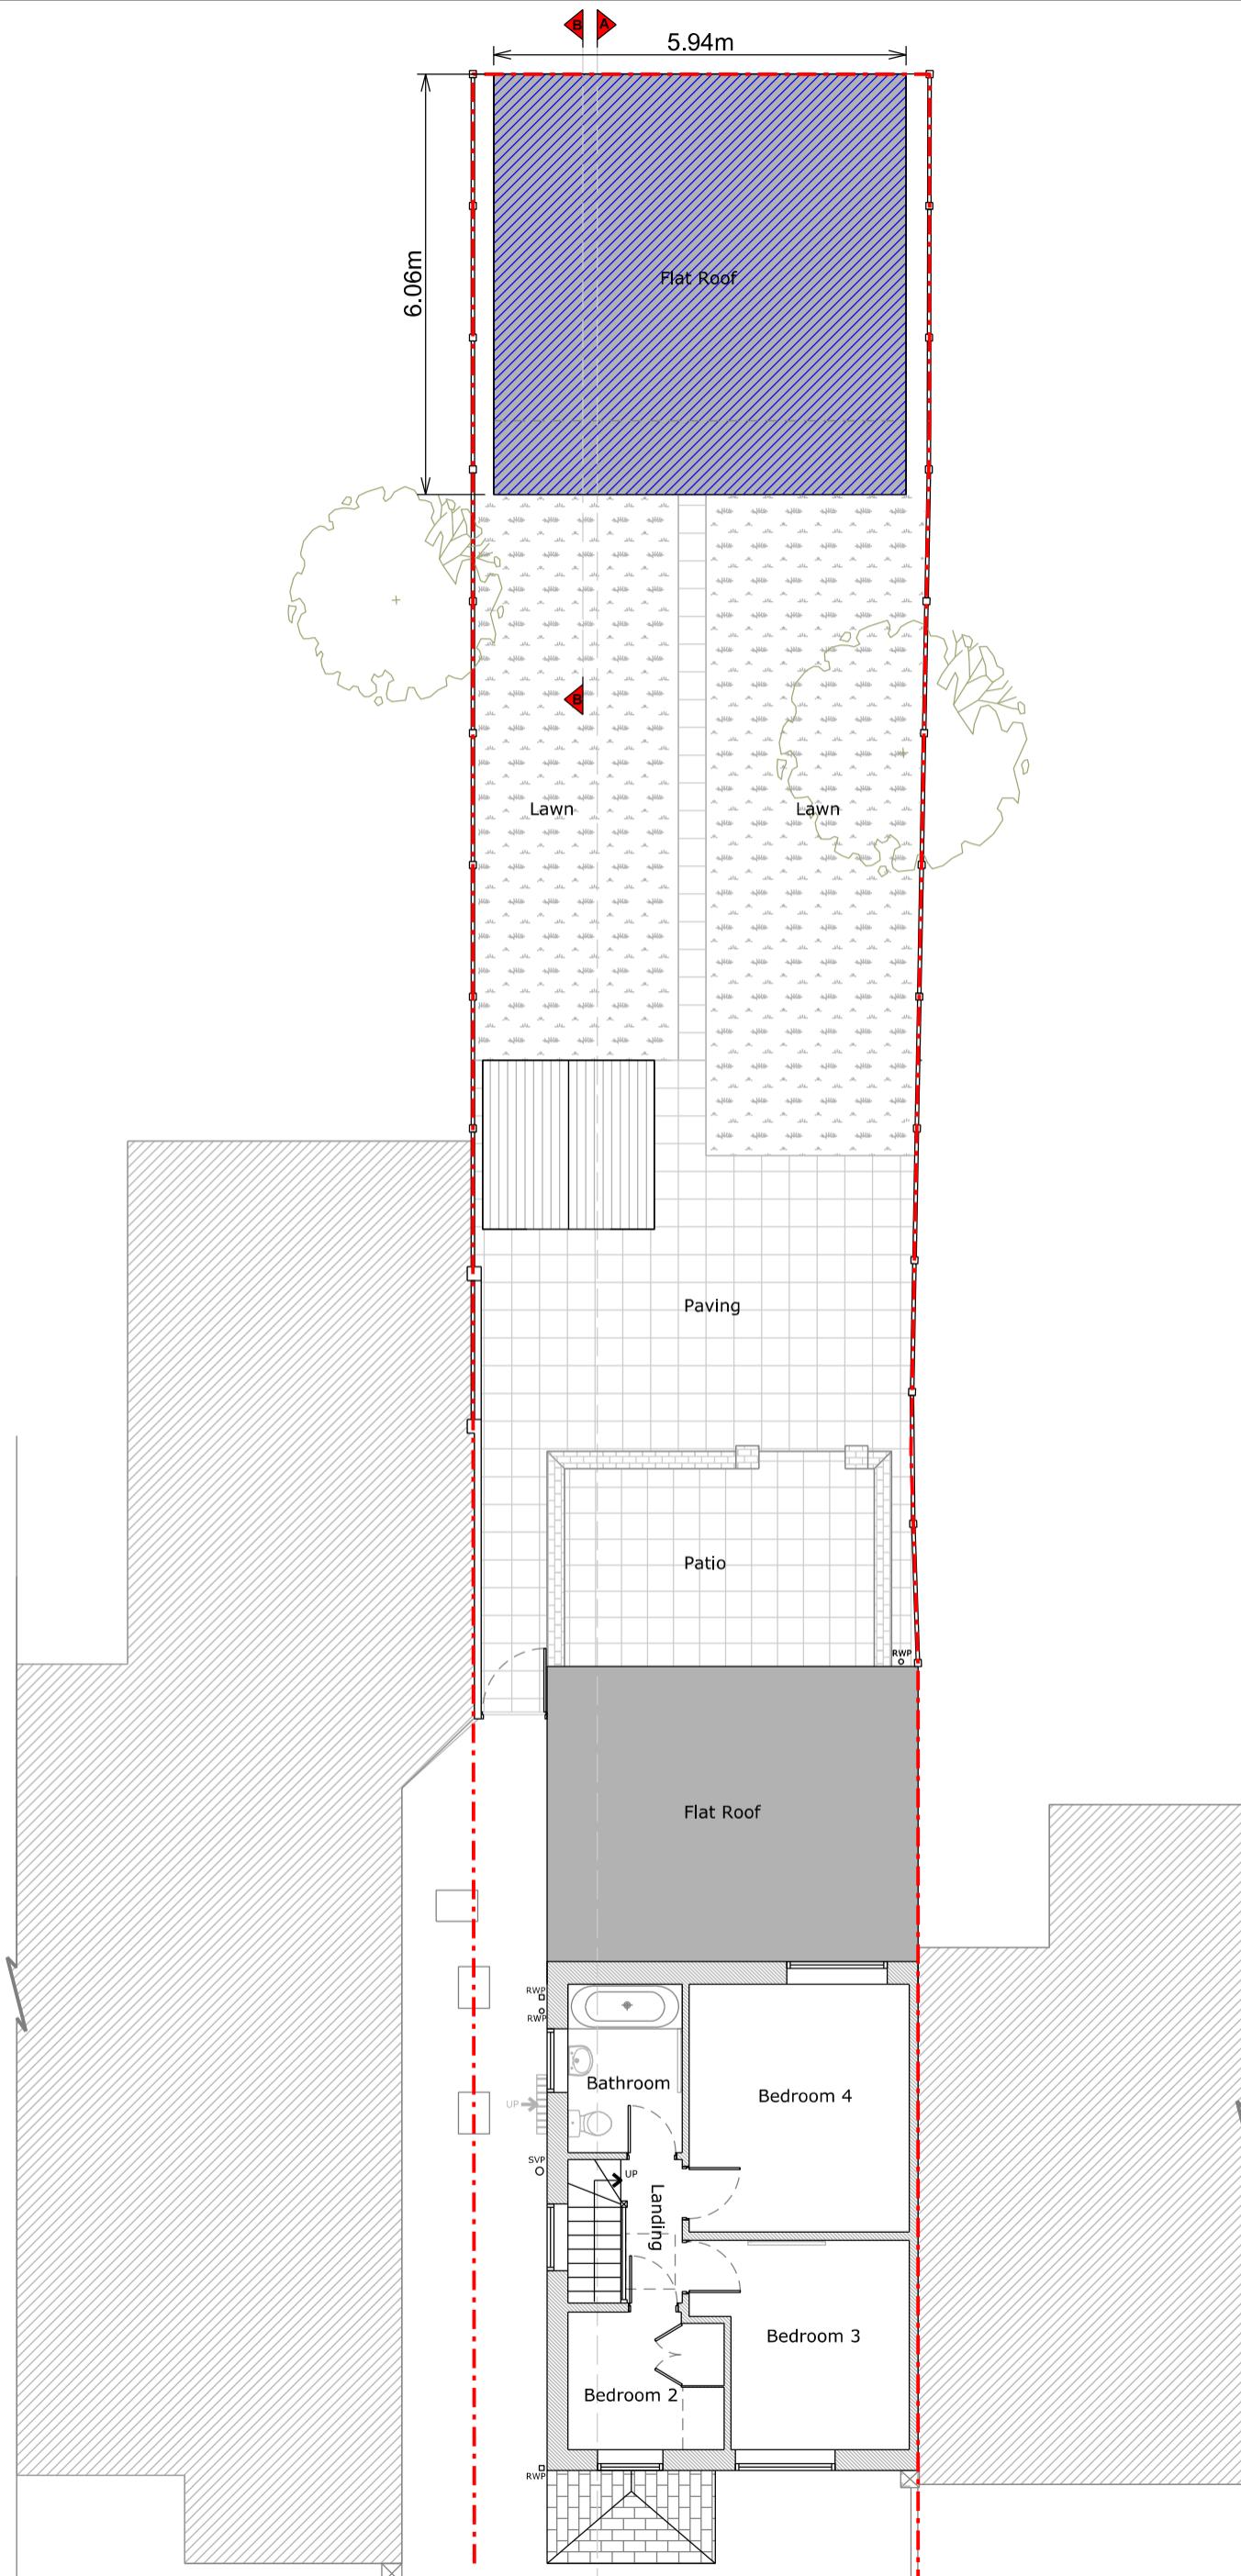


Copyright in design and this drawing is the property of Resi and Design Squared.

Reproduction in whole or in part is forbidden without written sanction of Resi and Design Squared.

All dimensions to be cross-checked on site prior to completing a Building Regulations package, structural engineering, the party wall process and construction.

Print to scale (as actual size)

NOTES

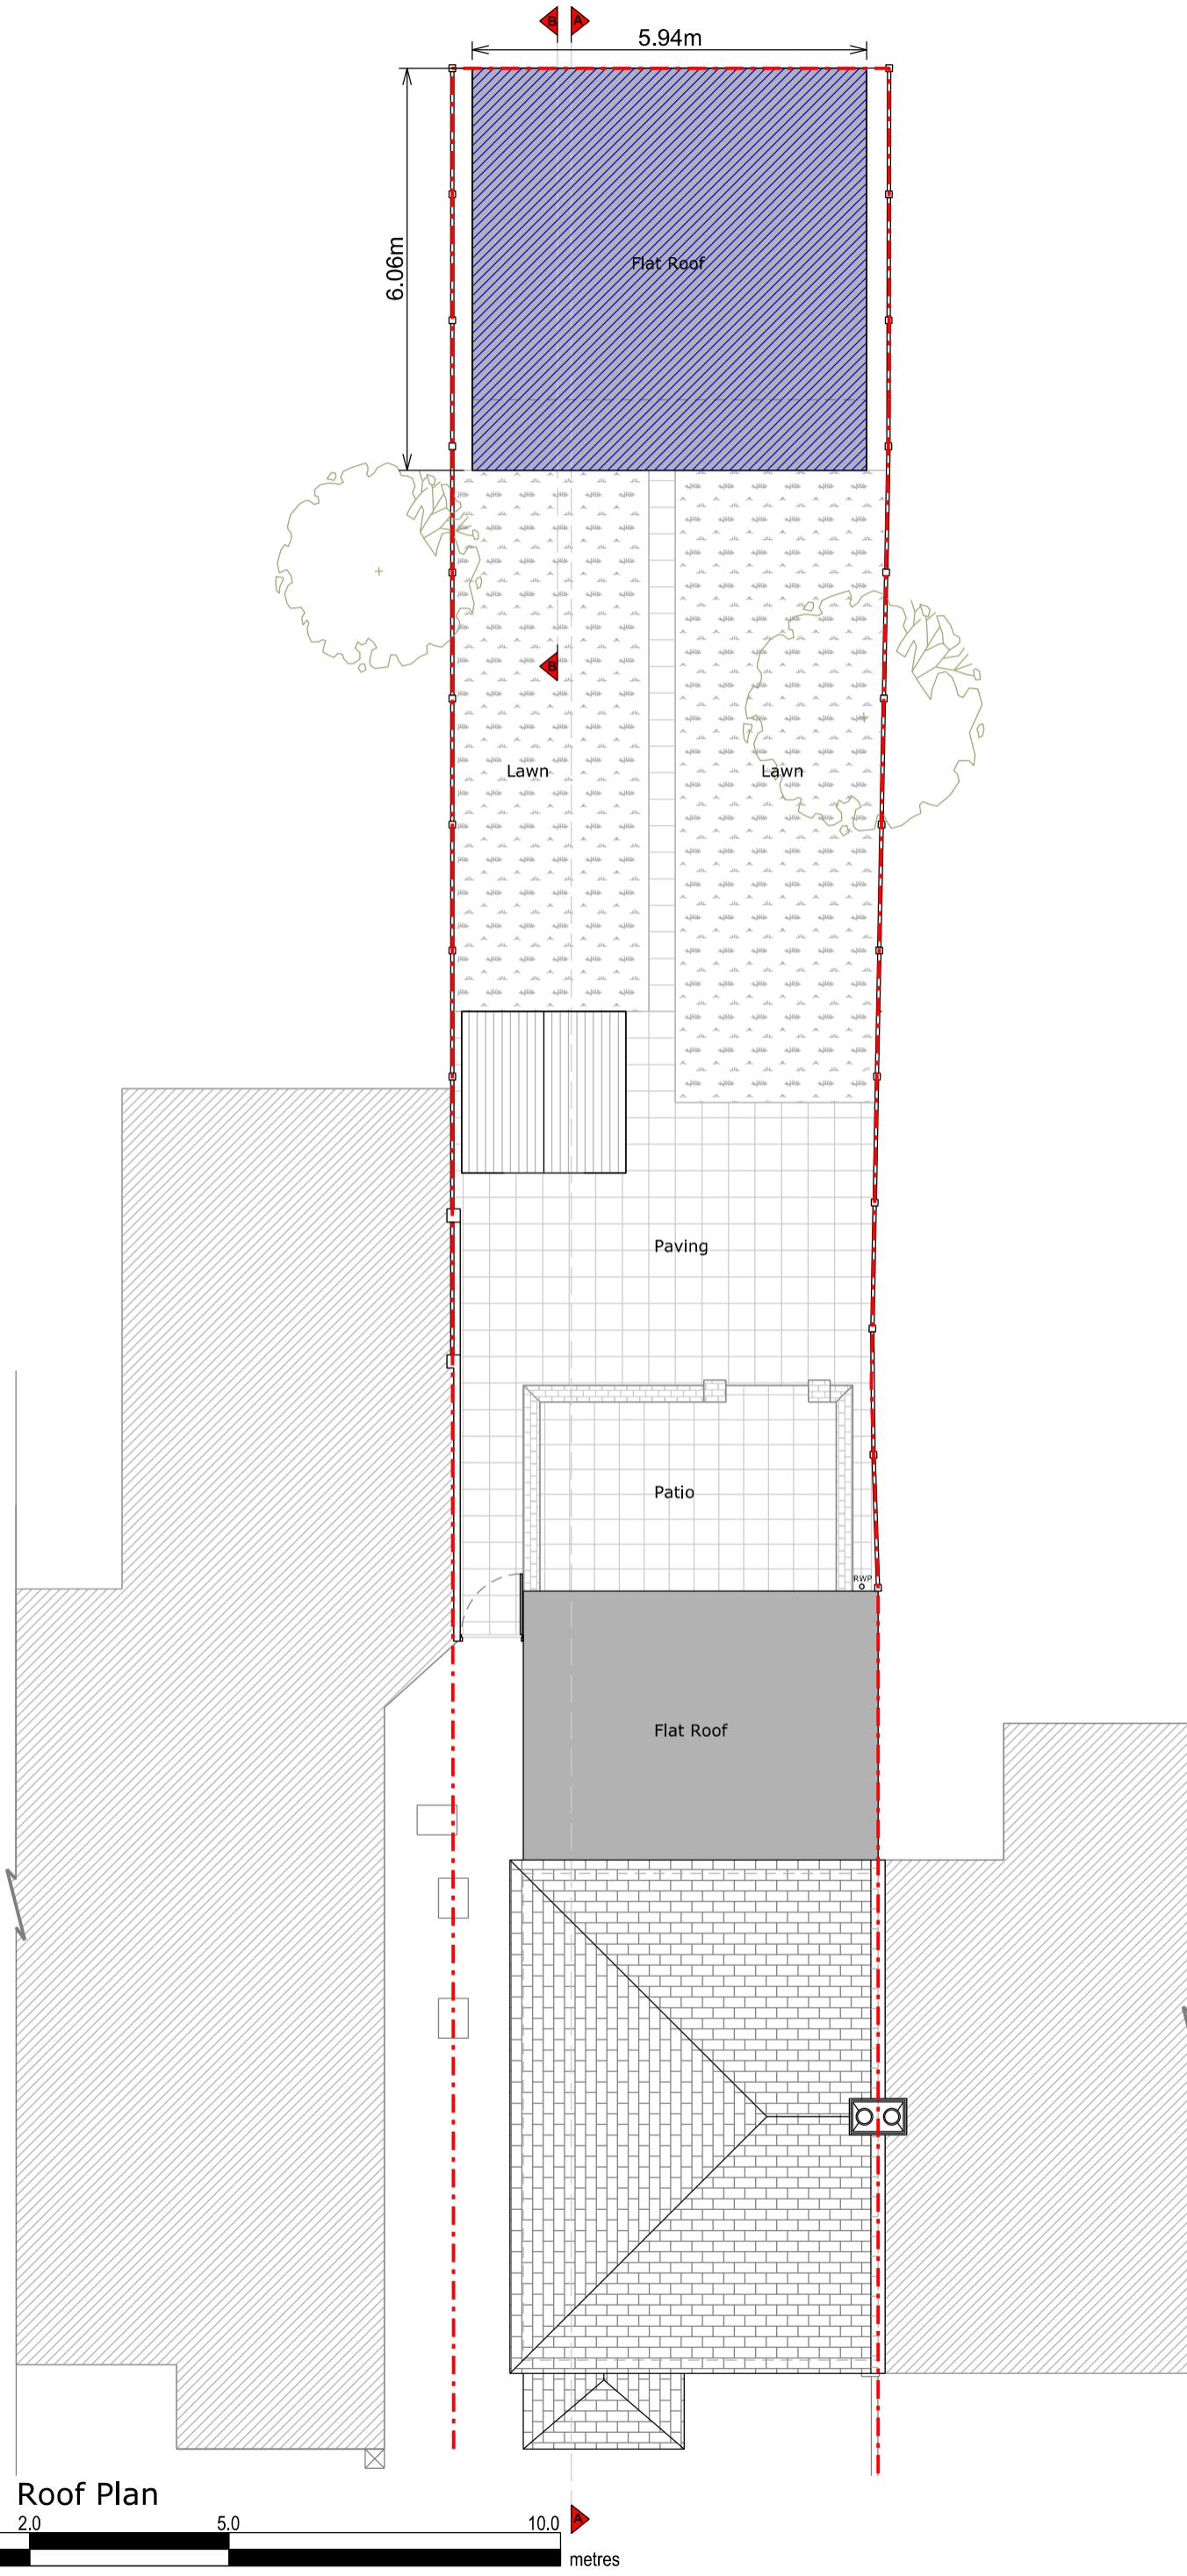

Revision

Rev	Notes	Date
- A	Preliminary Issue Planning	23/09/2024 21/10/2024

KEY

As - Built annexe	Boundary lines
Existing walls	Proposed beam
Existing removed	Proposed drainage
Proposed rooflight	1.8m head height
	1.5m head height

JOB TITLE

Lawful development certificate application for existing use of an outbuilding as a residential annexe at 9 Chaucer Avenue, Hayes UB4 0AP

STATUS

Planning

DRAWING TITLE

As - Built Roof Plan

CLIENT

Gudria Choudrey

SCALE
1:100 at A3

DRAWN
LQ

DATE
Oct 2024

CHECKED
NS

DRAWING NO. 260502 - 01 - 103A

Copyright in design and this drawing is the property of Resi and Design Squared.

Reproduction in whole or in part is forbidden without written sanction of Resi and Design Squared.

All dimensions to be cross-checked on site prior to completing a Building Regulations package, structural engineering, the party wall process and construction.

Print to scale (as actual size)

NOTES

Revision

Rev	Notes	Date
- A	Preliminary Issue Planning	23/09/2024 21/10/2024

KEY	
As - Built annexe	Boundary lines
Existing walls	Proposed beam
Existing removed	Proposed drainage
Proposed rooflight	1.8m head height
	1.5m head height

JOB TITLE

Lawful development certificate application for existing use of an outbuilding as a residential annexe at 9 Chaucer Avenue, Hayes UB4 0AP

STATUS

Planning

DRAWING TITLE

As - Built Left Side Elevation

CLIENT

Gudria Choudrey

SCALE

1:100 at A3

DRAWN

LQ


DATE

Oct 2024


CHECKED

NS

DRAWING NO. 260502 - 01 - 201A

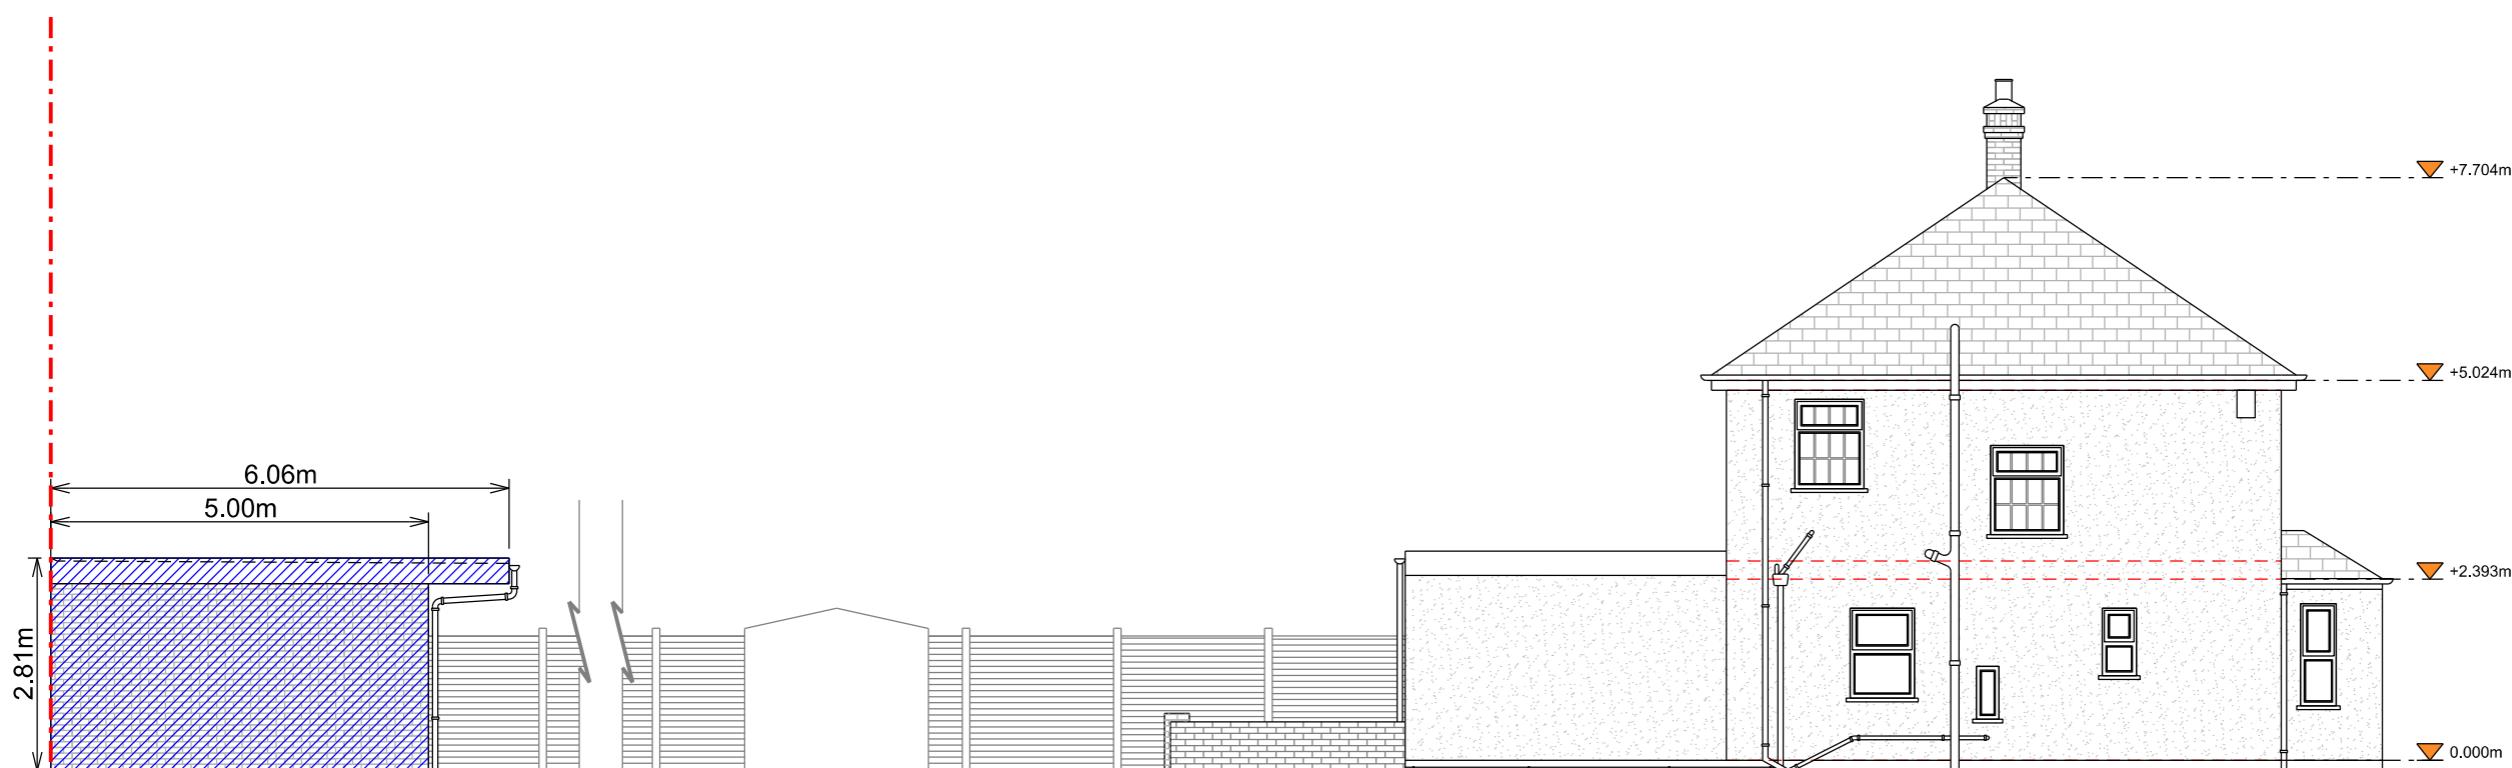

Left Side Elevation

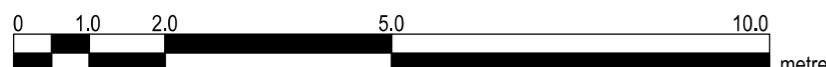

Copyright in design and this drawing is the property of Resi and Design Squared.

Reproduction in whole or in part is forbidden without written sanction of Resi and Design Squared.

All dimensions to be cross-checked on site prior to completing a Building Regulations package, structural engineering, the party wall process and construction.

Print to scale (as actual size)


NOTES

Revision


Rev	Notes	Date
- A	Preliminary Issue Planning	23/09/2024 21/10/2024

KEY

As - Built annexe	Boundary lines
Existing walls	Proposed beam
Existing removed	Proposed drainage
Proposed rooflight	1.8m head height
	1.5m head height

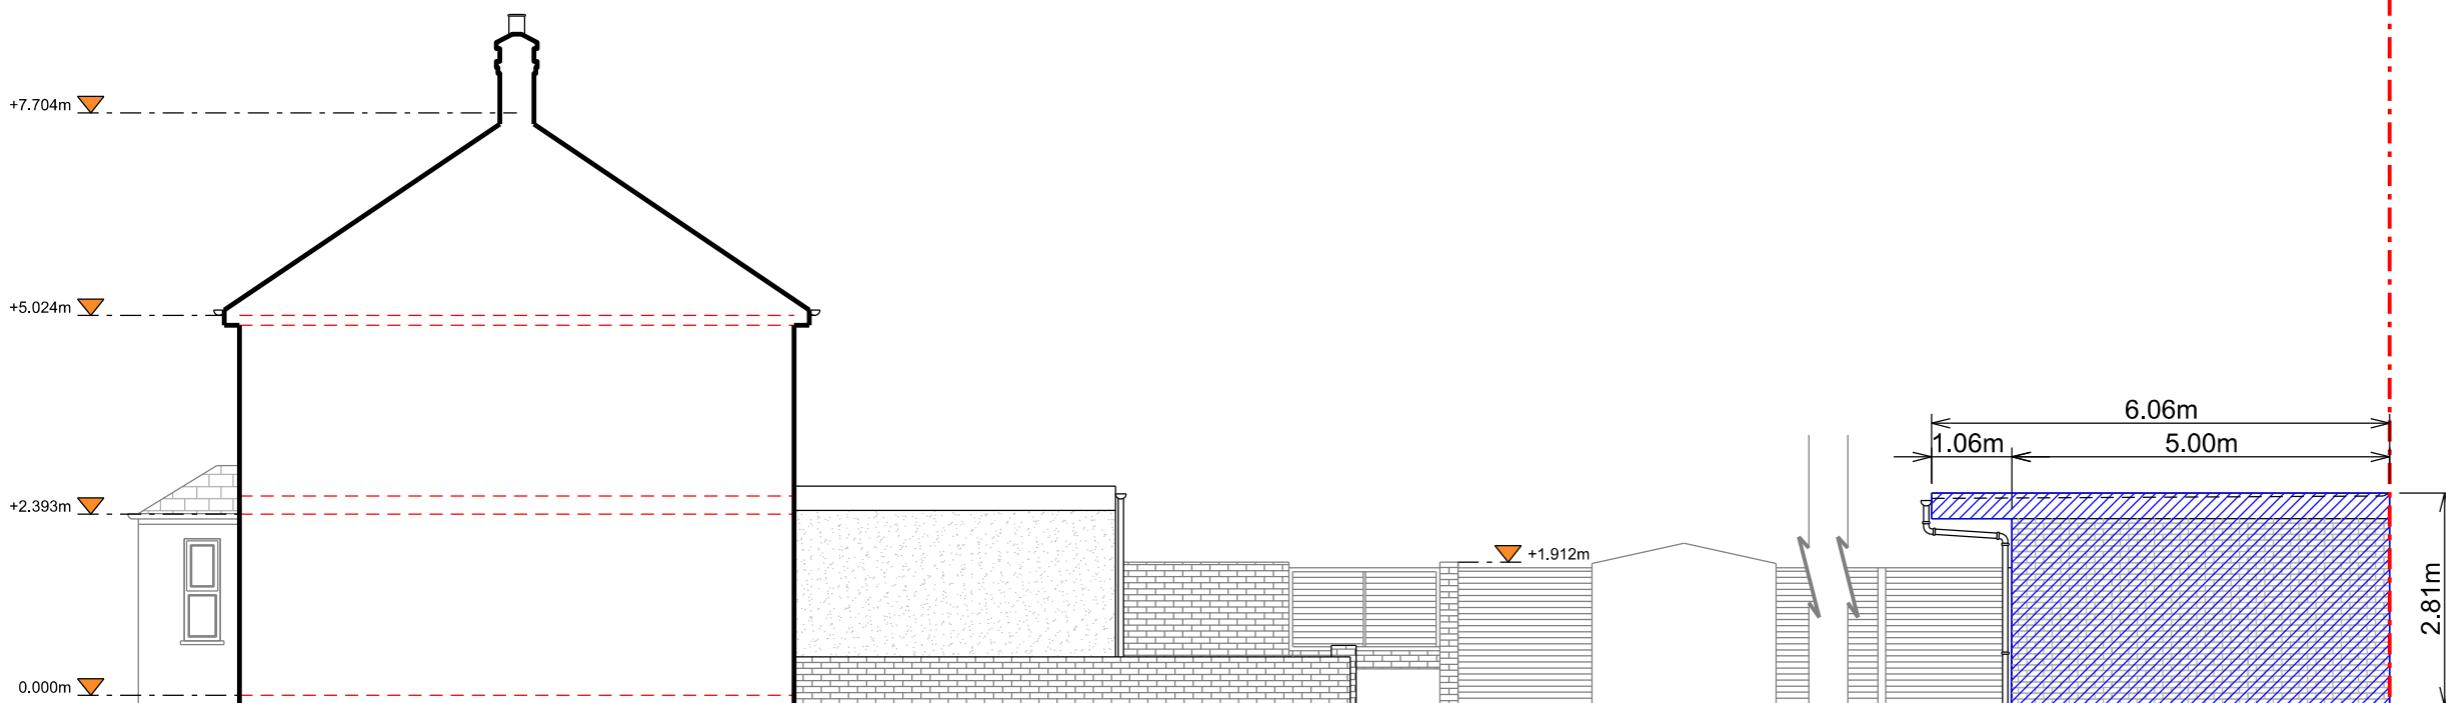

Right Side Elevation

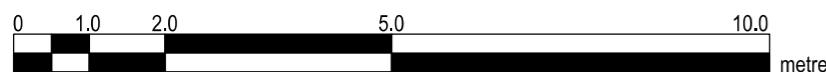

JOB TITLE

Lawful development certificate application for existing use of an outbuilding as a residential annexe at 9 Chaucer Avenue, Hayes UB4 0AP

STATUS

Planning

DRAWING TITLE

As - Built Right Side Elevation

CLIENT

Gudria Choudrey

SCALE

1:100 at A3

DRAWN

LQ

DATE

Oct 2024

CHECKED

NS

DRAWING NO. 260502 - 01 - 202A

Copyright in design and this drawing is the property of Resi and Design Squared.

Reproduction in whole or in part is forbidden without written sanction of Resi and Design Squared.

All dimensions to be cross-checked on site prior to completing a Building Regulations package, structural engineering, the party wall process and construction.

Print to scale (as actual size)

NOTES

Revision

Rev	Notes	Date
- A	Preliminary Issue Planning	23/09/2024 21/10/2024

KEY		
As - Built annexe	Boundary lines	
Existing walls	Proposed beam	
Existing removed	Proposed drainage	
	1.8m head height	
	Proposed rooflight	1.5m head height

JOB TITLE

Lawful development certificate application for existing use of an outbuilding as a residential annexe at 9 Chaucer Avenue, Hayes UB4 0AP

STATUS

Planning

DRAWING TITLE

As - Built Annexe Plans

CLIENT

Gudria Choudrey

SCALE

1:100 at A3


DRAWN
LQ

DATE


Oct 2024

CHECKED
NS


DRAWING NO. 260502 - 01 - 203A

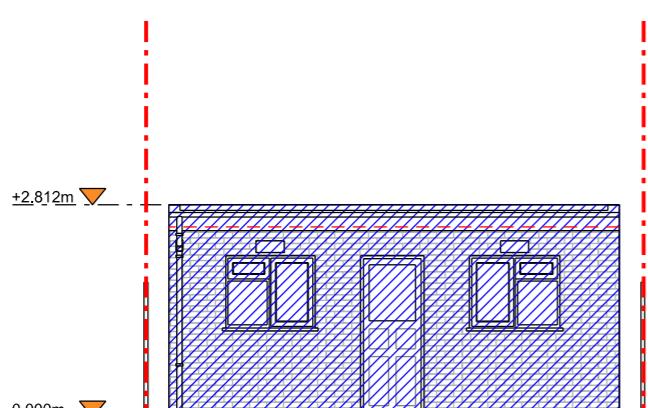


Front Elevation

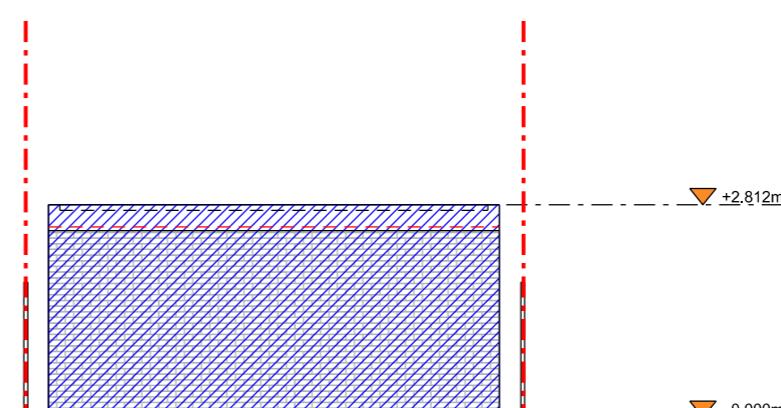


Rear Elevation

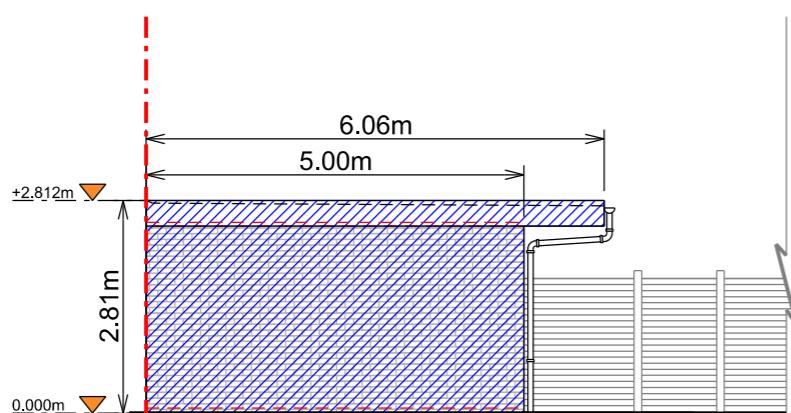


Left Side Elevation

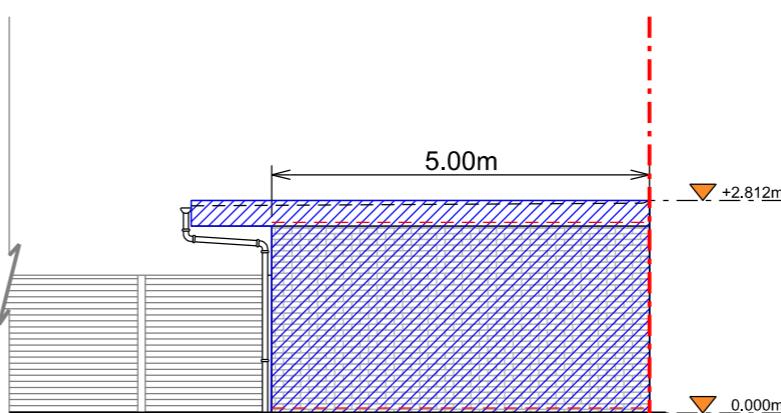

Right Side Elevation

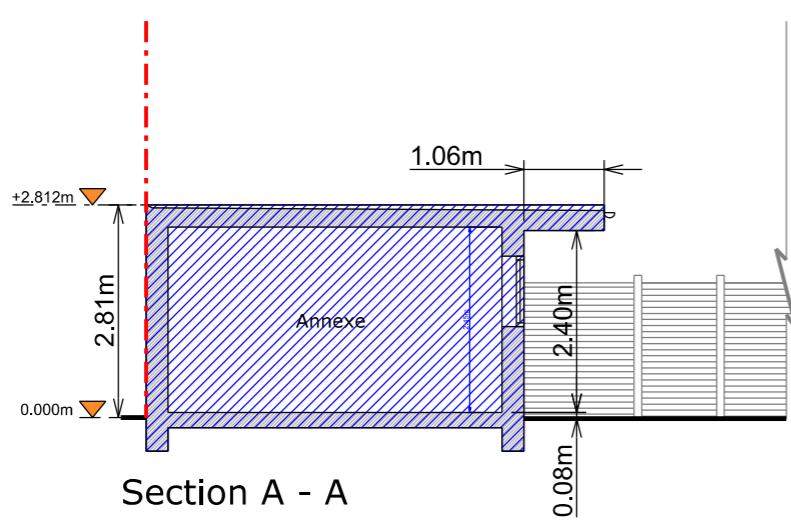

Section A - A

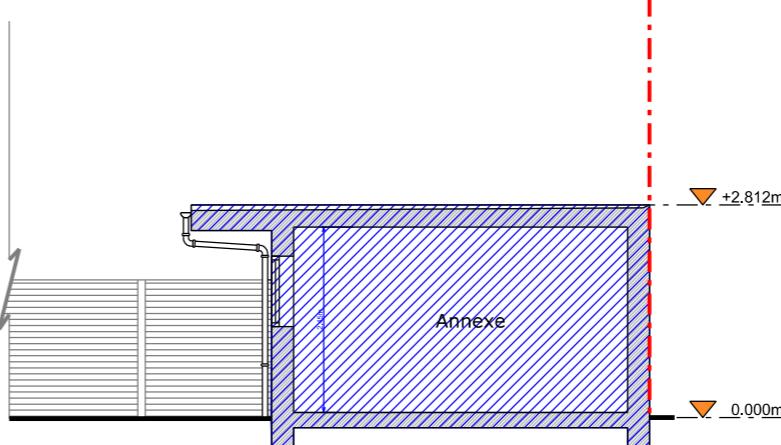

Section B - B

0 1.0 2.0 5.0 10.0 metres

Copyright in design and this drawing is the property of Resi and Design Squared.

Reproduction in whole or in part is forbidden without written sanction of Resi and Design Squared.

All dimensions to be cross-checked on site prior to completing a Building Regulations package, structural engineering, the party wall process and construction.

Print to scale (as actual size)

NOTES

Revision

Rev	Notes	Date
- A	Preliminary Issue Planning	23/09/2024 21/10/2024

KEY	
	Boundary lines
	As-Built annexe
	Existing walls
	Proposed beam
	Proposed drainage
	Existing removed
	1.8m head height
	Proposed rooflight

JOB TITLE

Lawful development certificate application for existing use of an outbuilding as a residential annexe at 9 Chaucer Avenue, Hayes UB4 0AP

STATUS

Planning

DRAWING TITLE

As-Built Section A - A

CLIENT

Gudria Choudrey

SCALE

1:100 at A3

DRAWN

LQ

DATE

Oct 2024

CHECKED

NS

DRAWING NO. 260502 - 01 - 301A

