

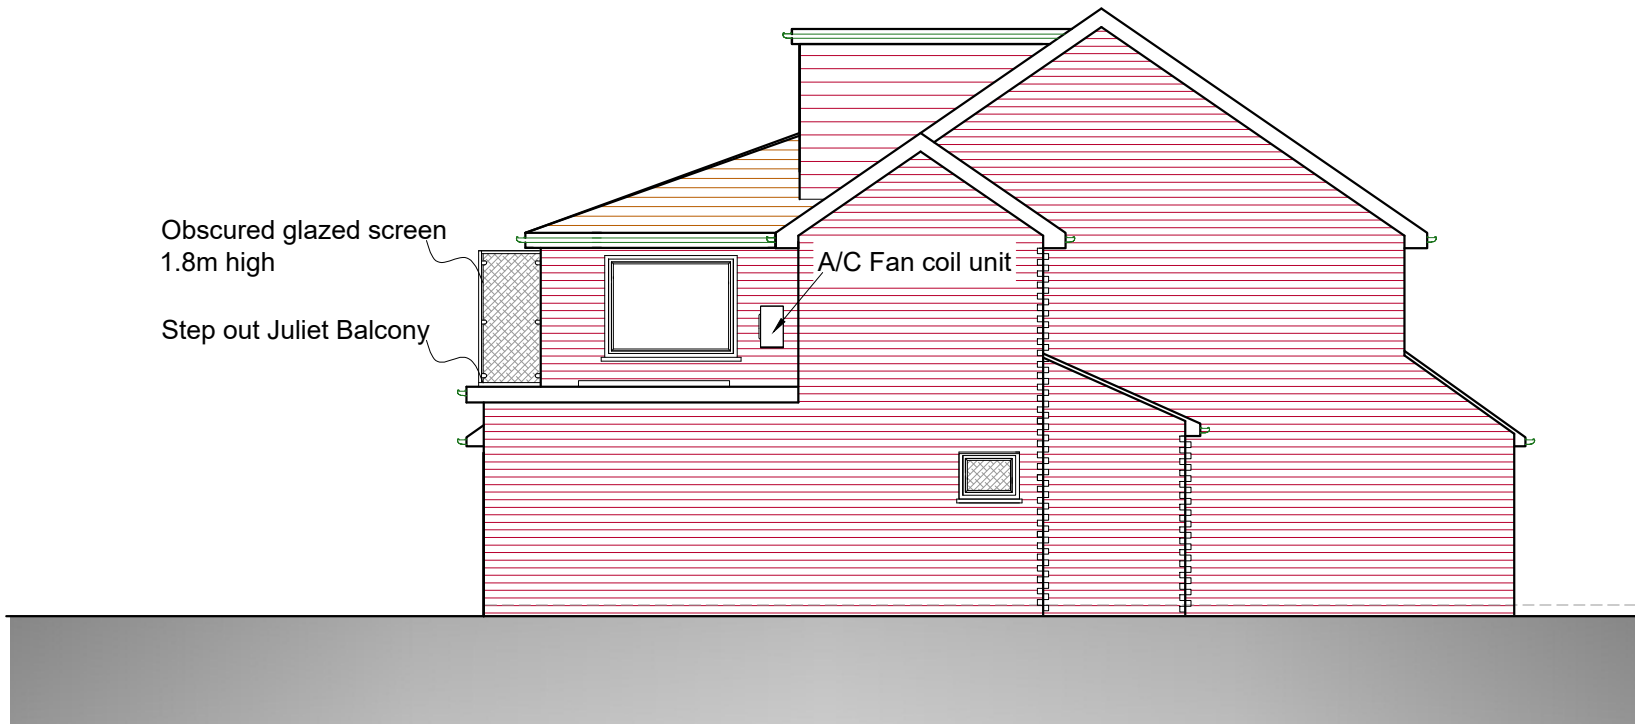



Rev.	AMENDMENTS
A	Drawling updated as built 15/12/23
B	Step out balcony included 16/1/24
C	Roof lights added, window adjusted 23/1/24
D	Windows and door adjusted as built 01/5/24

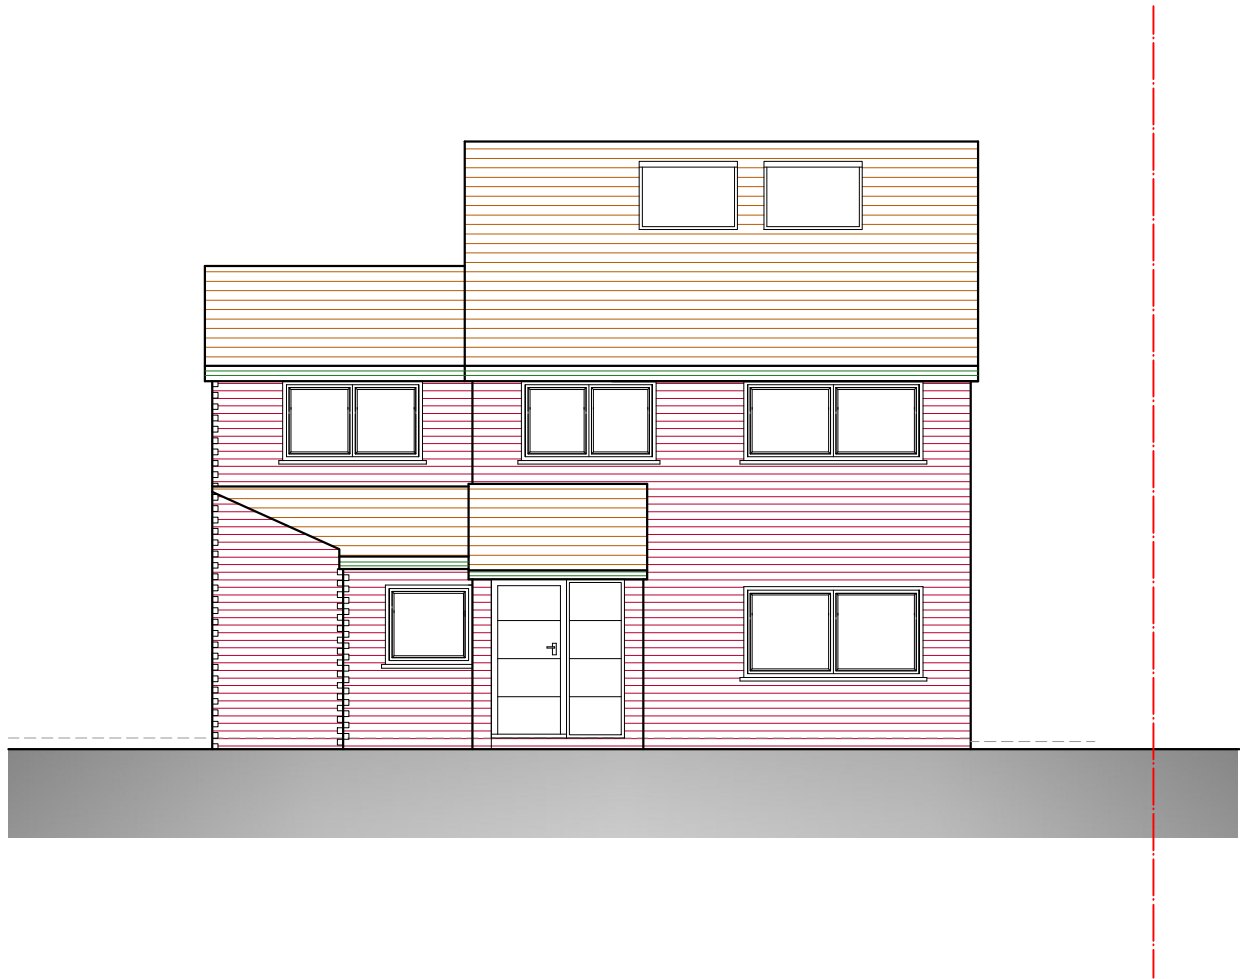

SOUTH EAST ELEVATION

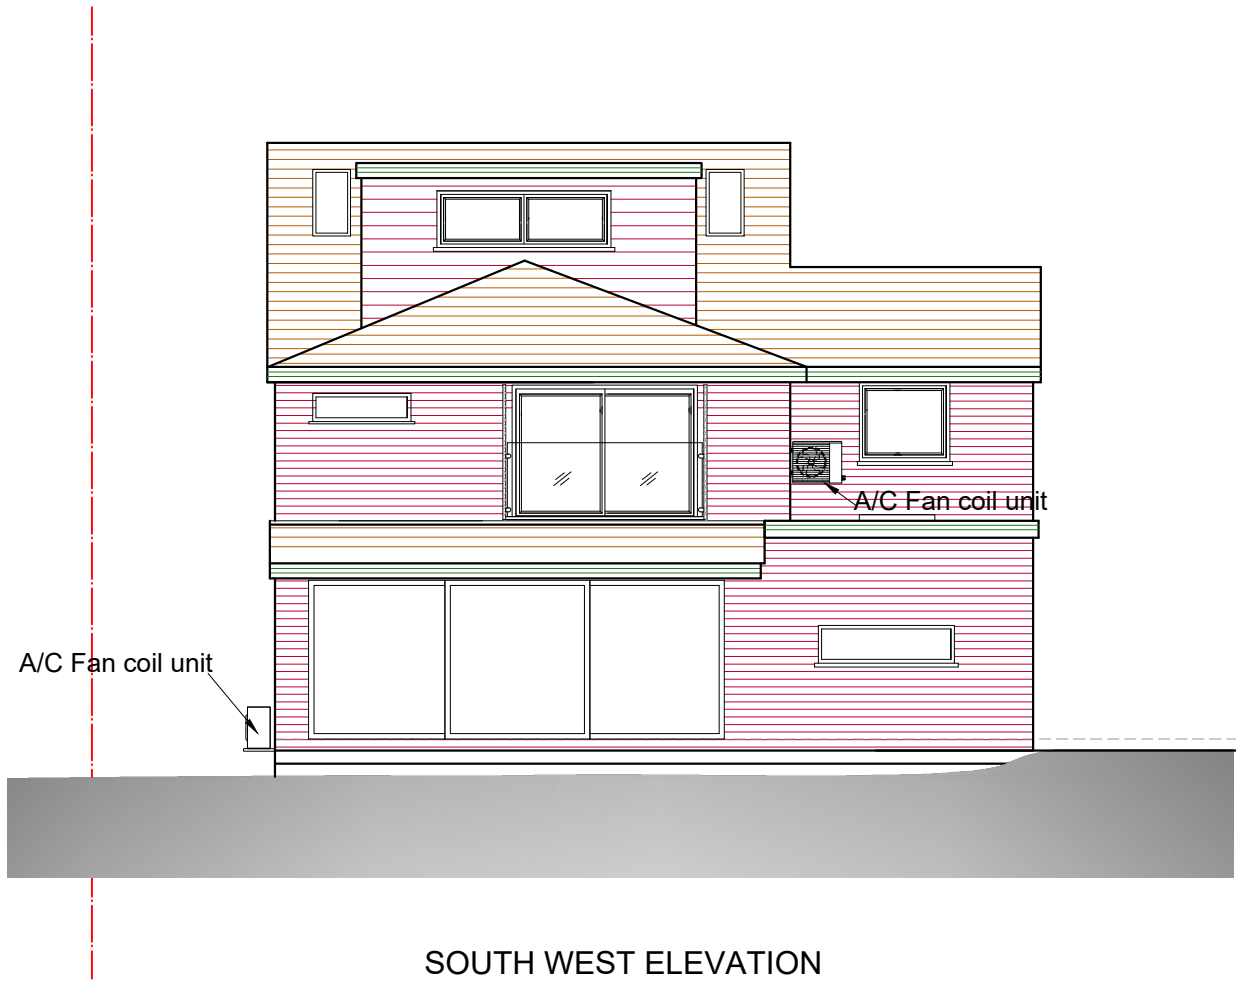


SOUTH WEST ELEVATION

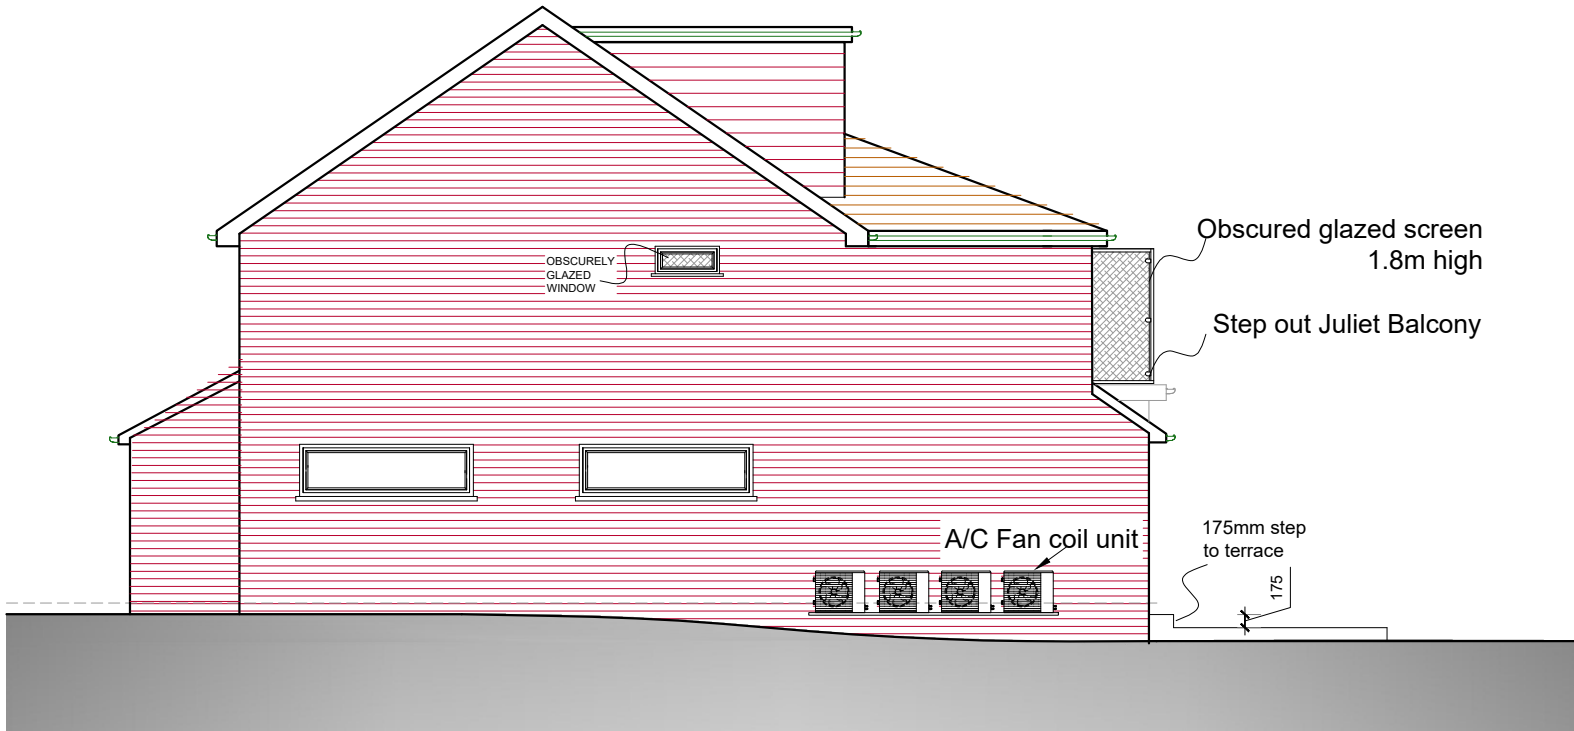

NORTH WEST ELEVATION

PROPOSED ELEVATIONS

4 Woodhall Close, Uxbridge, Middlesex, UB8 1PY

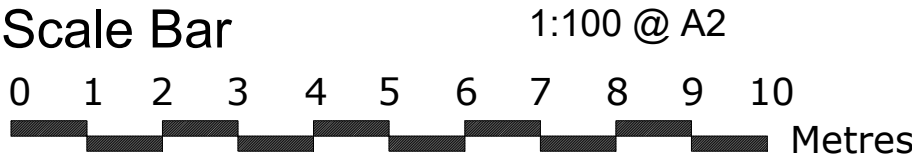

THE GILLETT MACLEOD PARTNERSHIP
Chartered Architects & Town Planning Consultants
1 High Road Old Eastcote Pinner Middlesex HA5 2EW tel. 0208 868 1333

Drg. No. 21/3436/304D
Scale 1:100
Date 03/11/23
Drawn by AK

REVISION
D
drawn