



Rev.	AMENDMENTS
A	Drawling updated as built 15/12/23



SOUTH EAST ELEVATION

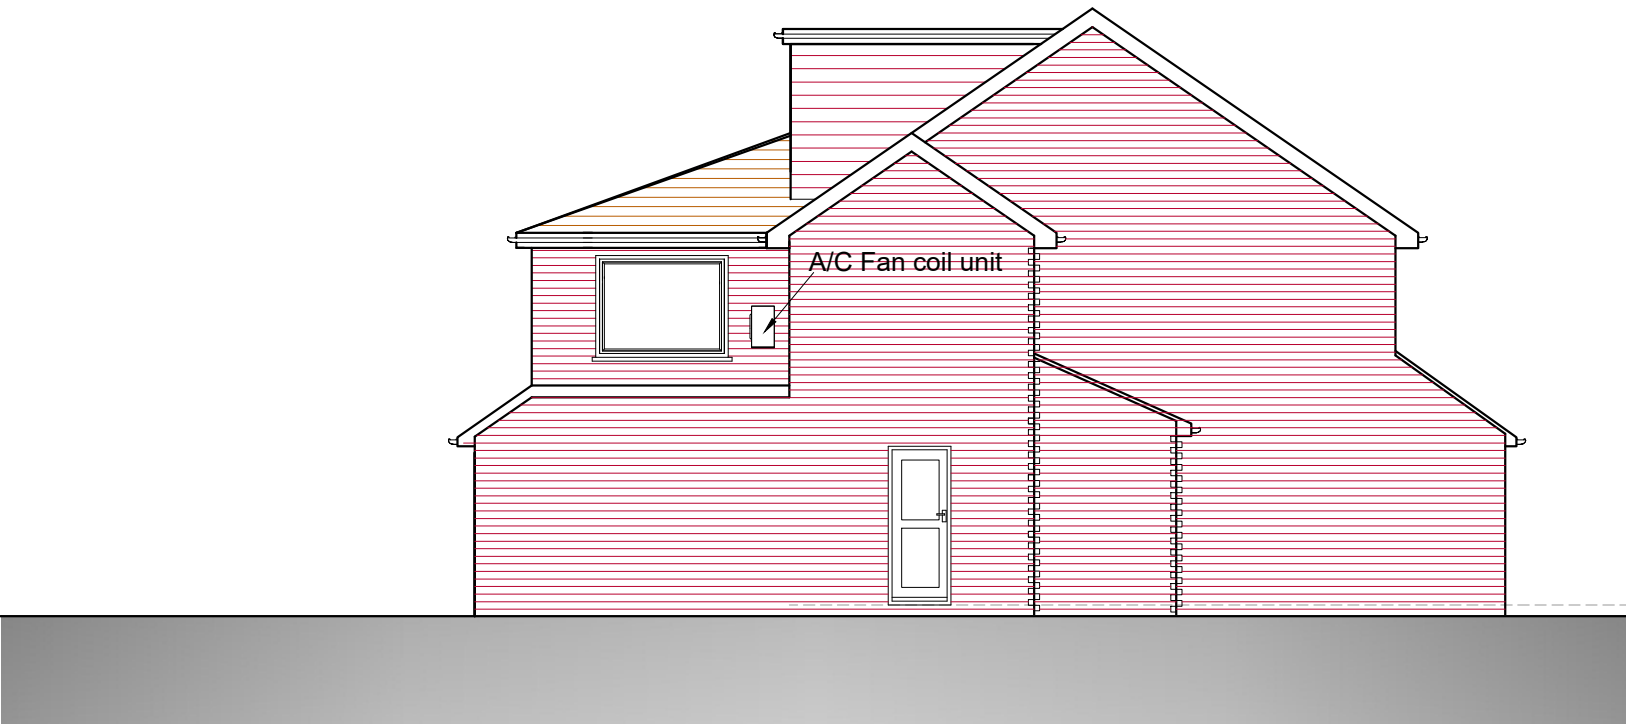

SOUTH WEST ELEVATION

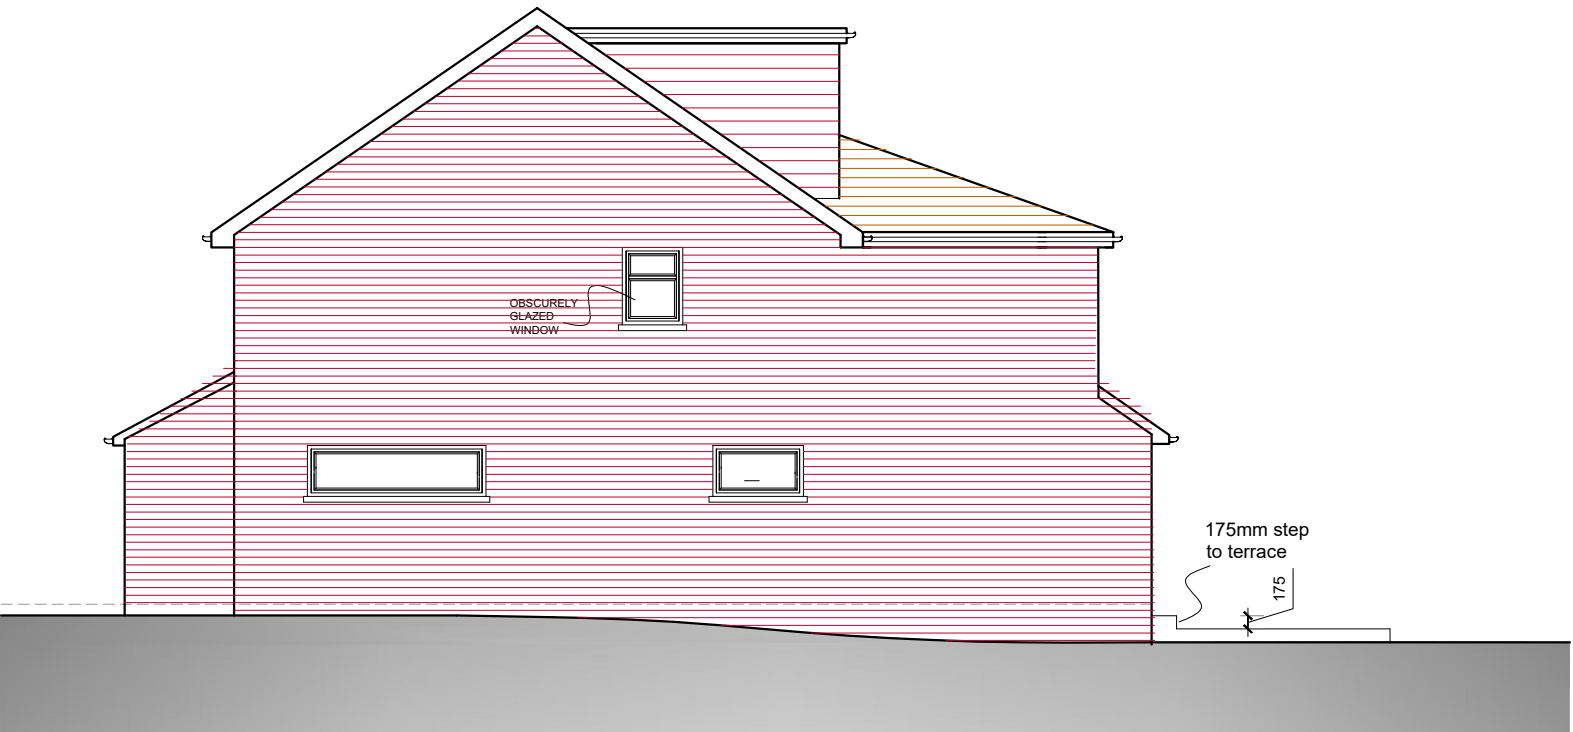

NORTH WEST ELEVATION

PROPOSED ELEVATIONS

4 Woodhall Close, Uxbridge, Middlesex, UB8 1PY

Scale Bar

1:100 @ A2

0 1 2 3 4 5 6 7 8 9 10

Metres



THE GILLETT MACLEOD PARTNERSHIP
Chartered Architects & Town Planning Consultants
1 High Road Old Eastcote Pinner Middlesex HA5 2EW tel. 0208 868 1333

Drg. No. 21/3436/304^A
Scale 1:100
Date 03/11/23
Drawn by AK

REVISION
A
drawer