




| Rev. | AMENDMENTS                         |
|------|------------------------------------|
| A    | Drawling updated as built 15/12/23 |

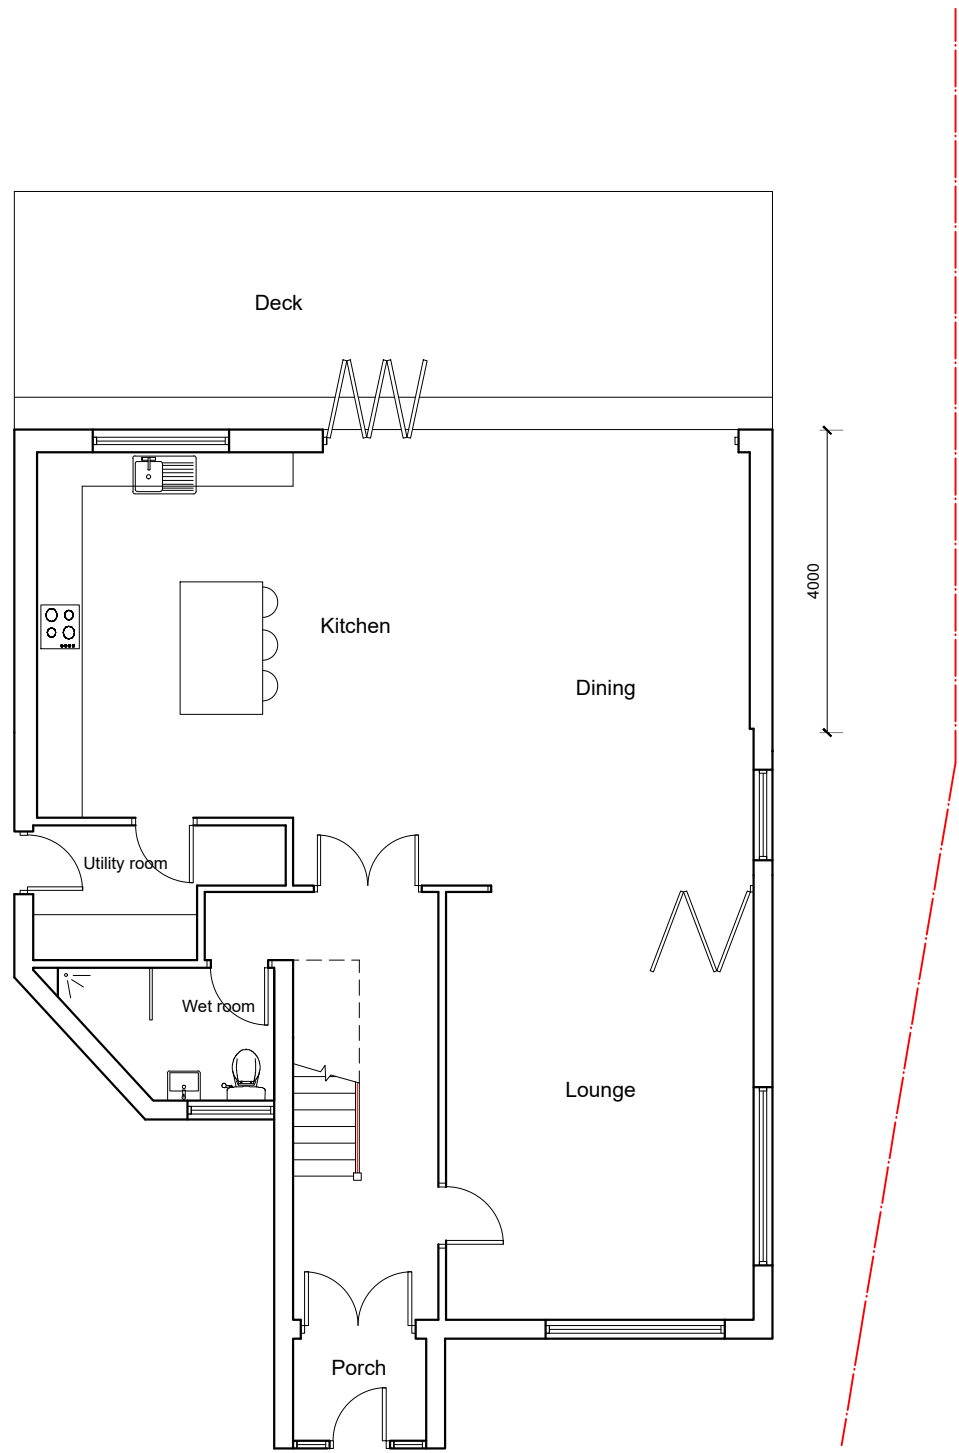

GROUND FLOOR

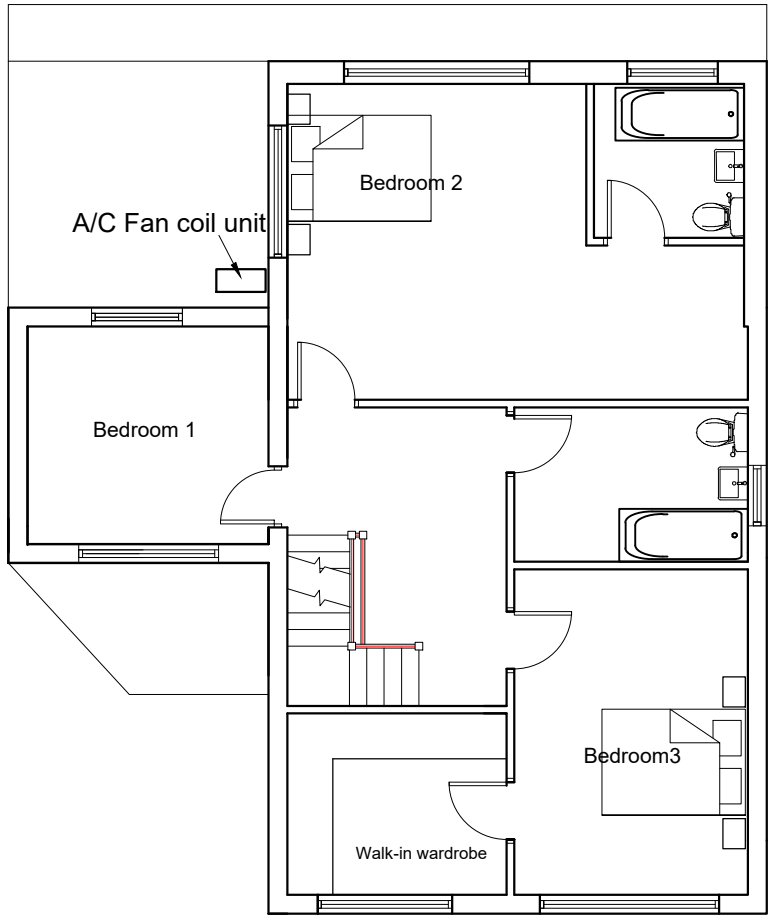

FIRST FLOOR

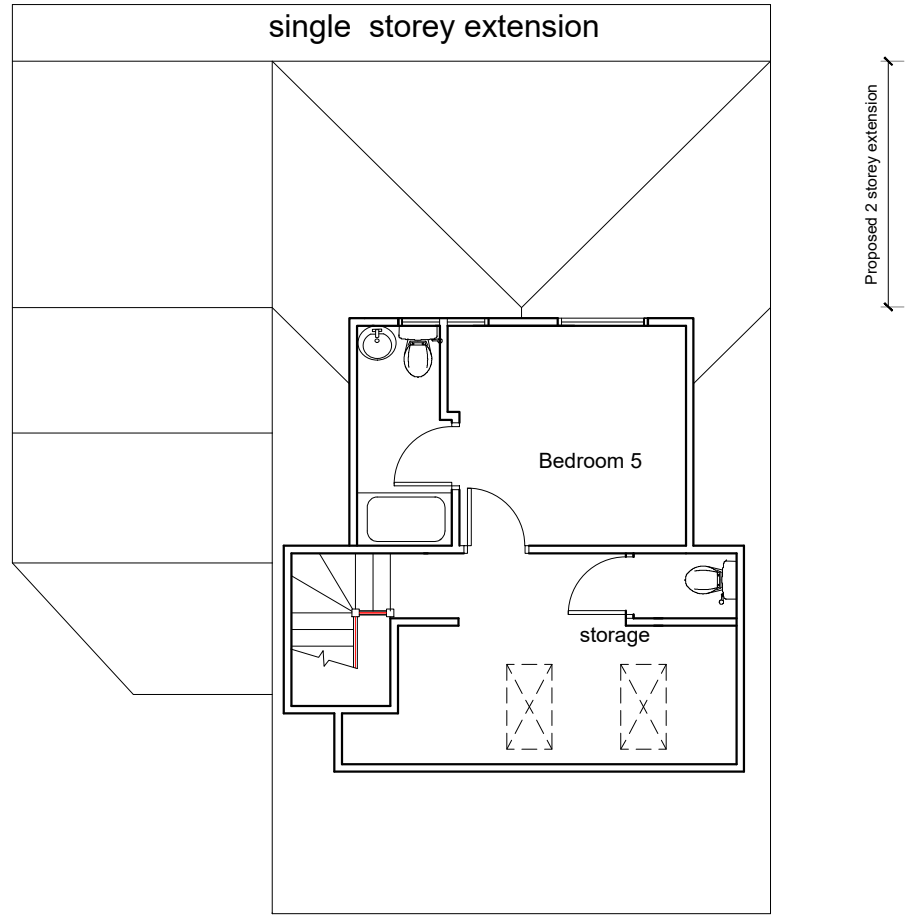

PROPOSED FLOOR PLANS

4 Woodhall Close, Uxbridge, Middlesex, UB8 1PY

Scale Bar

012345678910

Metres

1:100 @ A2

THE GILLETT MACLEOD PARTNERSHIP

Chartered Architects & Town Planning Consultants

1 High Road Old Eastcote Pinner Middlesex HA5 2EW tel. 0208 868 1333

Drg. No. 21/3436/303A

Scale 1:100

Date 03/11/23

Drawn by AK

REVISION

A

(C) drawer