

Dimensions to be verified on site
DO NOT SCALE FROM THIS DRAWING.
Any areas indicated on this drawing are for guidance only.
No responsibility is taken for their accuracy.

This drawing is the property of **BANCIL PARTNERSHIP LTD**
Copyright is reserved by them and the drawing is issued on the
condition that it is not copied, reproduced, retained or disclosed
to any unauthorised person, either wholly or in part without the
consent in writing of **BANCIL PARTNERSHIP LTD**

Site Address:

34, Pole Hill Road,
Uxbridge,
UB10 0QA.

Client Detail:

34, Pole Hill Road,
Uxbridge,
UB10 0QA.

Title:


As Built Second Floor Plan

Drawn By: NM
Checked By: PP
Date: 07/2020
Drawing No. BC/PP/2501 - 21

Revisions:

Rev	Revision	Date

Scale: 1:50 Paper Size: A3

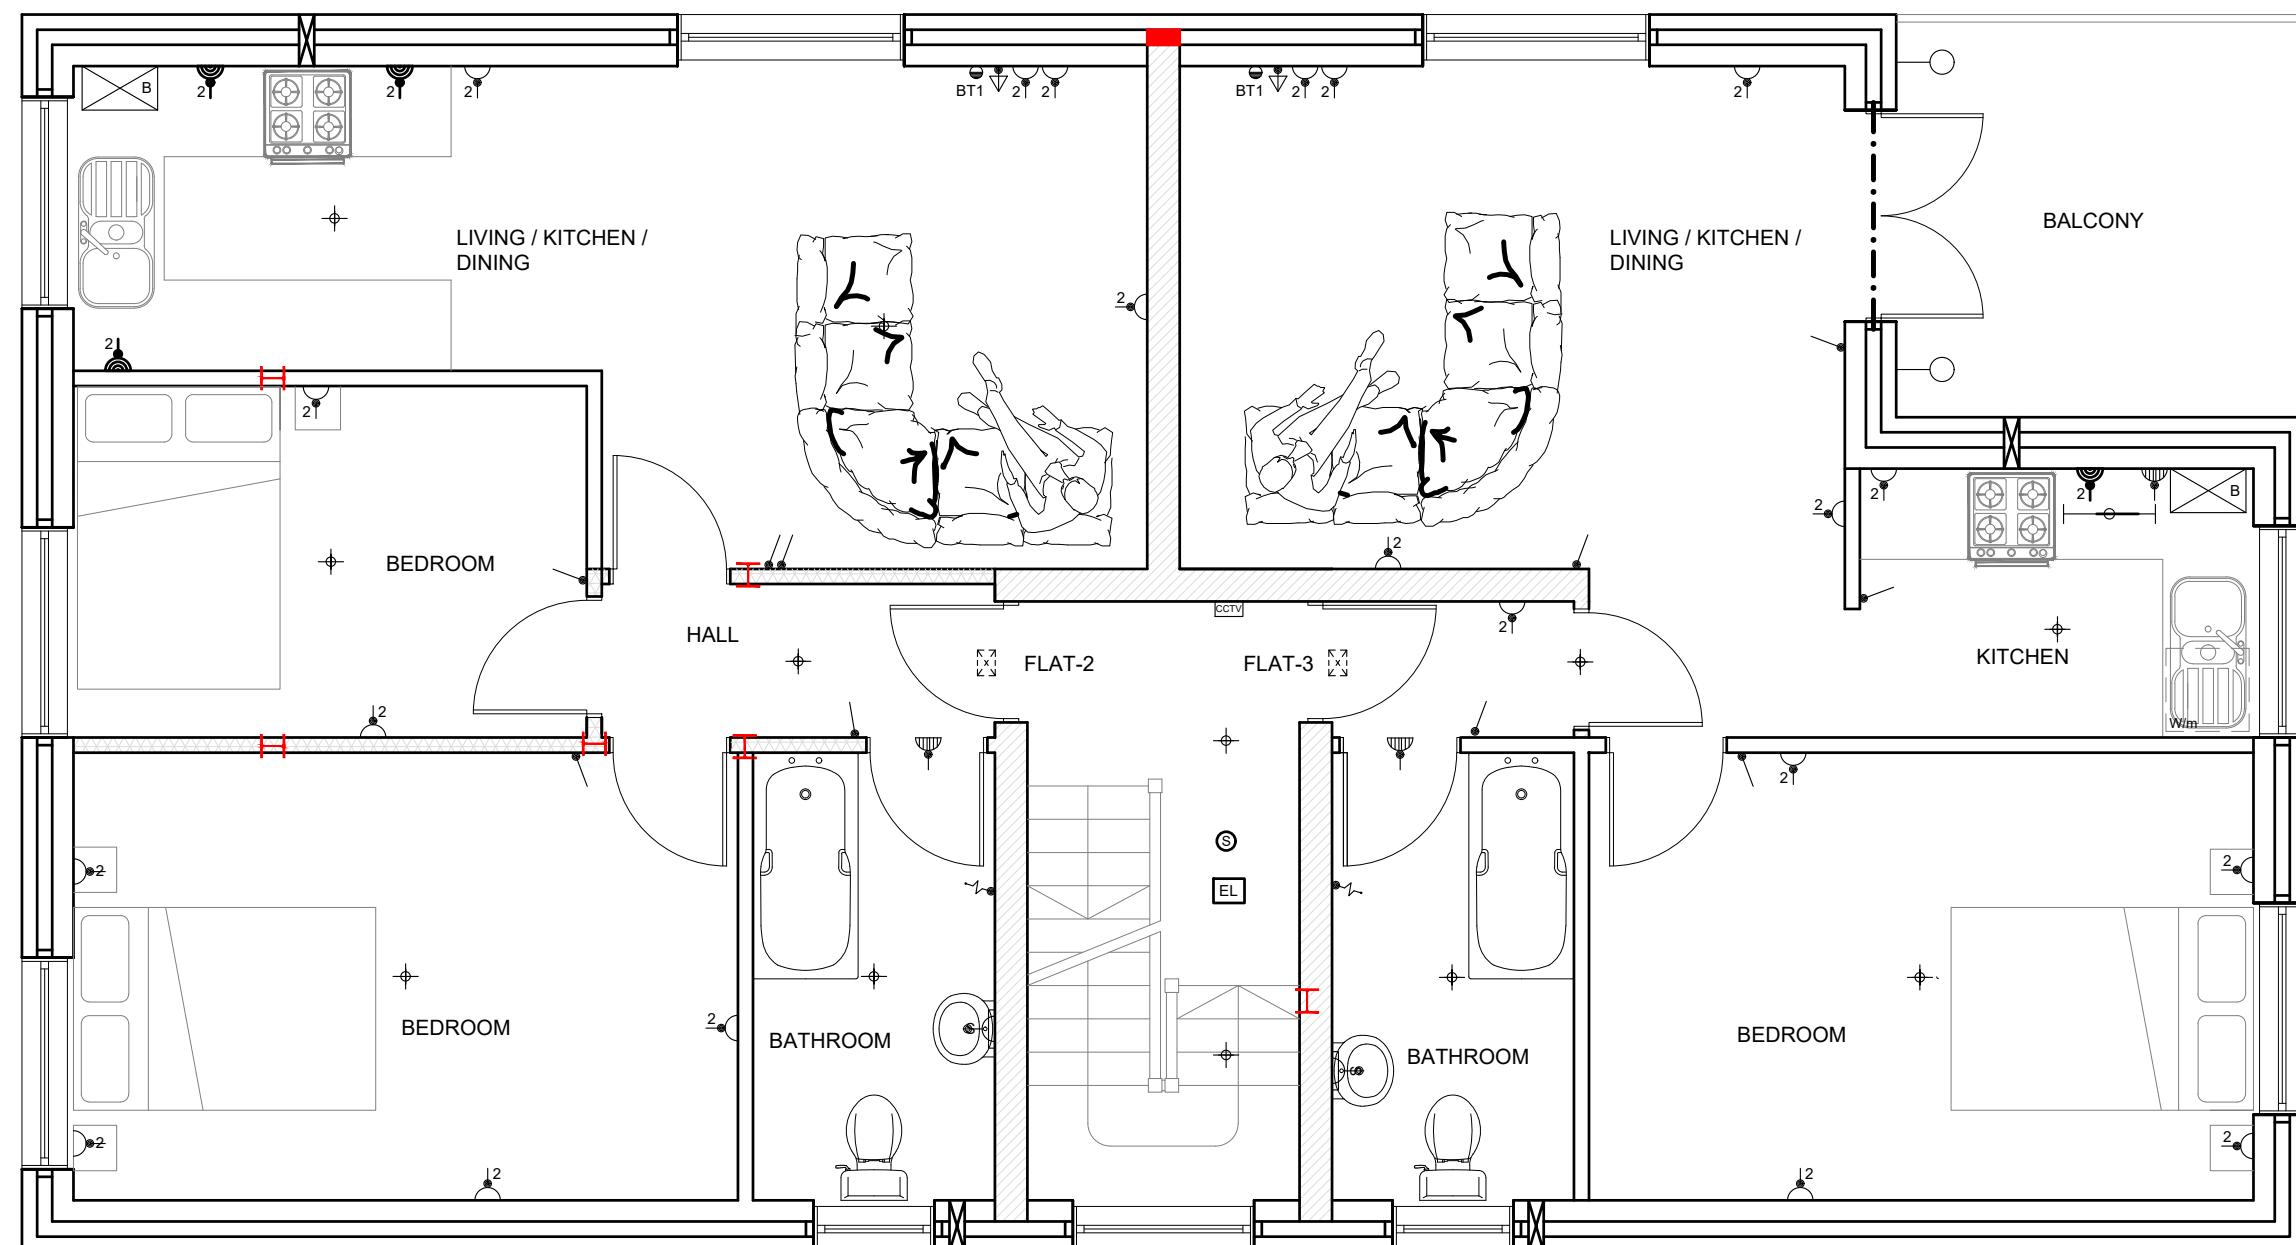

Dimensions to be verified on site
DO NOT SCALE FROM THIS DRAWING.
Any areas indicated on this drawing are for guidance only.
No responsibility is taken for their accuracy.

This drawing is the property of **BANCIL PARTNERSHIP LTD**
Copyright is reserved by them and the drawing is issued on the
condition that it is not copied, reproduced, retained or disclosed
to any unauthorised person, either wholly or in part without the
consent in writing of **BANCIL PARTNERSHIP LTD**

Site Address:

34, Pole Hill Road,
Uxbridge,
UB10 0QA.

Client Detail:

34, Pole Hill Road,
Uxbridge,
UB10 0QA.

Title:

As Built First Floor Plan

Drawn By: NM
Checked By: PP
Date: 07/2020
Drawing No. BC/PP/2501 - 20

Revisions:


Rev	Revision	Date



BANCIL
PARTNERSHIP
LTD

27-29 The Broadway, Southall, Middx, UB1 1JY Tel: 020 8574 4546 Fax: 020 8574 4526

Scale: 1:50 Paper Size: A3

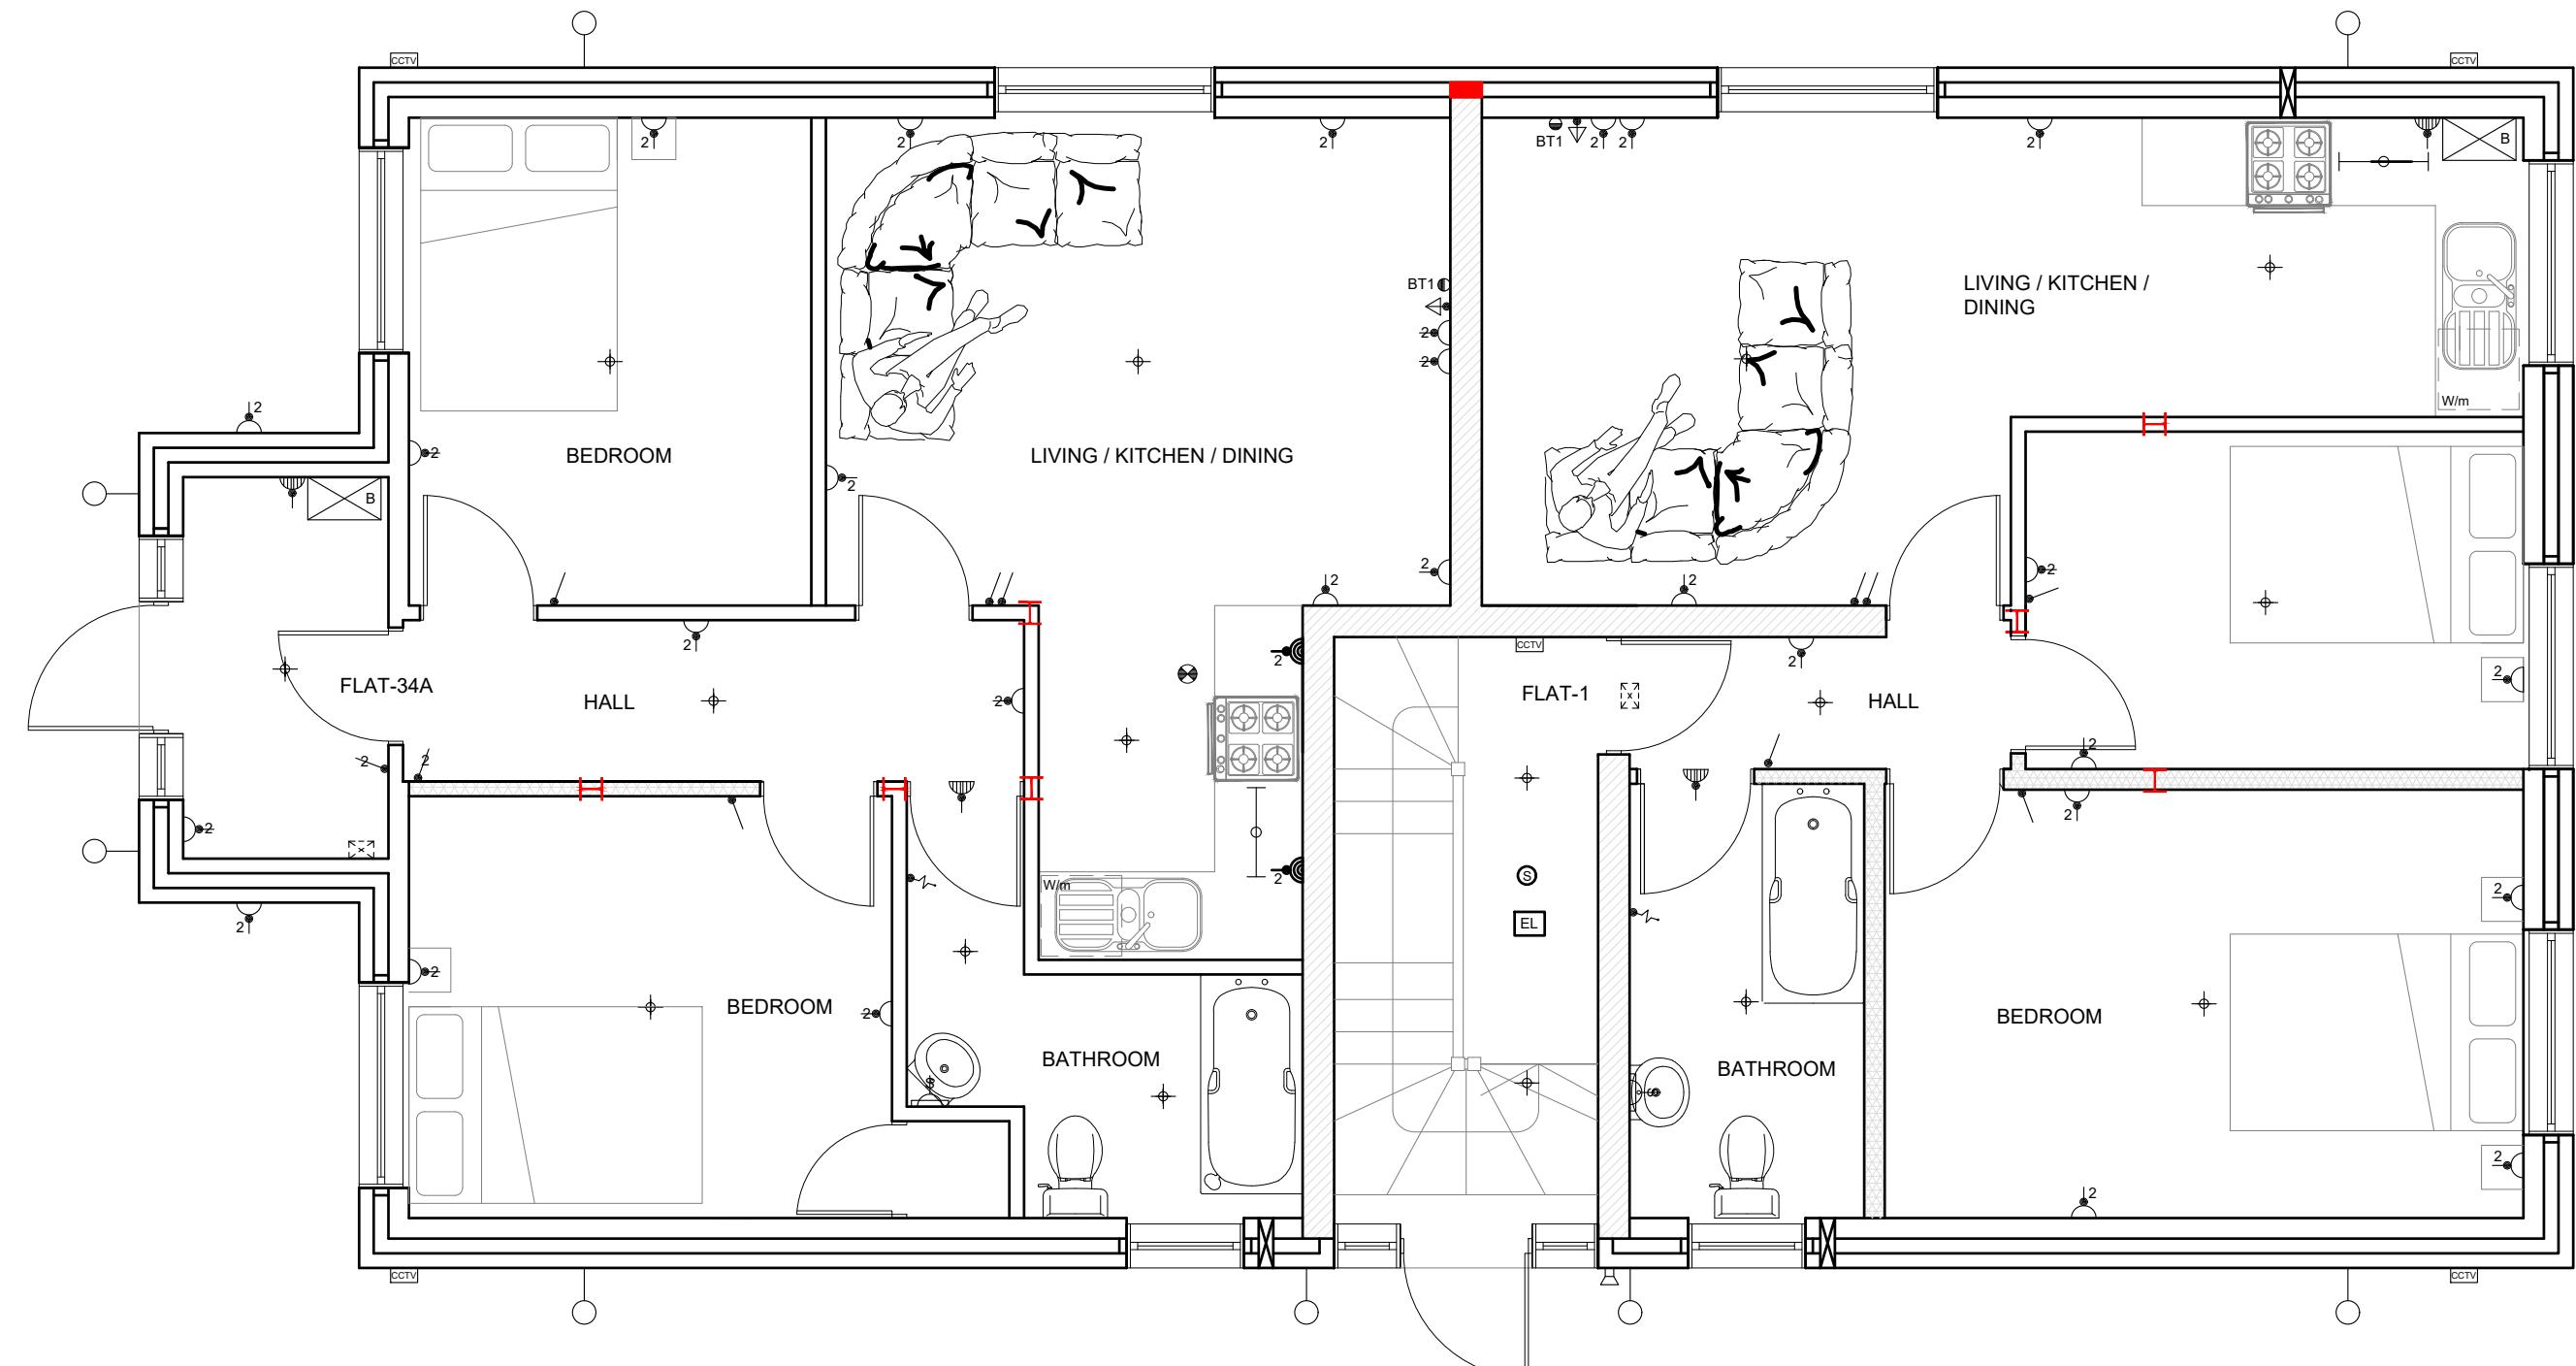

Dimensions to be verified on site
DO NOT SCALE FROM THIS DRAWING.
Any areas indicated on this drawing are for guidance only.
No responsibility is taken for their accuracy.

This drawing is the property of **BANCIL PARTNERSHIP LTD**
Copyright is reserved by them and the drawing is issued on the
condition that it is not copied, reproduced, retained or disclosed
to any unauthorised person, either wholly or in part without the
consent in writing of **BANCIL PARTNERSHIP LTD**

Site Address:

34, Pole Hill Road,
Uxbridge,
UB10 0QA.

Client Detail:

34, Pole Hill Road,
Uxbridge,
UB10 0QA.

Title:

As Built Ground Floor Plan

Drawn By: NM

Checked By: PP

Date: 07/2020

Drawing No. BC/PP/2501 - 19

Revisions:

Rev Revision

Date



BANCIL
PARTNERSHIP
LTD

27-29 The Broadway, Southall, Middx, UB1 1JY Tel: 020 8574 4546 Fax: 020 8574 4526

Scale: 1:50 Paper Size: A3