



NOTES


The general contractor is responsible for the verification of all dimensions on site and shall inform the Contract Administrator of any discrepancy. Do not scale from this drawing. Use figured dimensions only & should not be used for any other purpose other than it intended for. THIS DOCUMENT/DRAWING IS THE COPYRIGHT OF SURVEY DESIGN (HARROW) LTD, UNLESS FORMALLY ASSIGNED IN WRITING.

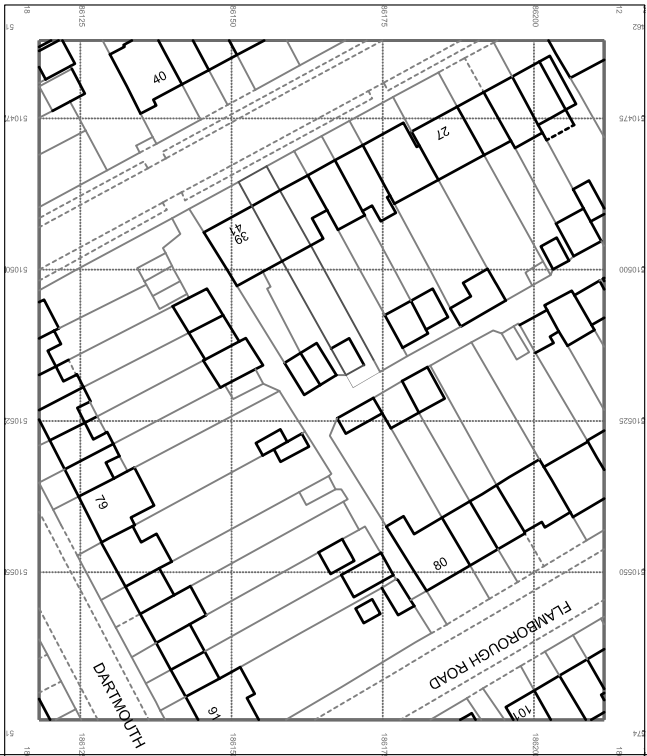

LOCATION PLAN 1:1250
OS REVISED AS PER TO CLIENT CONFIRMATION
REGARDING THE REAR BOUNDARY LINE


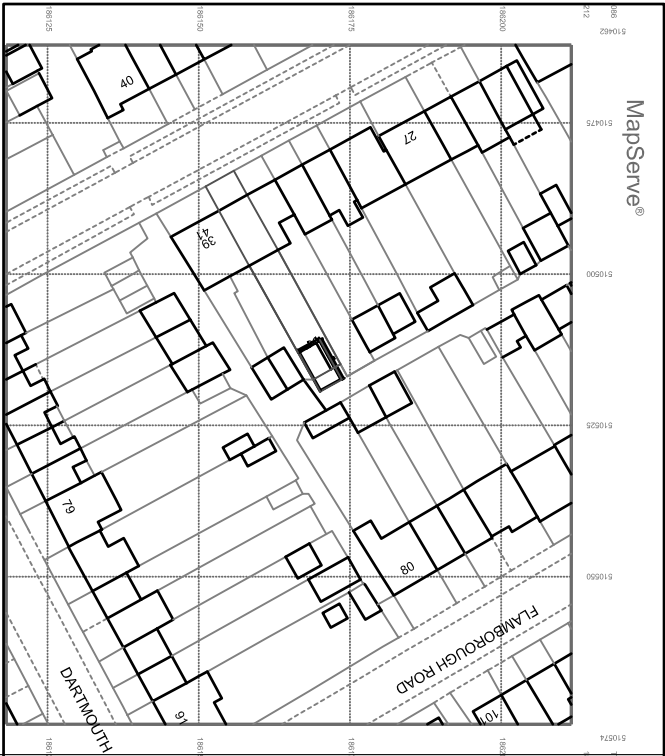


SITE PLAN 1:1250

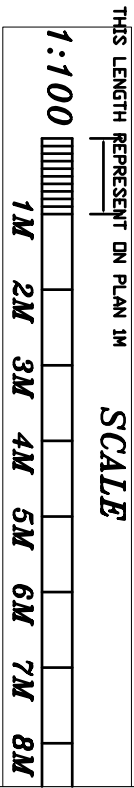

EXISTING GARDEN FLOOR PLAN

PROPOSED GARDEN FLOOR PLAN

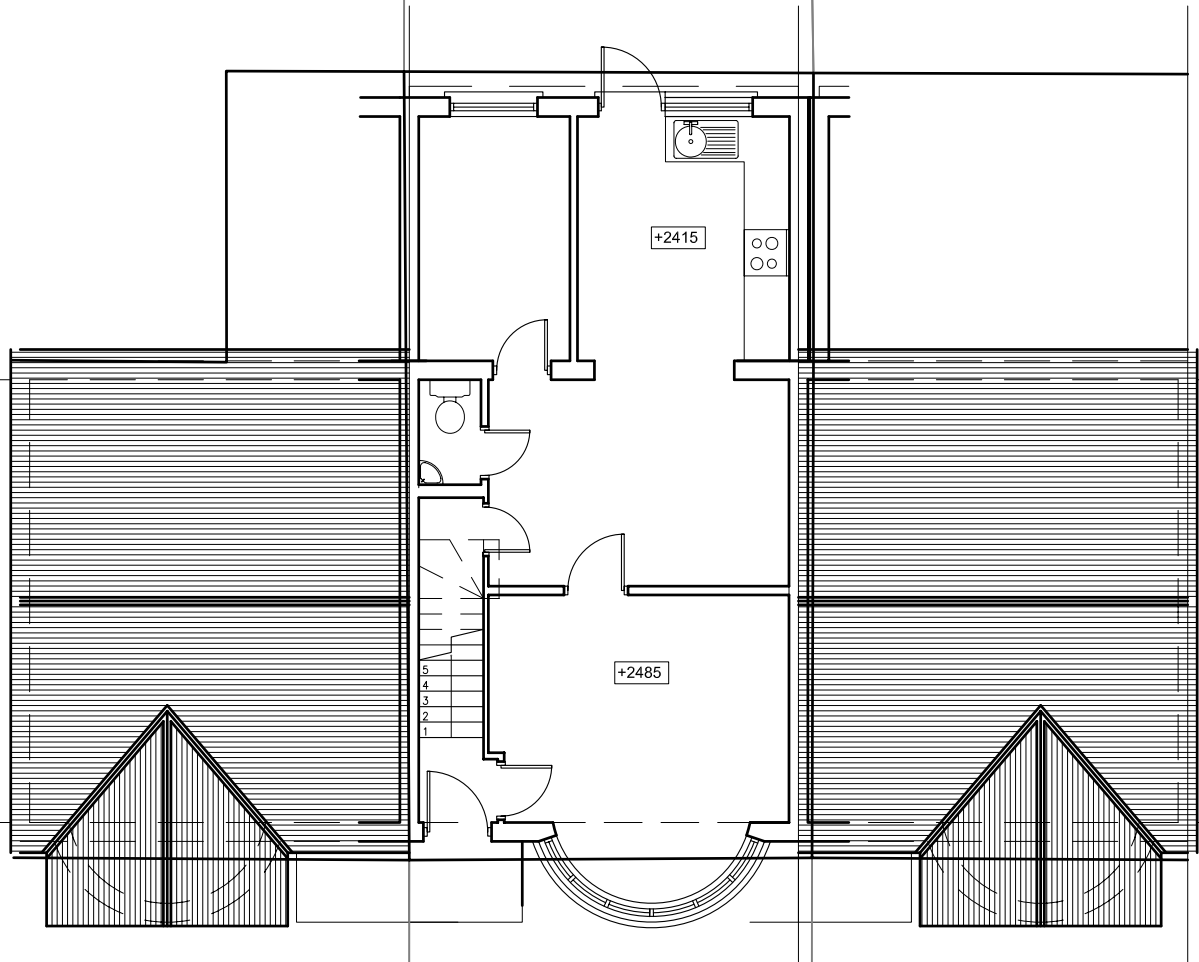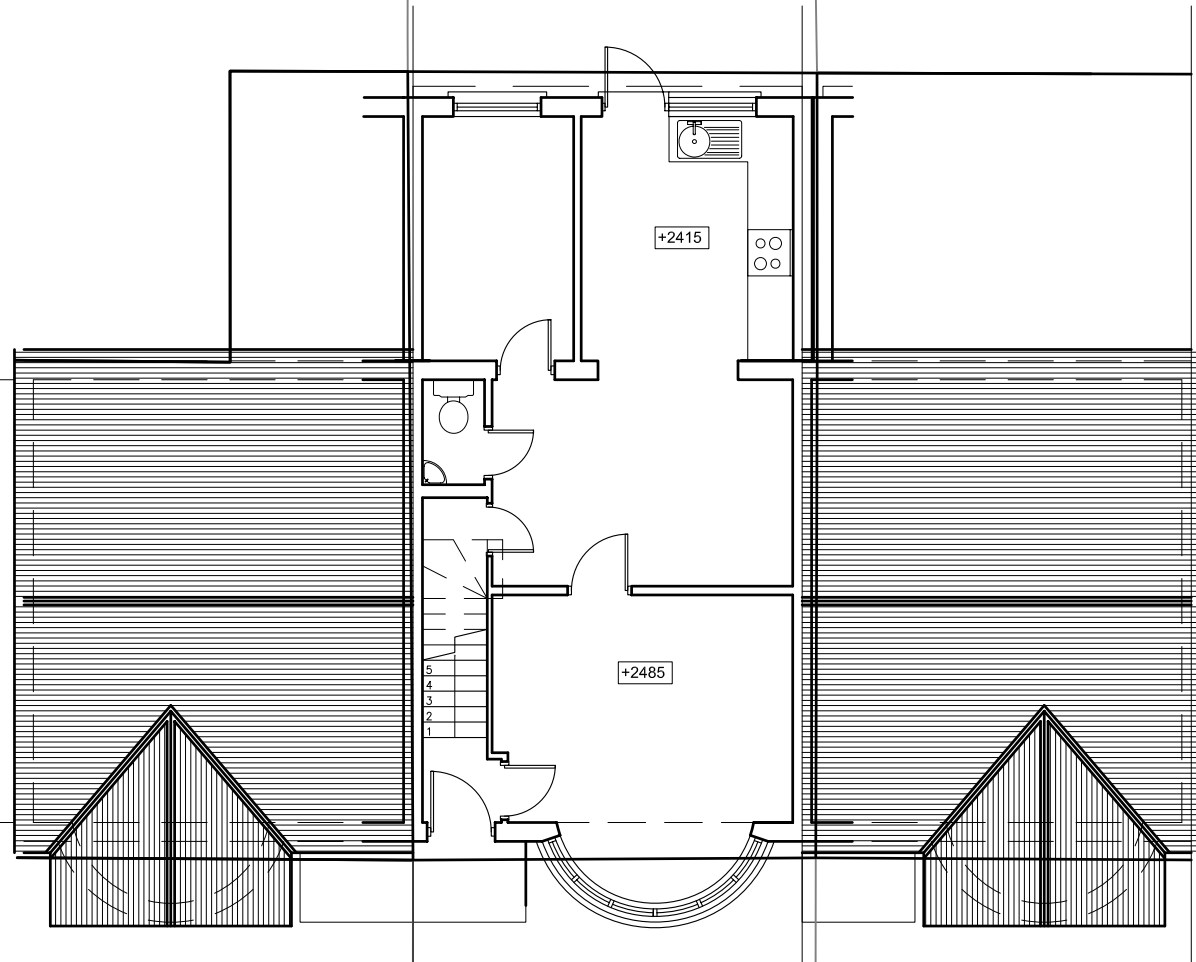


GROUND FLOOR AS EXISTING

GROUND FLOOR AS PROPOSED




PROPOSED FRONT ELEVATION

PROPOSED SIDE ELEVATION

PROPOSED SIDE ELEVATION

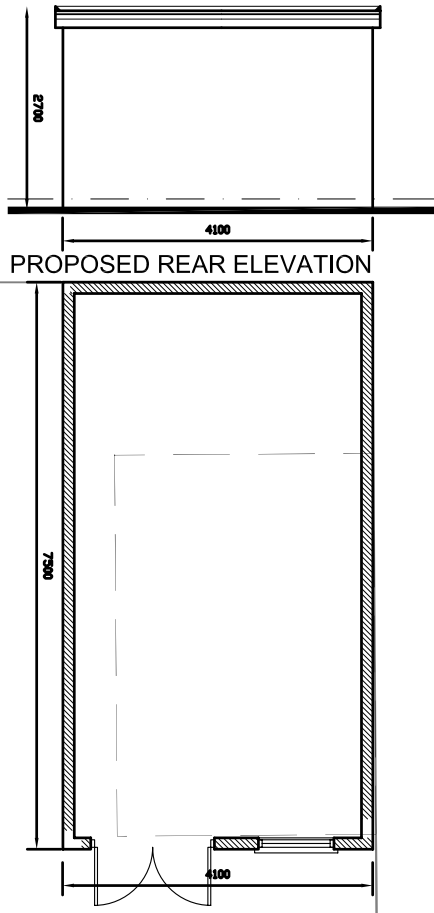

PROPOSED REAR ELEVATION

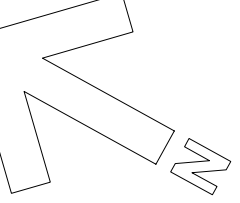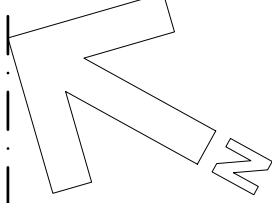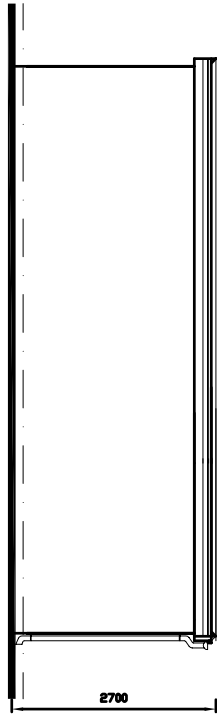

CLIENT/SITE:

MR ROBERT HOWELLS
37 COTTINGHAM CHASE
RUISLIP, MIDDLESEX
HA4 0BZ

DRAWING NAME: OUT BUILDING

TITLE: OUT BUILDING

DWG No: 037/COT/002
REV NO: C

ISSUE: PRELIMINARY
DATE: 02/DEC/2024

DRAWN BY: D.S.W
CKD BY: D.S.W
SCALE: 1:100, 1:1250
CKD BY: D.S.W

REV NO: A client rev - 7500mm length
B OS BOUNDARY REVISED AS PER CLIENTS
C DRAWING REVISED AS BUILT
D
DATE: 18/12/24
08/04/25
18/12/25

Abbey Partnership Ltd
1, WHALEY ROAD
POTTERS BAR
HERTFORDSHIRE
EN11 8JL
info@abbeypartnership.co.uk
www.abbeypartnership.co.uk

Abbey Partnership
Improving homes & lifestyles

SURVEY DESIGN (HARROW) LTD
93 ELIA DRIVE
NORTH HARROW
MIDDLESEX HA2 9BB
FAX: 0208 865 9990
survey.design@tdworld.com

