




SITE LOCATION PLAN
AREA 2 HA
SCALE 1:1250 on A4
CENTRE COORDINATES: 508517, 182355



Supplied by Streetwise Maps Ltd
www.streetwise.net
 Licence No: 100047474
 21/02/2026 12:45

LOCATION PLAN
1:1250 SCALE

SITE PLAN
1:200 SCALE

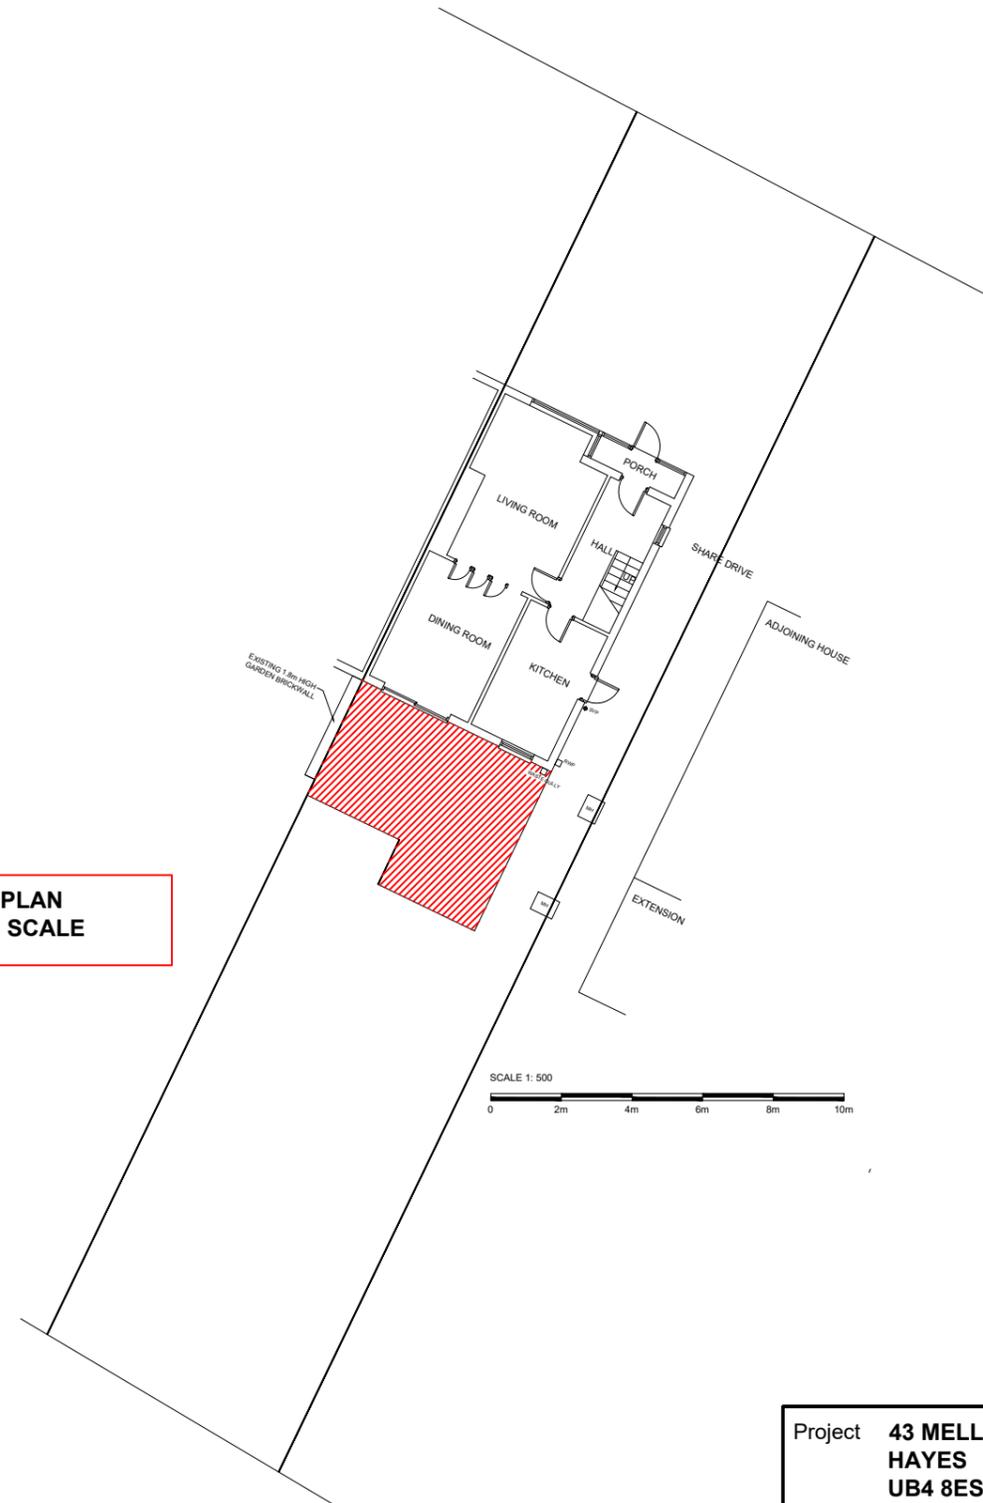

Project	43 MELLOW LANE EAST HAYES UB4 8ES	
Drawing Title	Location Plan & As Built Site Plan	
Drawing Title	143 /P/A	Rev.
Rev.	Scale: 1/1250 1: 200	Date: Jan 2026