

CLOUDED

01 Section 73 Issue 25.05.23

ITEM	DESCRIPTION	DATE
1	Section 73 Issue	23.03.23

EV DESCRIPTION DATE

IID Architects
Richmond Place
15 Petersham Road

13 Peterham Road
Richmond
TW10 6TP

info@iid.co.uk
020 7631 1000

020 3274 1000
www.iid.co.uk

CLIENT

ACS International Schools

11. *What is the primary purpose of the following statement?*

PROJECT

ACS Hillingdon - Sports Hall

extension

DRAWING TITLE

Proposed Block Plan

CALE @ A1: As indicated

PLANNING AND PLACEMENT

DRAWING NUMBER						REV
Object No.	Origin.	Zone	Level	Type	Drawing Number	

689 IID PL XX DR A-1002 P01

11 of 11 pages

Digitized by srujanika@gmail.com


Scale (m) @ 1: 500

0 5 10 15 20



Scope of Projects

-  Project A
Science Extension
-  Project B
Academic Centre
-  Project C
First Floor Repurpose
-  Project D
Sports Extension
-  Project E
Staff & Administration

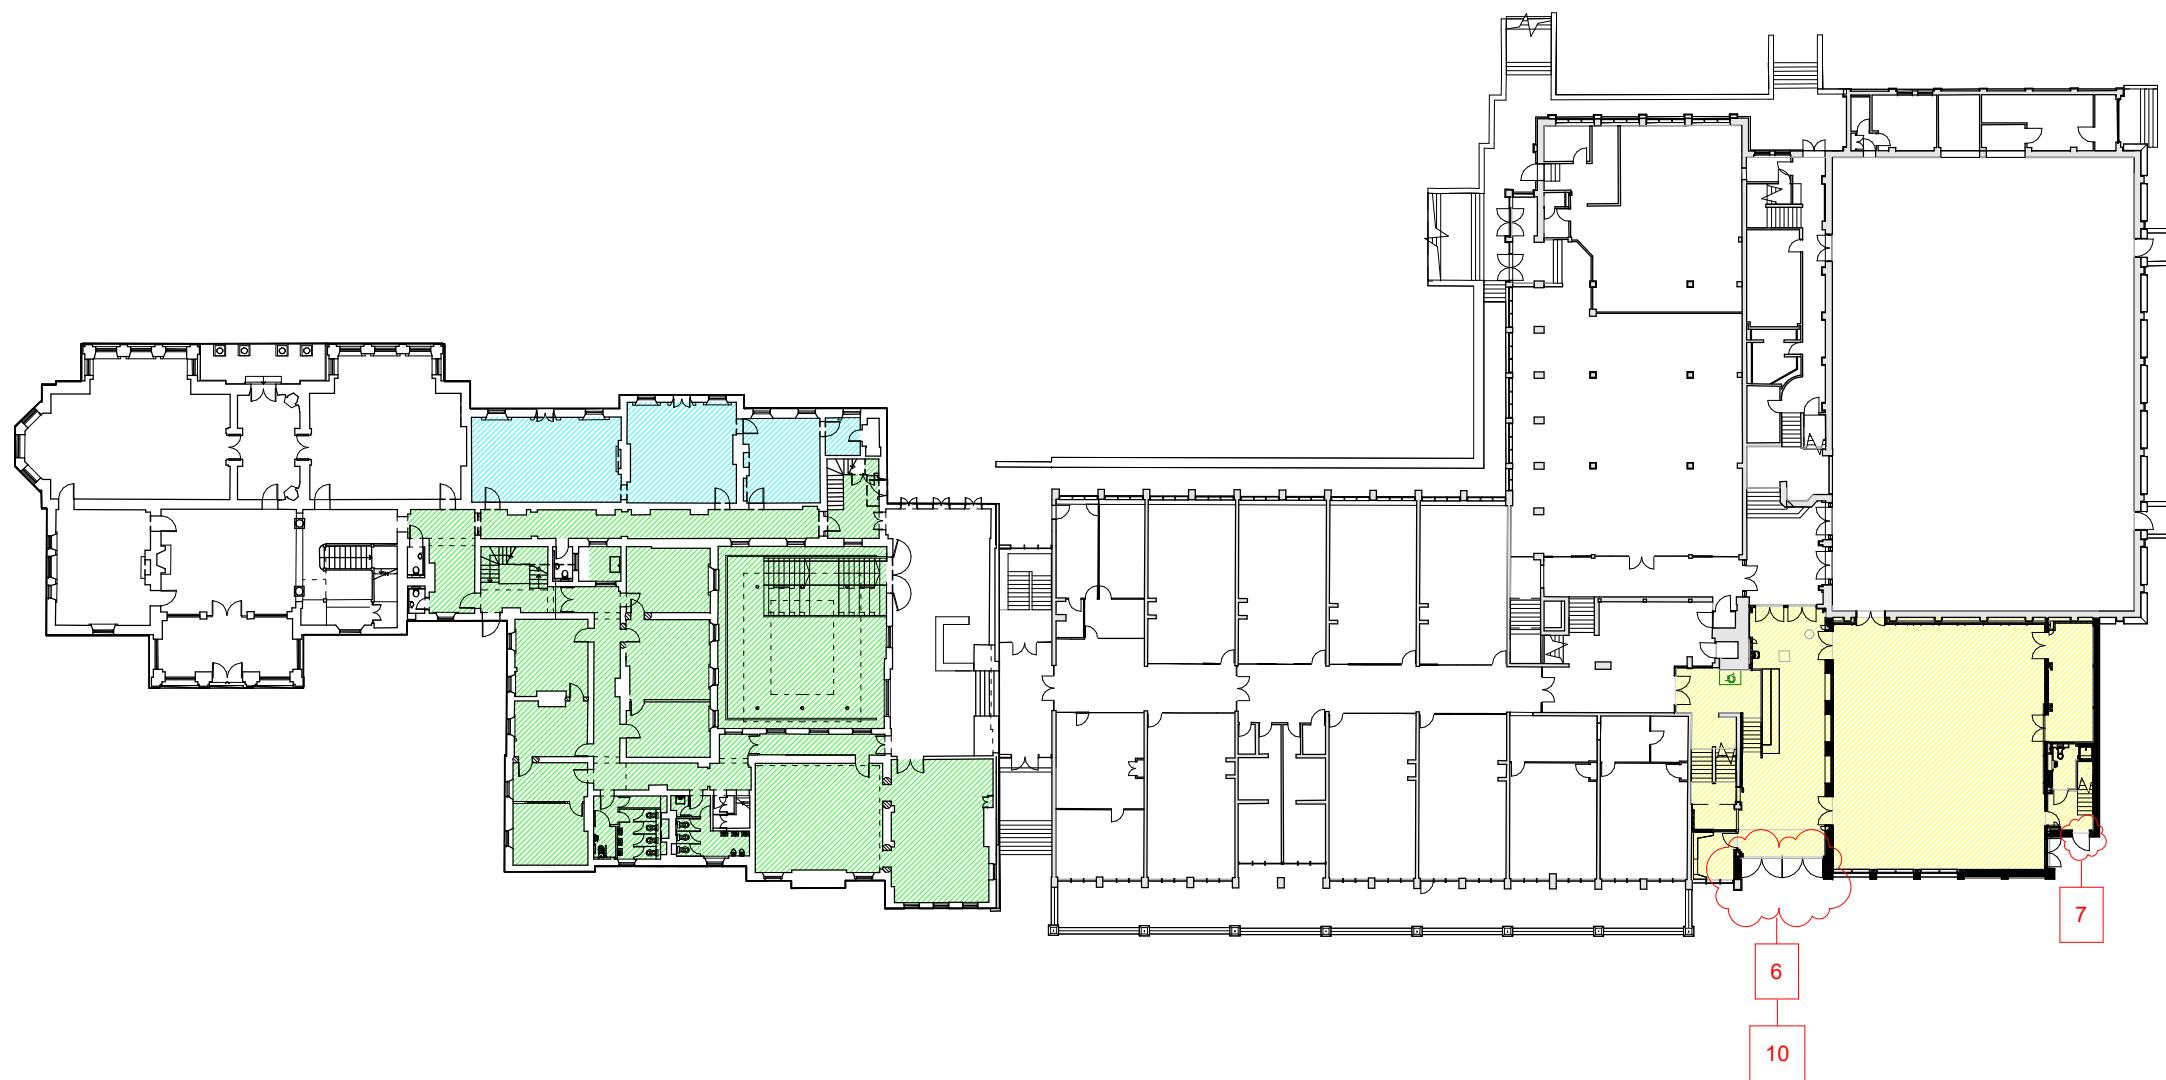

P01 Section 73 Issue 25.05.23

REV DESCRIPTION DATE



CLIENT
ACS International Schools

PROJECT
ACS Hillingdon - Sports Hall Extension

DRAWING TITLE
Scope of Proposed Projects
Ground Floor

SCALE @ A3: As indicated

DRAWING NUMBER						REV
Project No.	Origin.	Zone	Level	Type	Drawing Number	
1689	IID	PL	XX	DR	A-1021	P01


Scale (m) @ 1: 500

0 5 10 15 20



Scope of Projects

-  Project A
Science Extension
-  Project B
Academic Centre
-  Project C
First Floor Repurpose
-  Project D
Sports Extension
-  Project E
Staff & Administration

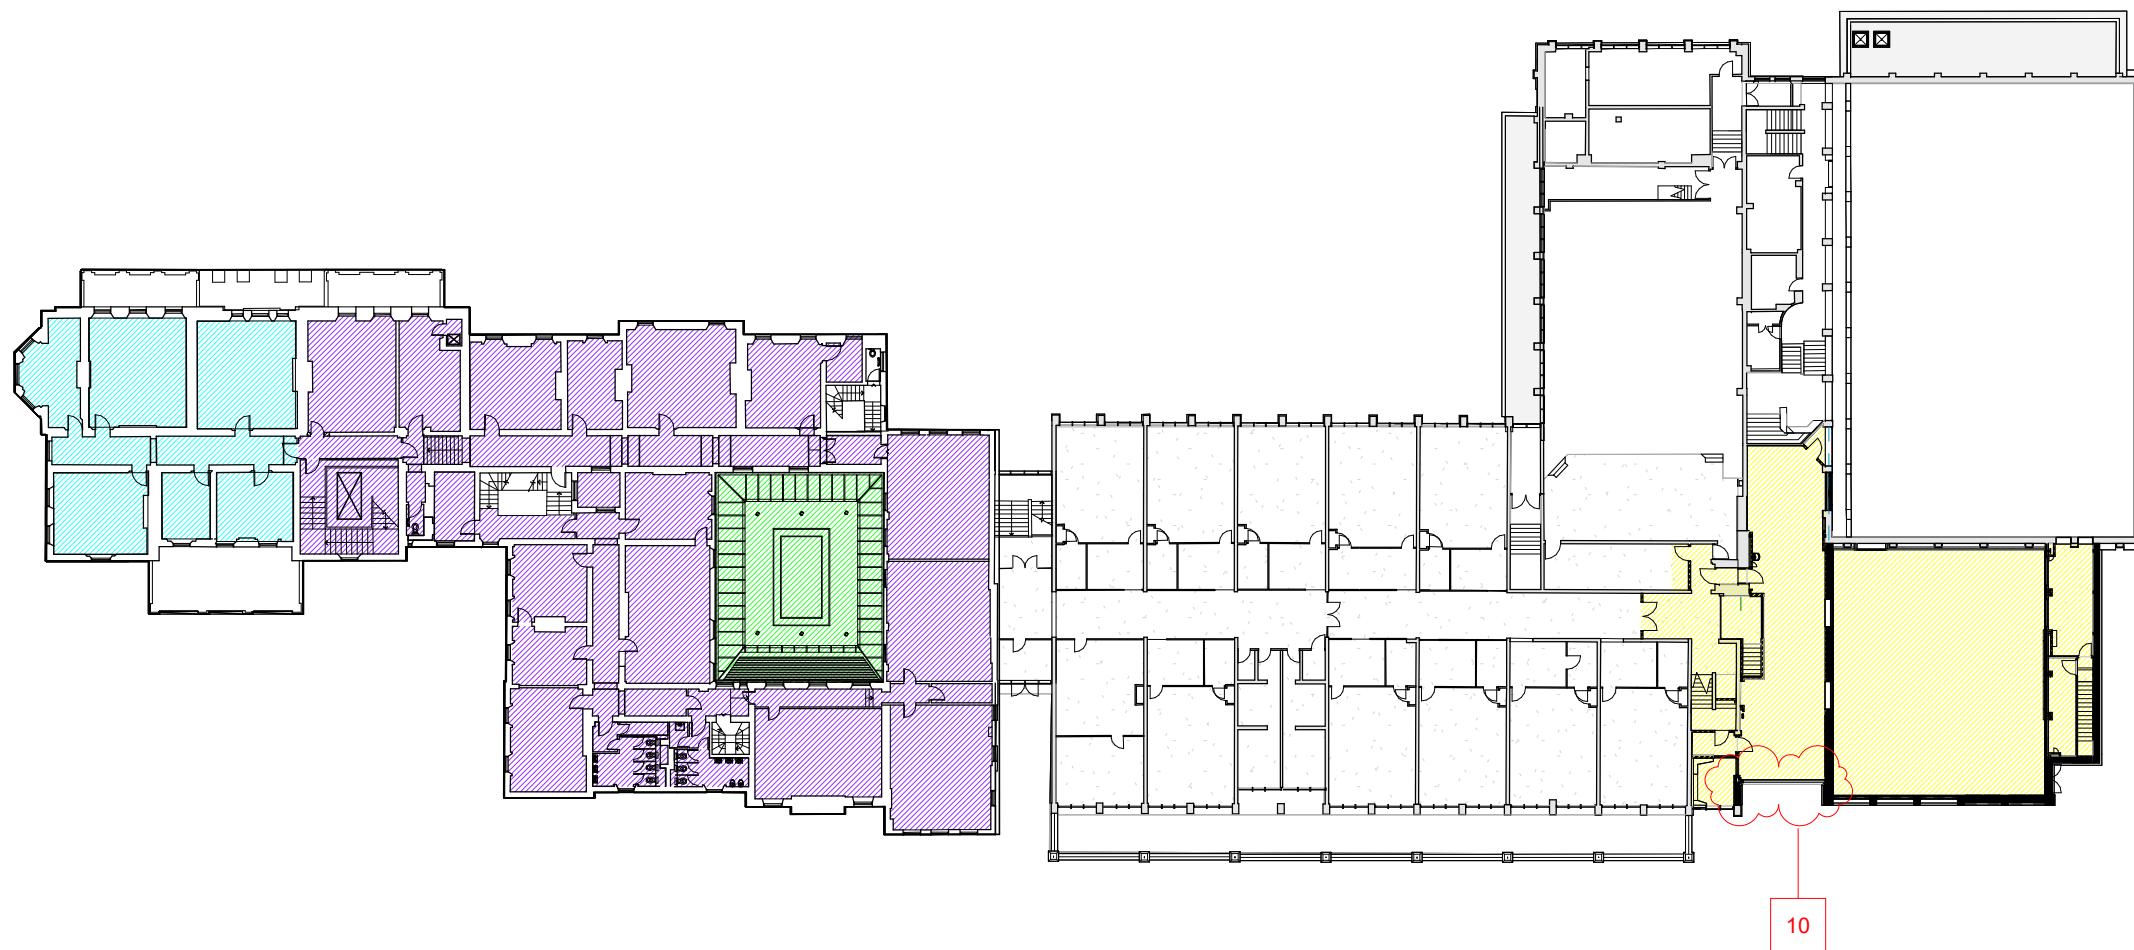

P01 Section 73 Issue 25.05.23

REV DESCRIPTION DATE



IID Architects
Richmond Place
15 Petersham Road
Richmond
TW10 6TP
info@iid.co.uk
020 3274 1000
www.iid.co.uk

CLIENT	ACS International Schools
PROJECT	ACS Hillingdon - Sports Hall Extension
DRAWING TITLE	Scope of Proposed Projects First Floor

SCALE @ A3: As indicated


DRAWING NUMBER						REV
Project No.	Origin.	Zone	Level	Type	Drawing Number	
1689	IID	PL	XX	DR	A-1022	P01

Scale (m) @ 1: 500
0 5 10 15 20



Scope of Projects

	Project A Science Extension
	Project B Academic Centre
	Project C First Floor Repurpose
	Project D Sports Extension
	Project E Staff & Administration

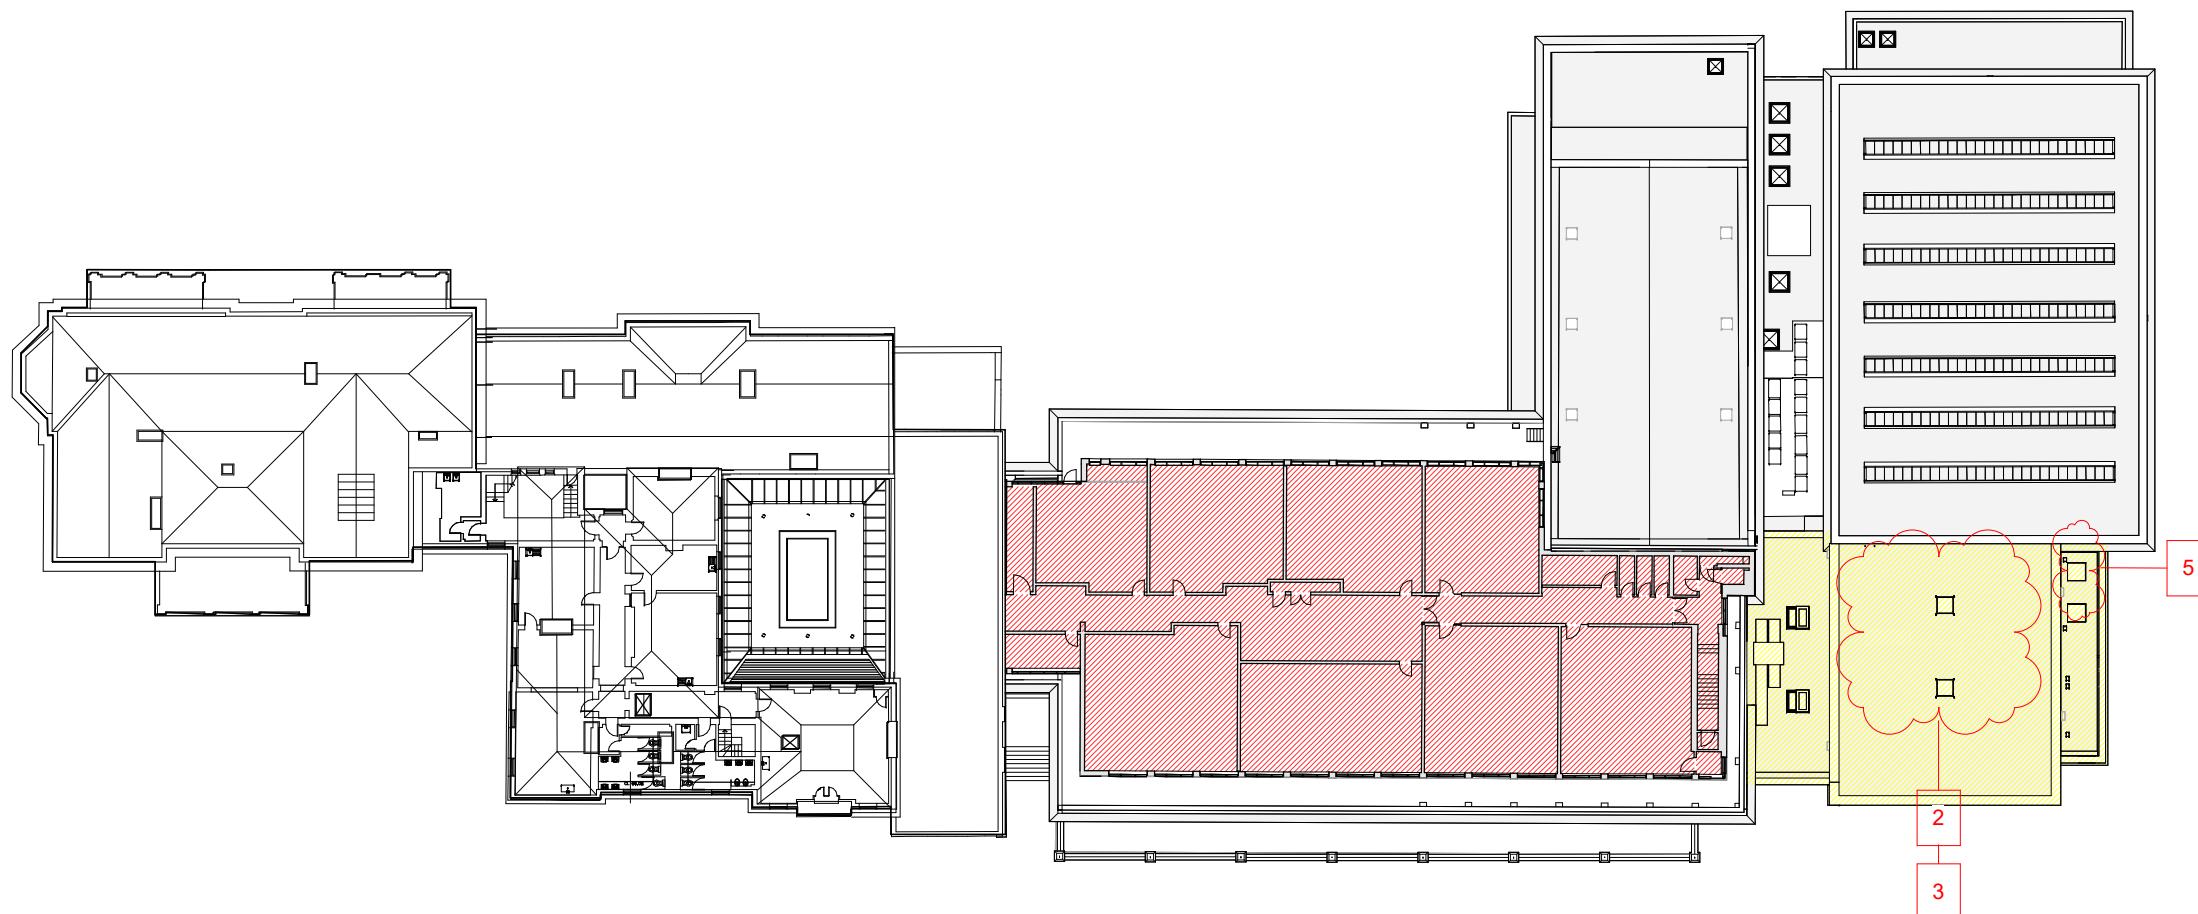

P01 Section 73 Issue 25.05.23

REV DESCRIPTION DATE



IID Architects
Richmond Place
15 Petersham Road
Richmond
TW10 6TP
info@iid.co.uk
020 3274 1000
www.iid.co.uk

CLIENT	ACS International Schools
PROJECT	ACS Hillingdon - Sports Hall Extension
DRAWING TITLE	Scope of Proposed Projects Second Floor
SCALE @ A3:	As indicated


DRAWING NUMBER						REV
Project No.	Origin.	Zone	Level	Type	Drawing Number	
1689	IID	PL	XX	DR	A-1023	P01

Scale (m) @ 1: 500
0 5 10 15 20



Scope of Projects

- Additional building footprint
- Additional floor space (provided by adding roof to courtyard)

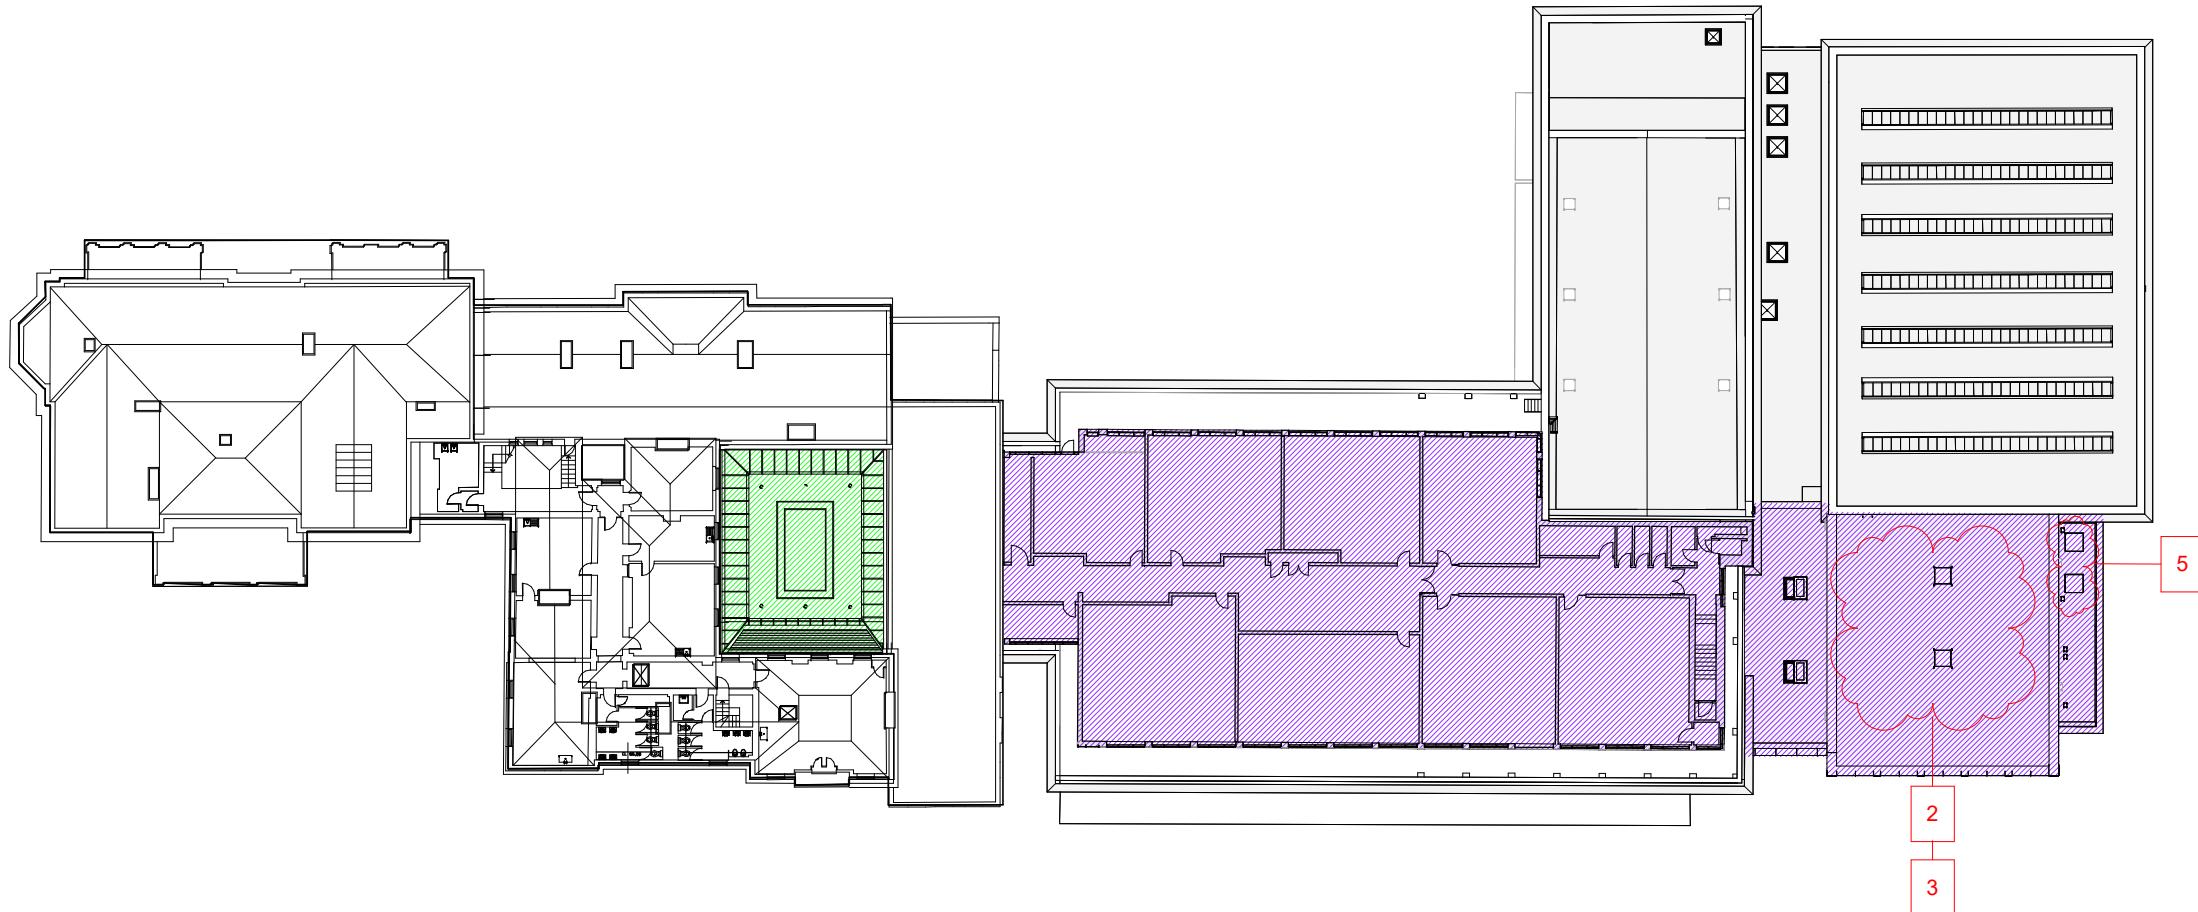

Project B: Academic Centre

Project A: Science

Project D: Multi-Use Hall

P01 Section 73 Issue 25.05.23

REV DESCRIPTION DATE

IID
IID Architects
Richmond Place
15 Petersham Road
Richmond
TW10 6TP
info@iid.co.uk
020 3274 1000
www.iid.co.uk


CLIENT
ACS International Schools

PROJECT
ACS Hillingdon - Sports Hall Extension

DRAWING TITLE
Scope of Proposed Projects
Roof Plan

SCALE @ A3: As indicated

DRAWING NUMBER						REV
Project No.	Origin.	Zone	Level	Type	Drawing Number	
1689	IID	PL	XX	DR	A-1024	P01

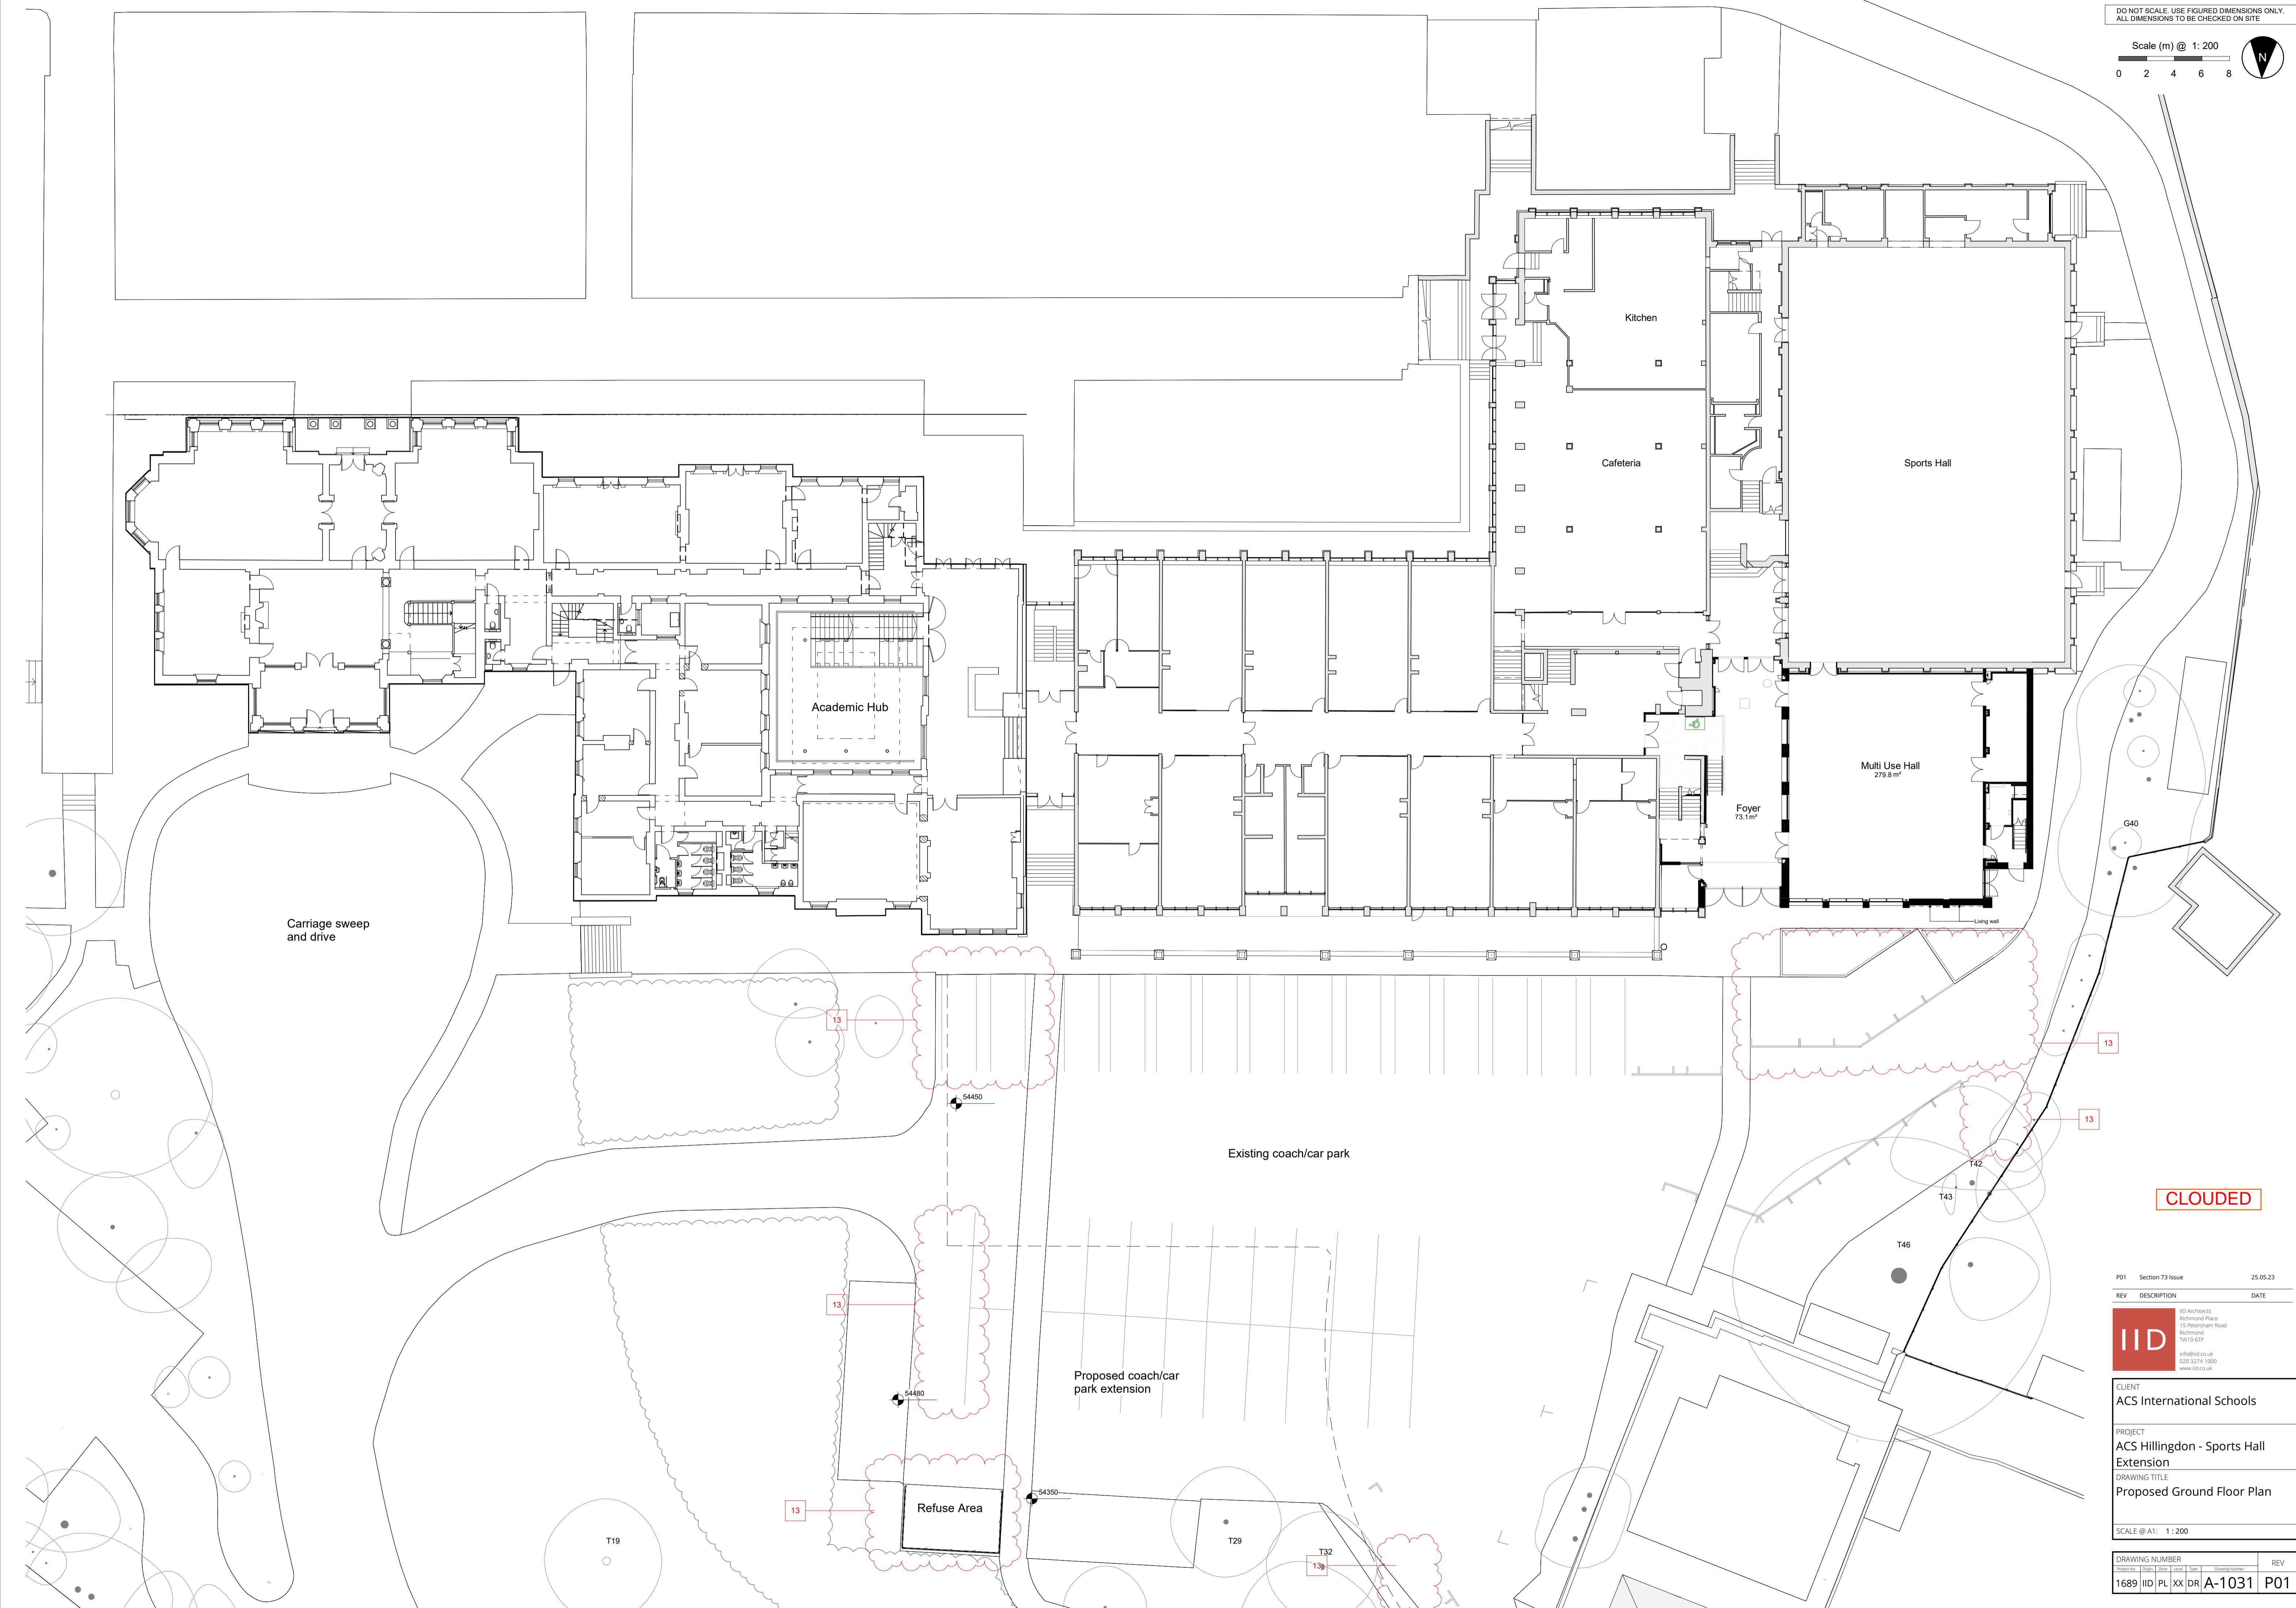



CLOUDED

P01 Section 73 Issue 25.05.23
 REV DESCRIPTION DATE

IID
 IID Architects
 Richmond Place
 11 Richmond Road
 Richmond
 TW10 6TP
 info@iid.co.uk
 020 3274 1000
 www.iid.co.uk


CLIENT
 ACS International Schools


PROJECT
 ACS Hillingdon - Sports Hall Extension

DRAWING TITLE
 Proposed First Floor Plan

SCALE @ A1: 1:200

DRAWING NUMBER
 Project No. Origin Zone Level Type Drawing Number
 1689 IID PL XX DR A-1032 P01

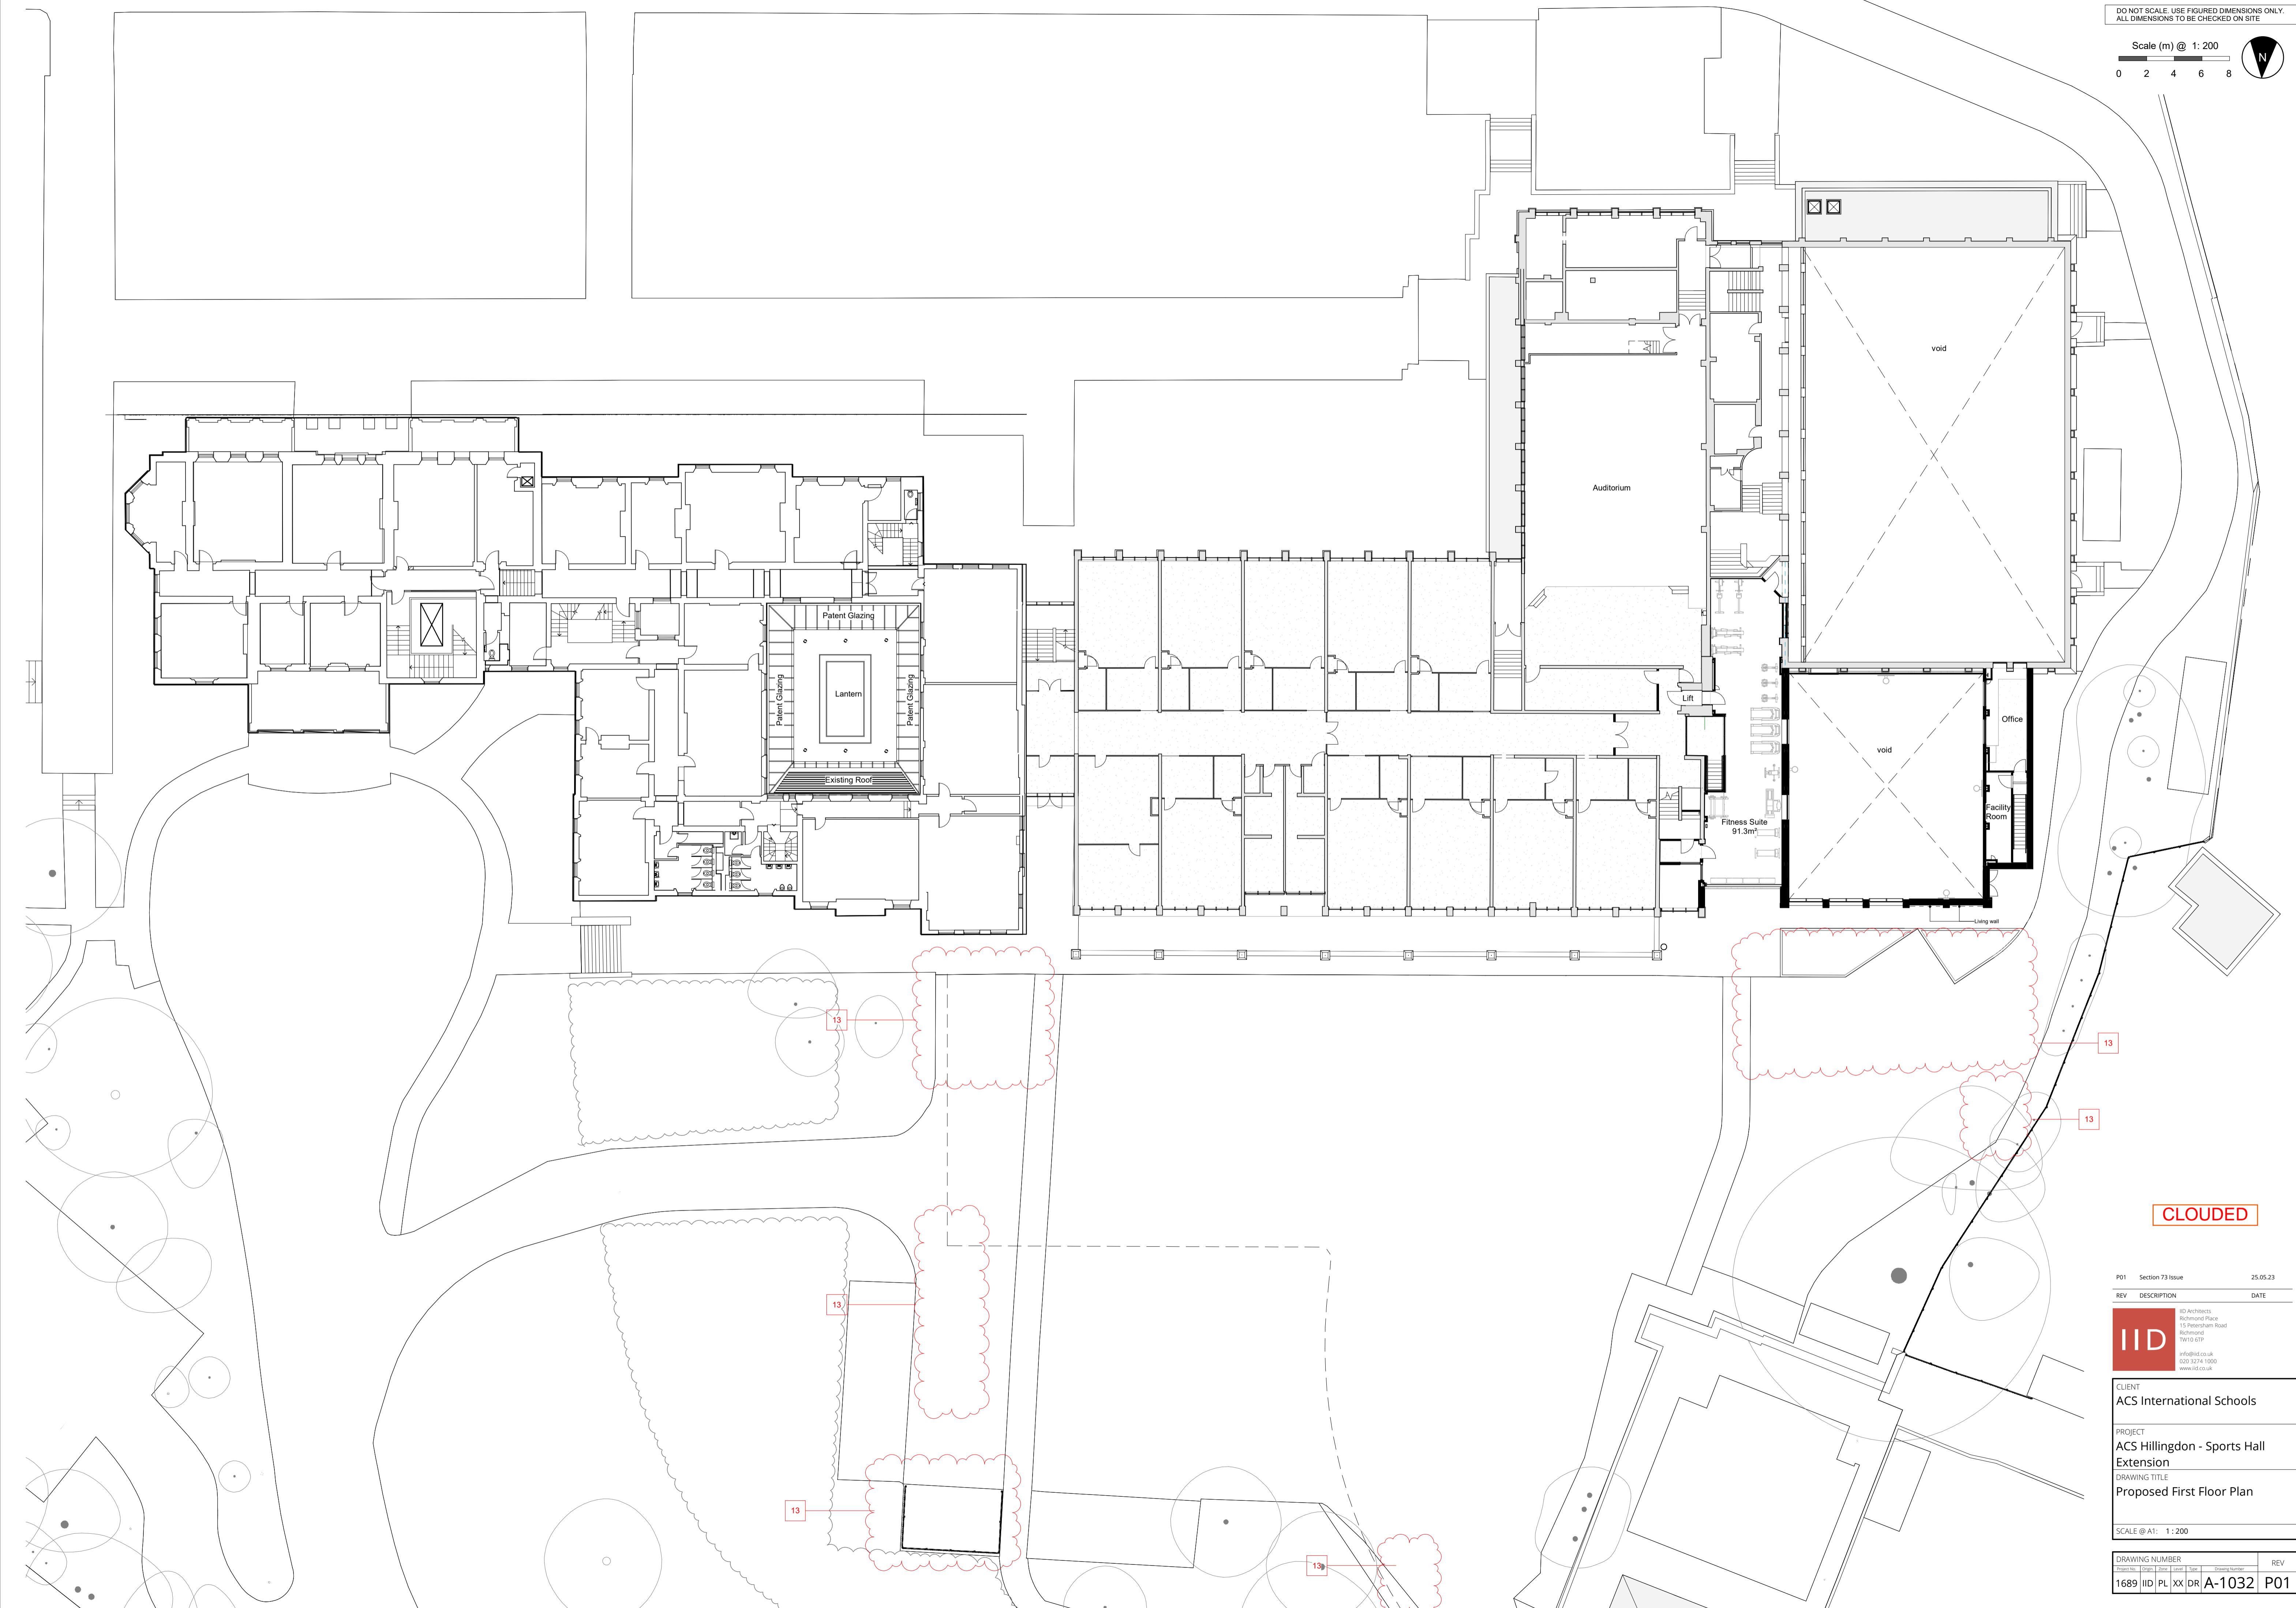

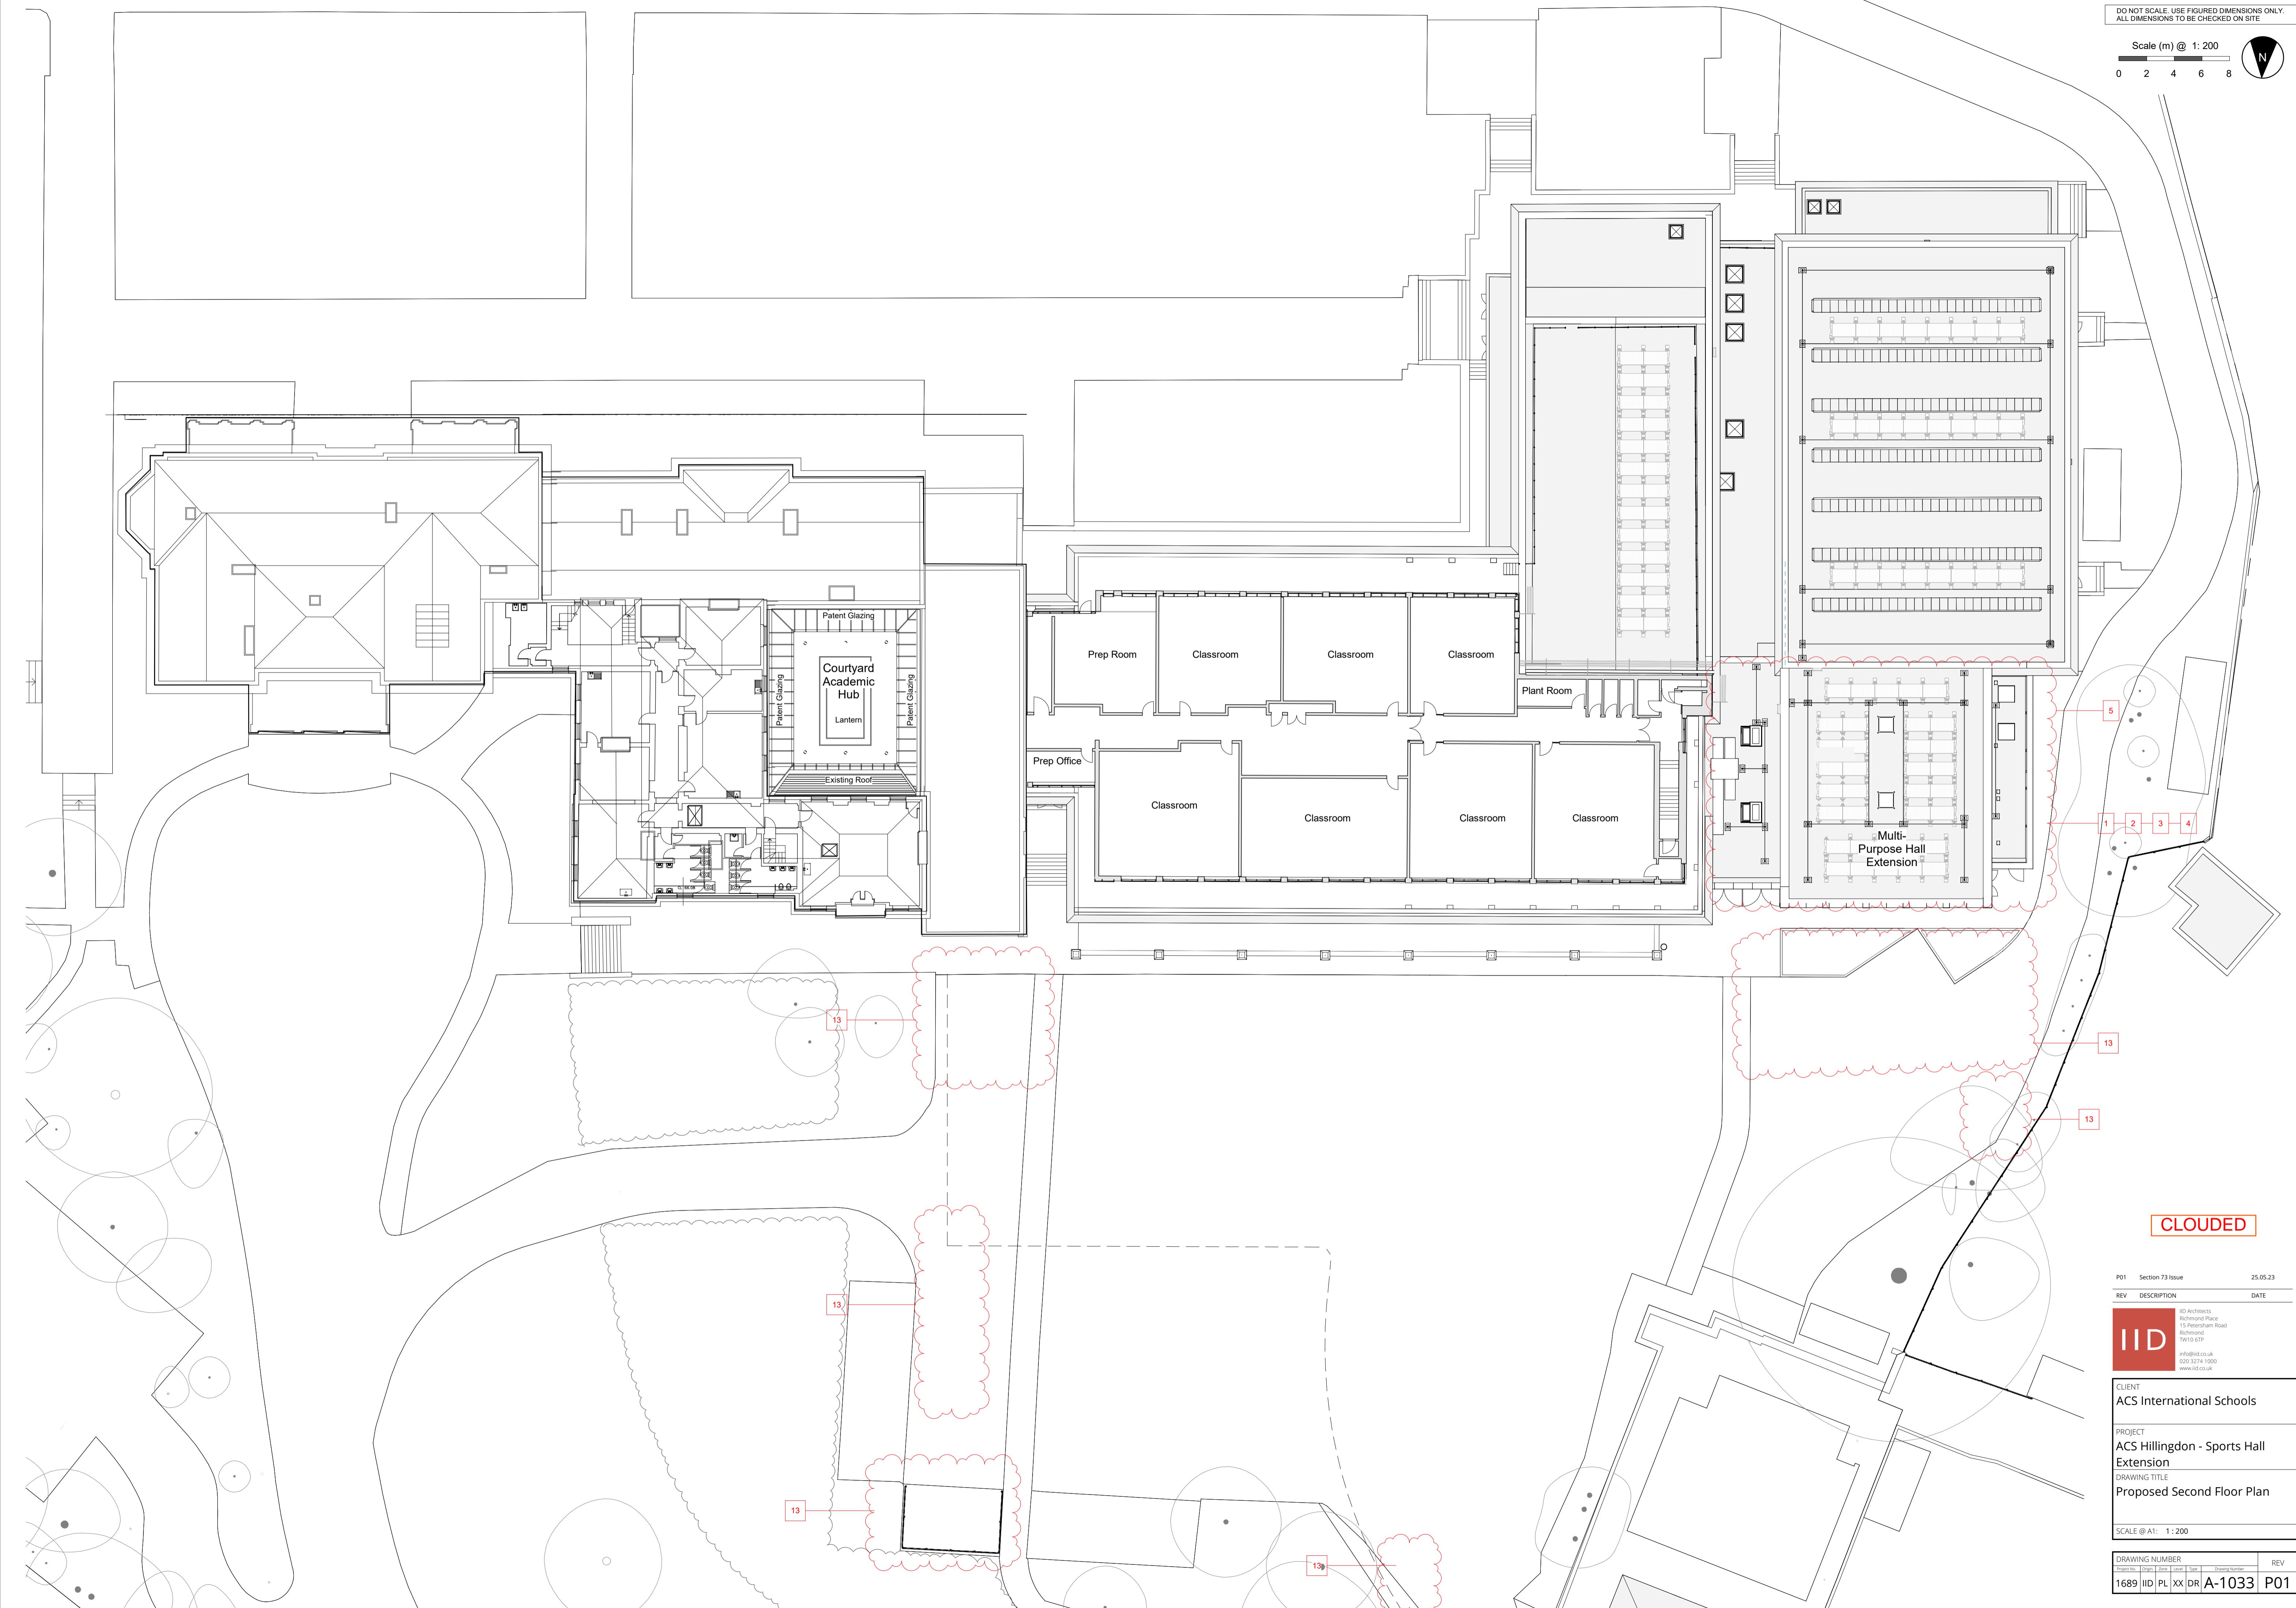



For roof plant see PW drawing M-57-RF-001 Rev.C1
approved under Application Ref.
2392/APP/2016/1693

CLOUDED

P01 Section 73 Issue 25.05.23

REV DESCRIPTION DATE

IID
IID Architects
Richmond Place
11 Richmond Road
Richmond
TW10 6TP
info@iid.co.uk
020 3274 1000
www.iid.co.uk

CLIENT
ACS International Schools

PROJECT
ACS Hillingdon - Sports Hall
Extension
DRAWING TITLE
Proposed Roof Plan


SCALE @ A1: 1:200

DRAWING NUMBER REV

1689 IID PL XX DR A-1034 P01


Location Plan

1 : 1000

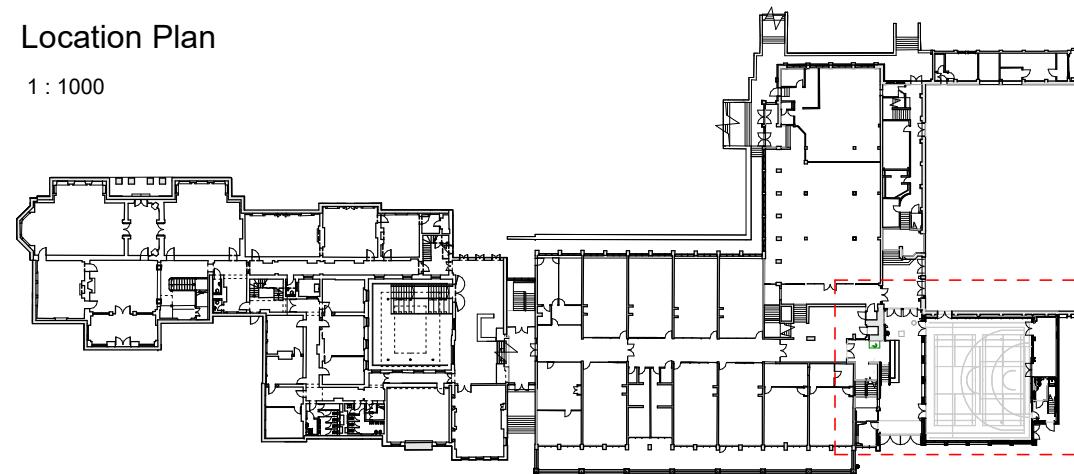

DO NOT SCALE. USE FIGURED DIMENSIONS ONLY.
ALL DIMENSIONS TO BE CHECKED ON SITE

Scale (m) @ 1: 100
0 1 2 3 4

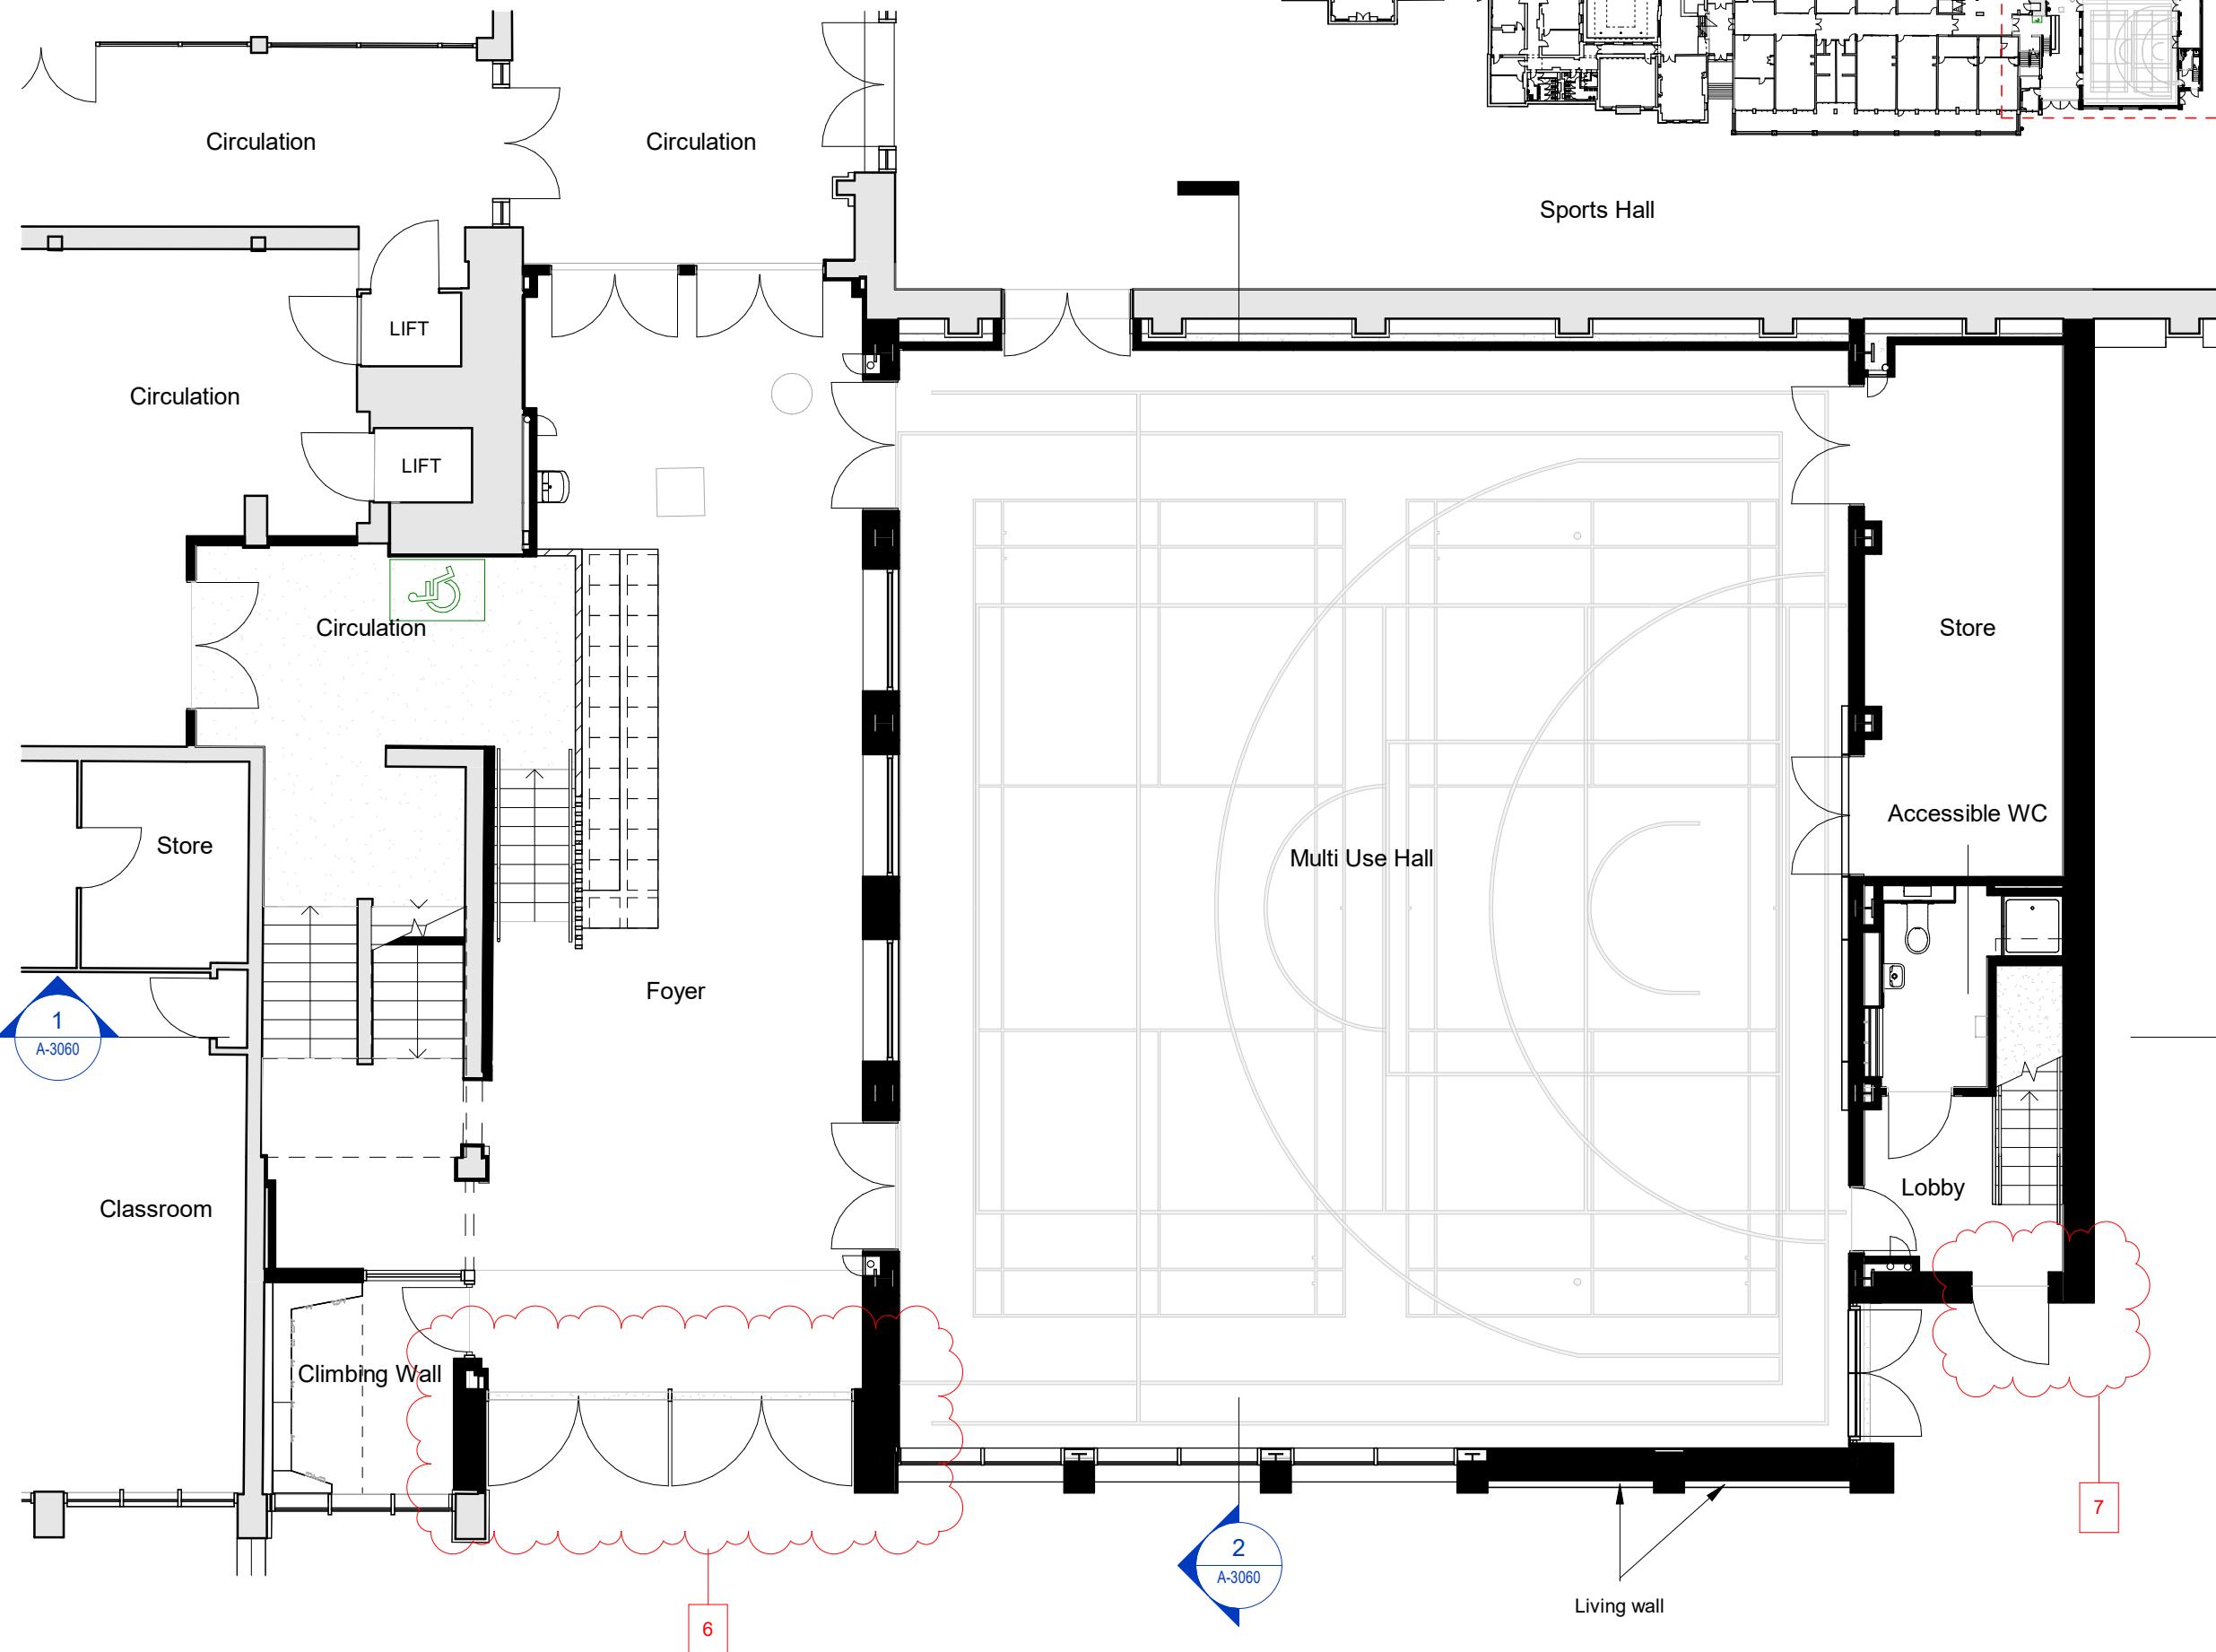

CLOUDED

P01 Section 73 Issue 25.05.23

REV DESCRIPTION DATE



IID Architects
Richmond Place
15 Petersham Road
Richmond
TW10 6TP
info@iid.co.uk
020 3274 1000
www.iid.co.uk

CLIENT
ACS International Schools

PROJECT
ACS Hillingdon - Sports Hall Extension


DRAWING TITLE
Proposed Multi-use Hall
Ground Floor Plan

SCALE @ A3: As indicated

DRAWING NUMBER						REV
Project No.	Origin.	Zone	Level	Type	Drawing Number	
1689	IID	PL	XX	DR	A-1036	P01

Location Plan


1 : 1000

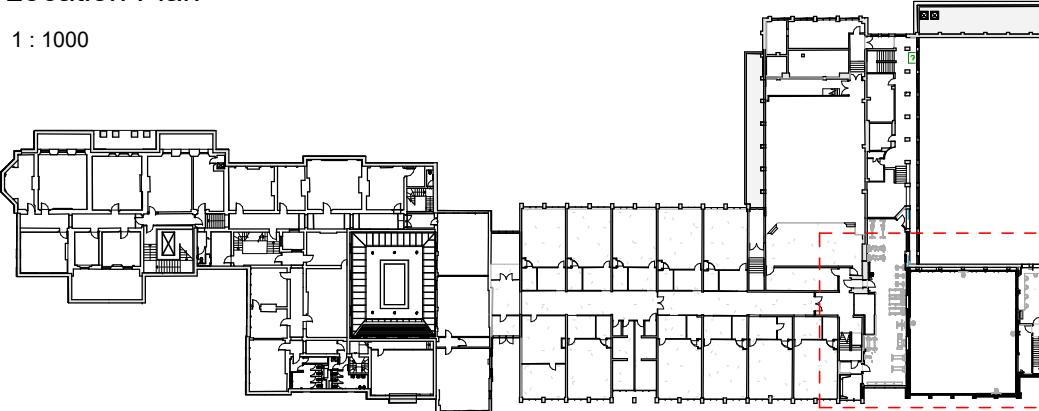

DO NOT SCALE. USE FIGURED DIMENSIONS ONLY.
ALL DIMENSIONS TO BE CHECKED ON SITE

Scale (m) @ 1: 100

0 1 2 3 4

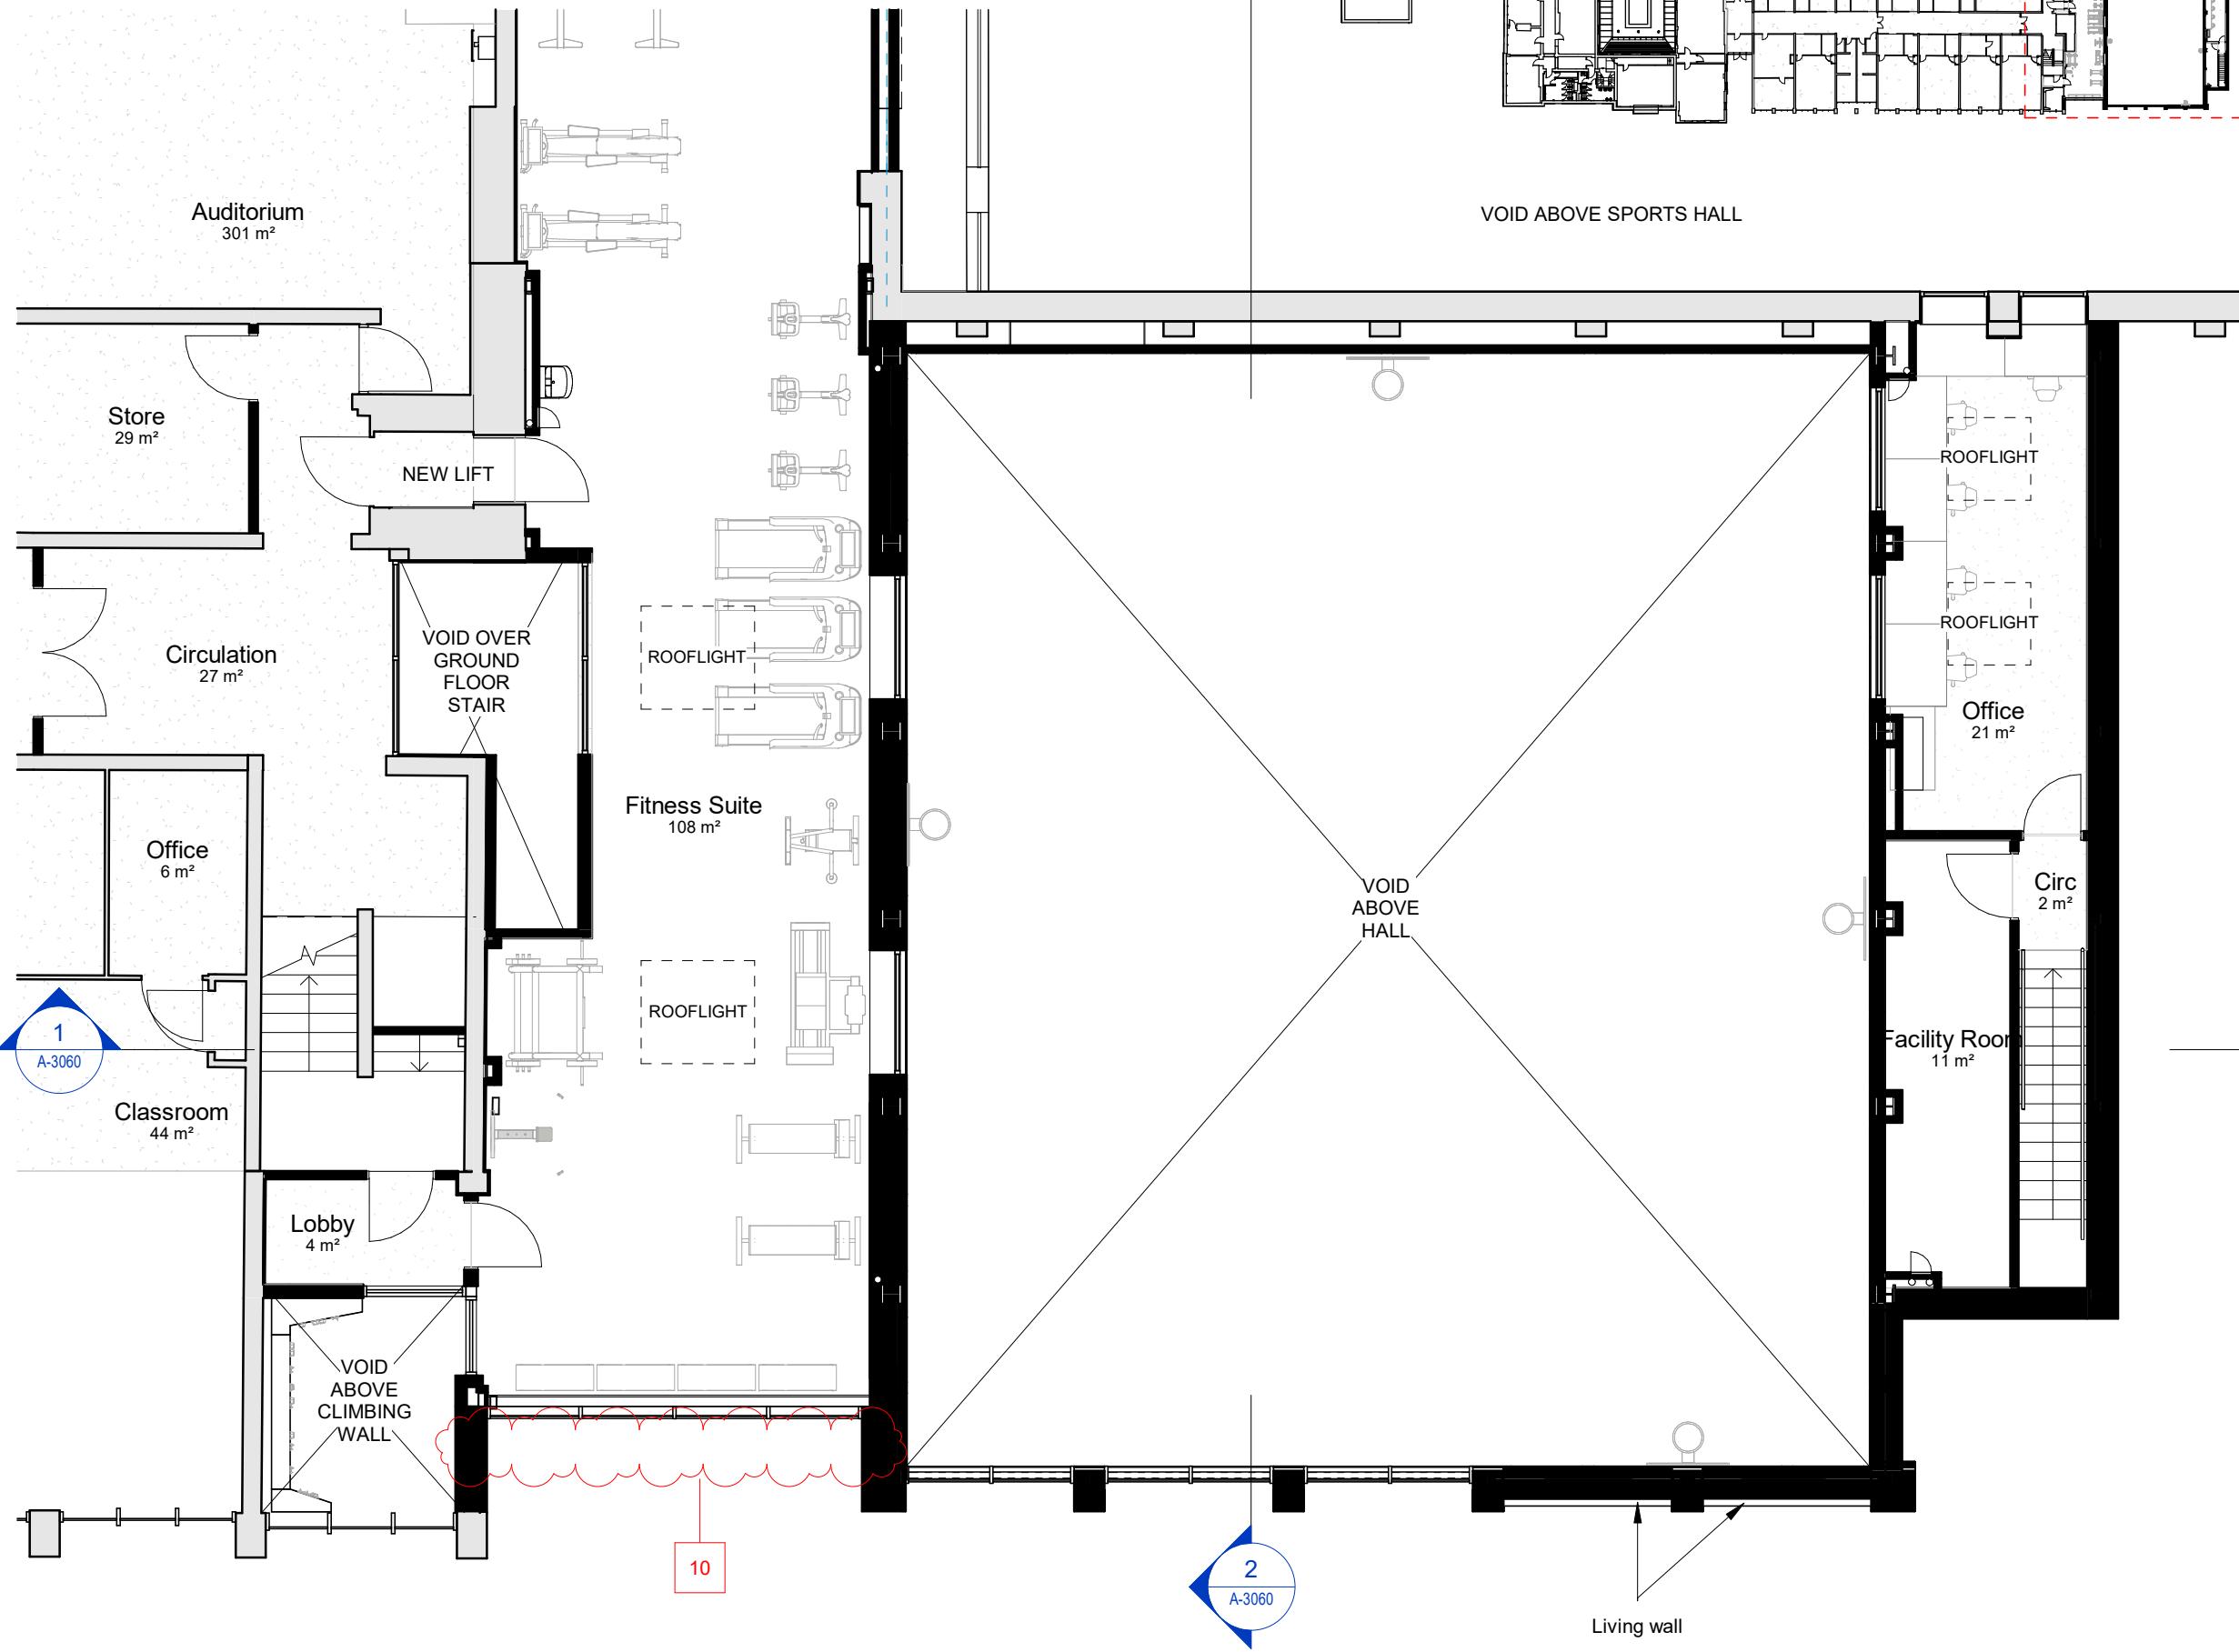

P01 Section 73 Issue 25.05.23

REV DESCRIPTION DATE



IID Architects
Richmond Place
15 Petersham Road
Richmond
TW10 6TP
info@iid.co.uk
020 3274 1000
www.iid.co.uk

CLIENT
ACS International Schools


PROJECT
ACS Hillingdon - Sports Hall Extension

DRAWING TITLE
Proposed Multi-use Hall First Floor Plan

SCALE @ A3: As indicated


DRAWING NUMBER						REV
Project No.	Origin.	Zone	Level	Type	Drawing Number	REV
1689	IID	PL	XX	DR	A-1037	P01

Scale (m) @ 1: 250
0 2.5 5 7.5 10

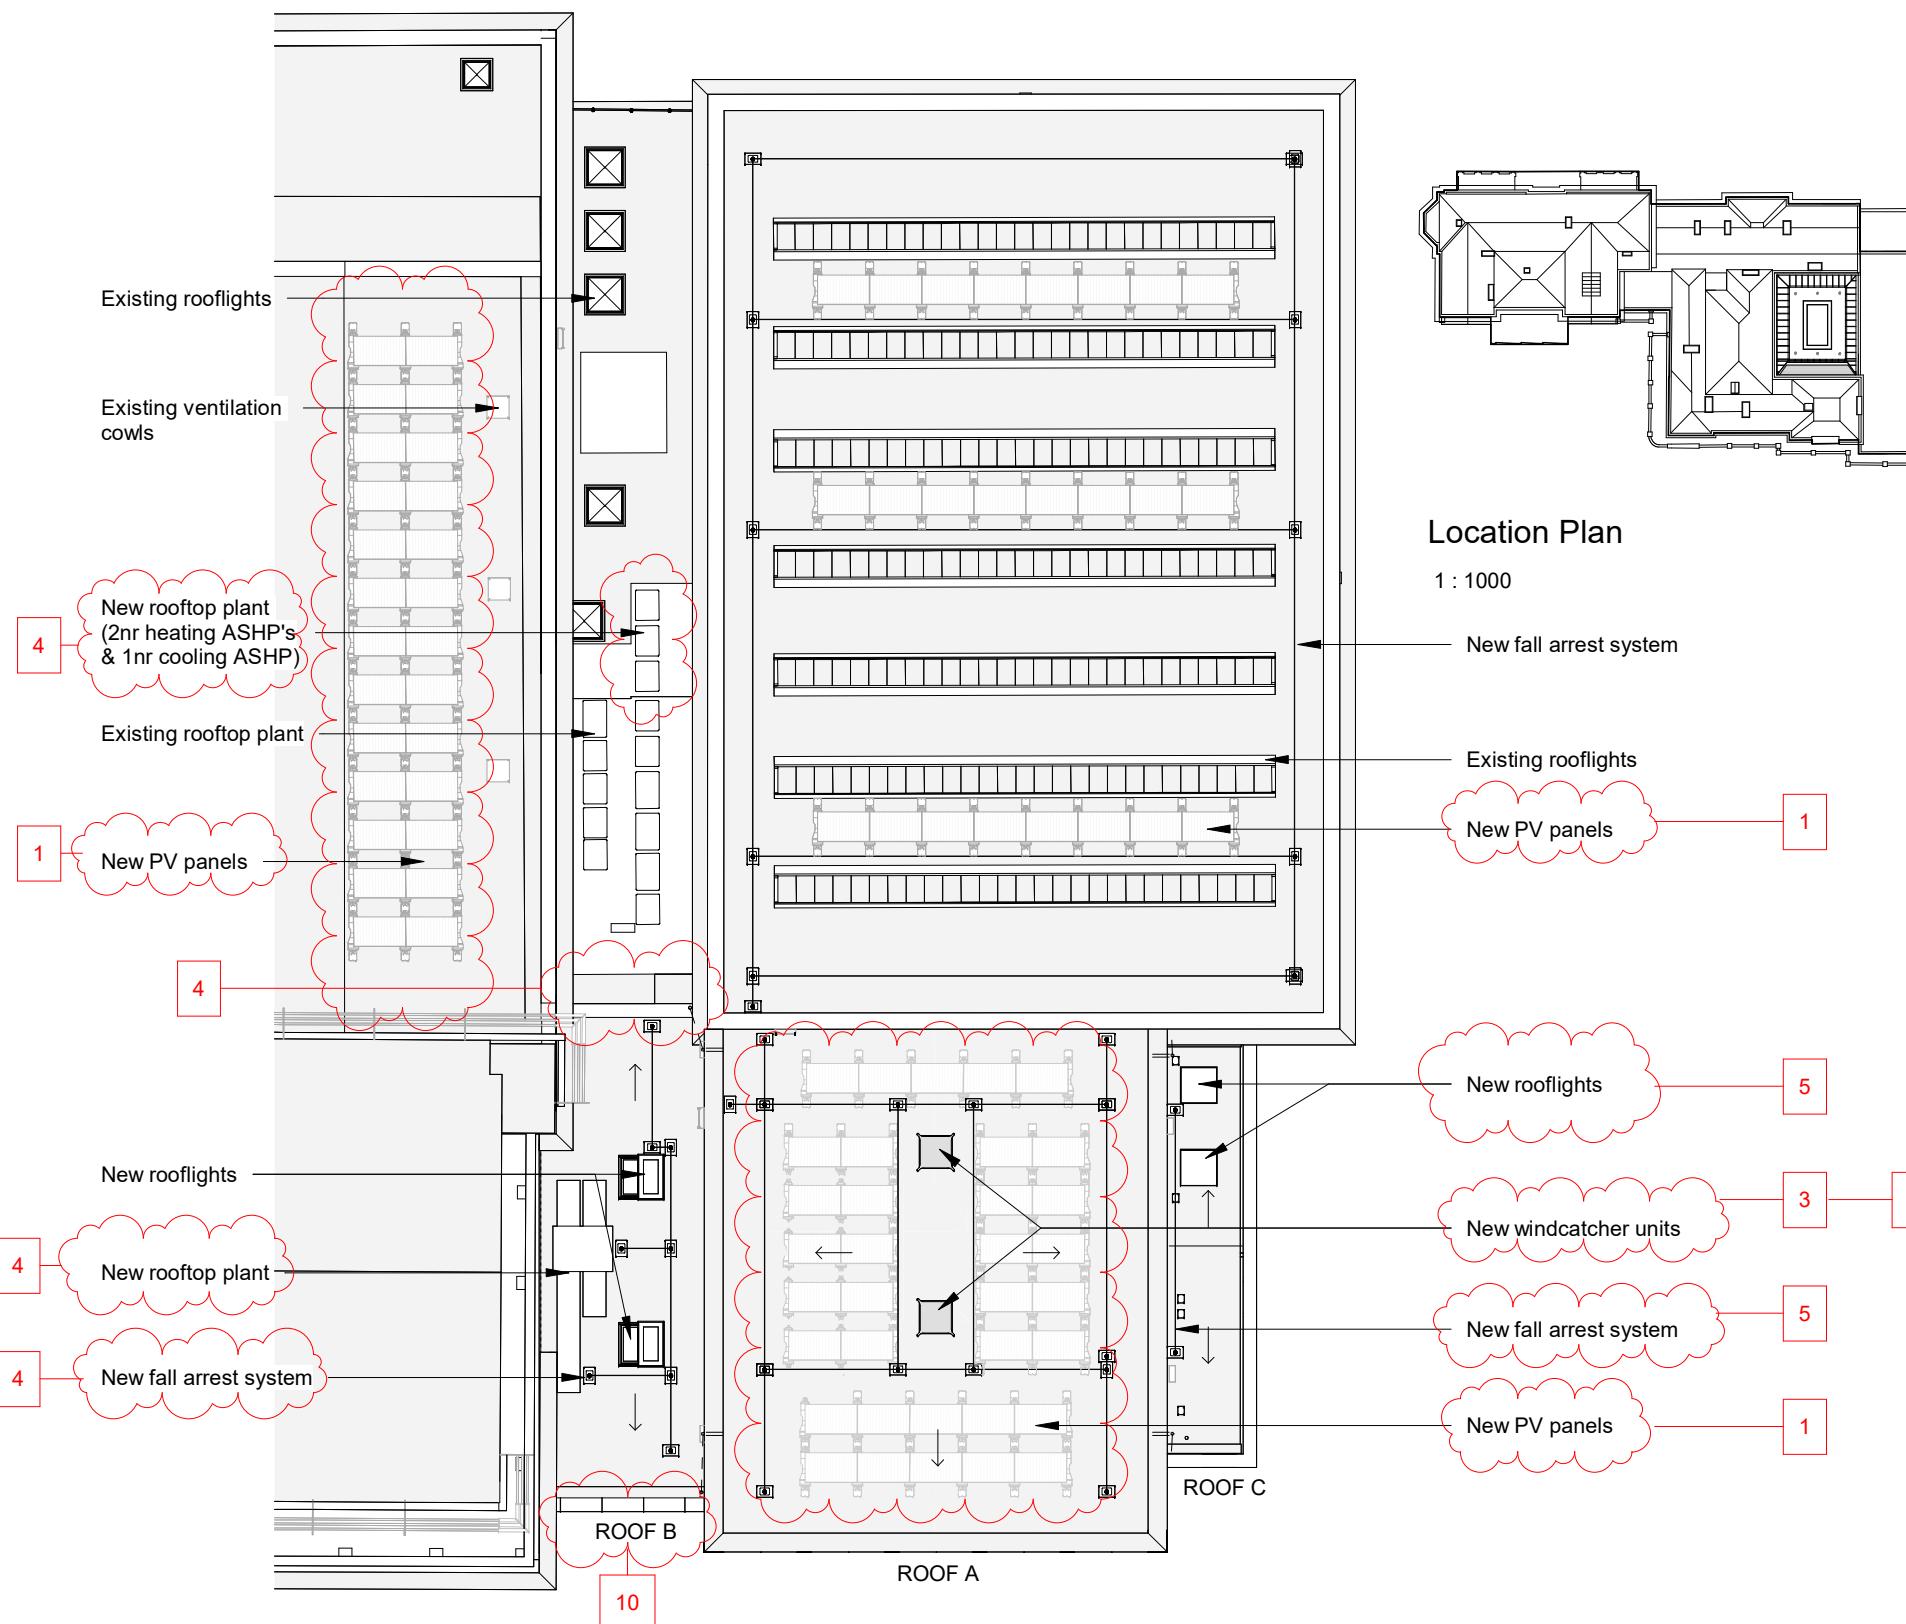

Existing Sports Hall Proposed Roof Layout

1 : 250

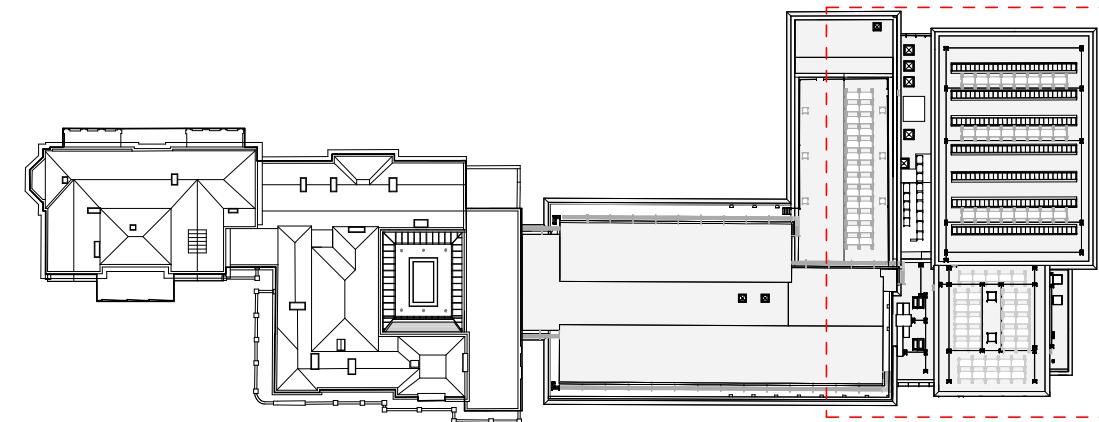

Location Plan

1 : 1000

New fall arrest system

Existing rooflights

New PV panels

CLOUDED

P01 Section 73 Issue 25.05.23

REV DESCRIPTION DATE



CLIENT	
ACS International Schools	
PROJECT	
ACS Hillingdon - Sports Hall Extension	
DRAWING TITLE	
Proposed Multi-use Hall Roof Plan	
SCALE @ A3: As indicated	

DRAWING NUMBER						REV
Project No.	Origin.	Zone	Level	Type	Drawing Number	REV
1689	IID	PL	XX	DR	A-1039	P01

DO NOT SCALE. USE FIGURED DIMENSIONS ONLY.
ALL DIMENSIONS TO BE CHECKED ON SITE



DO NOT SCALE. USE FIGURED DIMENSIONS ONLY.
ALL DIMENSIONS TO BE CHECKED ON SITE

Proposed Multi Use Hall

osed coach/ car

CLOUDED

ID Architects
Richmond Place
15 Petersham Road
Richmond
TW10 6TP

CLIENT
ACS International Schools

PROJECT

ACS Hillingdon - Sports Hall

DRAWING TITLE
Landscape - Proposed General
Arrangement

SCALE @ A3: 1:500

DRAWING NUMBER						REV
Project No.	Origin.	Zone	Level	Type	Drawing Number	
1689	IID	PL	XX	DR	A-1051	P01

Mansion

West Wing

Accessible key

Carriage sweet

Three new parking bays

Tree/shrub
salt restored

Existing coach/ car park

New slip road

13
Tree/shrub
belt restored

13

Law

Visitor ^Tpa


Scale (m) 1:500

0 5 10 15 20 25 30



KEY


- Area of existing car park to be re-surfaced to match new coach/ car park extension
- Addaset resin bound gravel Dorset Gold
- Natratox Heavy Duty resin bonded gravel - Cotswold
- Natratox Heavy Duty resin bonded gravel - Salmon
- Marshalls Tegular Priora permeable concrete block 240x160x100mm - Harvest Herringbone pattern.
- Moselden Yorkstone setts 200x100x50mm. Stretcher bond.
- Parking bay demarcation in Marshalls Tegular Priora permeable concrete block - Pennant grey
- Parking bay demarcation Marshalls silver grey cropped granite sett 100x100x100mm
- Marshalls British Standard kerb upstand 125mm in Natural to match existing
- Marshalls British Standard square channel 150mm laid flush in Natural to match existing
- Existing trees
- New tree and shrub belt
- Existing hedge
- New grassed areas
- Tactile paving slabs
- Thermoplastic line markings
- Existing spot level
- Proposed spot level

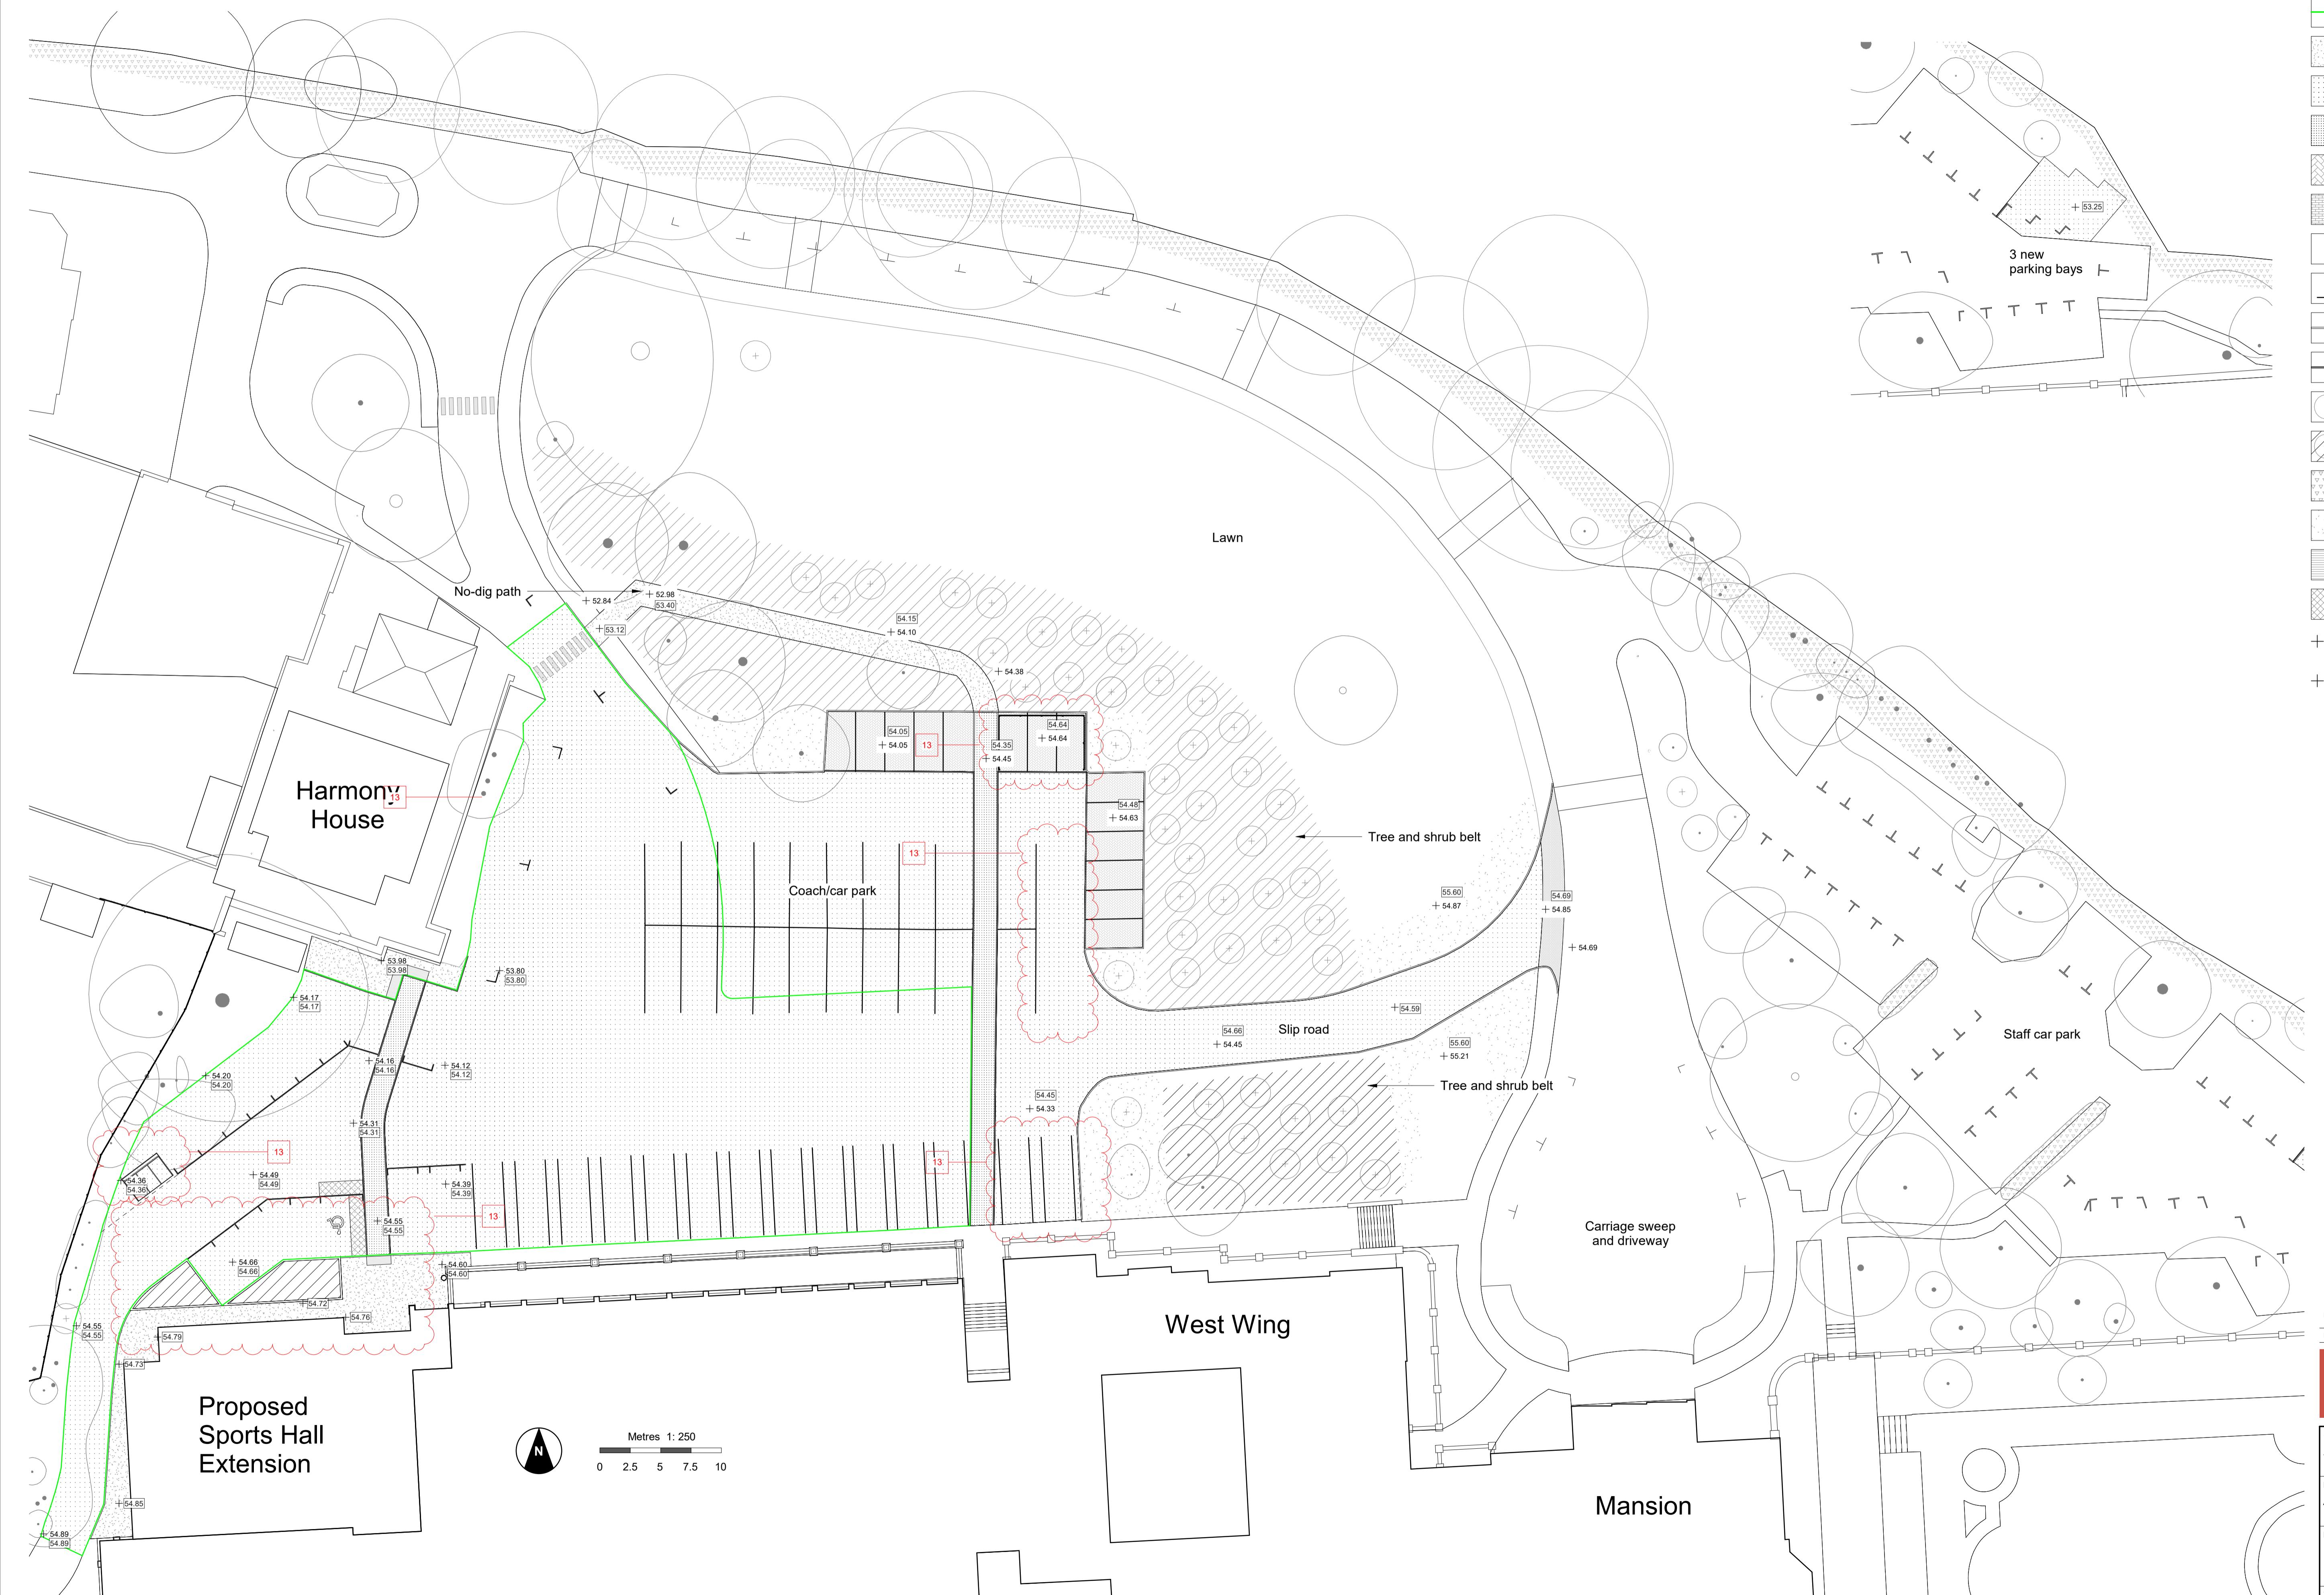


P01 Section 73 Issue 25.05.23
REV DESCRIPTION DATE
IID Architects Richmond Place 11 Richmond Road TW10 6TP info@iid.co.uk 020 3274 1000 www.iid.co.uk

CLIENT ACS International Schools
PROJECT ACS Hillingdon - Sports Hall Extension
DRAWING TITLE Landscape - Proposed Hard Materials
SCALE @ A1: As indicated

DRAWING NUMBER REV
1689 IID PL XX DR A-1052 P01


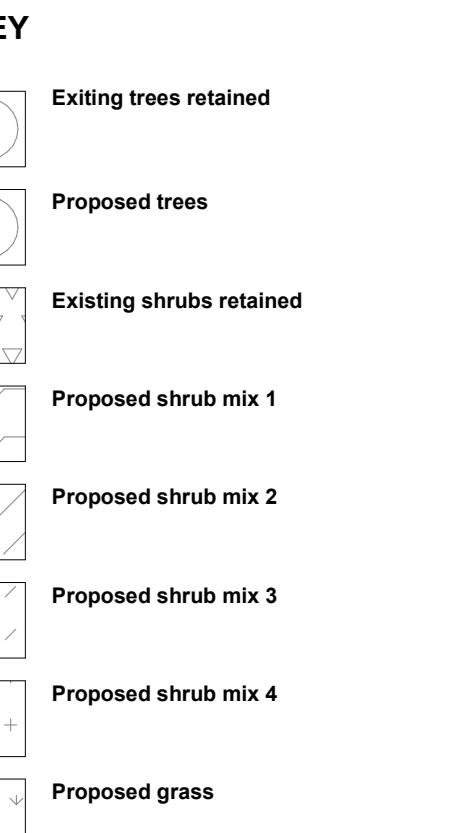


 Notes:
Refer to Novice Maher Landscape Planting Plan ref: 0028-125-PL for Tree and Shrub Site mix Part 1
Planting plan and Plan Schedule to be read together
Advice should be sought on pruning existing tree T38 in accordance with the advice given in the above drawing
adjacent (as of above drawing date, April 2016)




Scale (m) 1:200
0 2 4 6 8 10 12

DO NOT SCALE. USE FIGURED DIMENSIONS ONLY.
ALL DIMENSIONS TO BE CHECKED ON SITE.

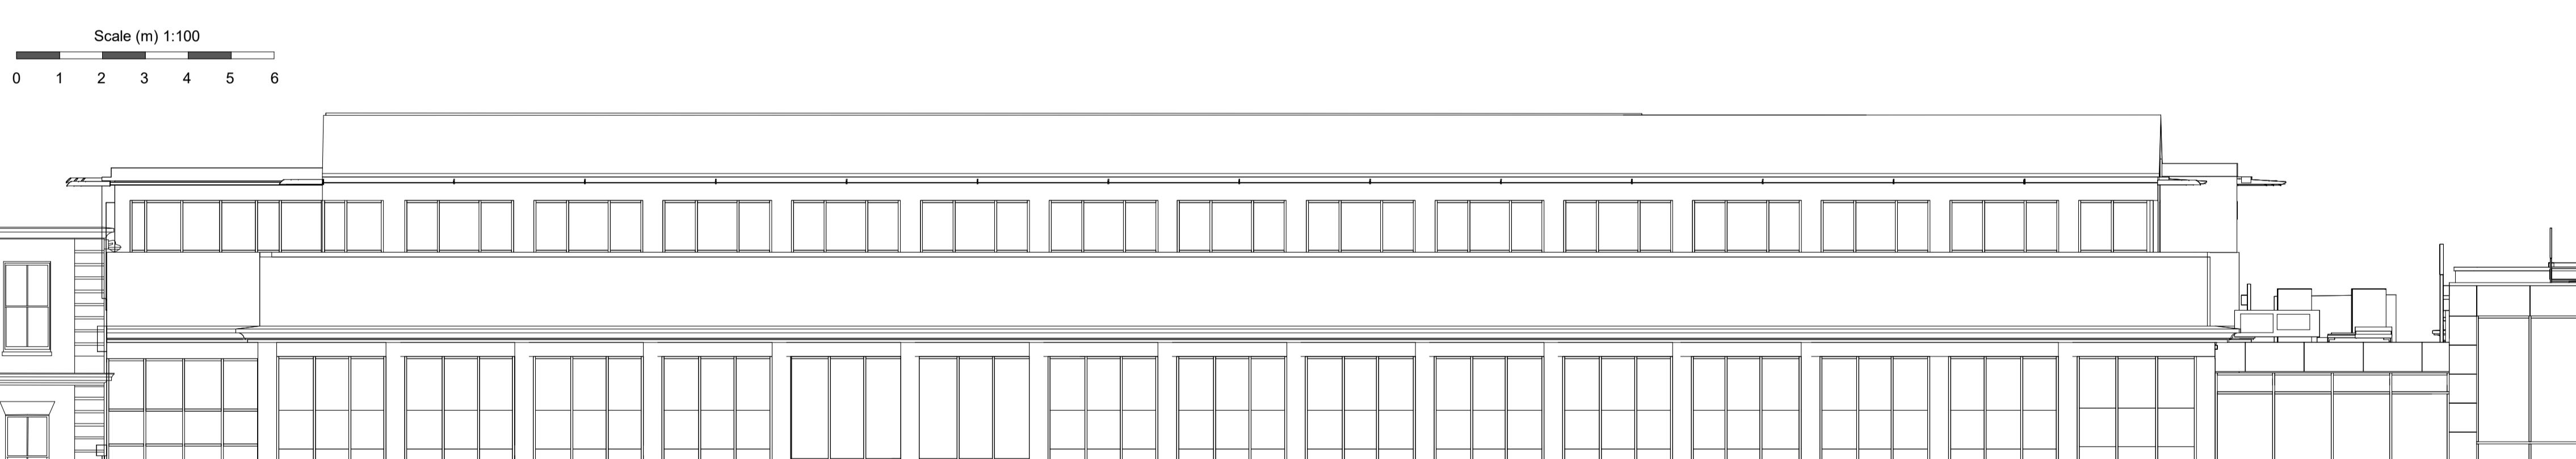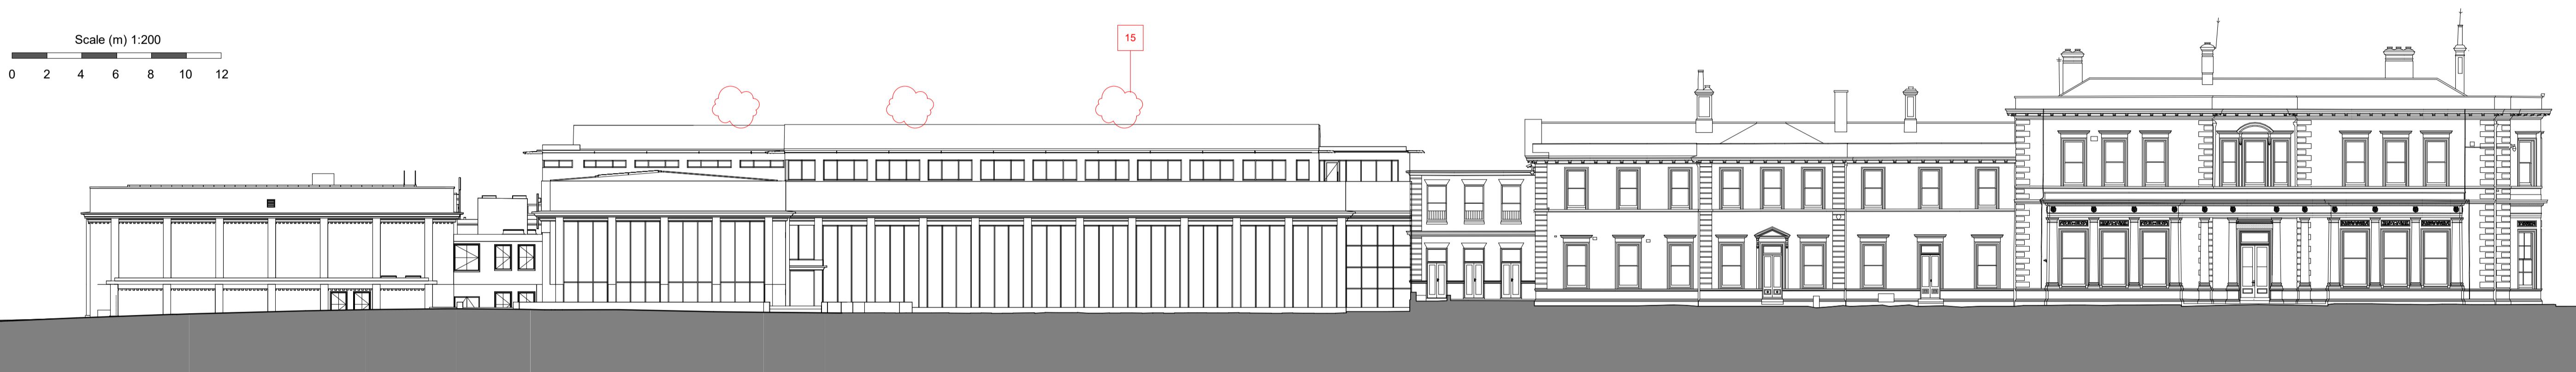

See Above Markup

CLOUDED

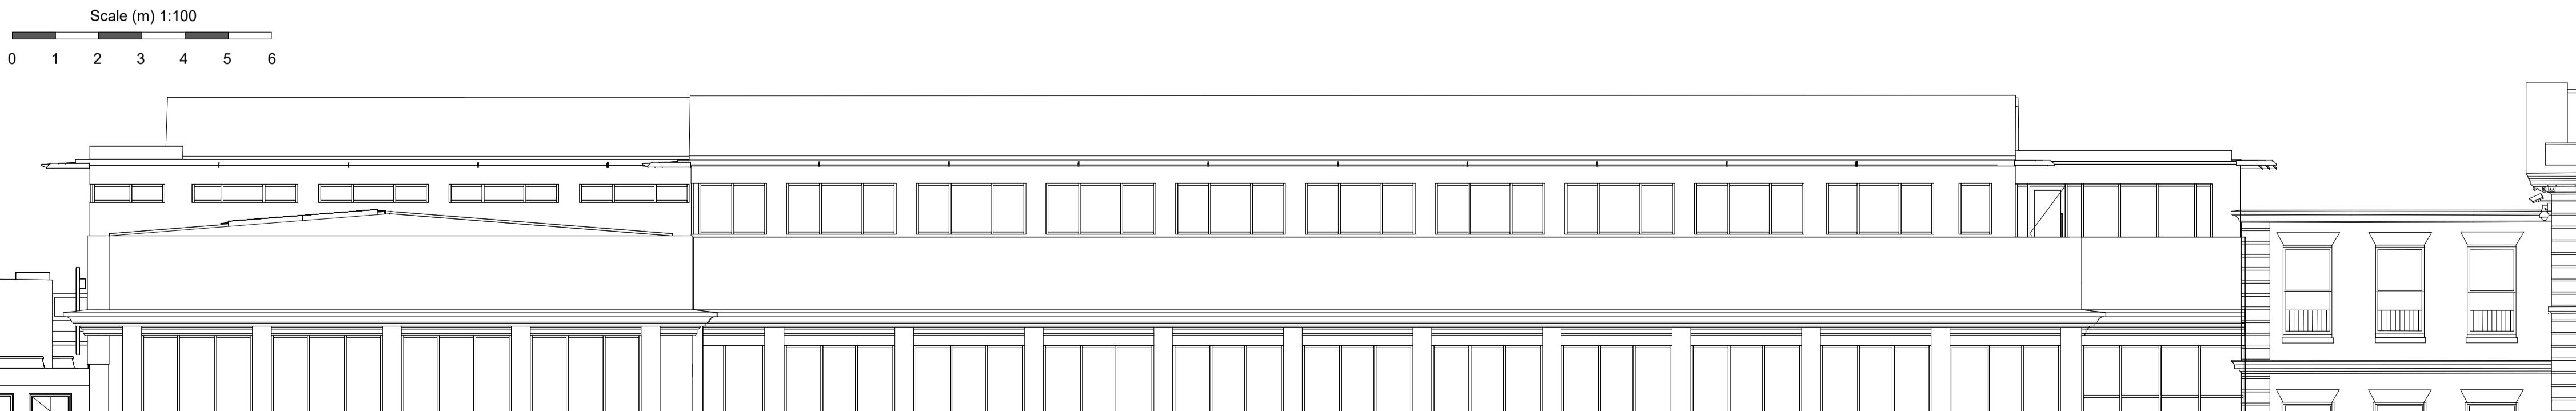

See Above Markup

P01 Section 73 Issue 25.05.23

REV DESCRIPTION DATE

IID Architects
Richmond Place
11-13 Hammersmith Road
Richmond
TW10 6TP
info@iid.co.uk
020 3274 1000
www.iid.co.uk

CLIENT
ACS International Schools

PROJECT
ACS Hillingdon - Sports Hall
Extension

DRAWING TITLE
Proposed Science Extension
North and South Elevations



SCALE @ A1: As indicated

DRAWING NUMBER
Project No. Origin Zone Level Type Drawing Number
1689 IID PL XX DR A-2050 P01

REV


DO NOT SCALE. USE FIGURED DIMENSIONS ONLY.
ALL DIMENSIONS TO BE CHECKED ON SITE

Scale (m) @ 1: 200

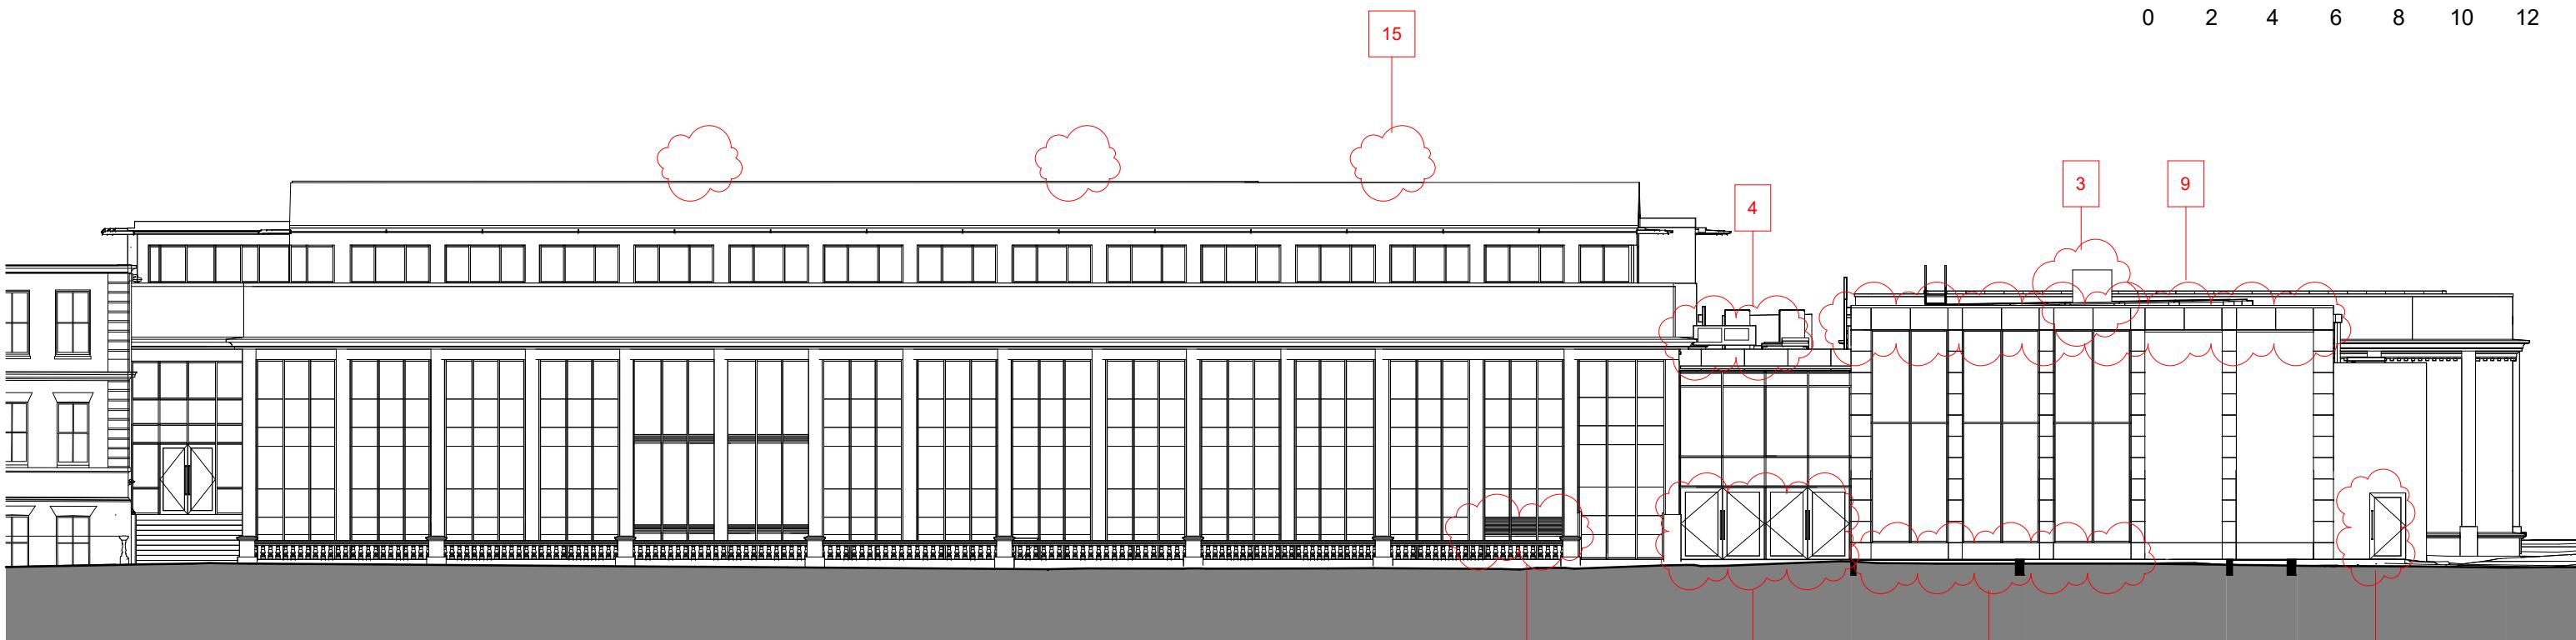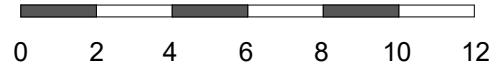

North Elevation - Proposed

1 : 200

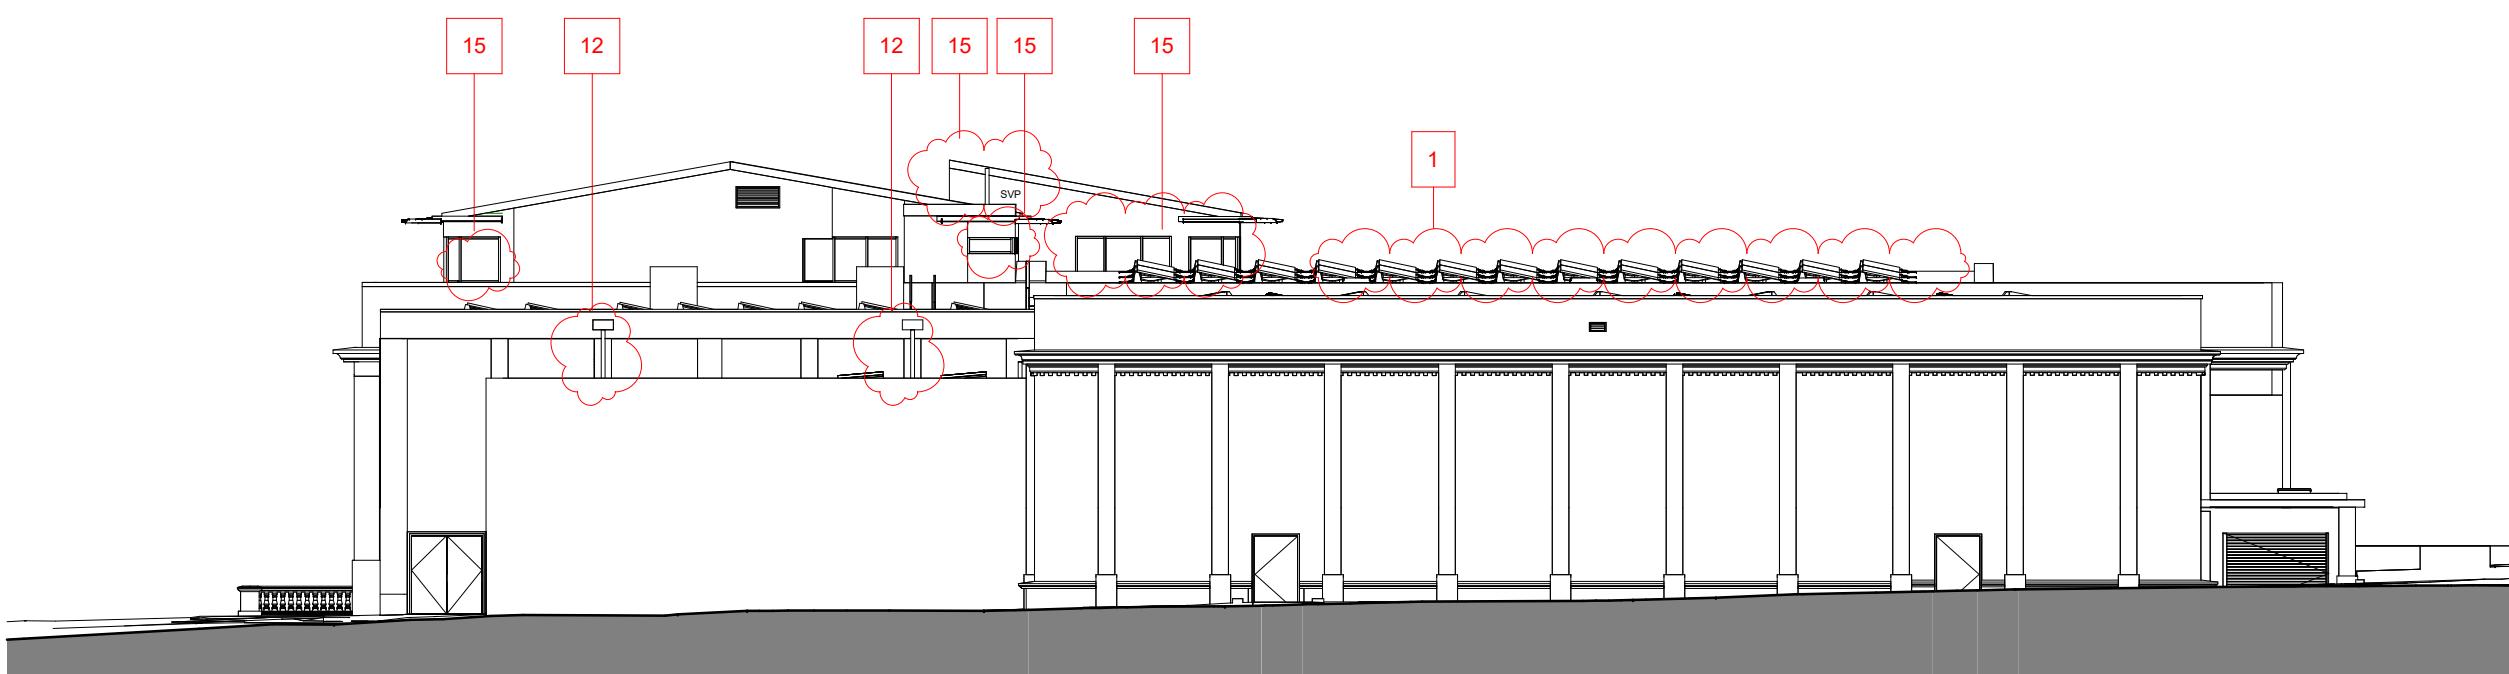

West Elevation - Proposed

1 : 200

CLOUDED

P01 Section 73 Issue 25.05.23


REV DESCRIPTION DATE



IID Architects
Richmond Place
15 Petersham Road
Richmond
TW10 6TP
info@iid.co.uk
020 3274 1000
www.iid.co.uk

CLIENT	ACS International Schools
PROJECT	
PROJECT	ACS Hillingdon - Sports Hall Extension
DRAWING TITLE	
Proposed Multi-use Hall North & West Elevations	
SCALE @ A3: 1 : 200	

DRAWING NUMBER						REV
Project No.	Origin.	Zone	Level	Type	Drawing Number	REV
1689	IID	PL	XX	DR	A-2060	P01

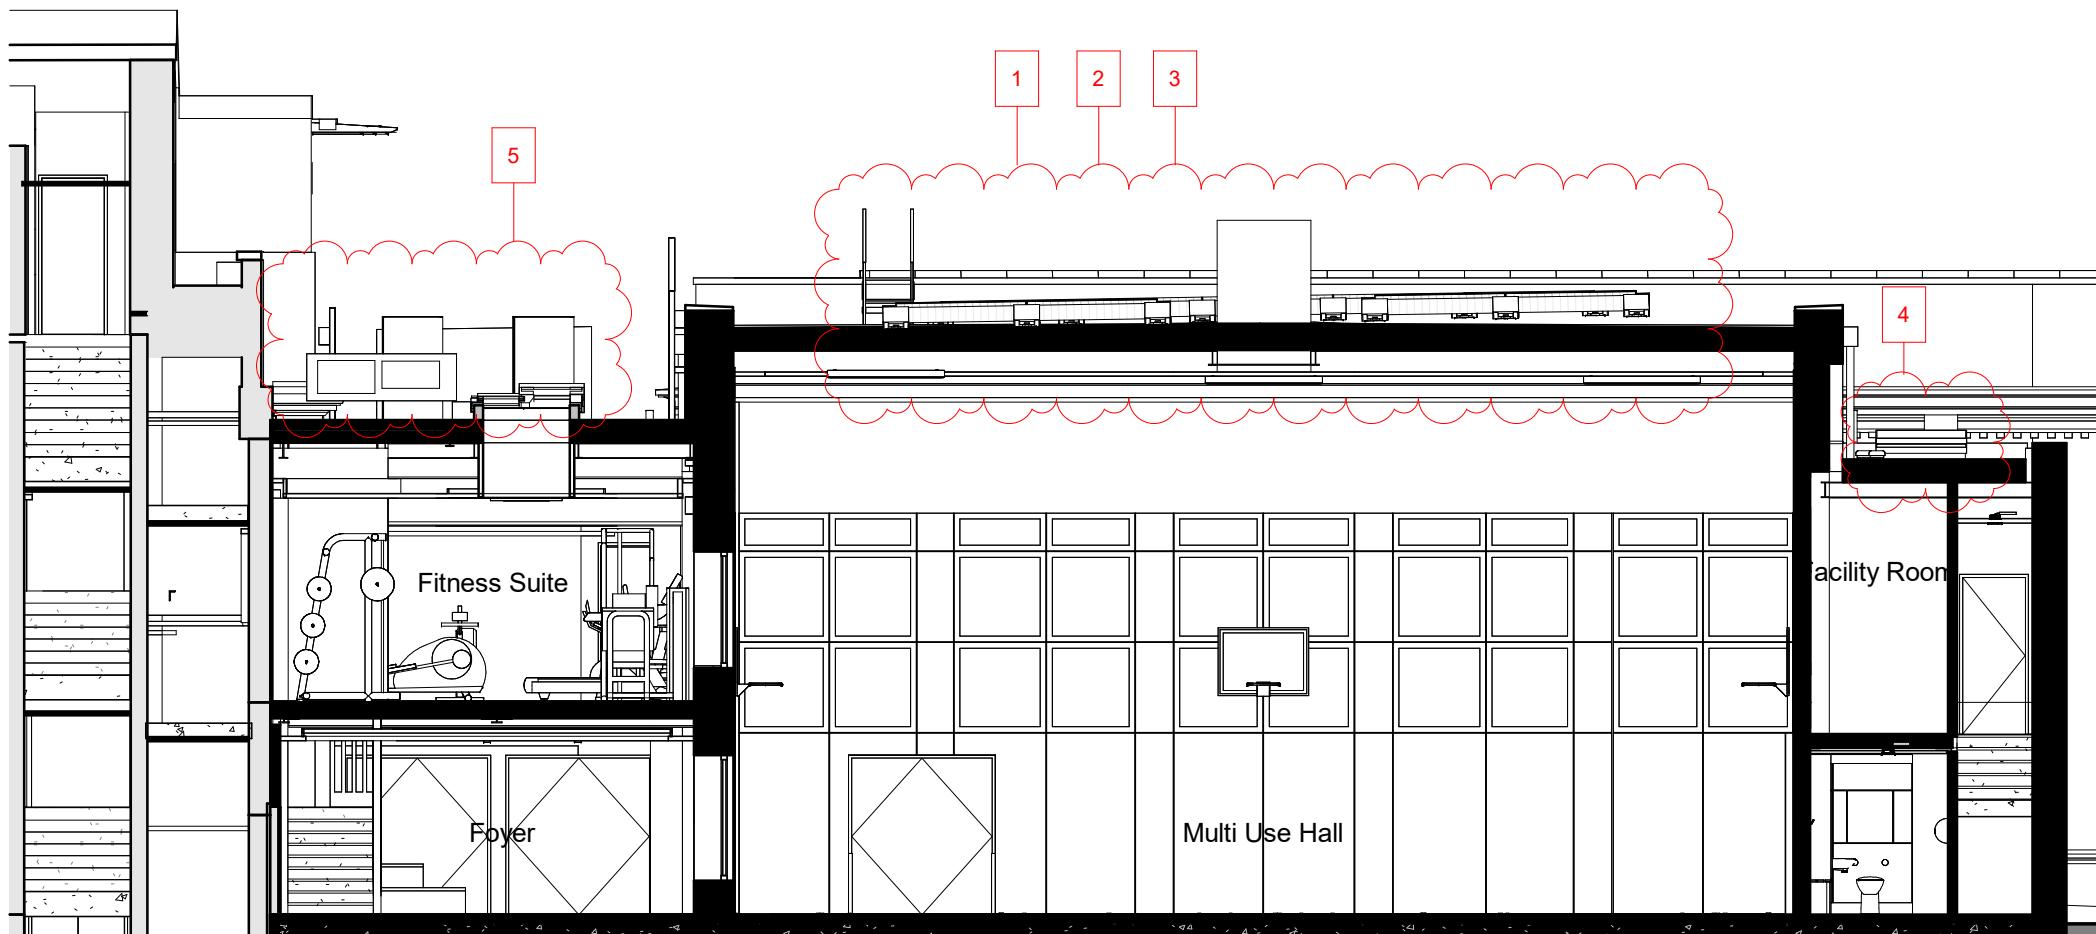


DO NOT SCALE. USE FIGURED DIMENSIONS ONLY.
ALL DIMENSIONS TO BE CHECKED ON SITE

Scale (m) @ 1: 100

0 1 2 3 4 5 6

Section A

1 : 100

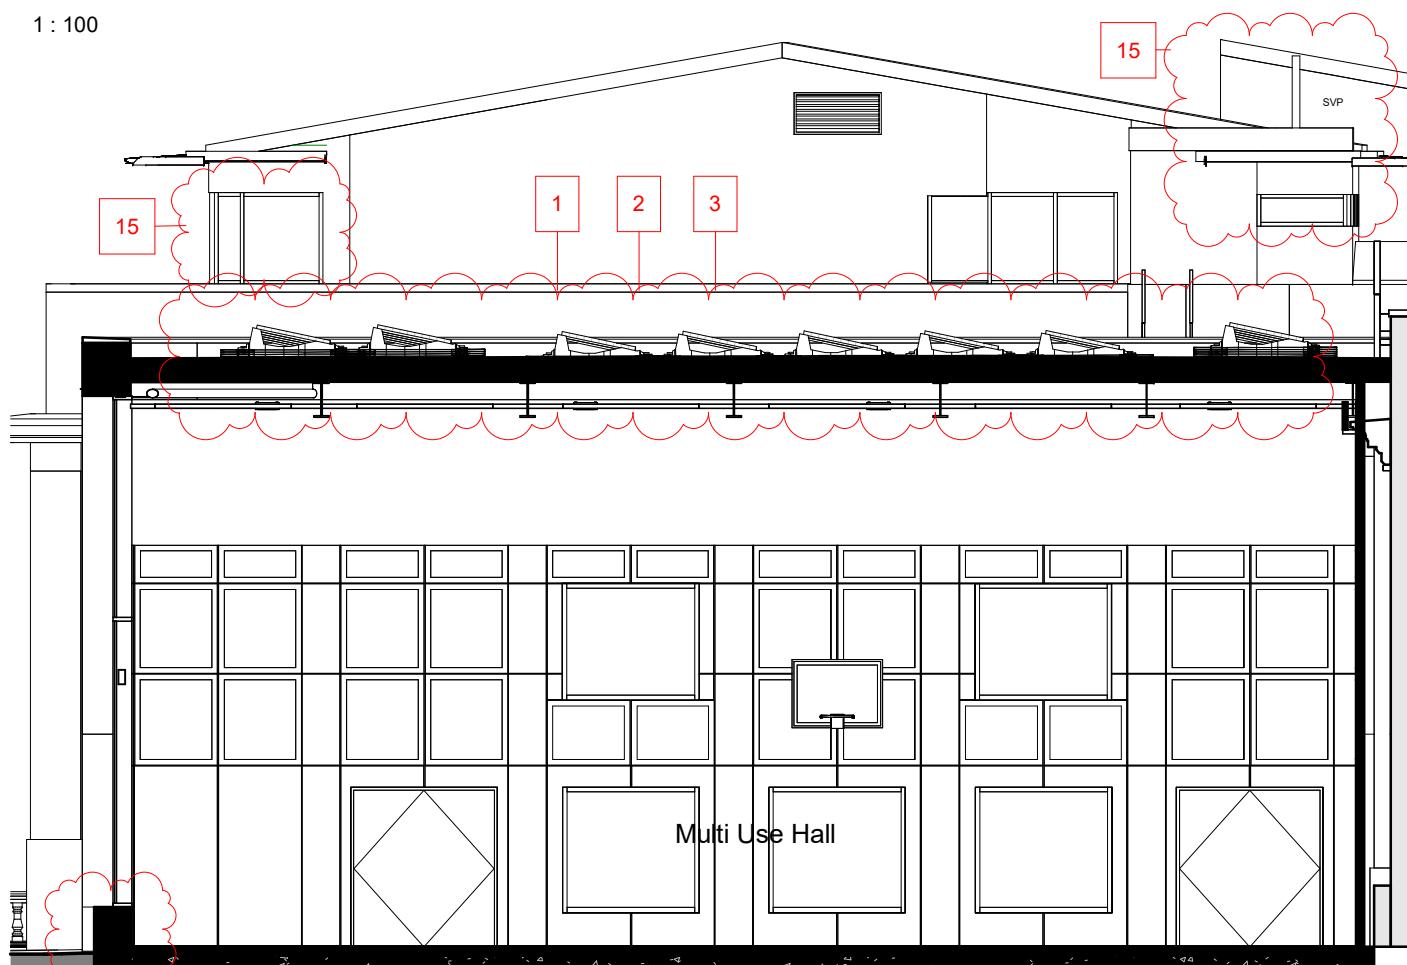

CLOUDED

P01 Section 73 Issue 25.05.23

REV DESCRIPTION DATE



IID Architects
Richmond Place
15 Petersham Road
Richmond
TW10 6TP
info@iid.co.uk
020 3274 1000
www.iid.co.uk

CLIENT
ACS International Schools

PROJECT
ACS Hillingdon - Sports Hall Extension

DRAWING TITLE
Proposed Multi-use Hall
Sections 01 and 02

SCALE @ A3: 1 : 100

DRAWING NUMBER						REV
Project No.	Origin.	Zone	Level	Type	Drawing Number	
1689	IID	PL	XX	DR	A-3060	P01

Section B

1 : 100