




SCALE BAR 1:50

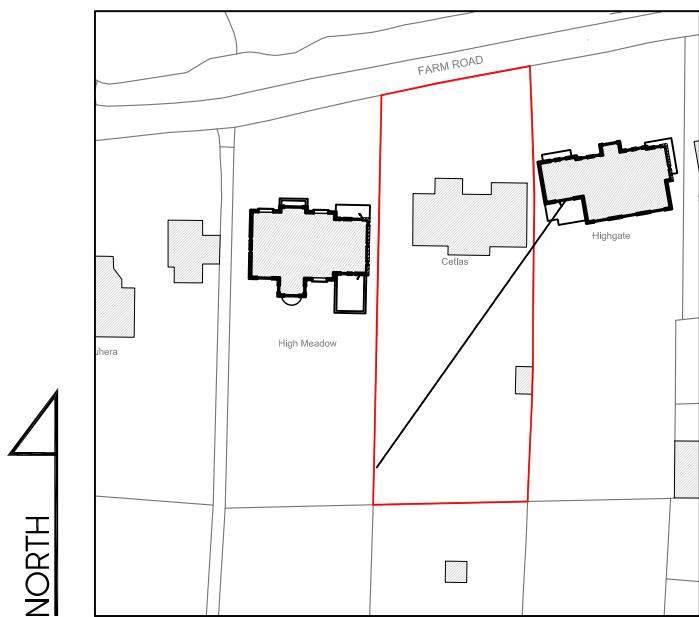


LOCATION PLAN
SCALE 1:1250

boundary

boundary

RED LINE INDICATES
PREVIOUSLY
APPROVED SCHEME
(REFERENCE:
26712/APP/2023/1726)

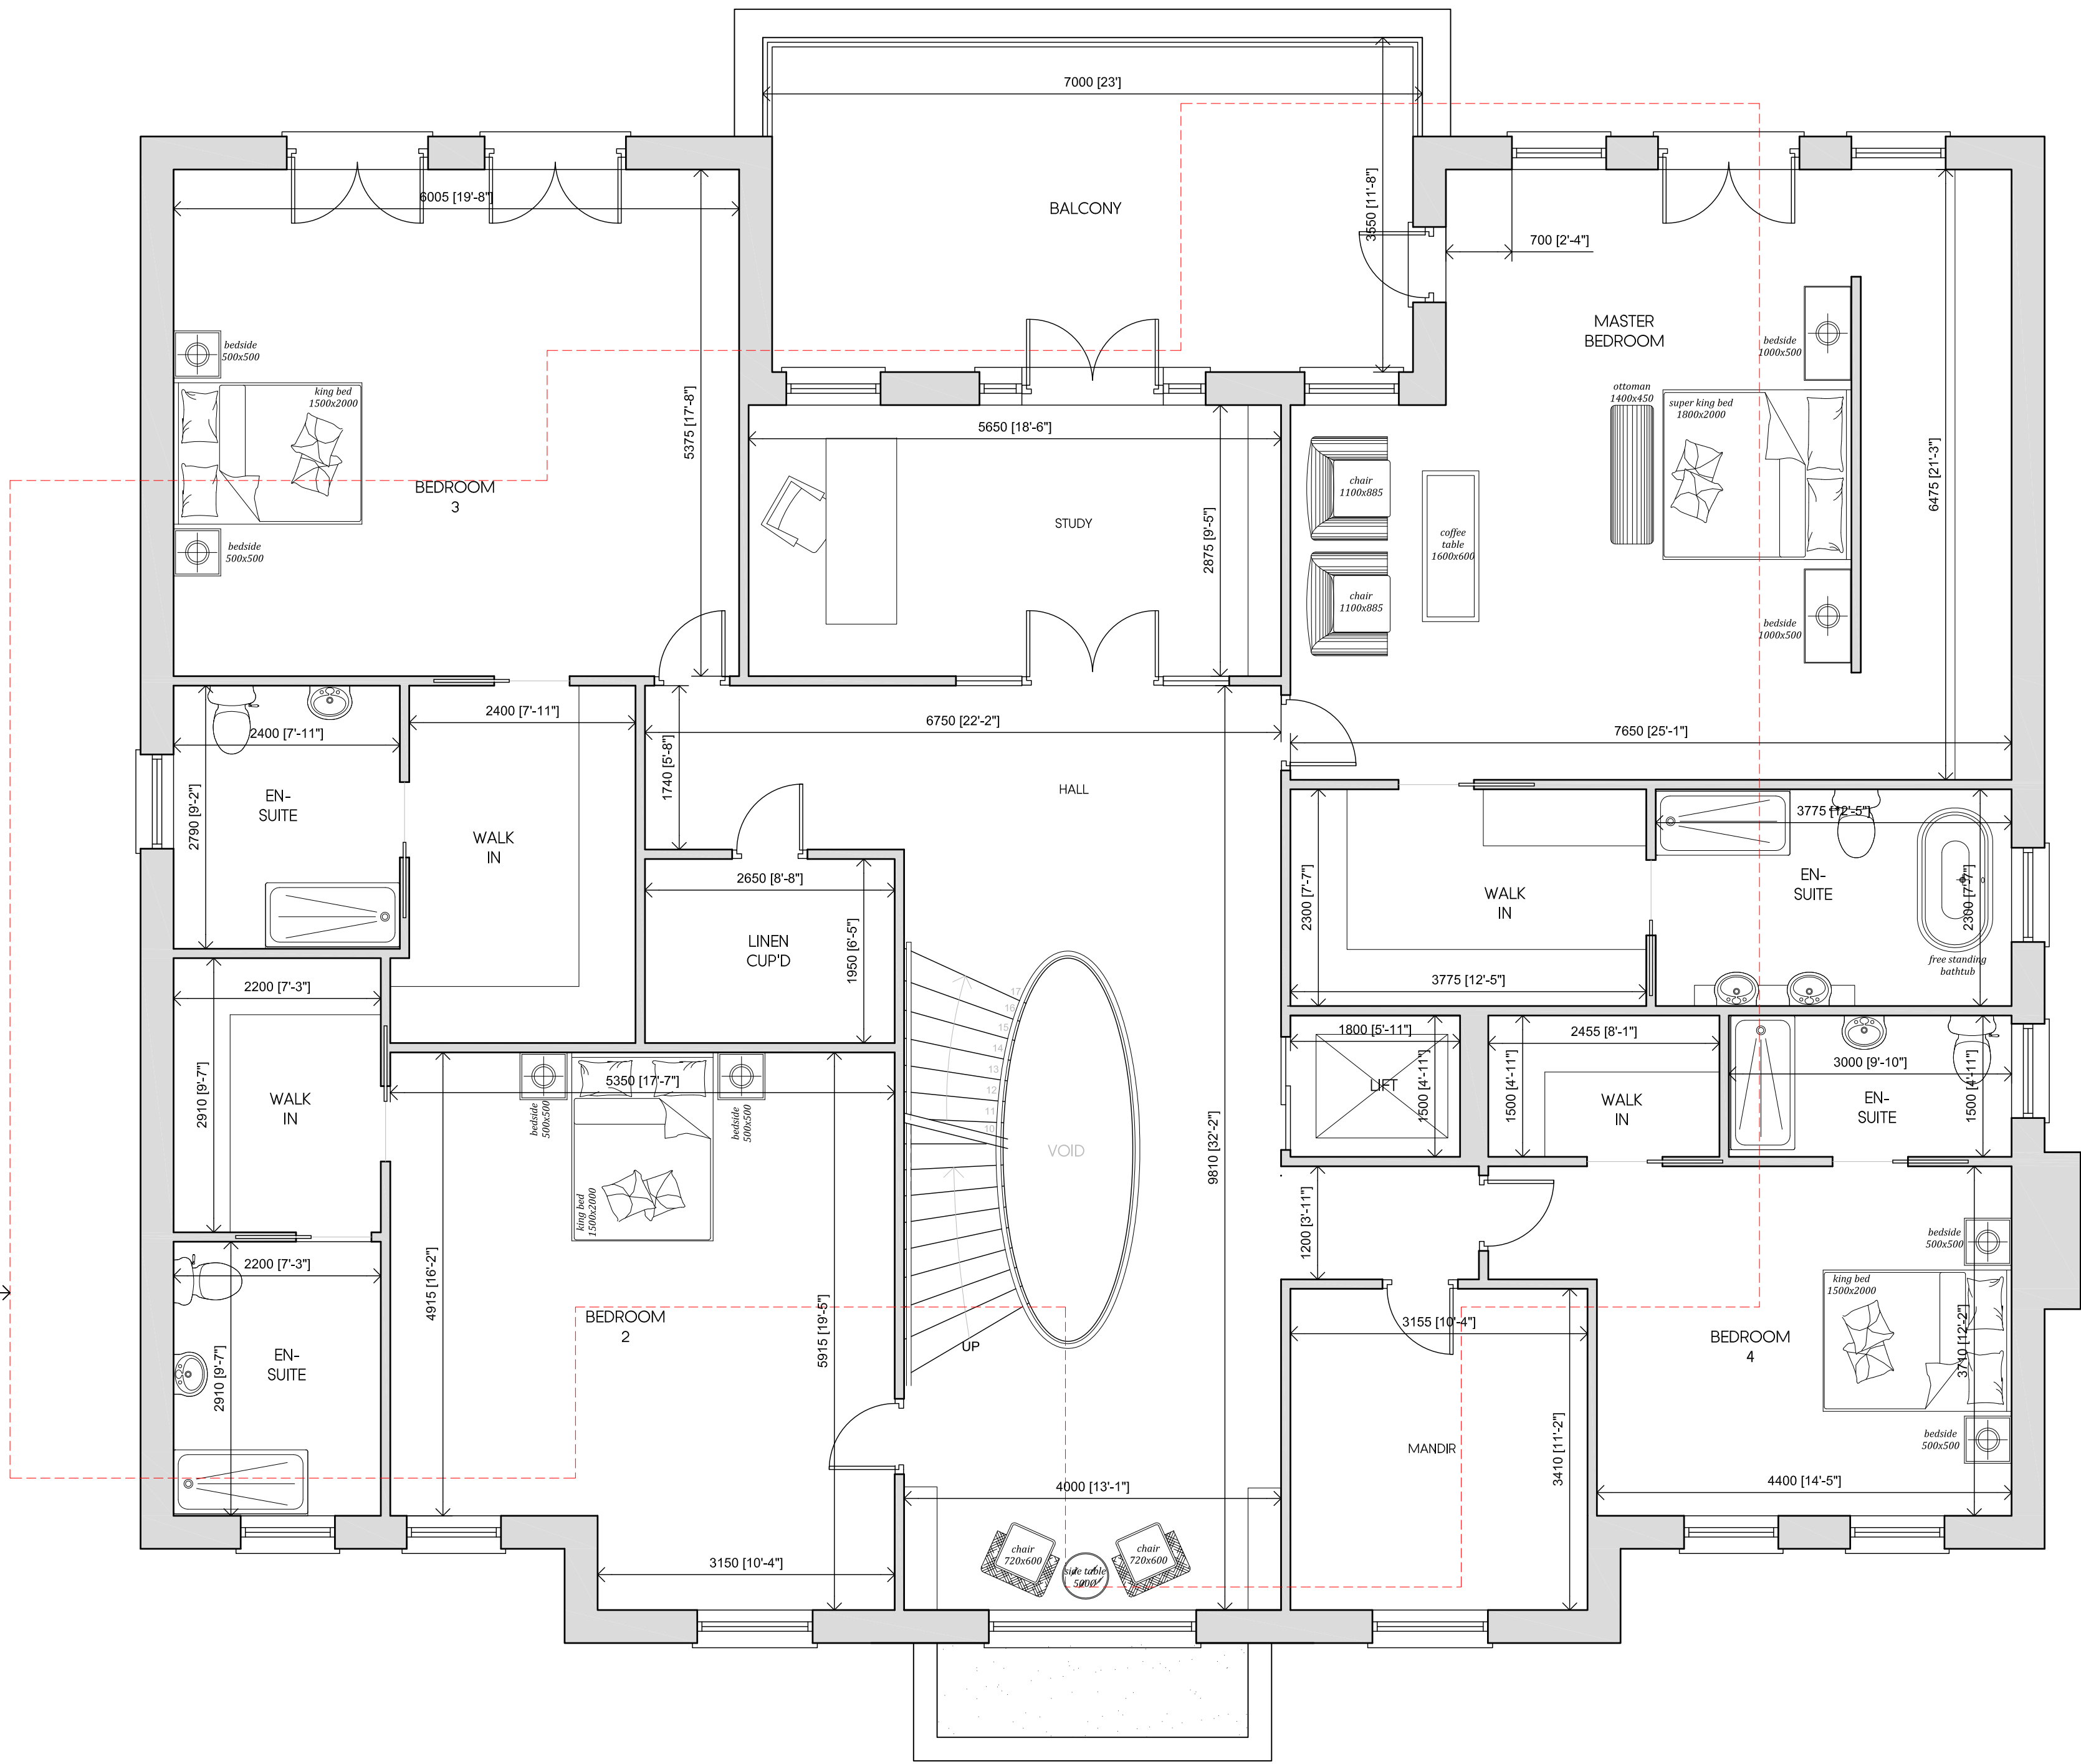

PROPOSED FIRST FLOOR PLAN

A	14.02.24	AMENDED TO SUIT COUNCIL COMMENTS	BR
Rev	Date	Description	Init.

Client

MR & MRS BANAİK

Project Title
PROPOSED REPLACEMENT DWELLING

CETLAS, FARM ROAD, NORTHWOOD, HA6 2NZ

Drawing Title

PROPOSED FIRST FLOOR PLAN

Cad File	Sheet Size	Scale
P005	A1	1:50
Drawn by	Drawing Date	Approved by
BR	SEP 2023	NJ
Project No.	Drawing No.	Revision
1923	P302	A

Juttla Architects

2-4 High Street Ruislip
Middlesex HA4 7AR

1 01923 840077 1 01923 840078
info@juttla-architects.com
juttla-architects.com

This drawing is property of Juttla Architects Ltd © and must not be copied or otherwise reproduced. All dimensions must be checked on site before commencing work. No dimensions to be scaled from this drawing. This drawing was produced using AutoCad 2016.

PLANNING ISSUE