



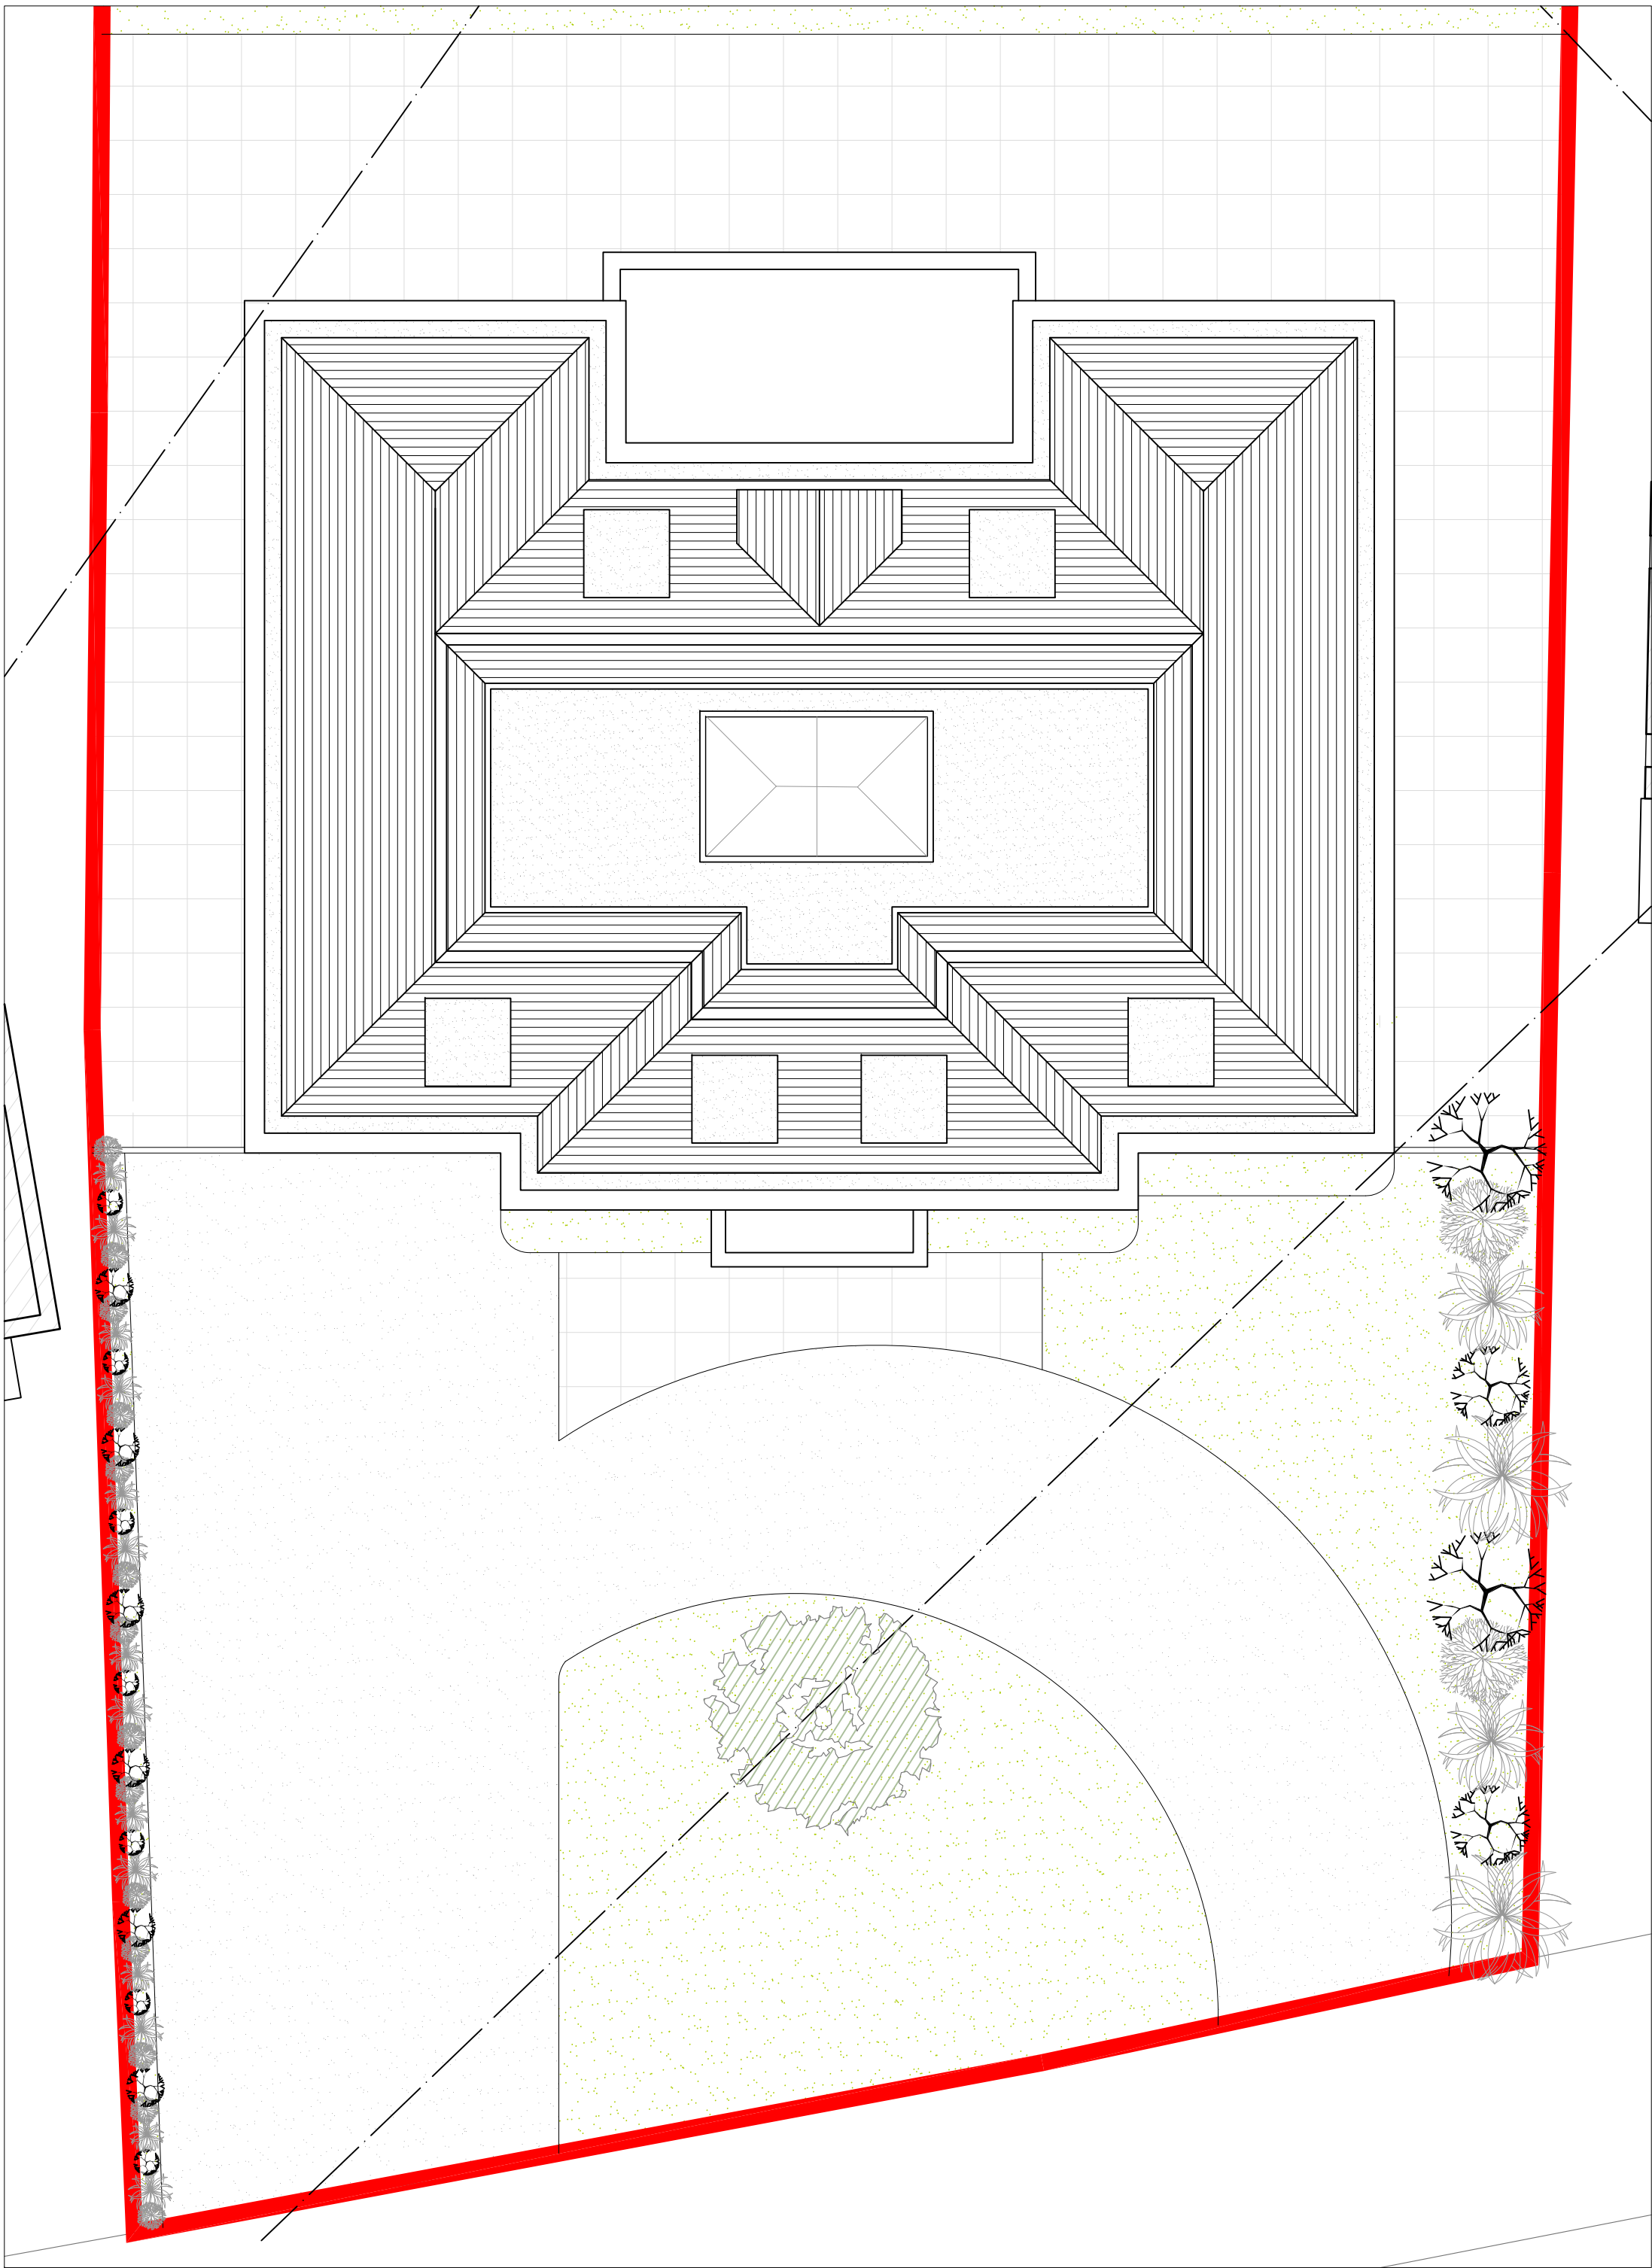

AS BUILT BLOCK PLAN
SCALE 1:100

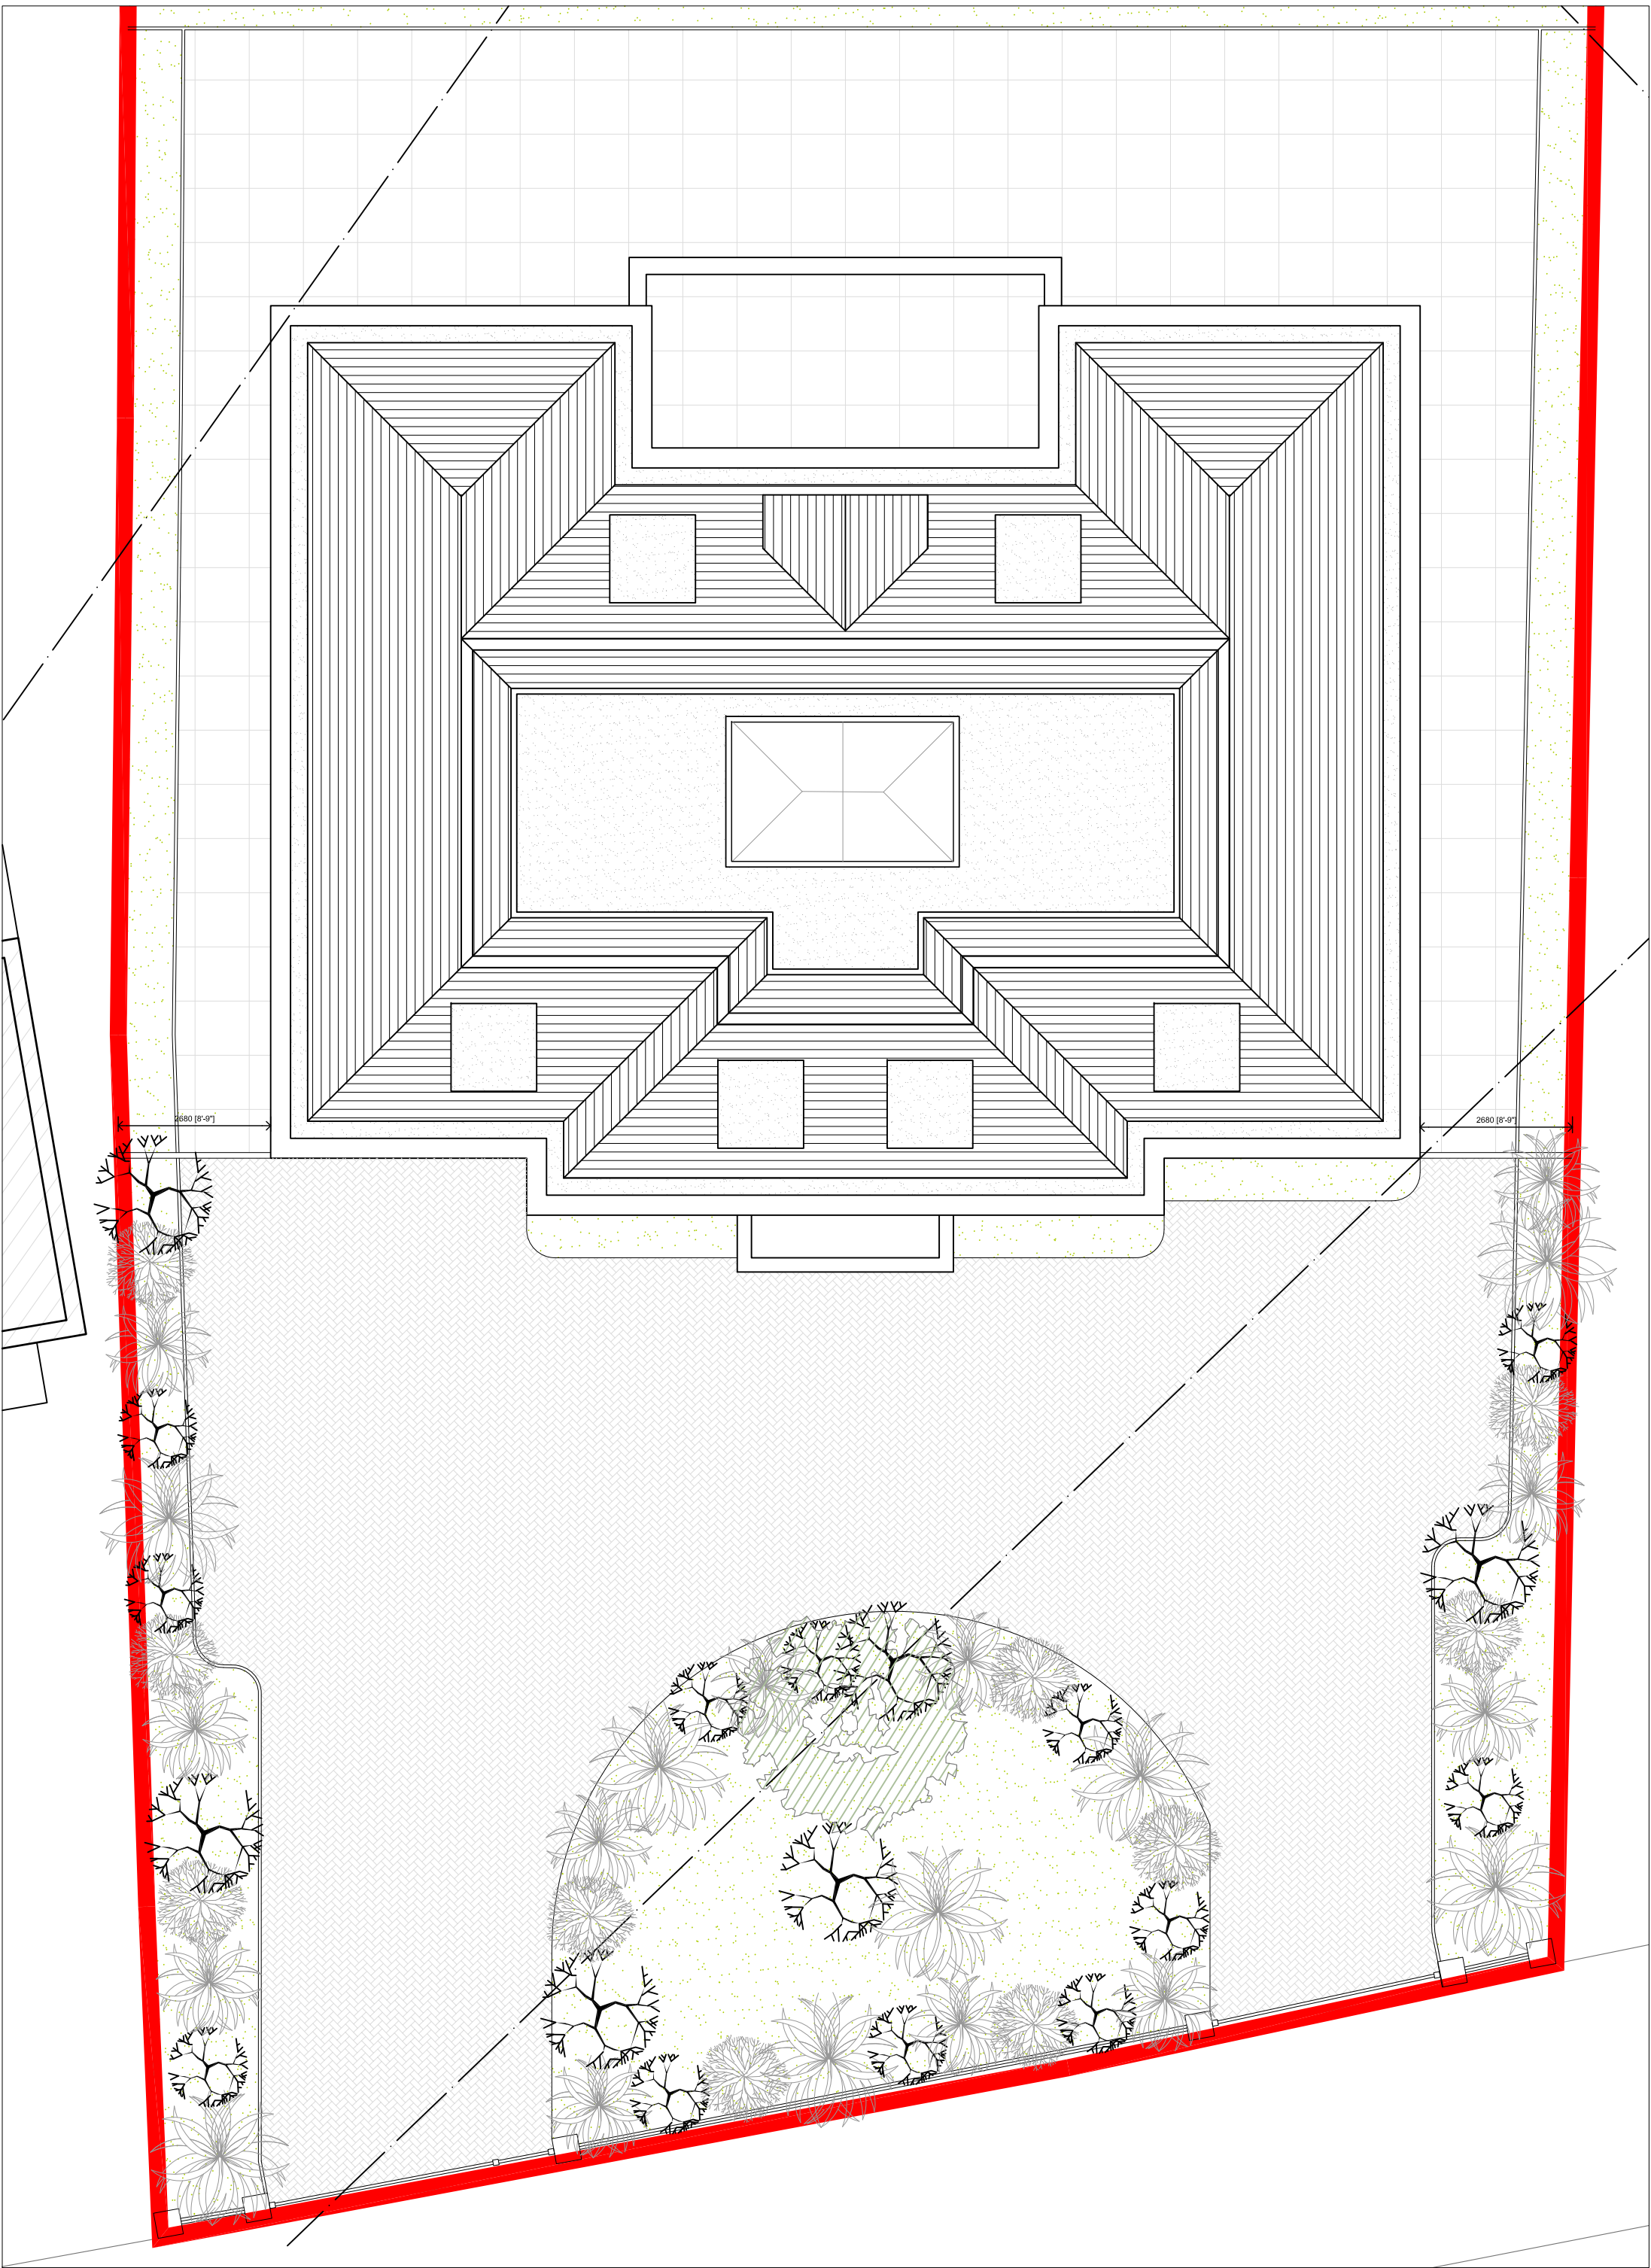



PROPOSED BLOCK PLAN
SCALE 1:100




AS BUILT FRONT ELEVATION
SCALE 1:100



PROPOSED FRONT ELEVATION
SCALE 1:100

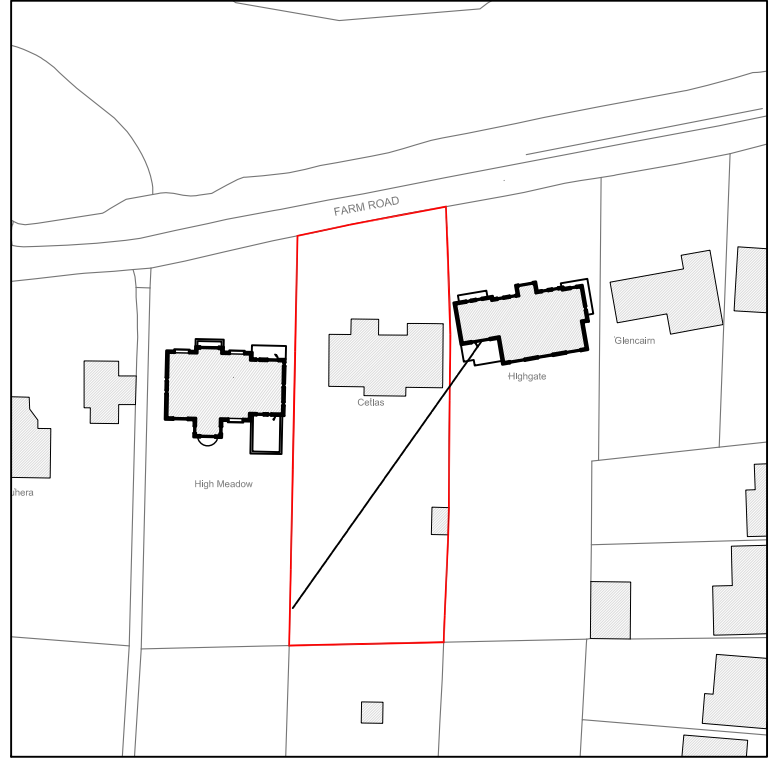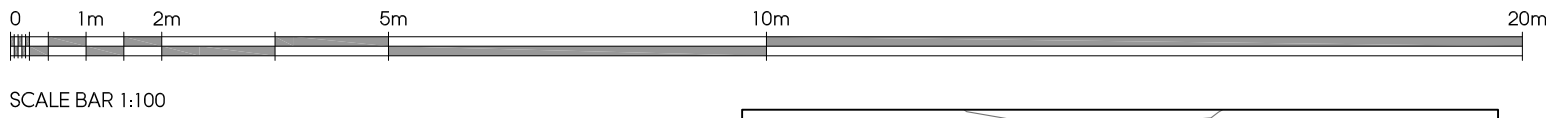

LOCATION PLAN
SCALE 1:1250

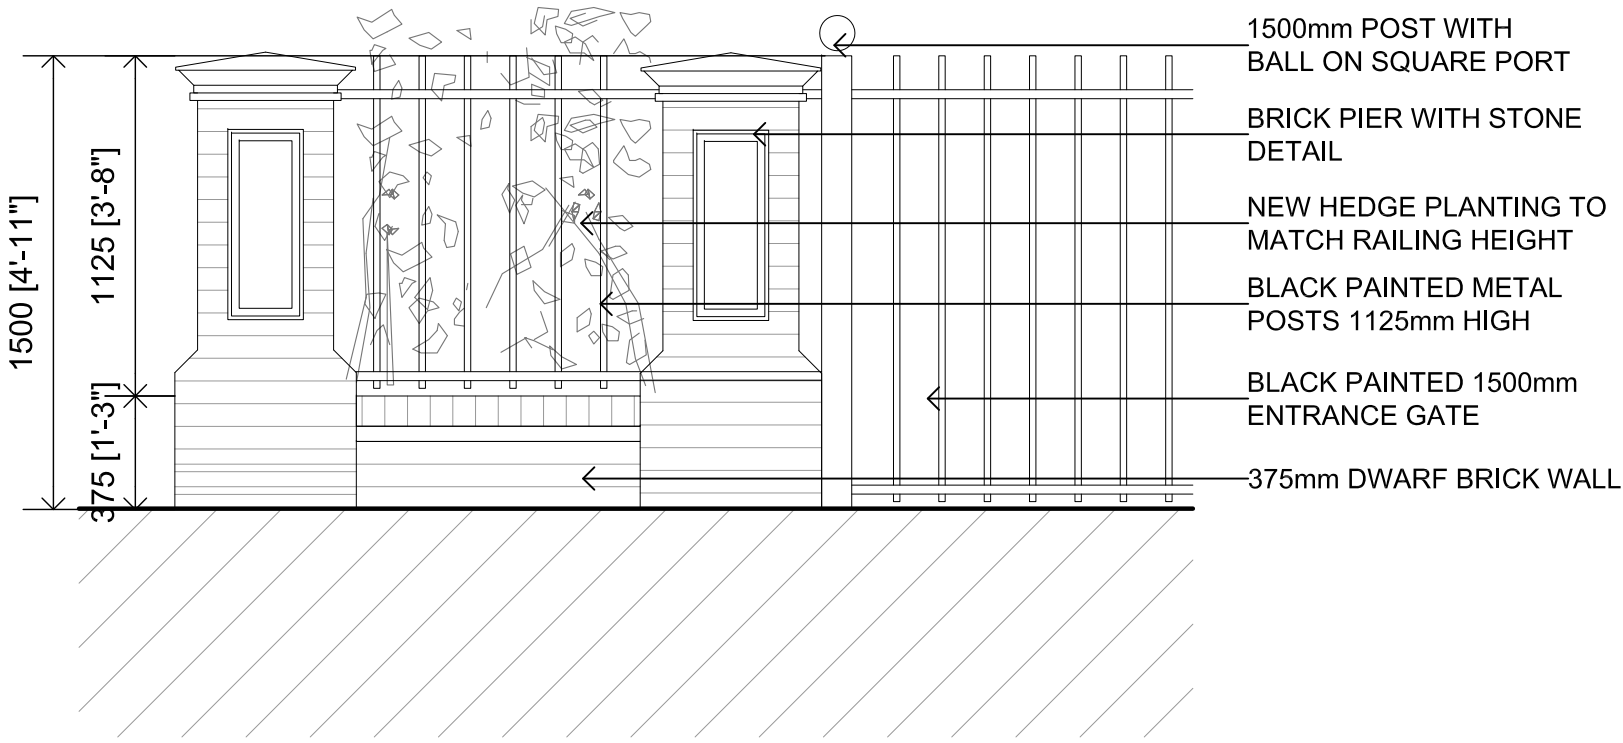

PROPOSED FRONT BOUNDARY WALL
SCALE 1:20

Rev	Date	Description	Init.
A	01.09.26	AMENDED FOR SUBMISSION	KP

Client

MR & MRS BANAUK

Project Title

PROPOSED FRONT BOUNDARY WALL

CETLAS, FARM ROAD, NORTHWOOD, HA6 2NZ

Drawing Title

AS BUILT AND PROPOSED PLANS AND ELEVATIONS

Cad File	Sheet Size	Scale
B001	A1	1:100
Drawn by	Drawing Date	Approved by
KP	SEP 2026	BR
Project No.	Drawing No.	Revision
1923	P110	A



2-4 High Street Ruslip
Middlesex HA4 7AP
101923 840077 101923 840078
info@jutla-architects.com
jutla-architects.com

This drawing is property of Jutla Architects Ltd © and must not be copied or otherwise reproduced. All dimensions must be checked on site before commencing work. No dimensions to be scaled from this drawing. This drawing was produced using AutoCad 2016.

BUILDING CONTROL ISSUE