
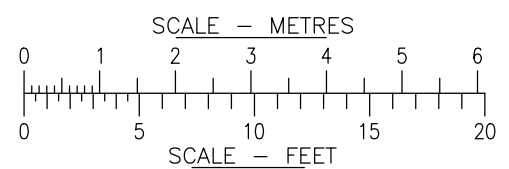


DO NOT SCALE FROM THIS DRAWING. ALL DIMENSIONS TO BE CHECKED ON SITE. ANY DISCREPANCIES MUST BE REPORTED TO THE ARCHITECT FOR VERIFICATION PRIOR TO COMMENCEMENT OF THE EFFECTED WORKS. IF IN DOUBT ASK. THIS DRAWING IS COPYRIGHT.

Rev No	Date	Revision note
P1	16.09.2020	Preliminary issue.
P2	02.12.2020	Revised as per on-site dimensions.
P3	14.12.2020	Bay internal windowindicated, boundary on No33 revised.
P4	17.12.2020	Existing house garage line shown

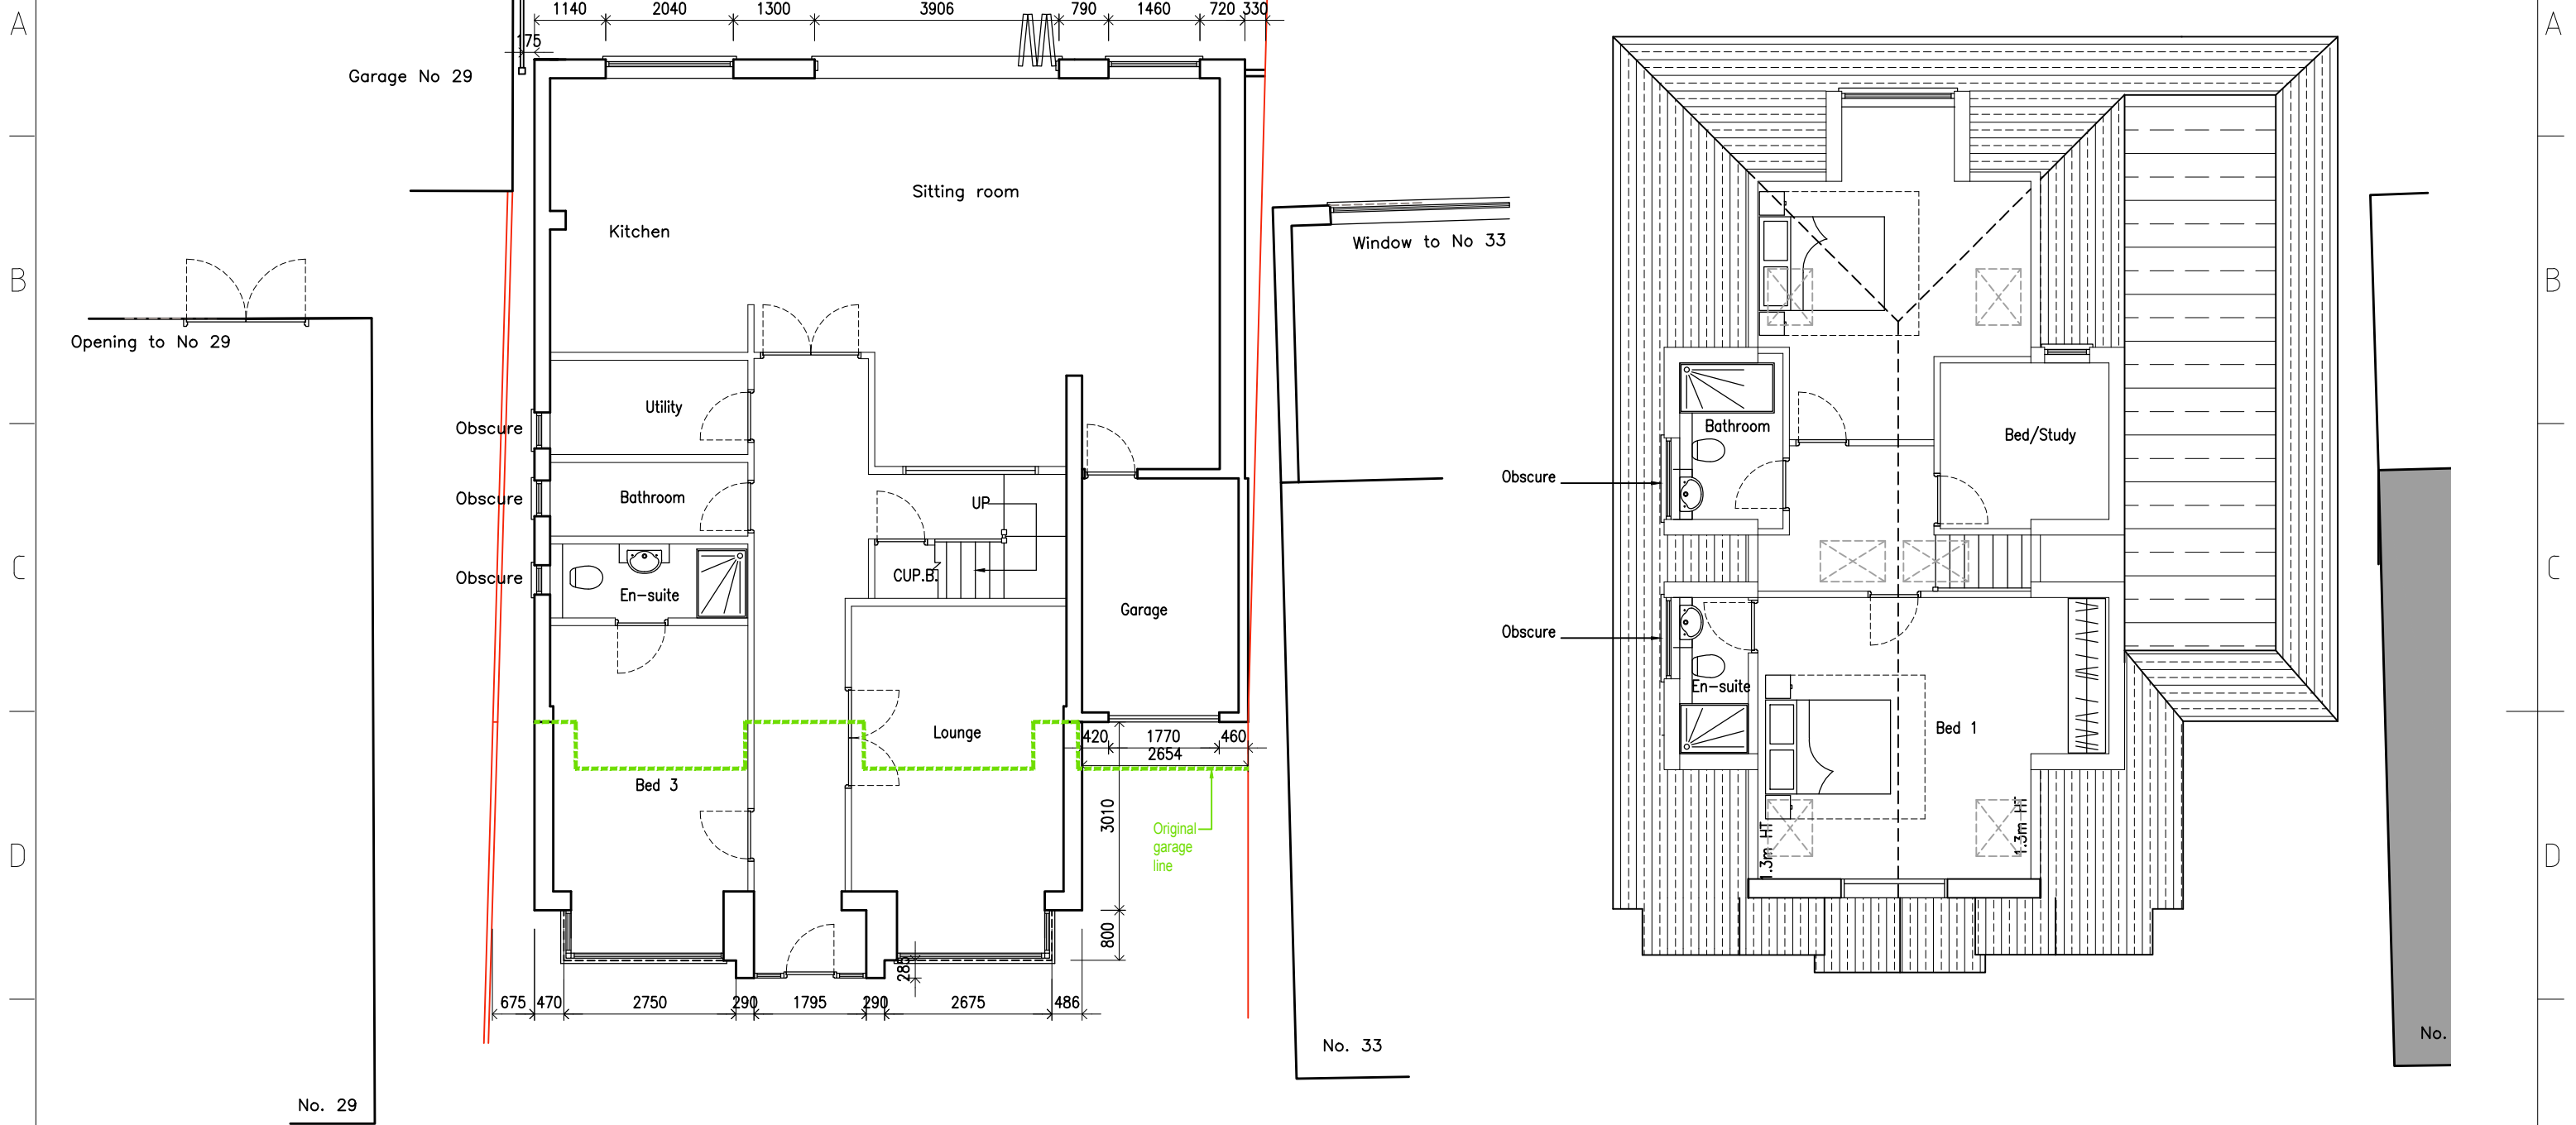

CEDAR HOUSE
VINE LANE HILLINGDON
UXBRIDGE UB10 0NF

TEL: (01895) 272 446
FAX: (01895) 272 483
EMAIL: admin@jpbarchitects.co.uk

JOB TITLE		
31 Halford Road, Ickenham UB10 8PZ		
DRG TITLE		
As- built Plans		
SCALE	DATE	
1:100 @ A3	Sept '20	
JOB NO.	DRG NO.	REV
10970	171	P4