
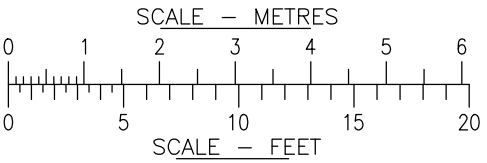
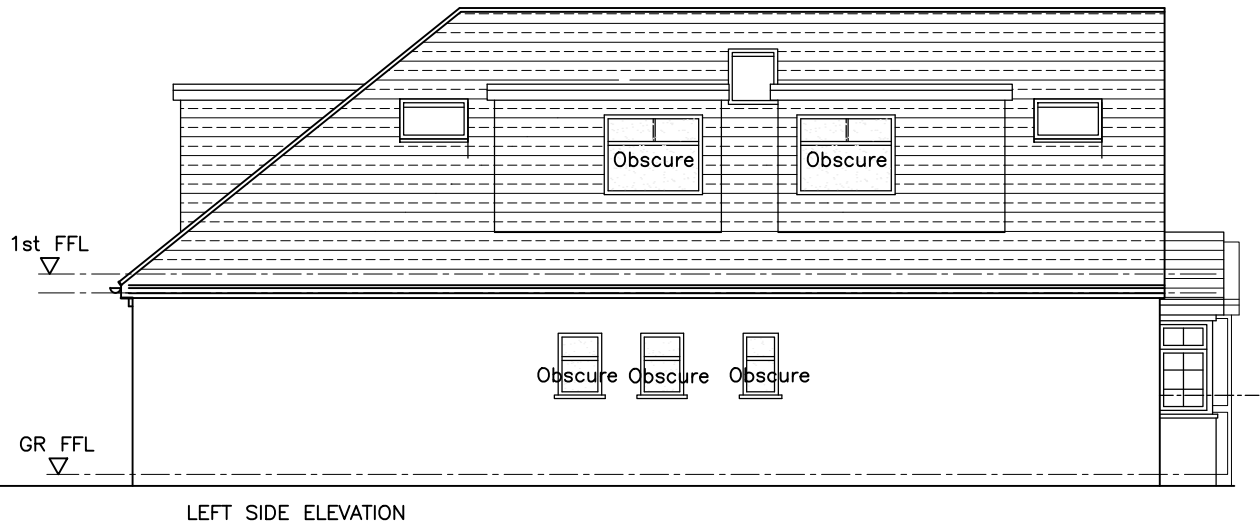


DO NOT SCALE FROM THIS DRAWING. ALL DIMENSIONS TO BE CHECKED ON SITE. ANY DISCREPANCIES MUST BE REPORTED TO THE ARCHITECT FOR VERIFICATION PRIOR TO COMMENCEMENT OF THE EFFECTED WORKS. IF IN DOUBT ASK. THIS DRAWING IS COPYRIGHT.

Rev No	Date	Revision note
P1	16.09.2020	Preliminary issue.
P2	17.09.2020	Amended to comments received
P3	02.12.2020	Revised as per on-site dimensions.

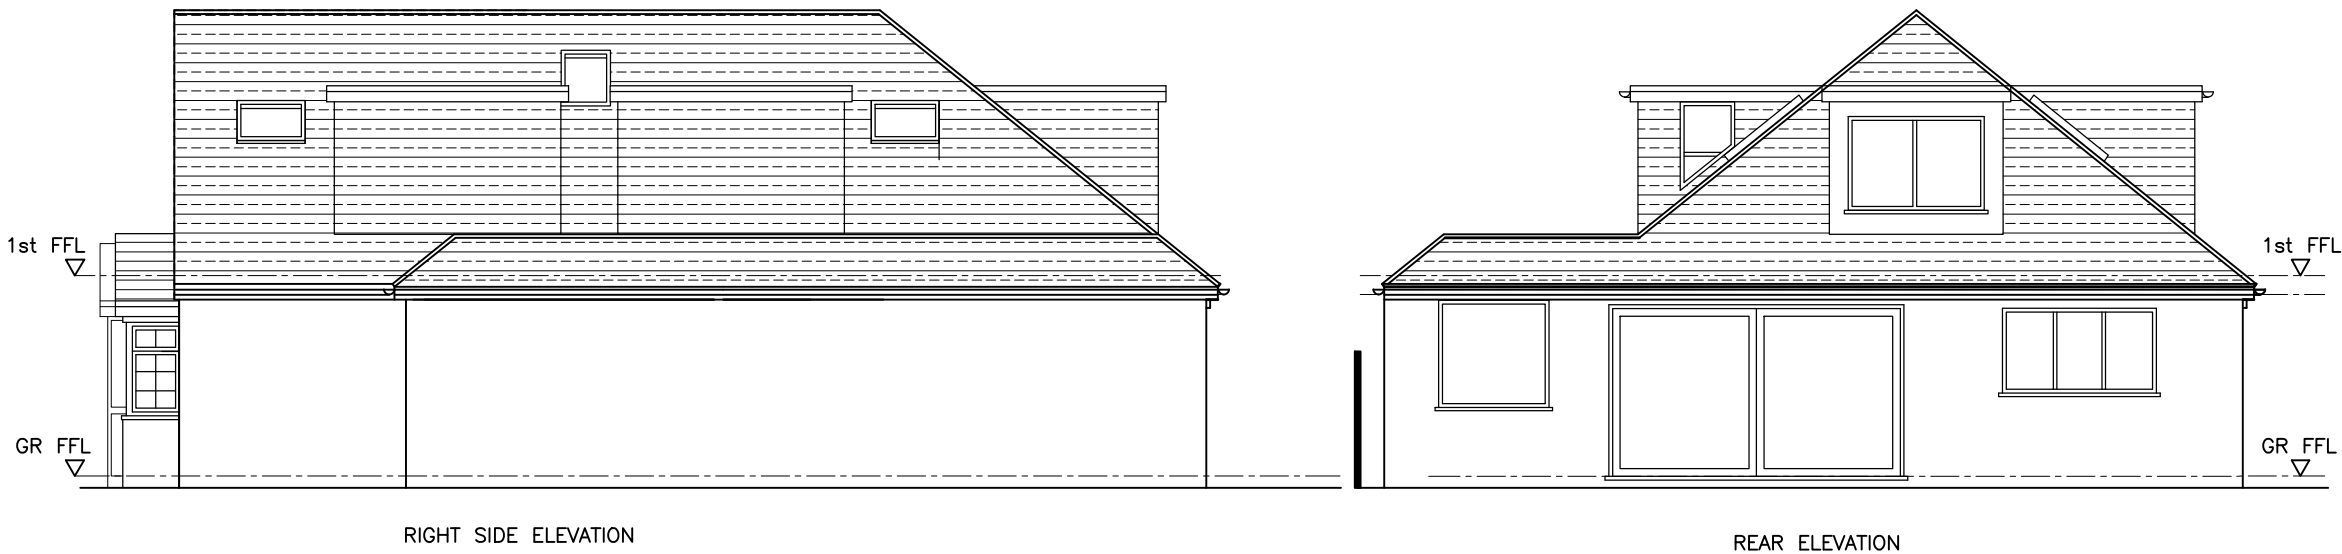

jpb
architects

CEDAR HOUSE
VINE LANE HILLINGDON
UXBRIDGE UB10 0NF

TEL : (01895) 272 446
FAX : (01895) 272 483
EMAIL : admin@jpbarchitects.co.uk

JOB TITLE
31 Halford Road,
Ickenham
UB10 8PZ

DRG TITLE
As-built Elevations

SCALE	DATE
1:100 @ A3	Sept '20
JOB NO.	DRG NO.
10970	172
REV	P3