






ELEVATION A
Scale 1:100

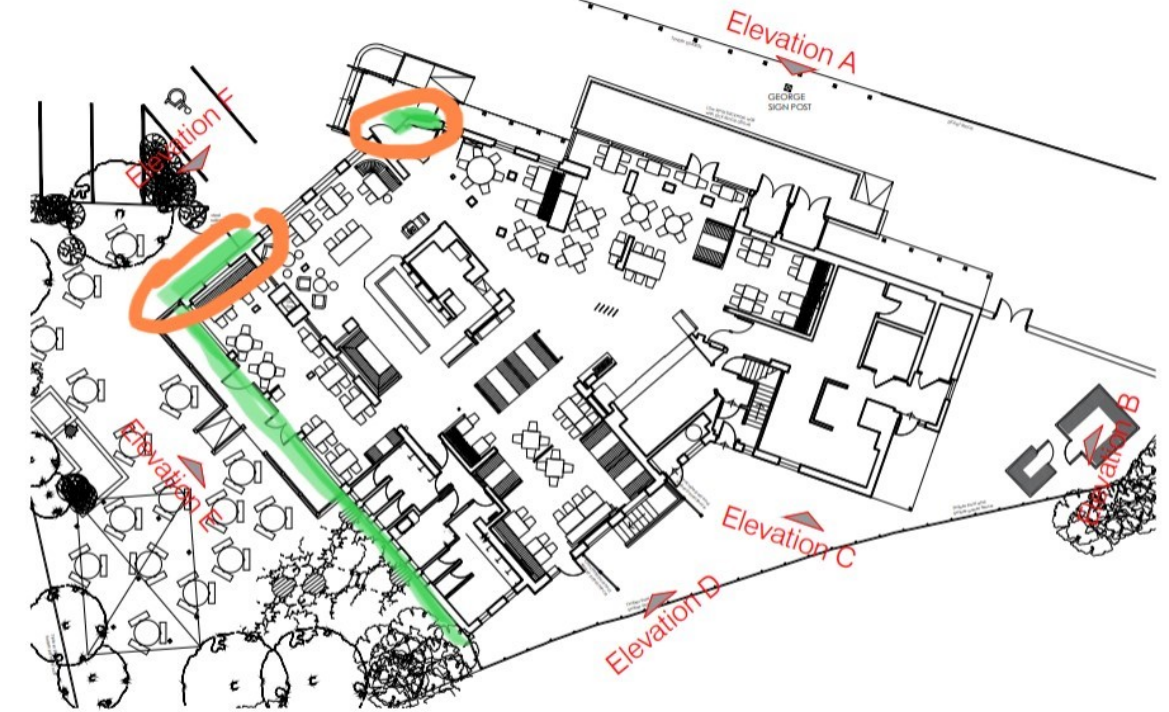

LOCATION PLAN
Scale 1:200

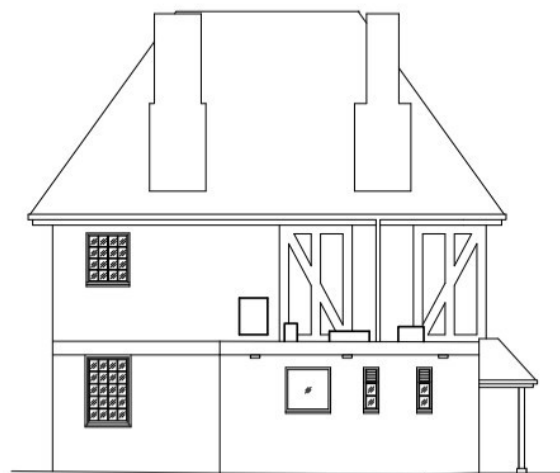

ELEVATION B
Scale 1:100

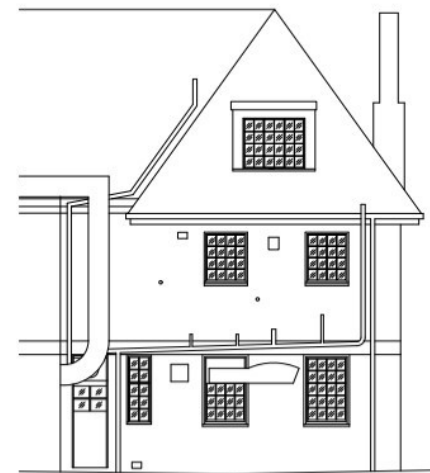


ELEVATION C
Scale 1:100



ELEVATION D
Scale 1:100



ELEVATION E
Scale 1:100

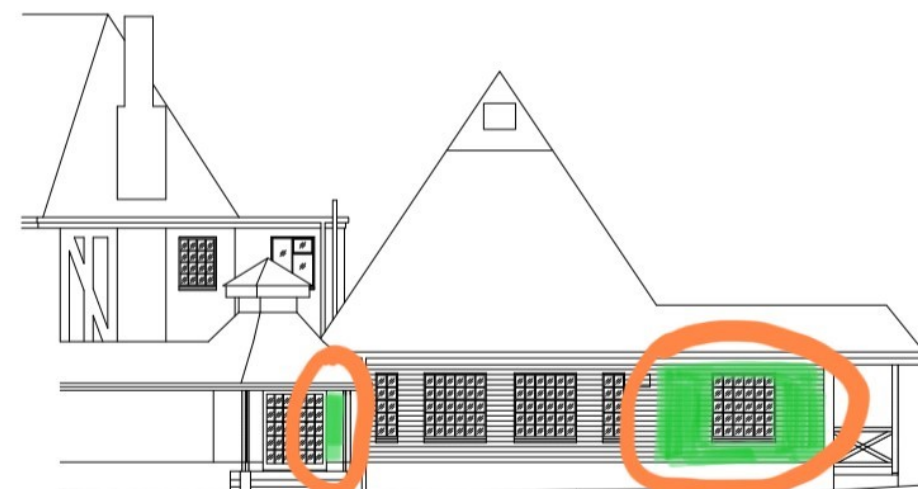

ELEVATION F
Scale 1:100

— NEW PAINTED
RENDER

— EXISTING
WEATHER-
BOARDING

APPRO

Do not scale from this drawing.
checked on site prior to construction.
discrepancies are to be resolved
immediately. © KIRK

KIRK

www.kirknolan.com
info@kirknolan.com
London | Cornwall

Client
MITCHELLS

Project
Browns, Ruislip, London

Drawing
Existing External

First Issue
JUNE 2022

Drawing No.
2206/8