
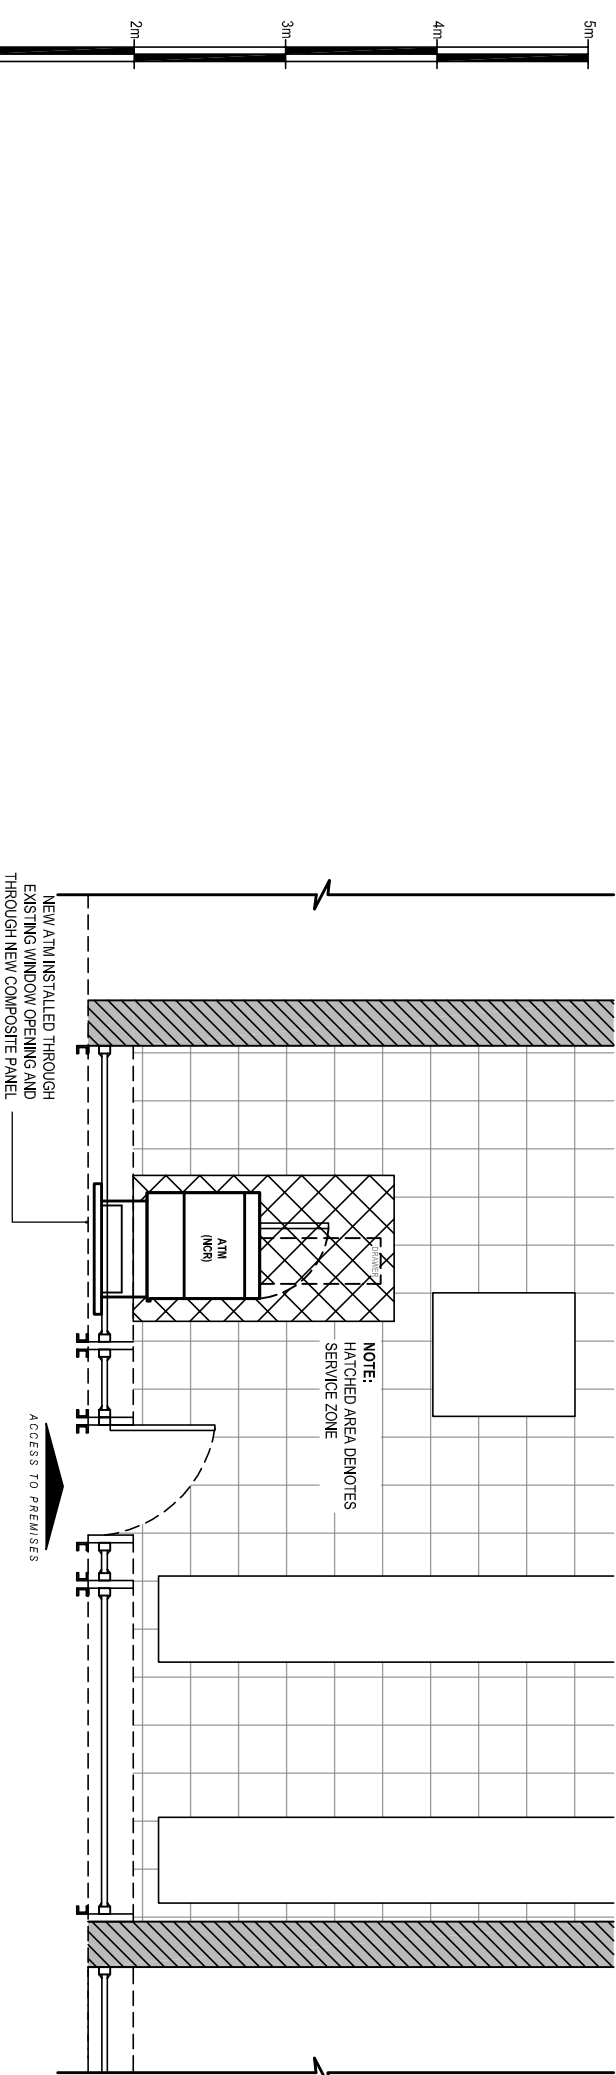


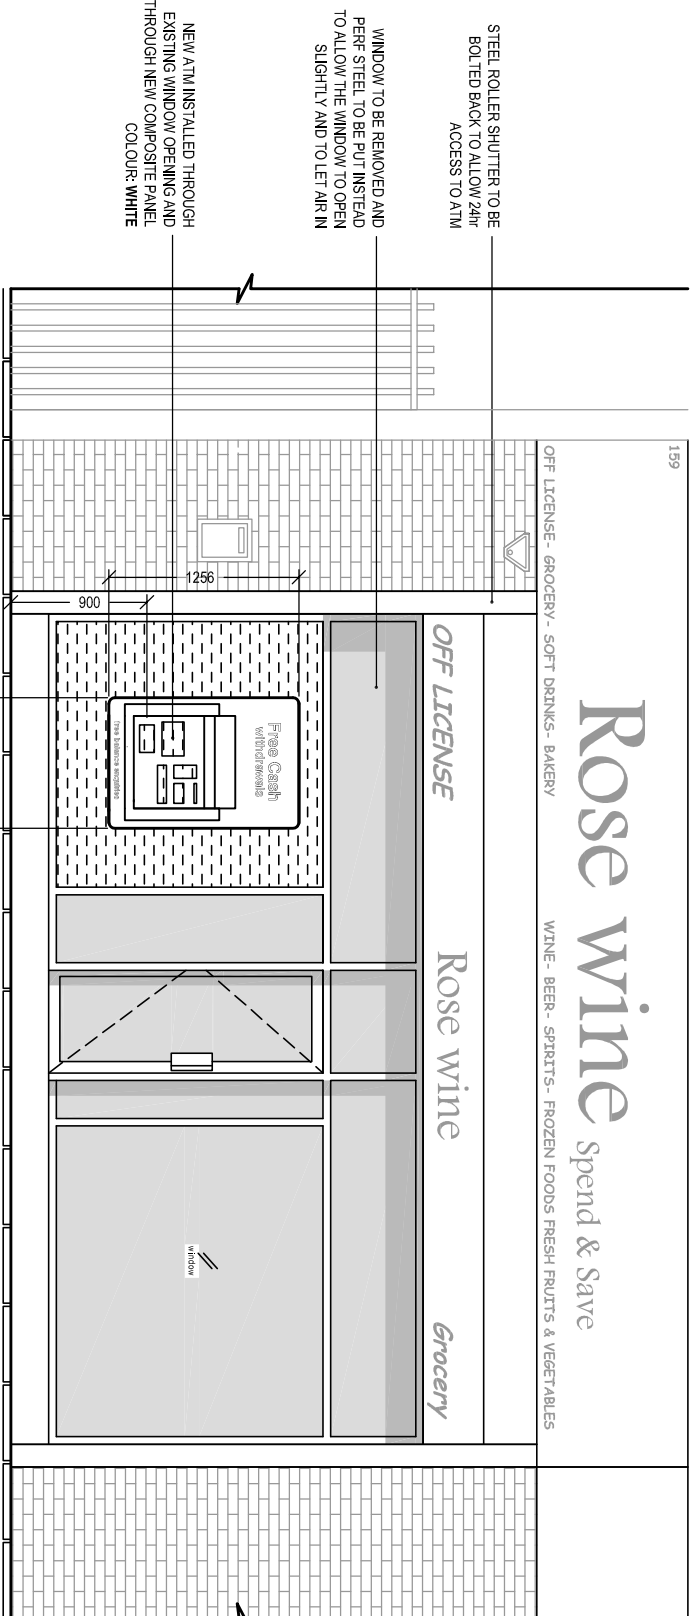

Date: _____ By: _____

Comments: _____

GENERAL NOTES:
1) All dimensions in millimeters unless otherwise stated.

Site:
ROSE WINE
159 Ryefield Avenue
Uxbridge
UB10 9DA

Drawing Title:
As Installed Elevations and Plans

Ref:	Date:	Rev:
NM-07-2015-65-2	06-07-2015	
Scale:	Paper:	Date Rev:
1:50	A3	