


REAR



REAR

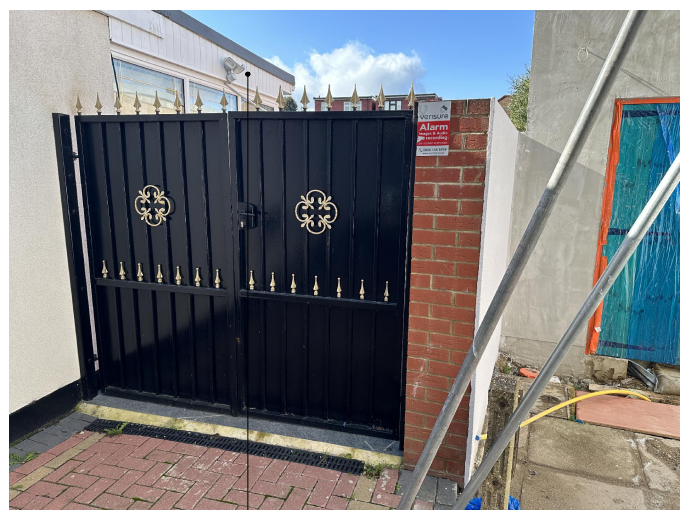


FRONT



FRONT




FRONT

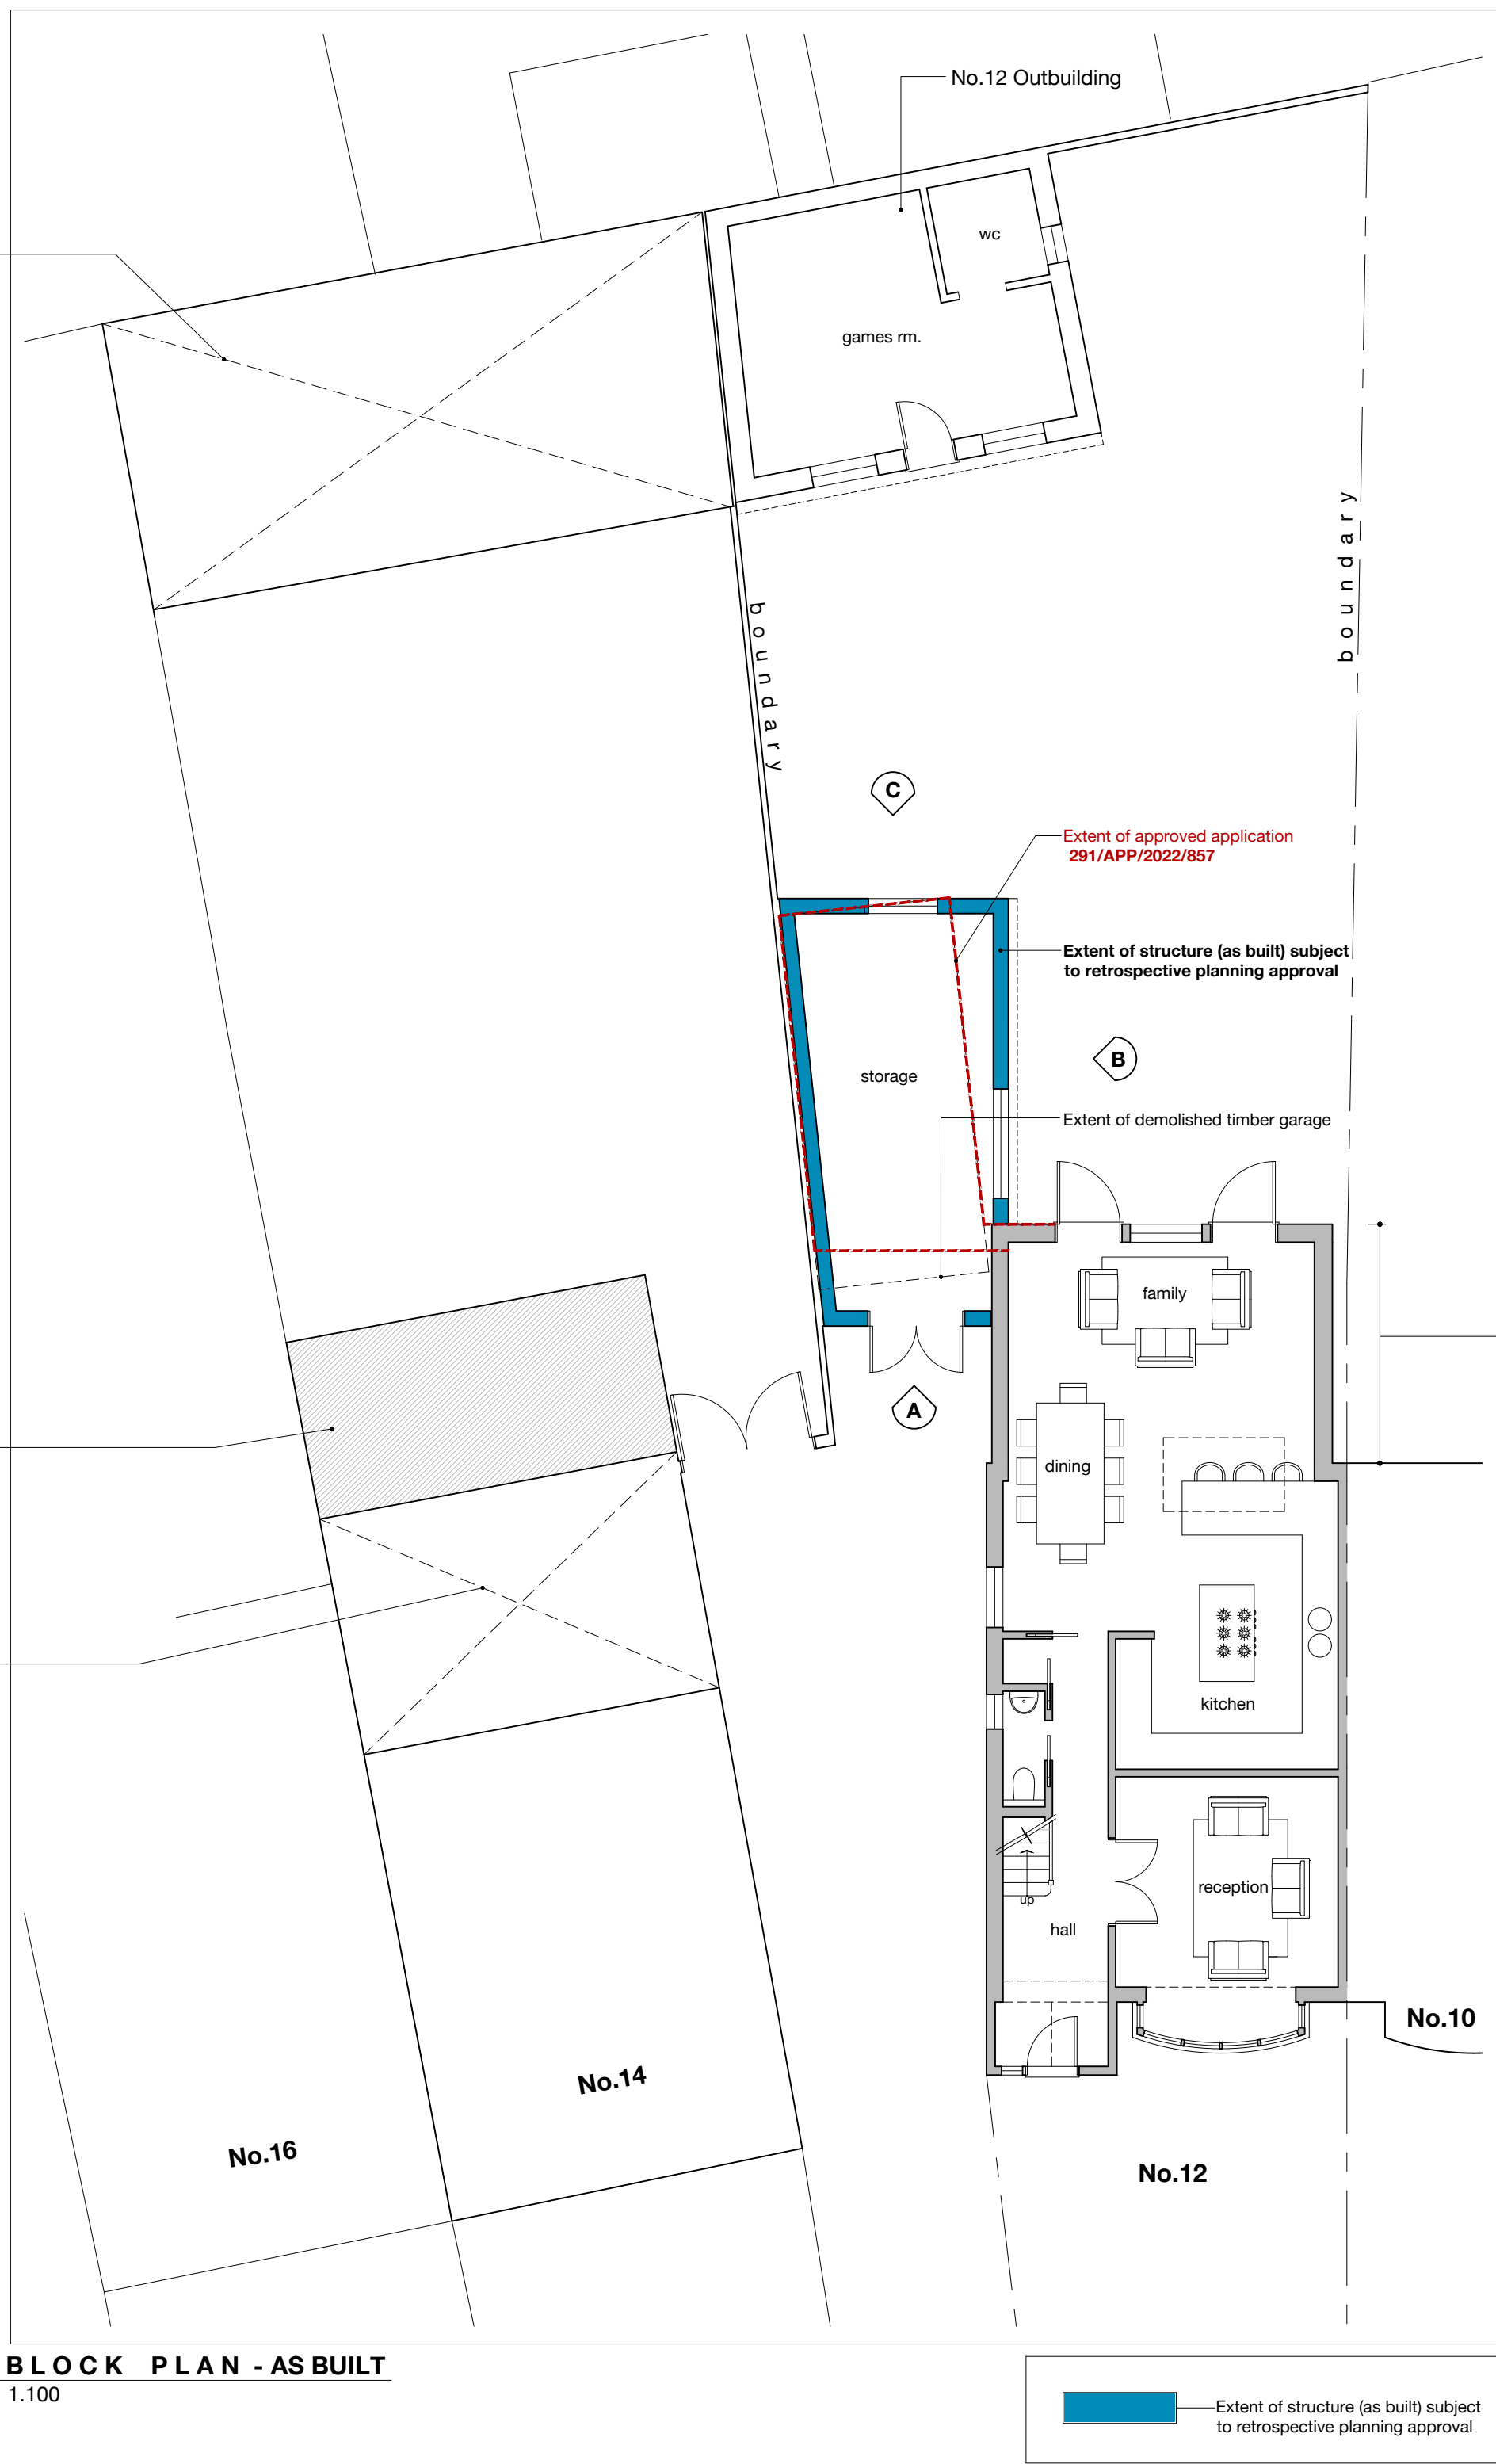


BLOCK PLAN - AS BUILT

1.100

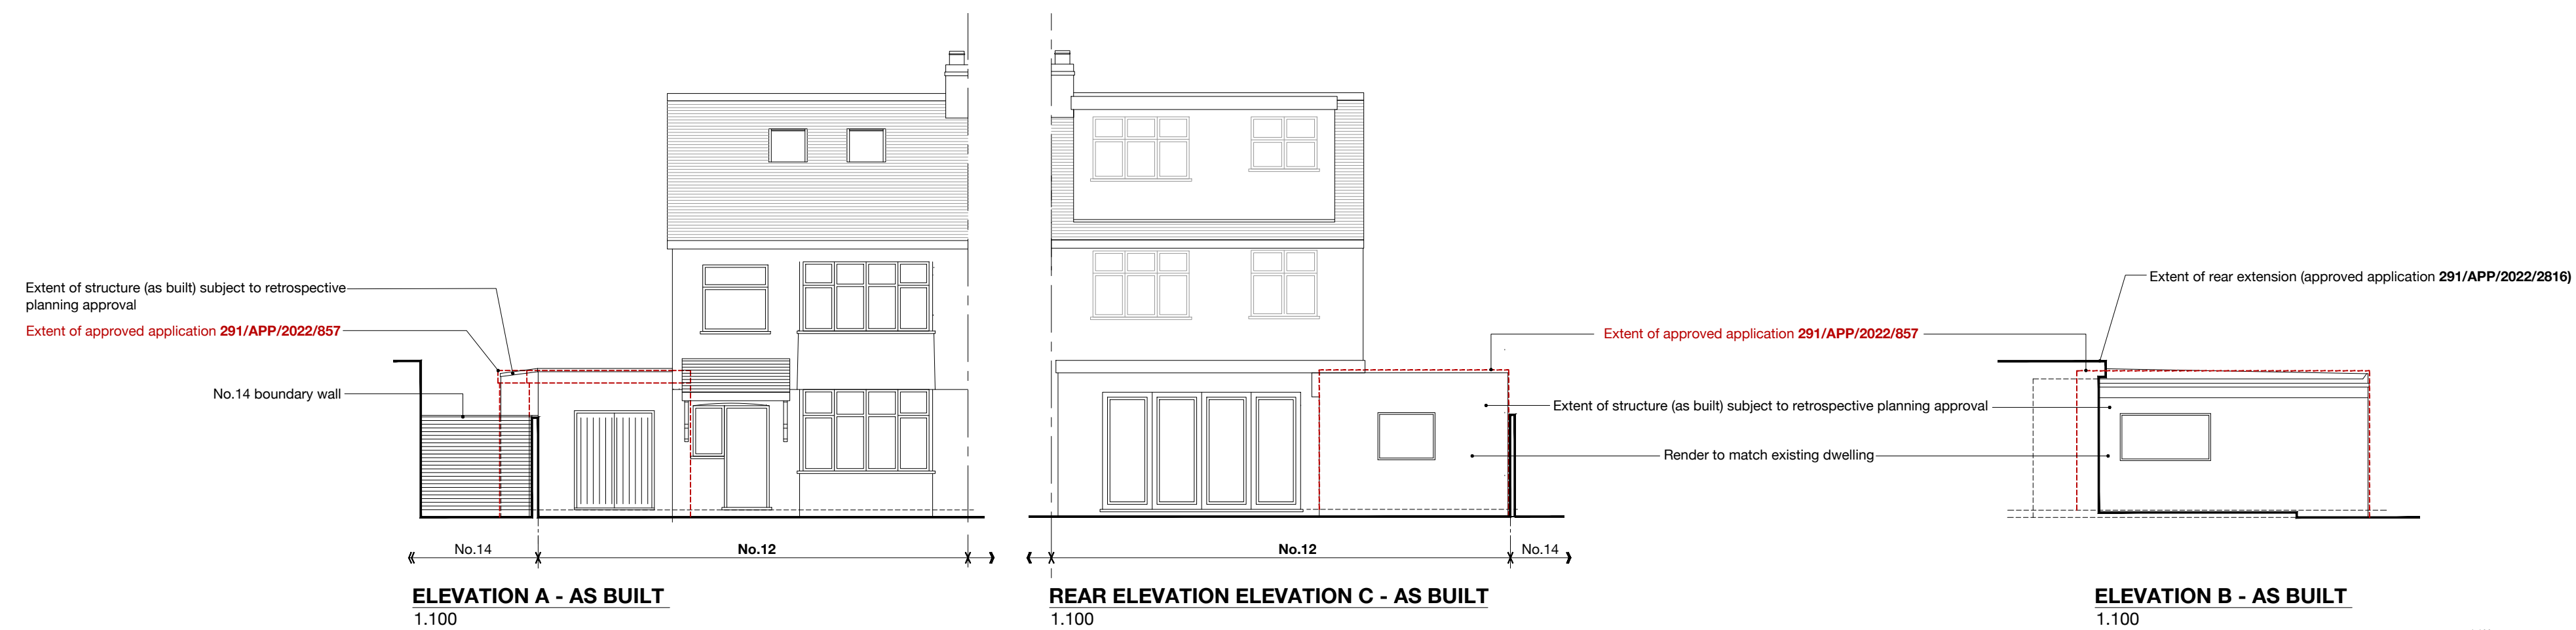


ELEVATION A - AS BUILT

1.100

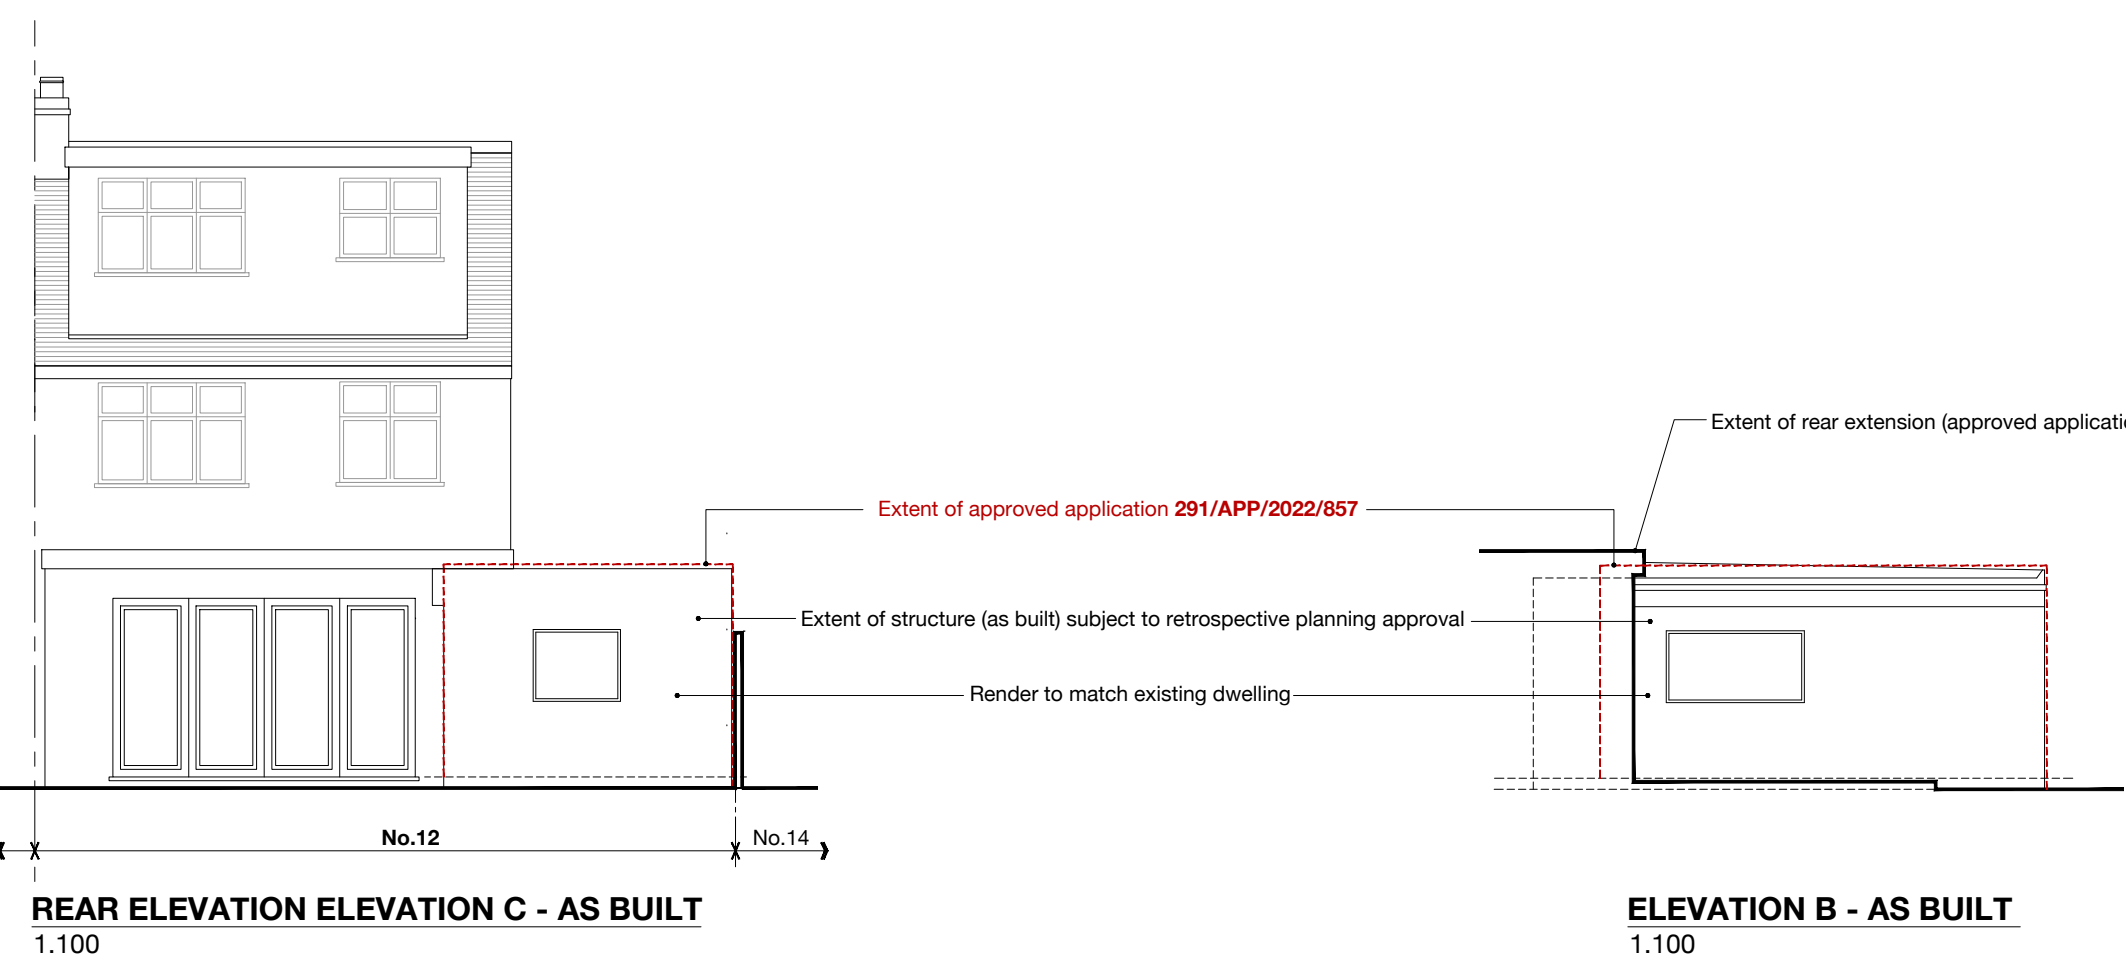

ELEVATION B - AS BUILT

1.100

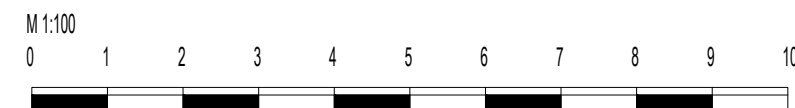

AERIAL



LOCATION PLAN - AS BUILT

1.200



FRONT - PRIOR TO DEMOLITION



FRONT - AS BUILT

A	03.12.24	KSP	Elevations amended
Revision			



drawing notes		© Akaii Architecture Ltd 2024	
All rights described in chapter IV of the Copyright Designs & Patents Act 1988 have been generally asserted. This Drawing must not be scaled; only figured dimensions should be used. If there are any discrepancies, or contradictions between this and other information, it should be brought to the Architect's attention.			
client: J Dhillon		project: 12 Hitherbroom Road, Hayes UB3	
drawing title: EXISTING PLANS + ELEVATIONS			
date: Nov. 2024	scale: 1:100 @A1 1:200 @A3	project no.: 2024.008	drawing no.: 03.01
			A

PLANNING