


General Notes:
 1. New work shown shaded in red
 2. Demolition shown dotted in red
 3. W: Wardrobe
 Cpld: Cupboard
 RLA: Roof lantern above
 RL: Roof light/lantern below
 4. If shown levels indicated in red dotted

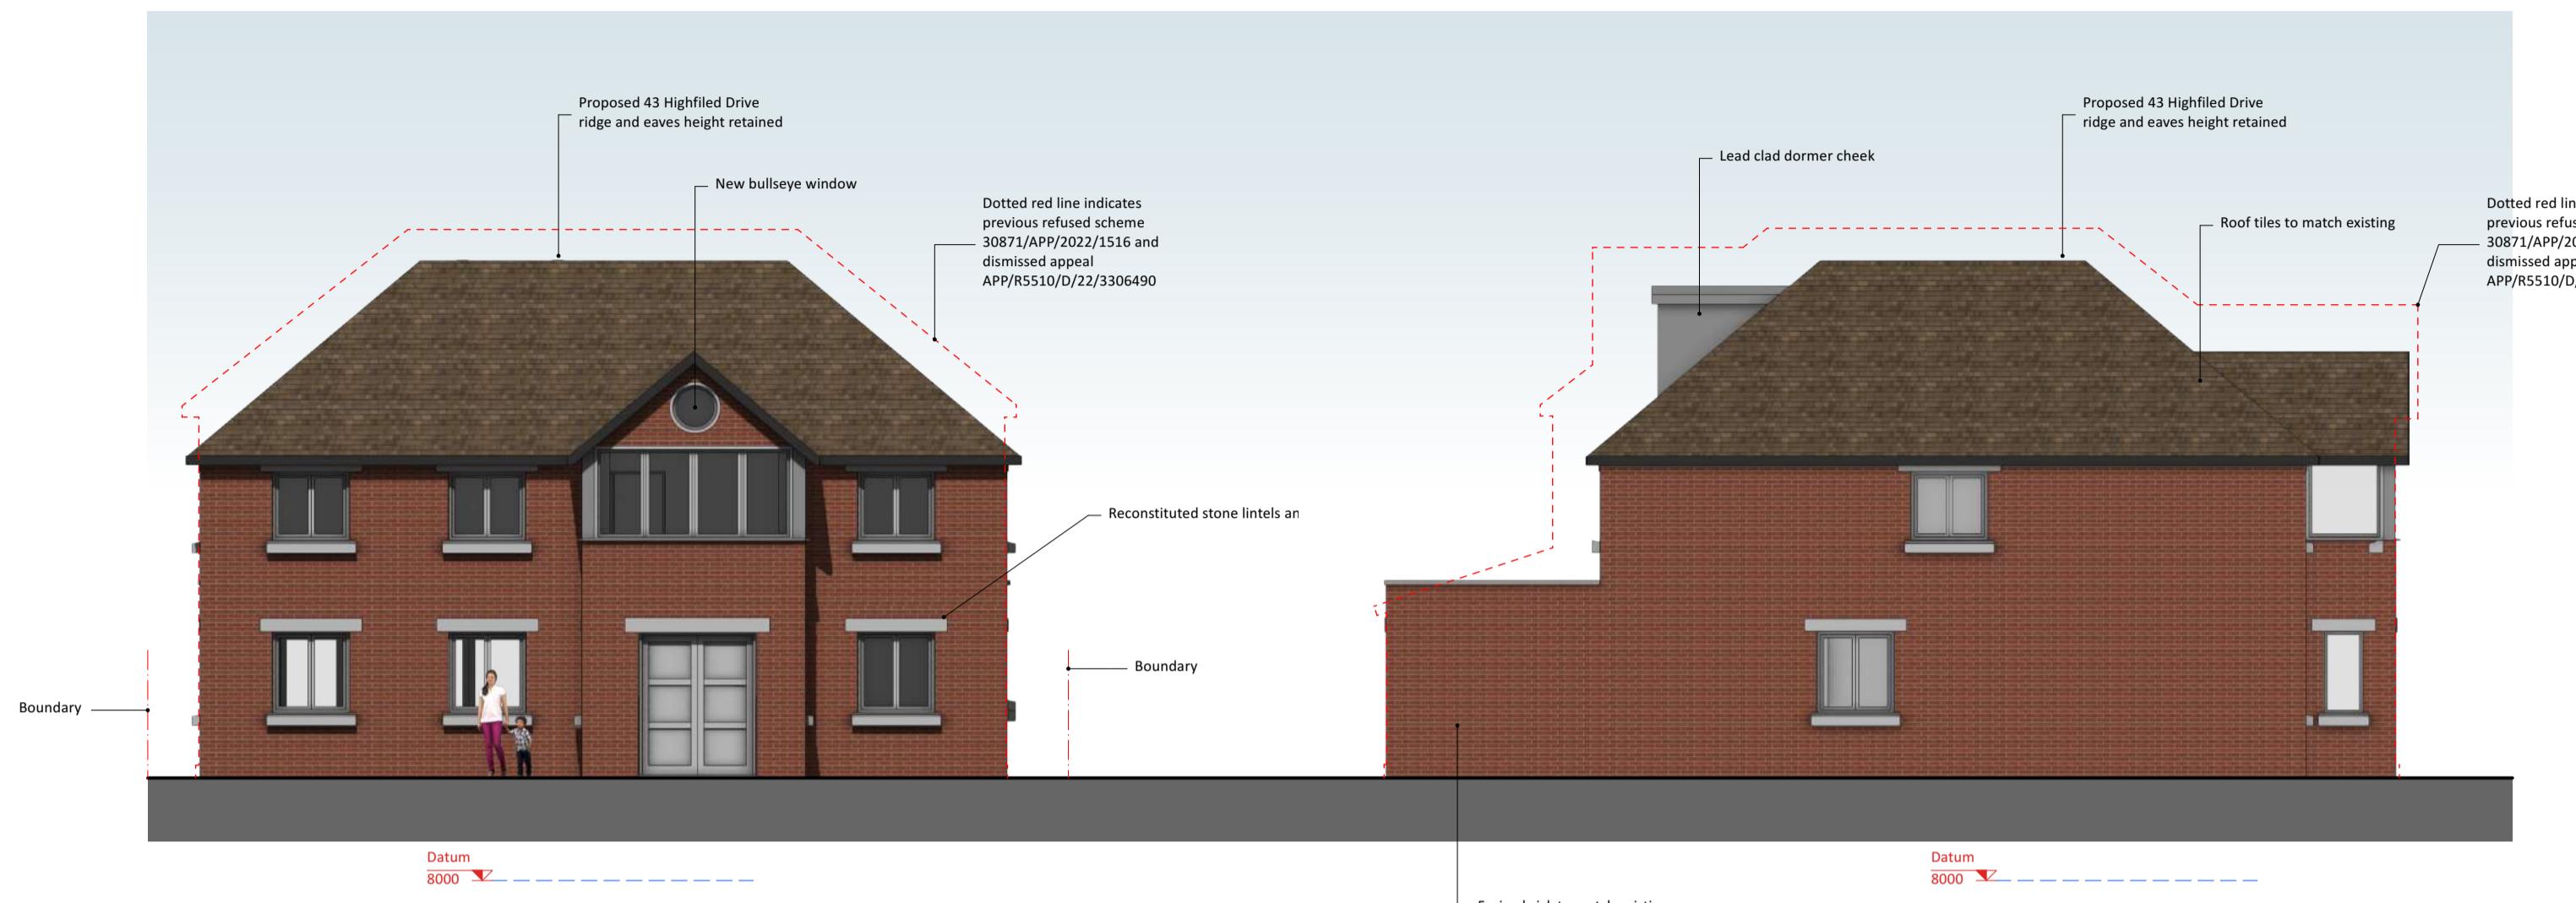

1 SOUTH WEST - Front

2 NORTH WEST - Side



4 NORTH EAST - Rear

5 SOUTH EAST - Side

A 12/12/2023 Main roof ridge/eaves heights re-adjusted as per LBH email of 07/11/23
 ISSUE DATE REVISION

PROJECT 41 Highfield Drive, Ickenham UB10 8AW

CLIENT Mr Madhan

PROPOSED ELEVATIONS



All rights reserved in chapter IV of the copyright designs & patent act 1988. Any unauthorised use of this drawing must not be scaled, only figured dimensions should be used. Check and verify all dimensions on site prior to commencing any work. Any discrepancies should be reported to the Architects immediately.

PROJECT # 2023.006 DWG # REV
 DATE 02/09/2023
 SCALE 1:100
 DRAWN JC CHKD JC
 D11 - A

Stones Architects Ltd
 50 Coldharbour Lane Hayes Middlesex UB3 3EP
 t 020 8969 0000 e mail@stonesarchitects.co.uk w stonesarchitects.co.uk