
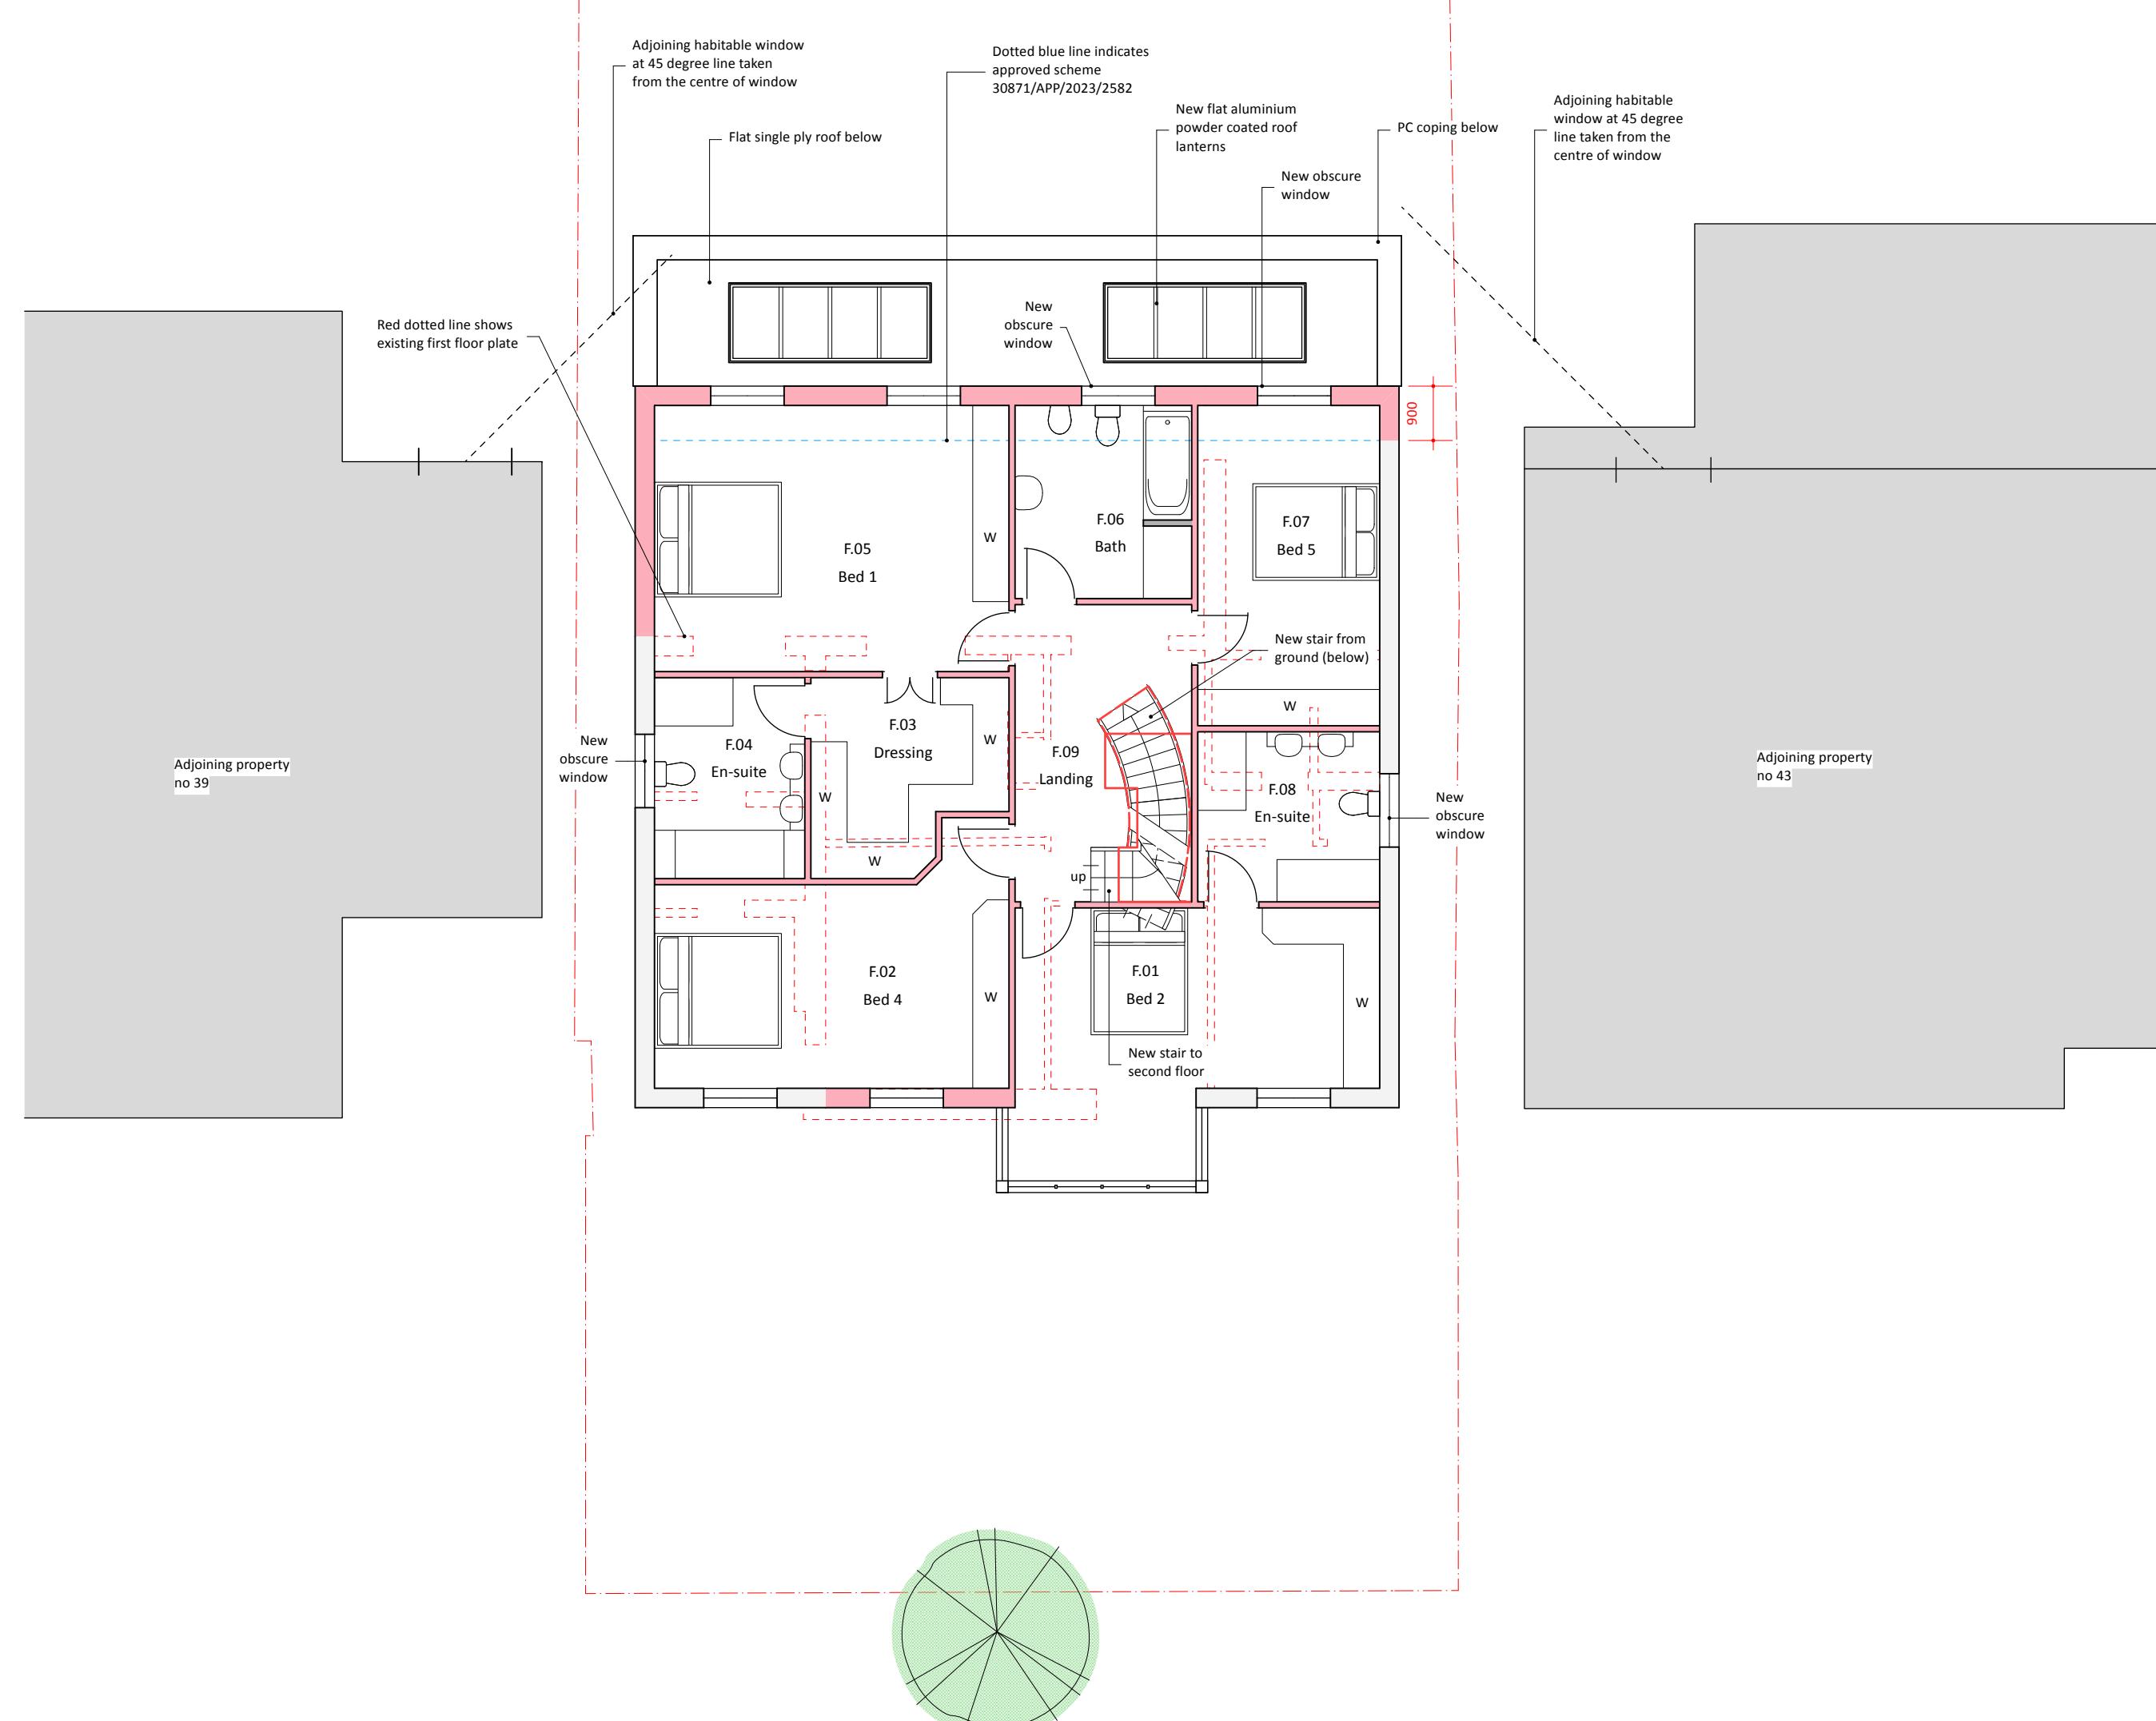


General Notes:  
 1. New work shown shaded in red  
 2. Demolition shown dotted in red  
 3. W: Wardrobe  
 Cplb: Cupboard  
 RL: Roof lantern above  
 RL: Roof light/lantern below  
 4. If shown levels indicated in red dotted

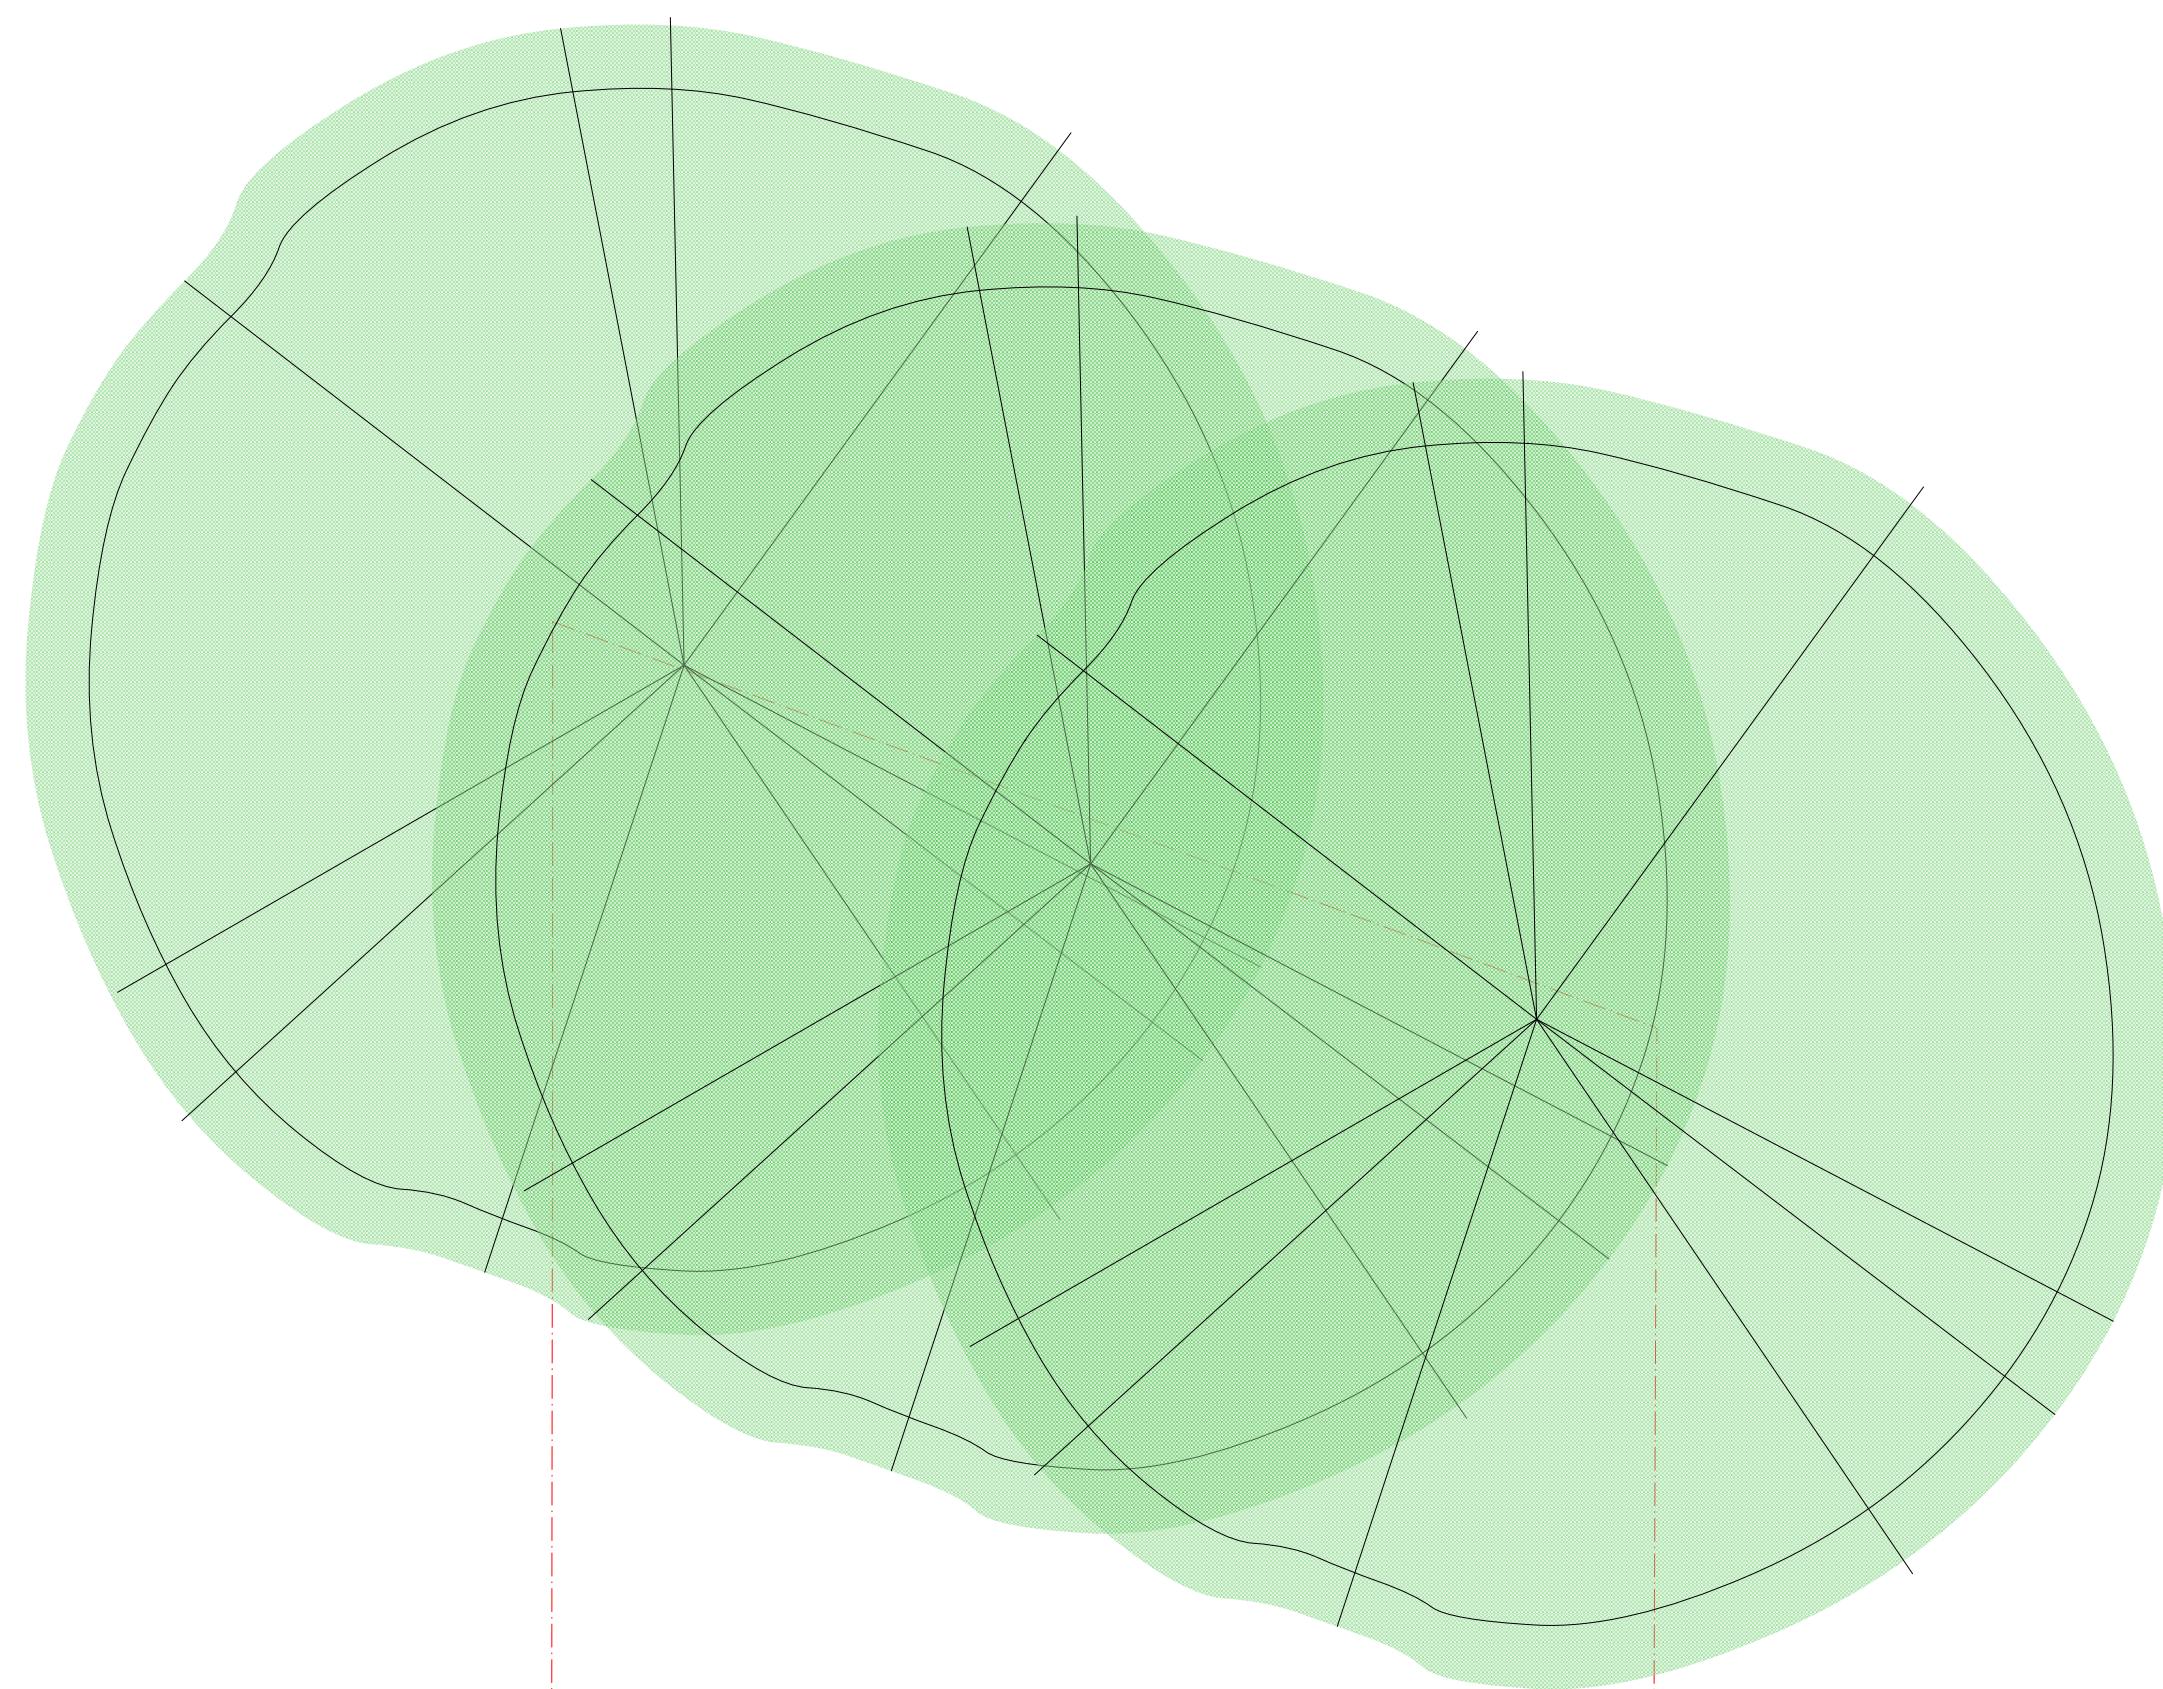

ISSUE DATE REVISION

PROJECT 41 Highfield Drive, Ickenham UB10 8AW

CLIENT Mr Madhan


DRAWING PROPOSED FIRST FLOOR

**STONES**  
ARCHITECTS

All rights reserved in chapter IV of the copyright designs & patents act 1988 have been asserted. This drawing must not be scaled; only figured dimensions to be used. Check and verify all dimensions on site prior to commencing any work. Any discrepancies should be reported to the Architects immediately.

PROJECT # 2023.006 DWG #  
 DATE 20/06/2025  
 SCALE 1:100  
 DRAWN JC CHKD JC  
 D101

0.0 1.0 2.0 3.0 4.0 5.0 M

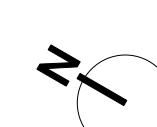

Stones Architects Ltd  
 50 Coldharbour Lane Hayes Middlesex UB3 3EP  
 t 020 8969 0000 e mail@stonesarchitects.co.uk w stonesarchitects.co.uk