



NORTH ELEVATION

SOUTH ELEVATION

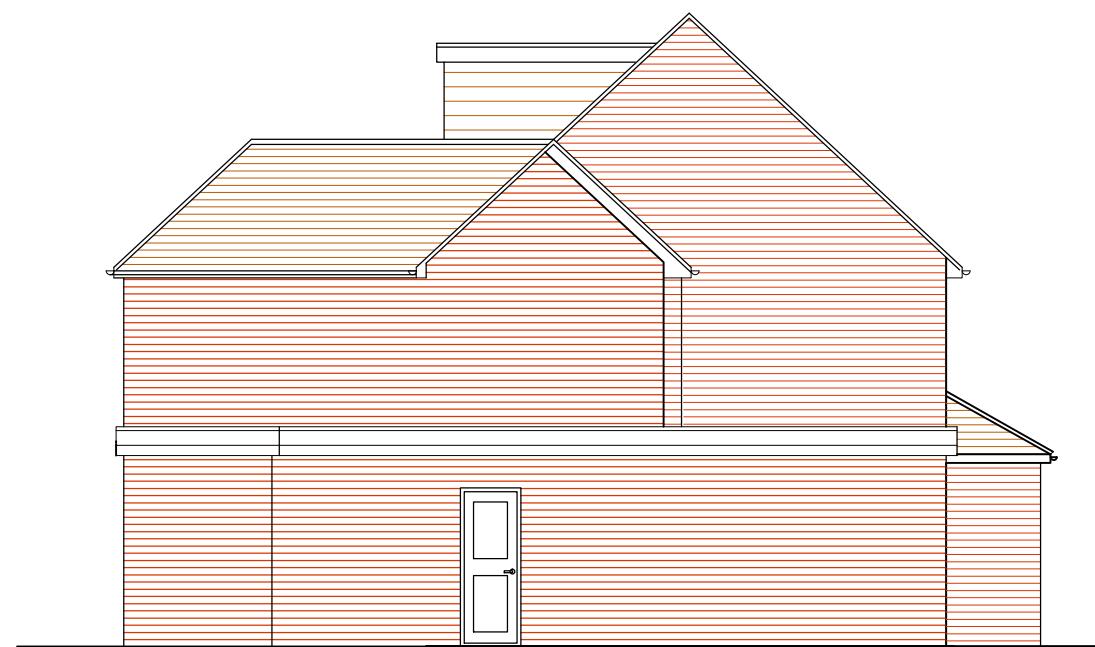

EAST ELEVATION

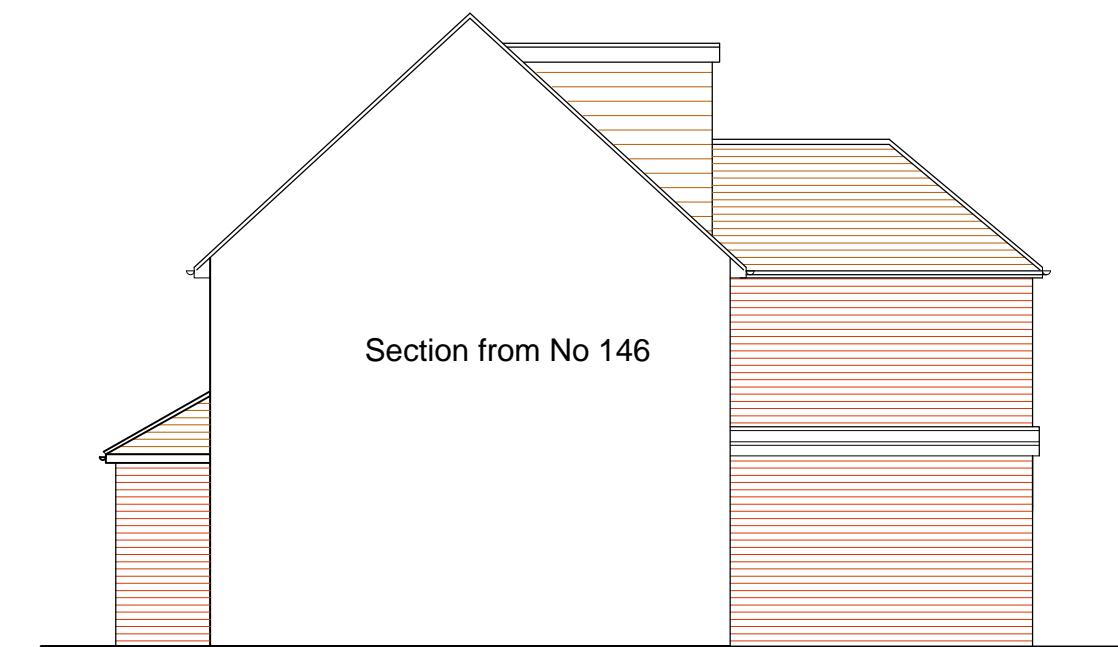

WEST ELEVATION

ELEVATIONS  
AS BUILT

**148 Pine Gardens, Ruislip, HA4 9TH**

Scale Bar

1:100 @ A3

0 1 2 3 4 5 6 7 8 9 10 Metres



THE GILLETT MACLEOD PARTNERSHIP  
Chartered Architects & Town Planning Consultants

Drg. No. 17/3158/407  
Scale 1:100@A3  
Date 06/09/21  
Drawn by AK

REVISION  
C  
drawer