


No 146

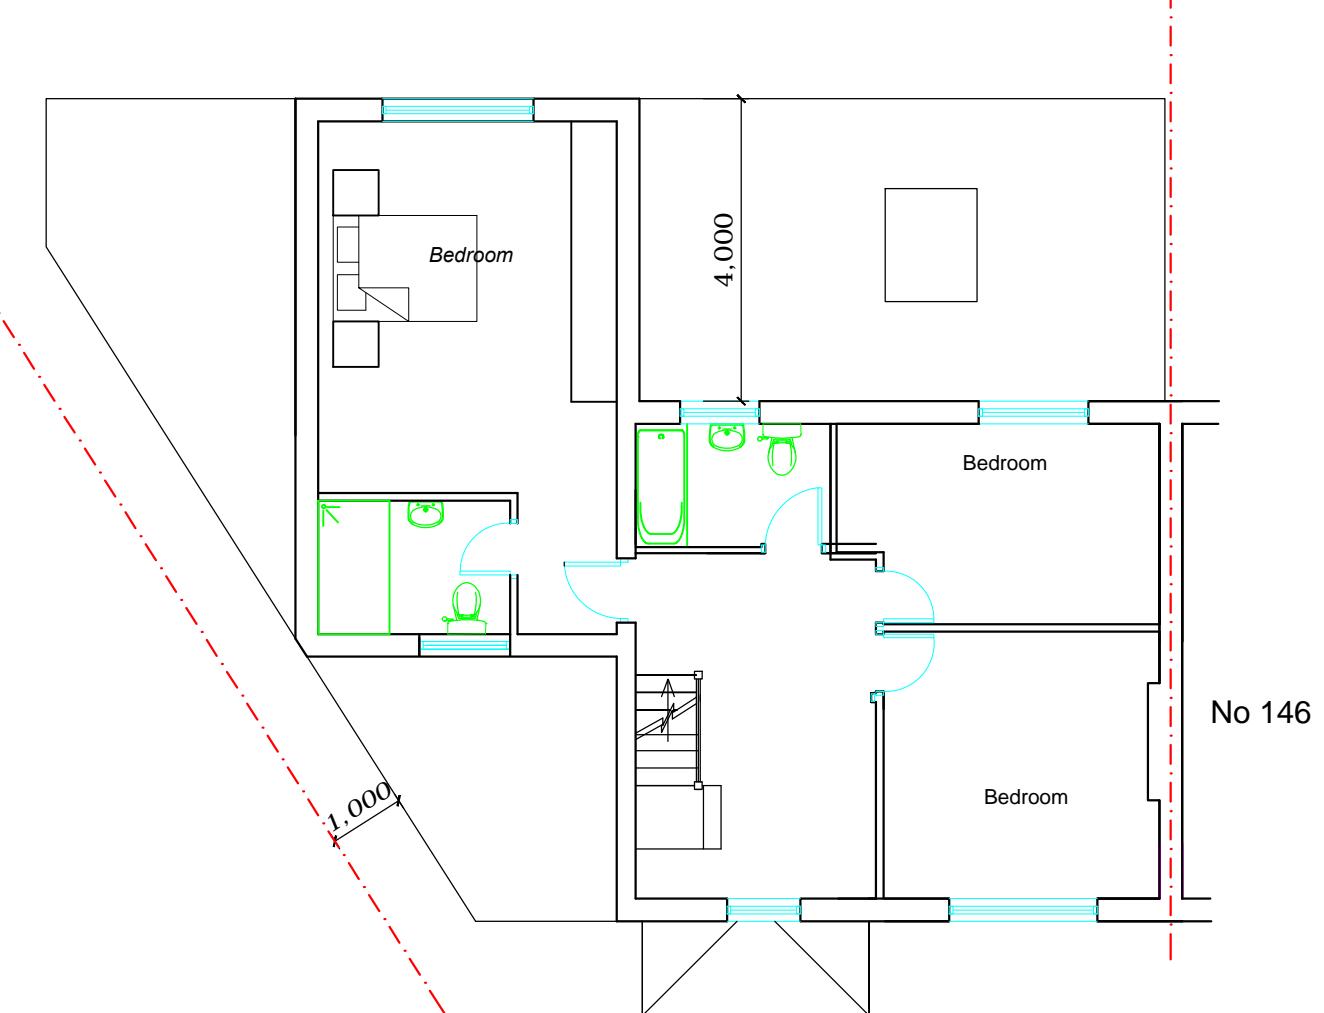

No 146

FLOOR PLANS
AS BUILT

148 Pine Gardens, Ruislip, HA4 9TH

Scale Bar


0 1 2 3

1:100 @ A3

4 5 6 7

Metres

8 9 10

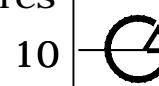

THE GILLETT MACLEOD PARTNERSHIP
Chartered Architects & Town Planning Consultants

Drg. No. 17/3158/405
Scale 1:100@A3
Date 06/09/21
Drawn by AK

REVISION
C
drawer