



Second Floor Plan

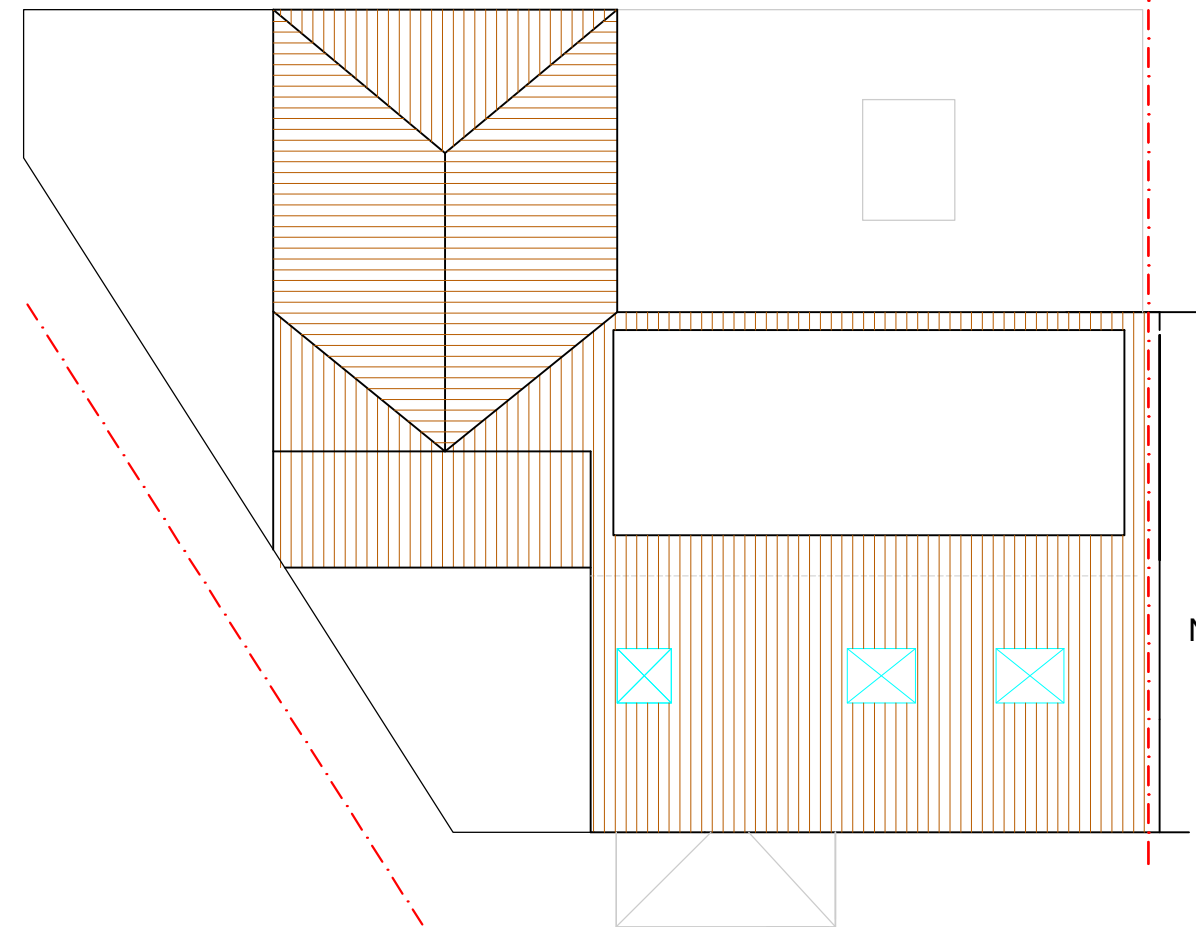

Roof Plan

FLOOR PLANS
AS BUILT

148 Pine Gardens, Ruislip, HA4 9TH

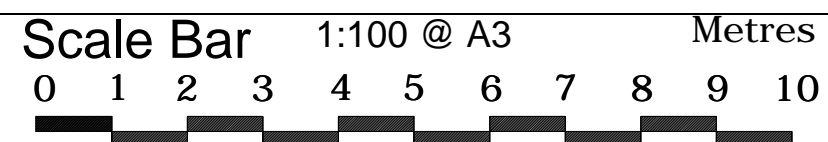

THE GILLETT MACLEOD PARTNERSHIP
Chartered Architects & Town Planning Consultants

Drg. No. 17/3158/406
Scale 1:100@A3
Date 06/09/21
Drawn by AK

REVISION
C