


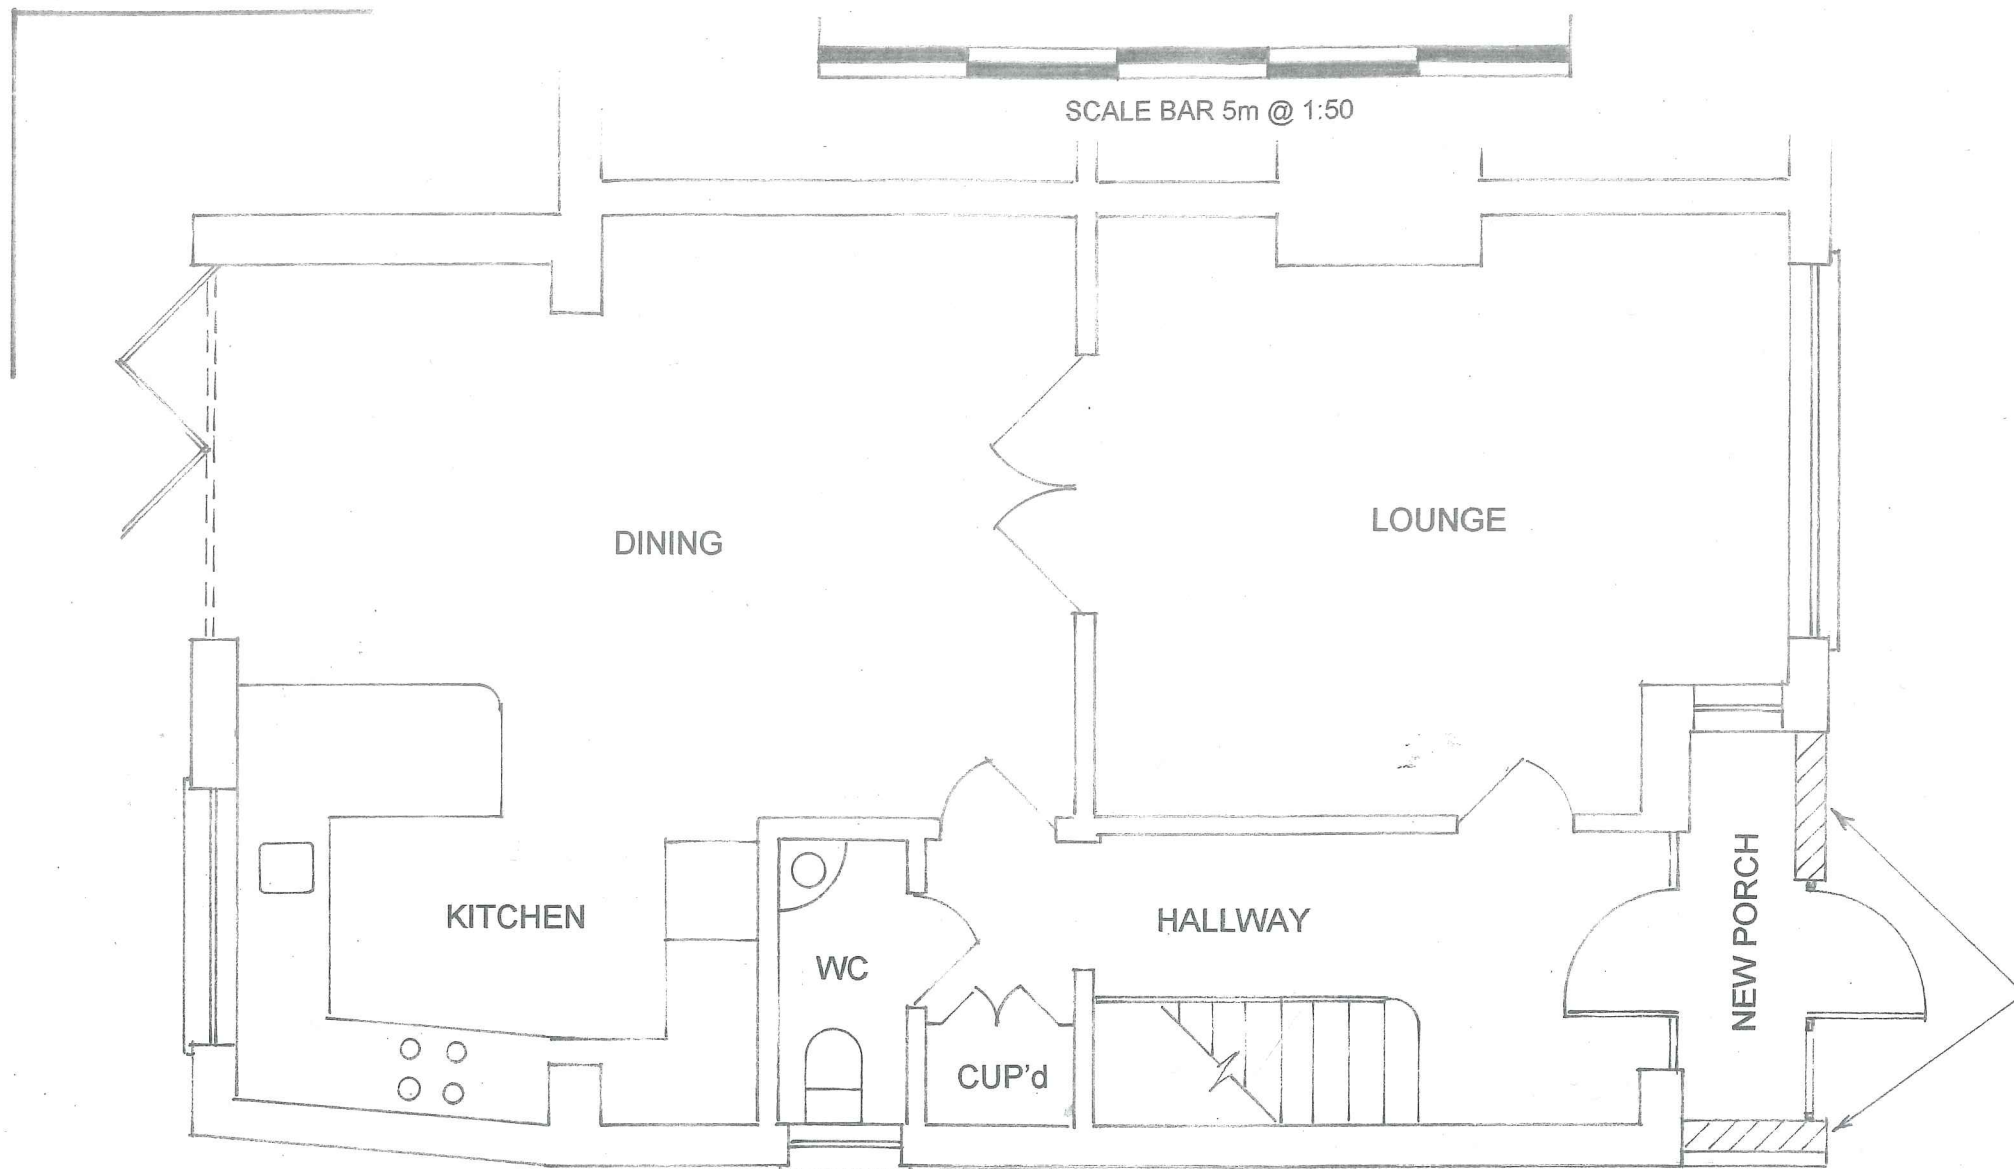

EXISTING (AS BUILT) GROUND FLOOR PLAN @ 1:50

EXISTING BLOCKWORK
TO BE ALTERED TO
FACE BRICKWORK TO
MATCH EXISTING

SITE:
12 EDINBURGH CLOSE
ICKENHAM
UB10 8RA

PROPOSAL:
ALTERATIONS TO FRONT
PORCH AND ERECTION
OF TILED ROOF TO
FRONT ELEVATION
**REVISED RETRO
APPLICATION**

DWG. TITLE:
EXISTING AS BUILT
PLANS AND ELEVATIONS

SCALE: 1:50 & 1:100 @ A3

DWG. NO.
0419 / CP / 05

REV:




Telephone: 020 8578 0155
Mobile: 07976 510827
Email: paulwryman@aol.com
www.pdsplanning.co.uk




ELEV'n 'A'

EXISTING BLOCKWORK
TO BE ALTERED TO
FACE BRICKWORK TO
MATCH EXISTING

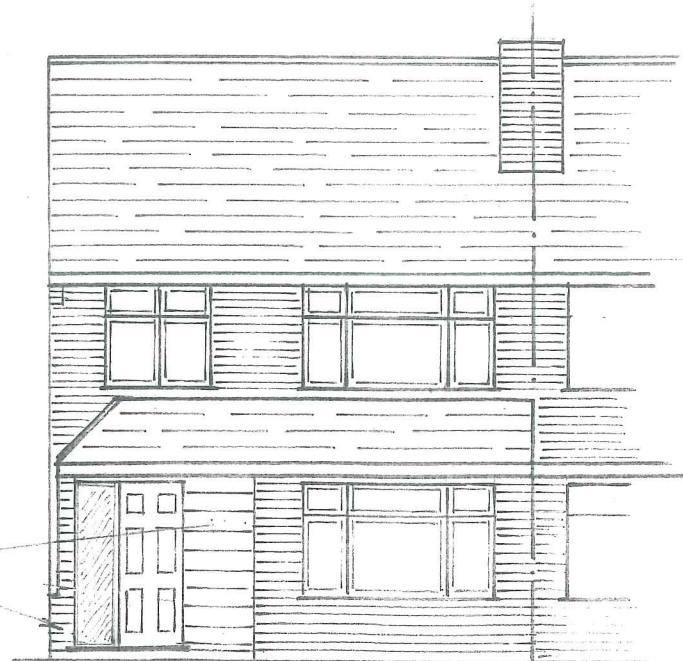


AS BUILT FRONT ELEV @ 1:100

ELEV'n 'B'

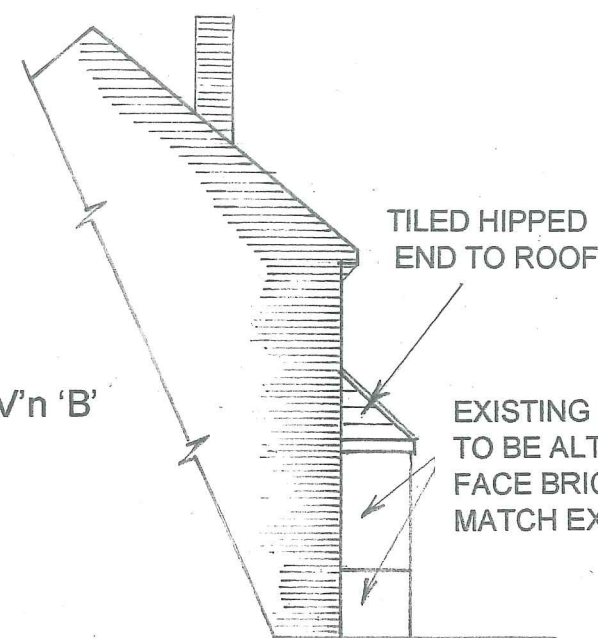

ELEV'n 'A' @ 1:100

BLACK PVC
END PANEL
TO ROOF

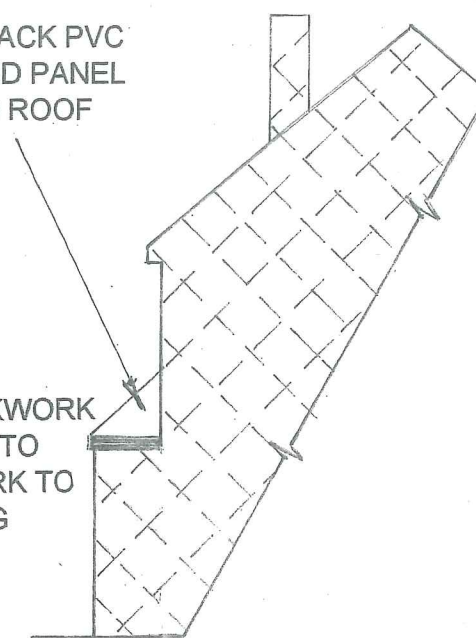

ELEV'n 'B' @ 1:100