





**NOTES**

- All dimensions are to be checked on site prior to the commencement of work and any discrepancy is to be reported to the construction manager before construction.
- All work is to comply with current Building Regulations and allied legislation.
- All contractors and sub-contractors must ensure that they have the latest issue of this drawing and details before the commencement of work on site.
- All materials are to be used and installed in strict compliance with the relevant manufacturers instructions and recommendations.
- Architectural drawings are prepared as a result of designs referred to in this drawing. They are to give full consideration for compliance with the Health and Safety CDP Regulations in respect of design and implementation on site and no works are to be undertaken if it is considered that compliance with the Building Regulations cannot be achieved.
- All dimensions shown in millimetres.
- Footprint of buildings shown at 10m above ground level.

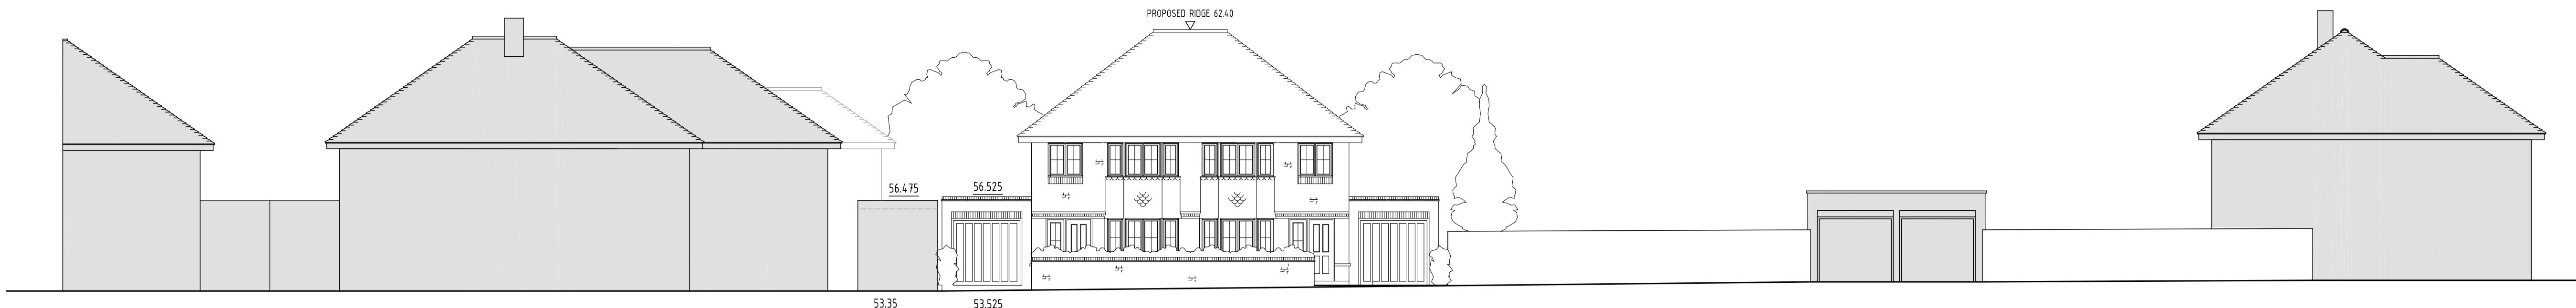

STREET SCENE ALONG RAISINS HILL SCALE 1:125

SCALE BAR (m)  
0 2.5 5 7.5 10 12.5

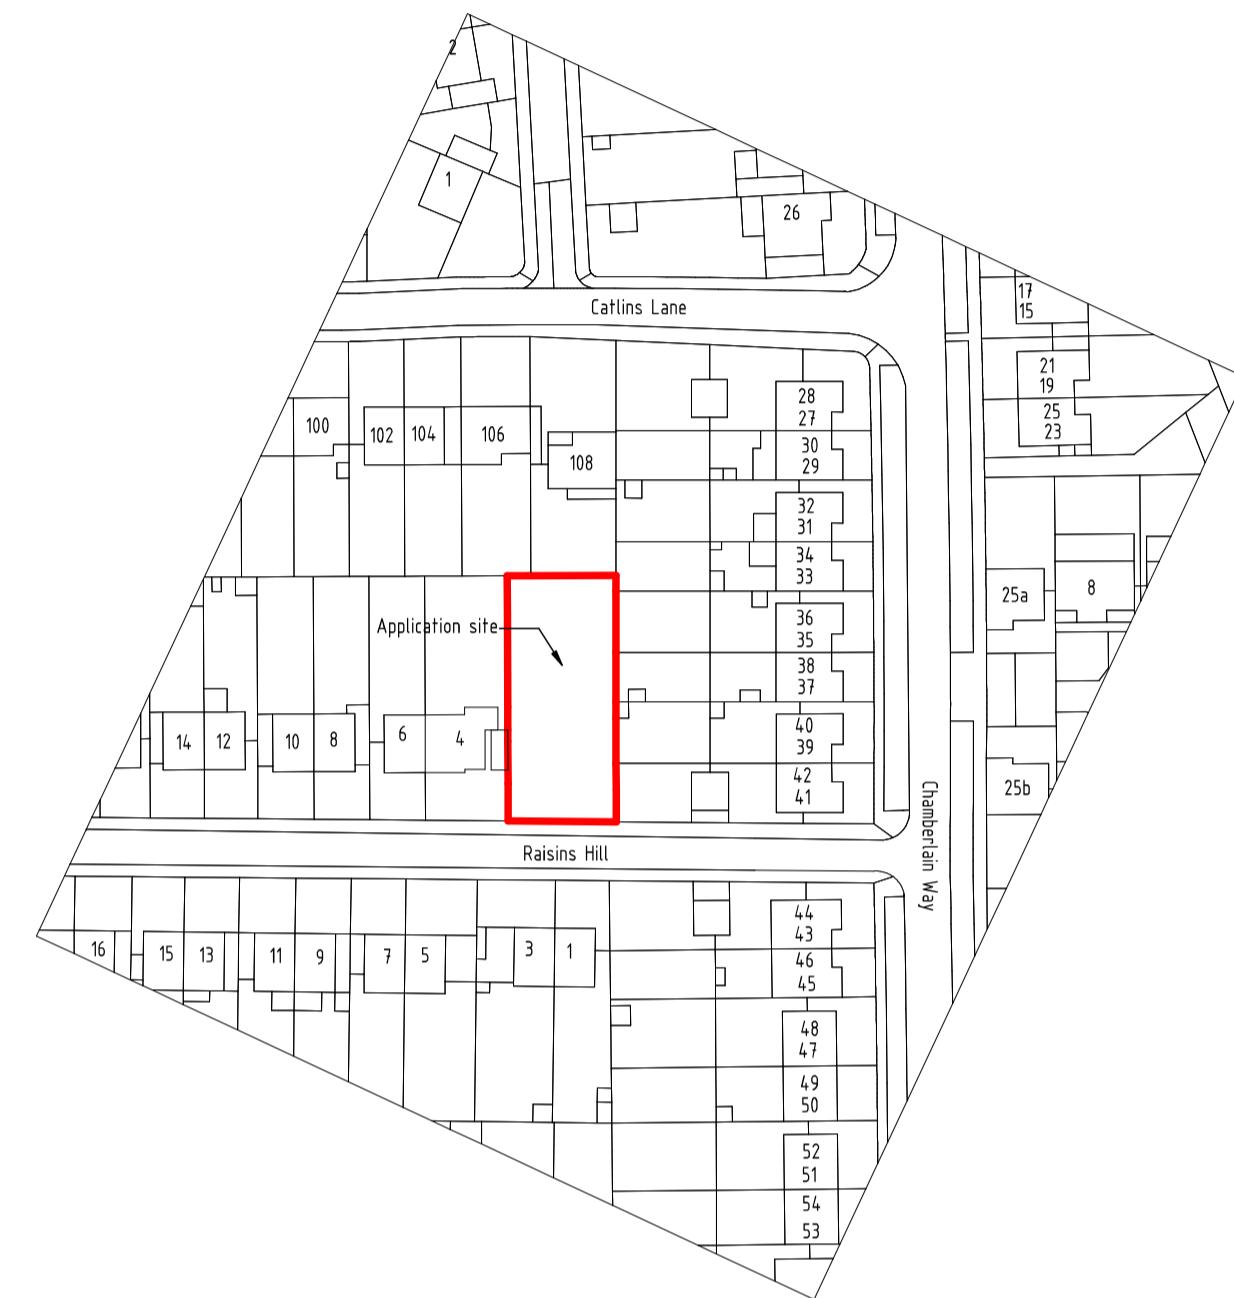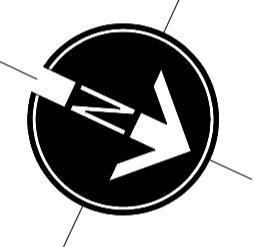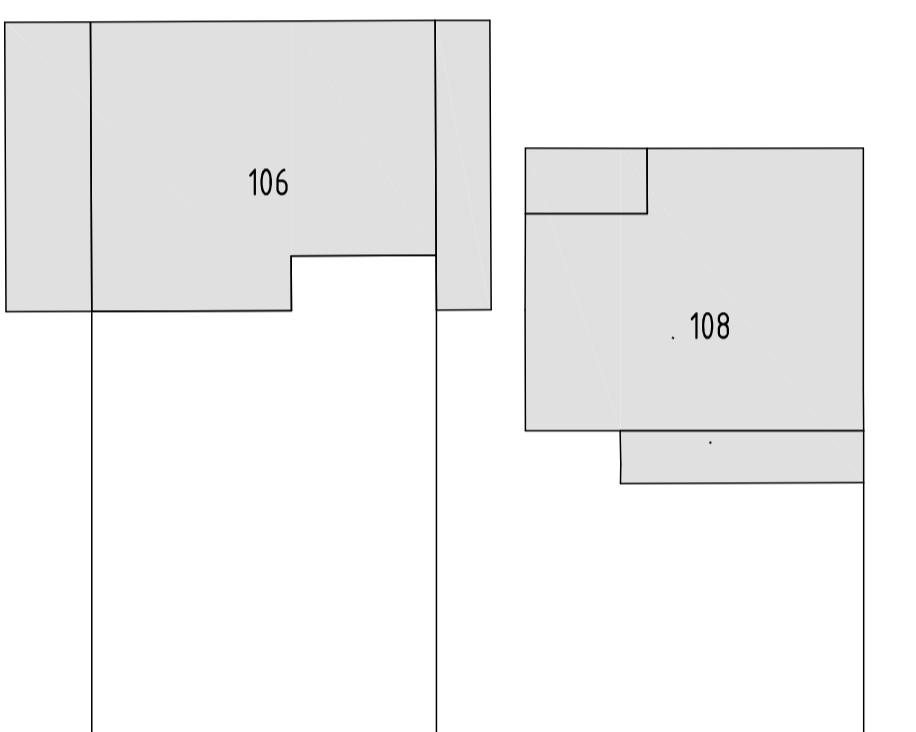

SITE LOCATION PLAN  
SCALE 1:1250

(c) UKMap Copyright. The Geoinformation Group 2017 Licence No. LANDMLON10000312118

SCALE BAR (m)

0 25 50 75 100 125

SITE AREA - 0.068 HECTARES

rev:	date:	description:
scale:	1:250 A1	date: 08-11-2023
drawing no:	1267-P5-1	drawn: AT
drawing:	AS BUILT	
project:	2 RAISINS HILL, EASTCOTE MIDDLESEX HA52BS	
client:	MR SUNDIP SHAH	

DDA

DUSEK DESIGN ASSOCIATES LTD  
ARCHITECTURE + PLANNING

01895 831 103  
info@dusek.co.uk  
www.dusek.co.uk

SITE LAYOUT PLAN SCALE 1:250

SCALE BAR (m)  
0 5 10 15 20 25

SCALE BAR (m)

0 5 10 15 20 25

print history: Wednesday, 8 November, 2023 17:17:41

Customer/ANDY/246 - DocumentID:008381246 025-0001246 2 RAISINS HILL/P5-1-P5-1 - PSCH ADDED 04/11/2023