

NOTES

1. All dimensions are to be checked on site prior to the commencement of work and any discrepancy is to be reported to the construction manager before construction.

2. All work is to comply with current Building Regulations and allied legislation.

3. All contractors and sub-contractors must ensure that they have the latest issue of this drawing and details before the commencement of work on site.

4. All materials are to be used and installed in strict compliance with the relevant manufacturers instructions and recommendations.


5. All works on site, managed and implemented as a result of the design indicated on this drawing, are to be given full consideration for compliance with the Health and Safety Executive's guidance in respect of design and implementation on site and no works are to be undertaken if it is considered that compliance with the Building Regulations cannot be achieved.

6. All dimensions shown in millimetres.


7. Footprint of buildings shown at 0m above ground level.




SIDE ELEVATION

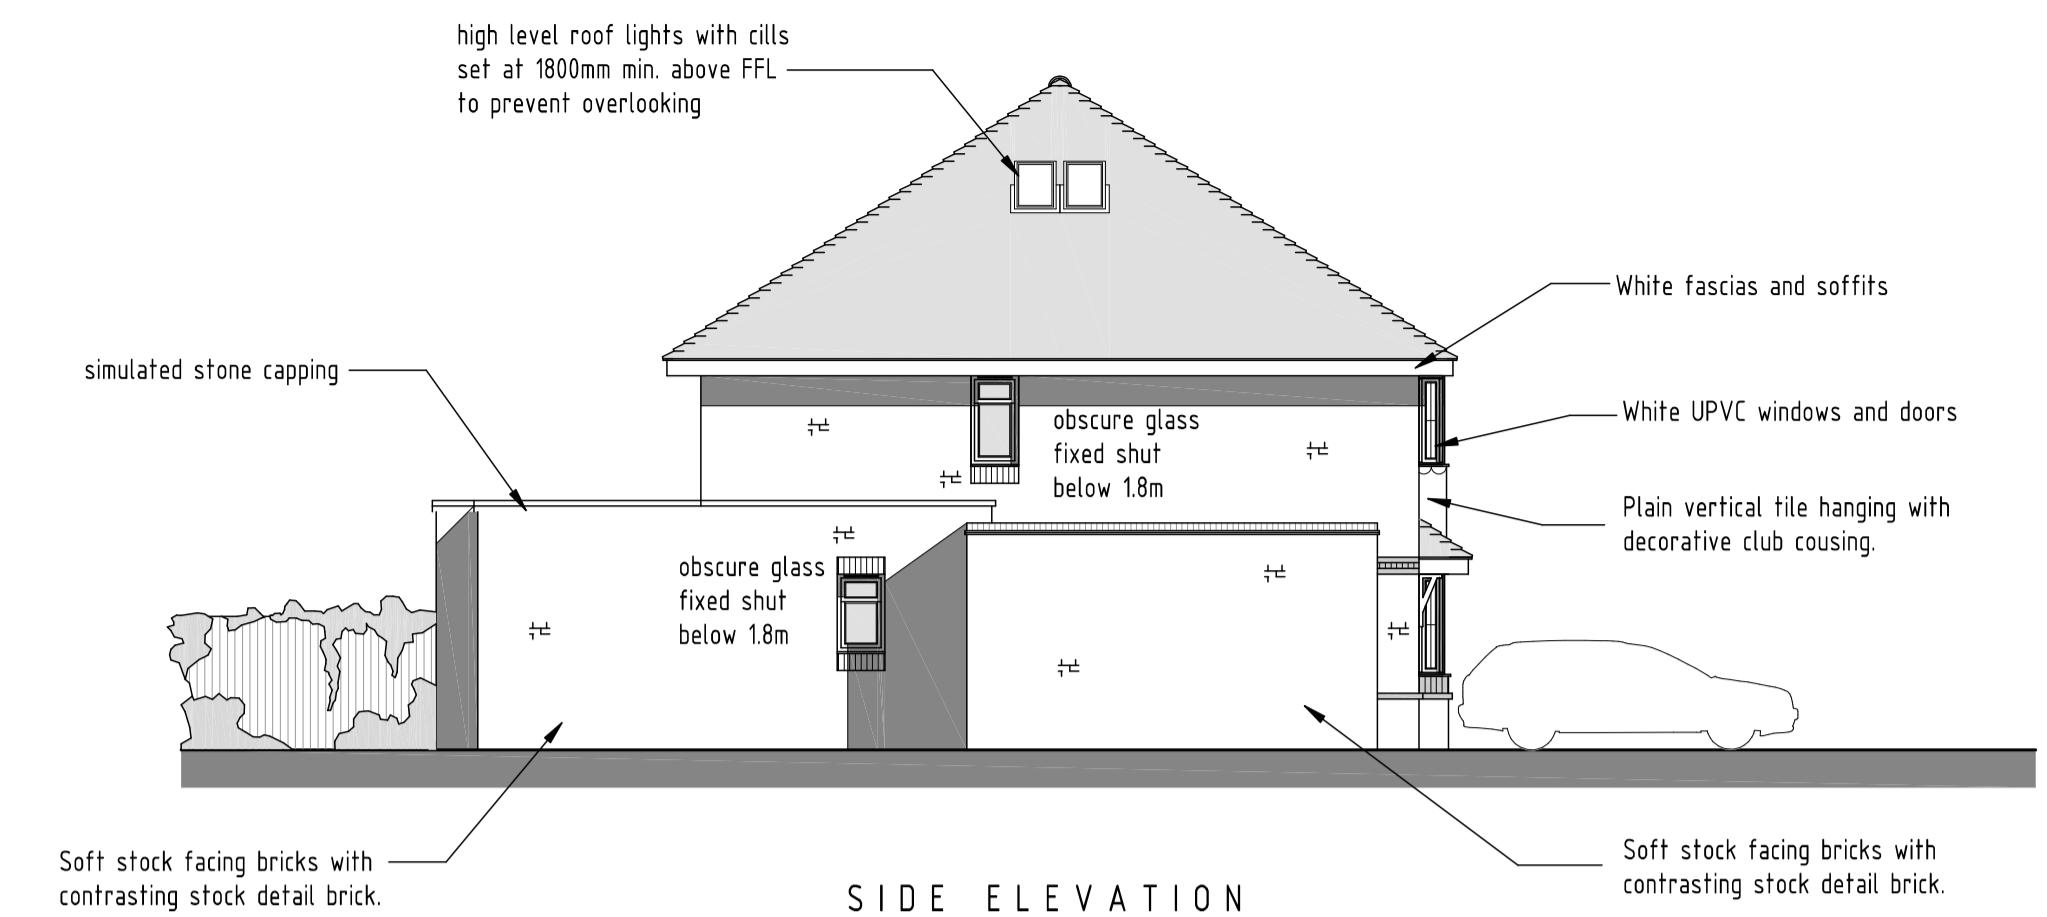


SIDE ELEVATION

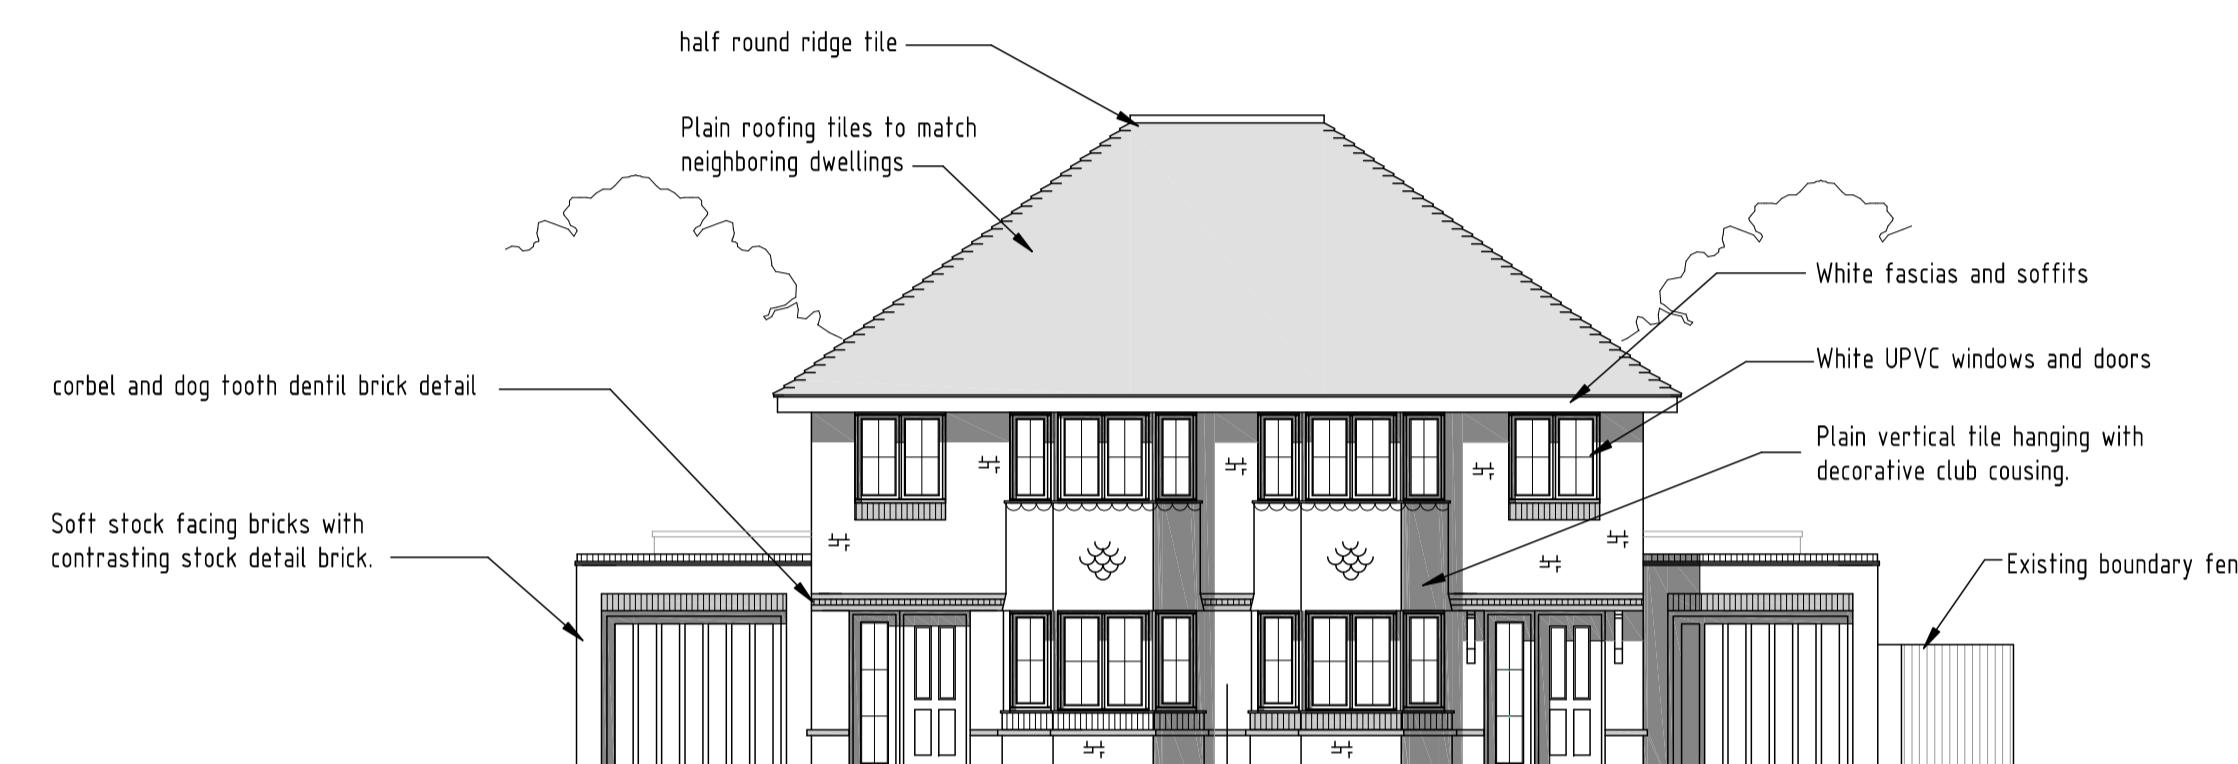


FRONT ELEVATION

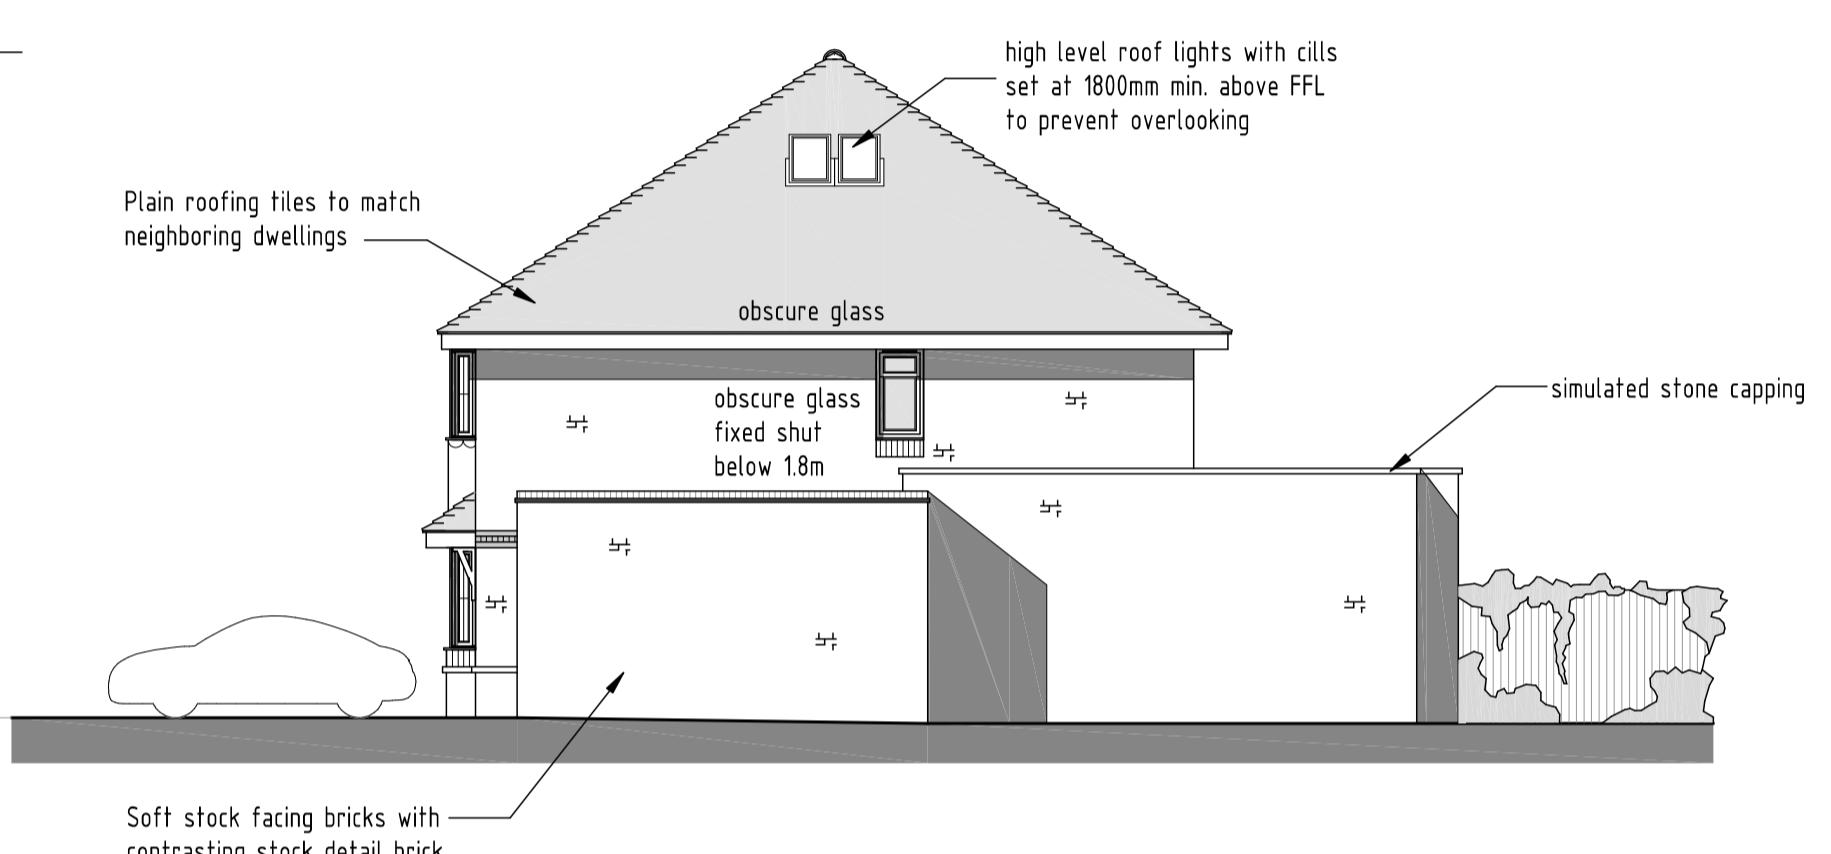


SIDE ELEVATION

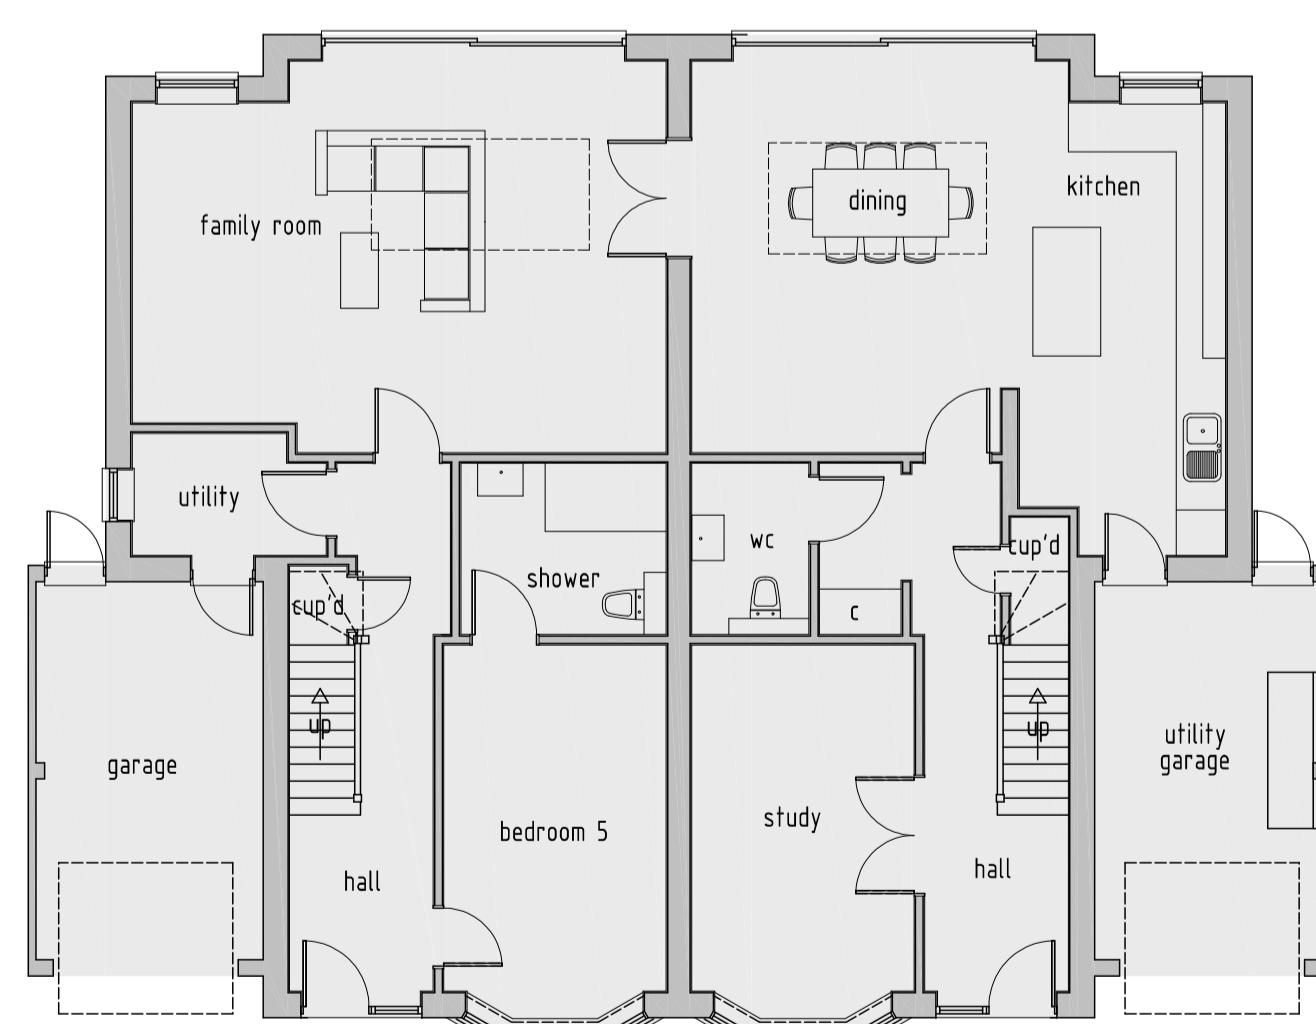

GROUND FLOOR PLAN

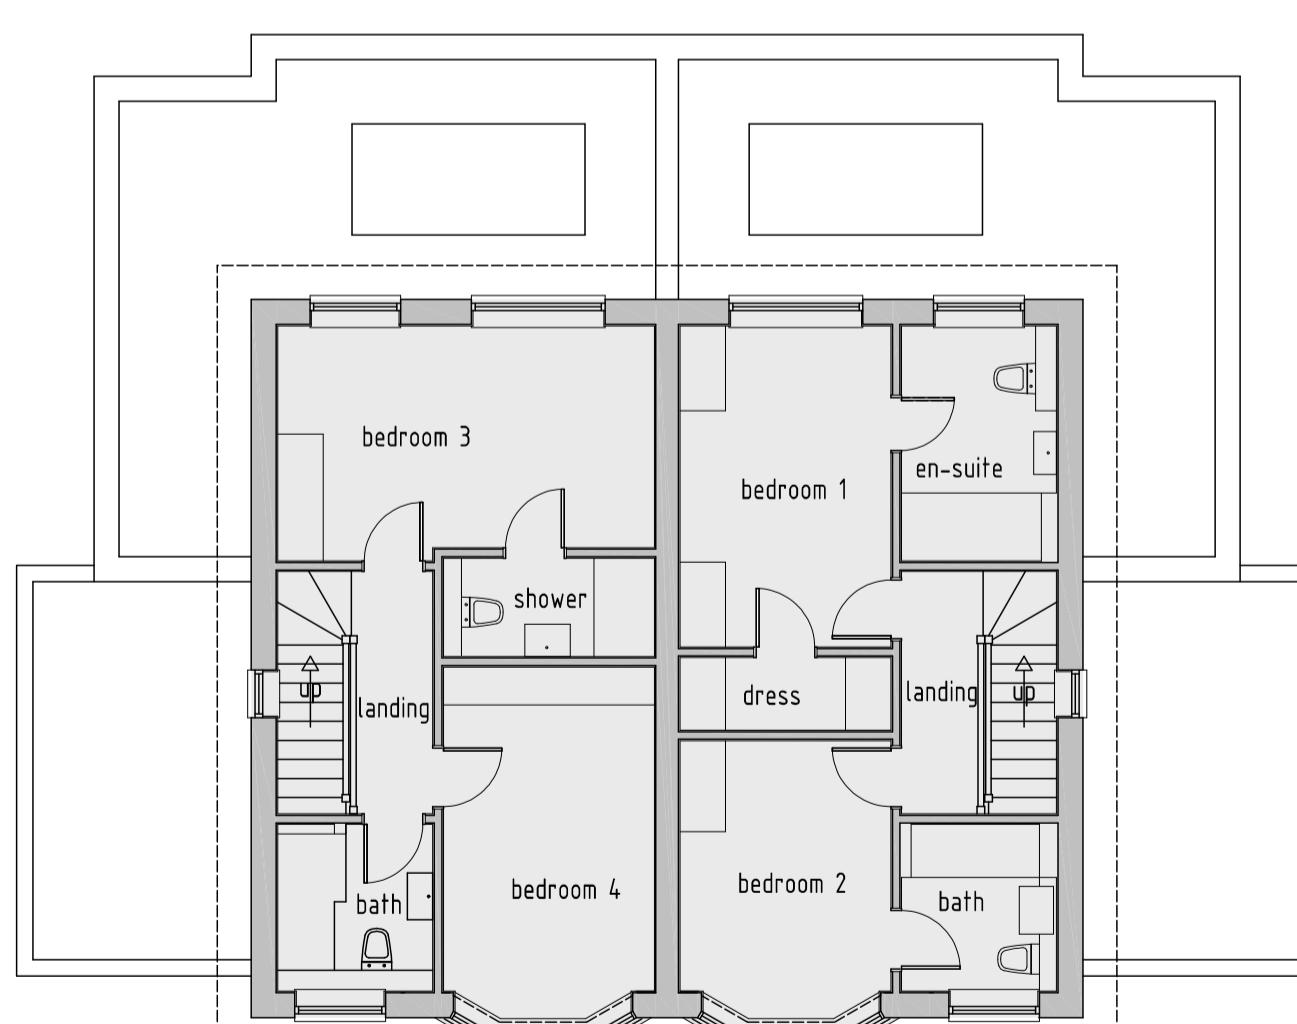


FIRST FLOOR PLAN

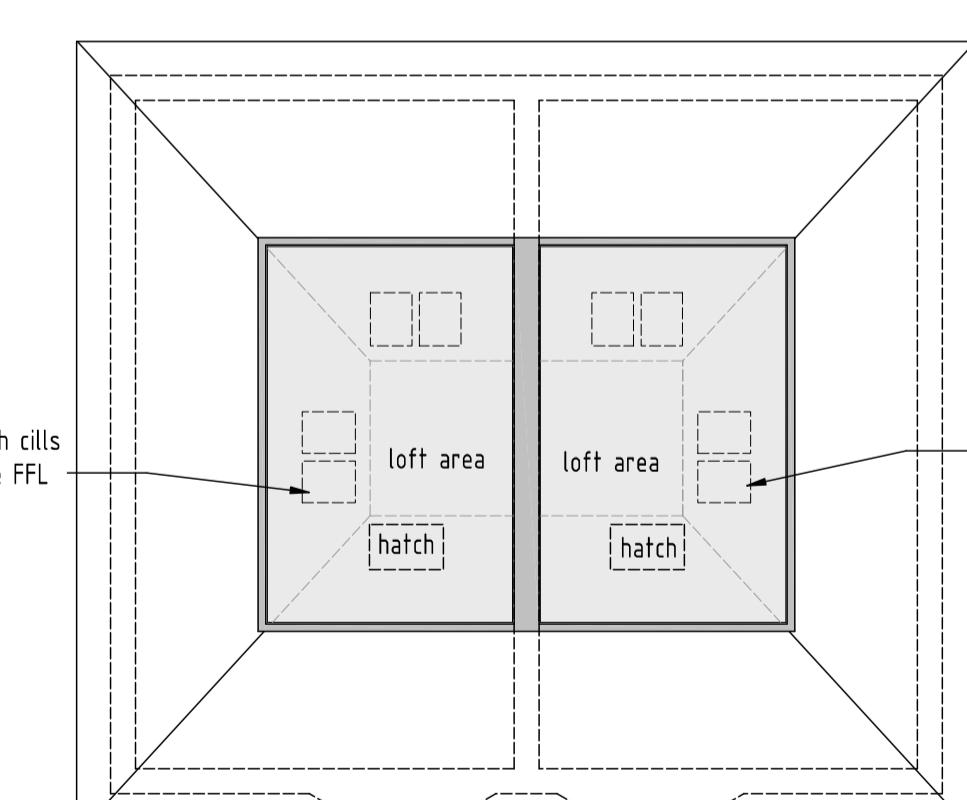

ROOF PLAN

SCALE BAR (m)

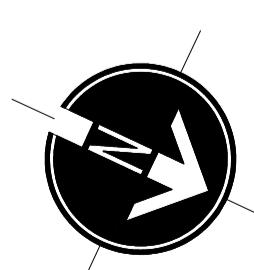

A 16-01-2024 Reference to porch omitted.

GIA - 2NO. 1293 ft² + GARAGE & LOFT 335ft²

rev: date: description:

scale: 1:100 A1 date: 08-11-2023

drawing no: 1267 / P5 / 2 A drawn: AT

drawing:

AS BUILT

FLOOR PLANS AND ELEVATIONS

project: 2 RAISINS HILL
EASTCOTE, MIDDLESEX HA52BS

client: MR SUNDIP SHAH

DDA

DUSEK DESIGN ASSOCIATES LTD
ARCHITECTURE + PLANNING01895 831 103
info@dusek.co.uk
www.dusek.co.uk

print history: Tuesday, 16 January, 2024 10:36:14

C:\Users\ANDY\DATA\OneDrive - Documents\GUSEK\DWG\051-0001\2 RAISINS HILL\PS\01-P5-1 - PSCH ADDED.dwg