

NOTES

1. All dimensions are to be checked on site prior to the commencement of work and any discrepancy is to be reported to the construction manager before construction.

2. All work is to comply with current Building Regulations and allied legislation.


3. All contractors and sub-contractors must ensure that they have the latest issue of this drawing and details before the commencement of work on site.

4. All materials are to be used and installed in strict compliance with the relevant manufacturers instructions and recommendations.

5. All works on site, managed and implemented as a result of the designs indicated on this drawing, are to be given full consideration for compliance with the Health and Safety CDM Regulations in respect of design and implementation on site and no works are to be undertaken if it is considered that compliance with the Building Regulations cannot be achieved.

6. All dimensions shown in millimetres.

7. Footprint of buildings shown at 10m above ground level.

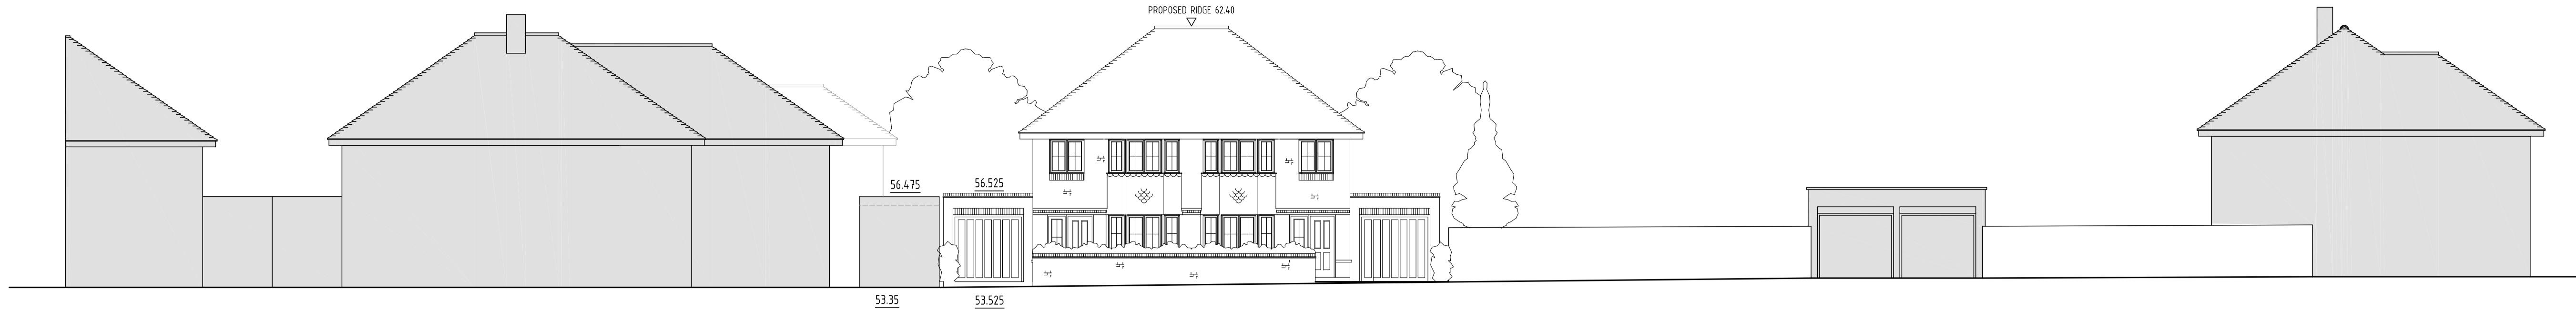

NO 8

NO 6 & 4




2 RAISINS HILL

EXISTING GARAGE

FLANK OF NO 41-42

STREET SCENE ALONG RAISINS HILL SCALE 1:125

SCALE BAR (m)
0 2.5 5 7.5 10 12.5

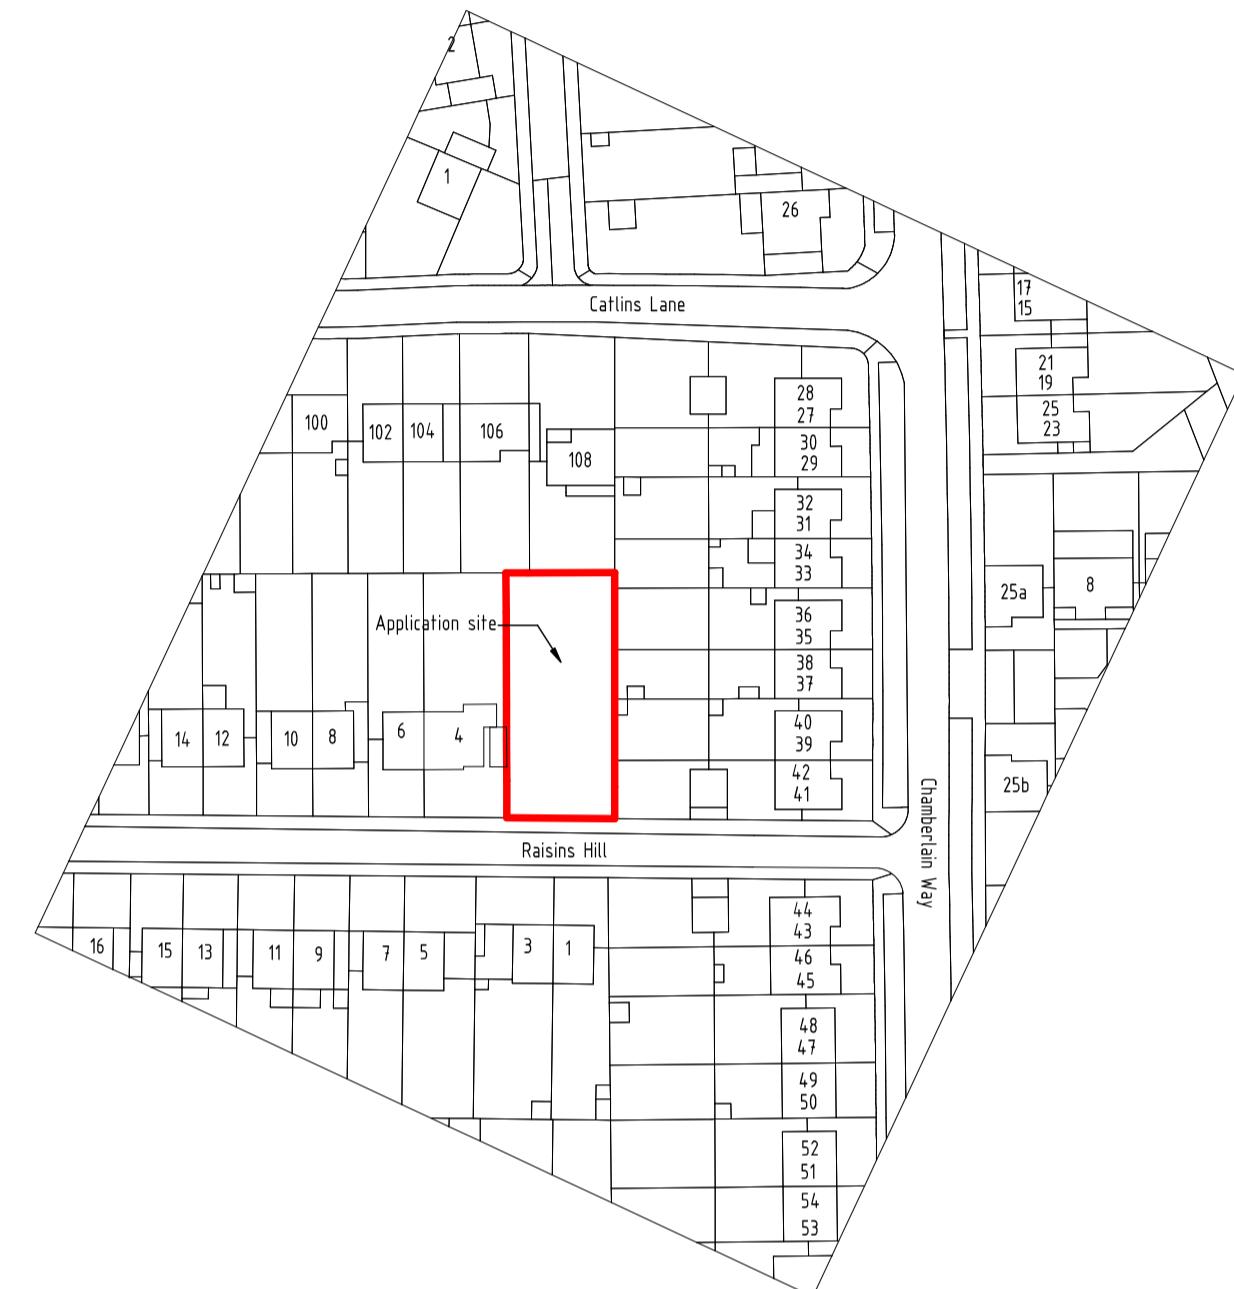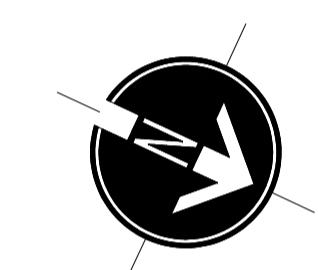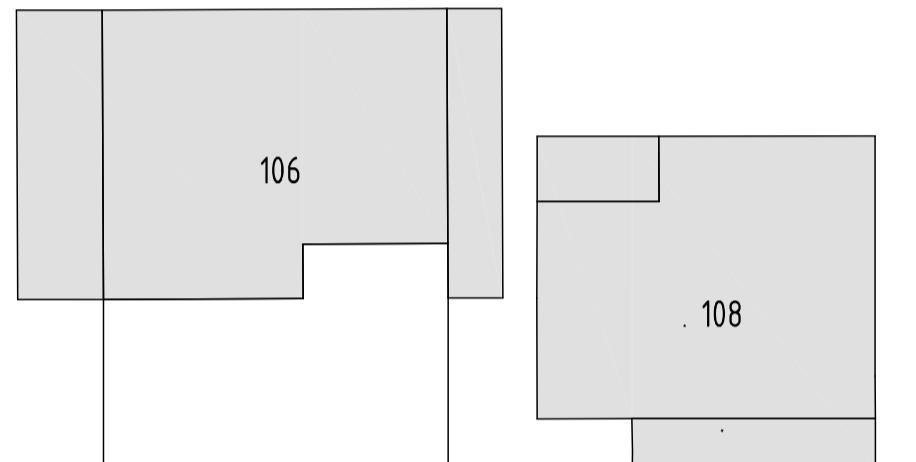SITE LOCATION PLAN
SCALE 1:1250

(c) UKMap Copyright. The GeoInformation Group 2017 Licence No. LANDMLON100003121118

SCALE BAR (m)

0 25 50 75 100 125

A 04-01-2024 Existing electric car charge points indicated along with cycle storage to sheds in rear garden.

SITE AREA - 0.068 HECTARES

rev: date: description:
scale: 1:250 A1 date: 08-11-2023
drawing no: 1267-P5-1 A drawn: AT

drawing: AS BUILT
SITE LAYOUT AND LOCATION PLAN



project: 2 RAISINS HILL, EASTCOTE
MIDDLESEX HA52BS

client: MR SUNDIP SHAH

DDA

DUSEK DESIGN ASSOCIATES LTD
ARCHITECTURE + PLANNING

01895 831 103
info@dusek.co.uk
www.dusek.co.uk

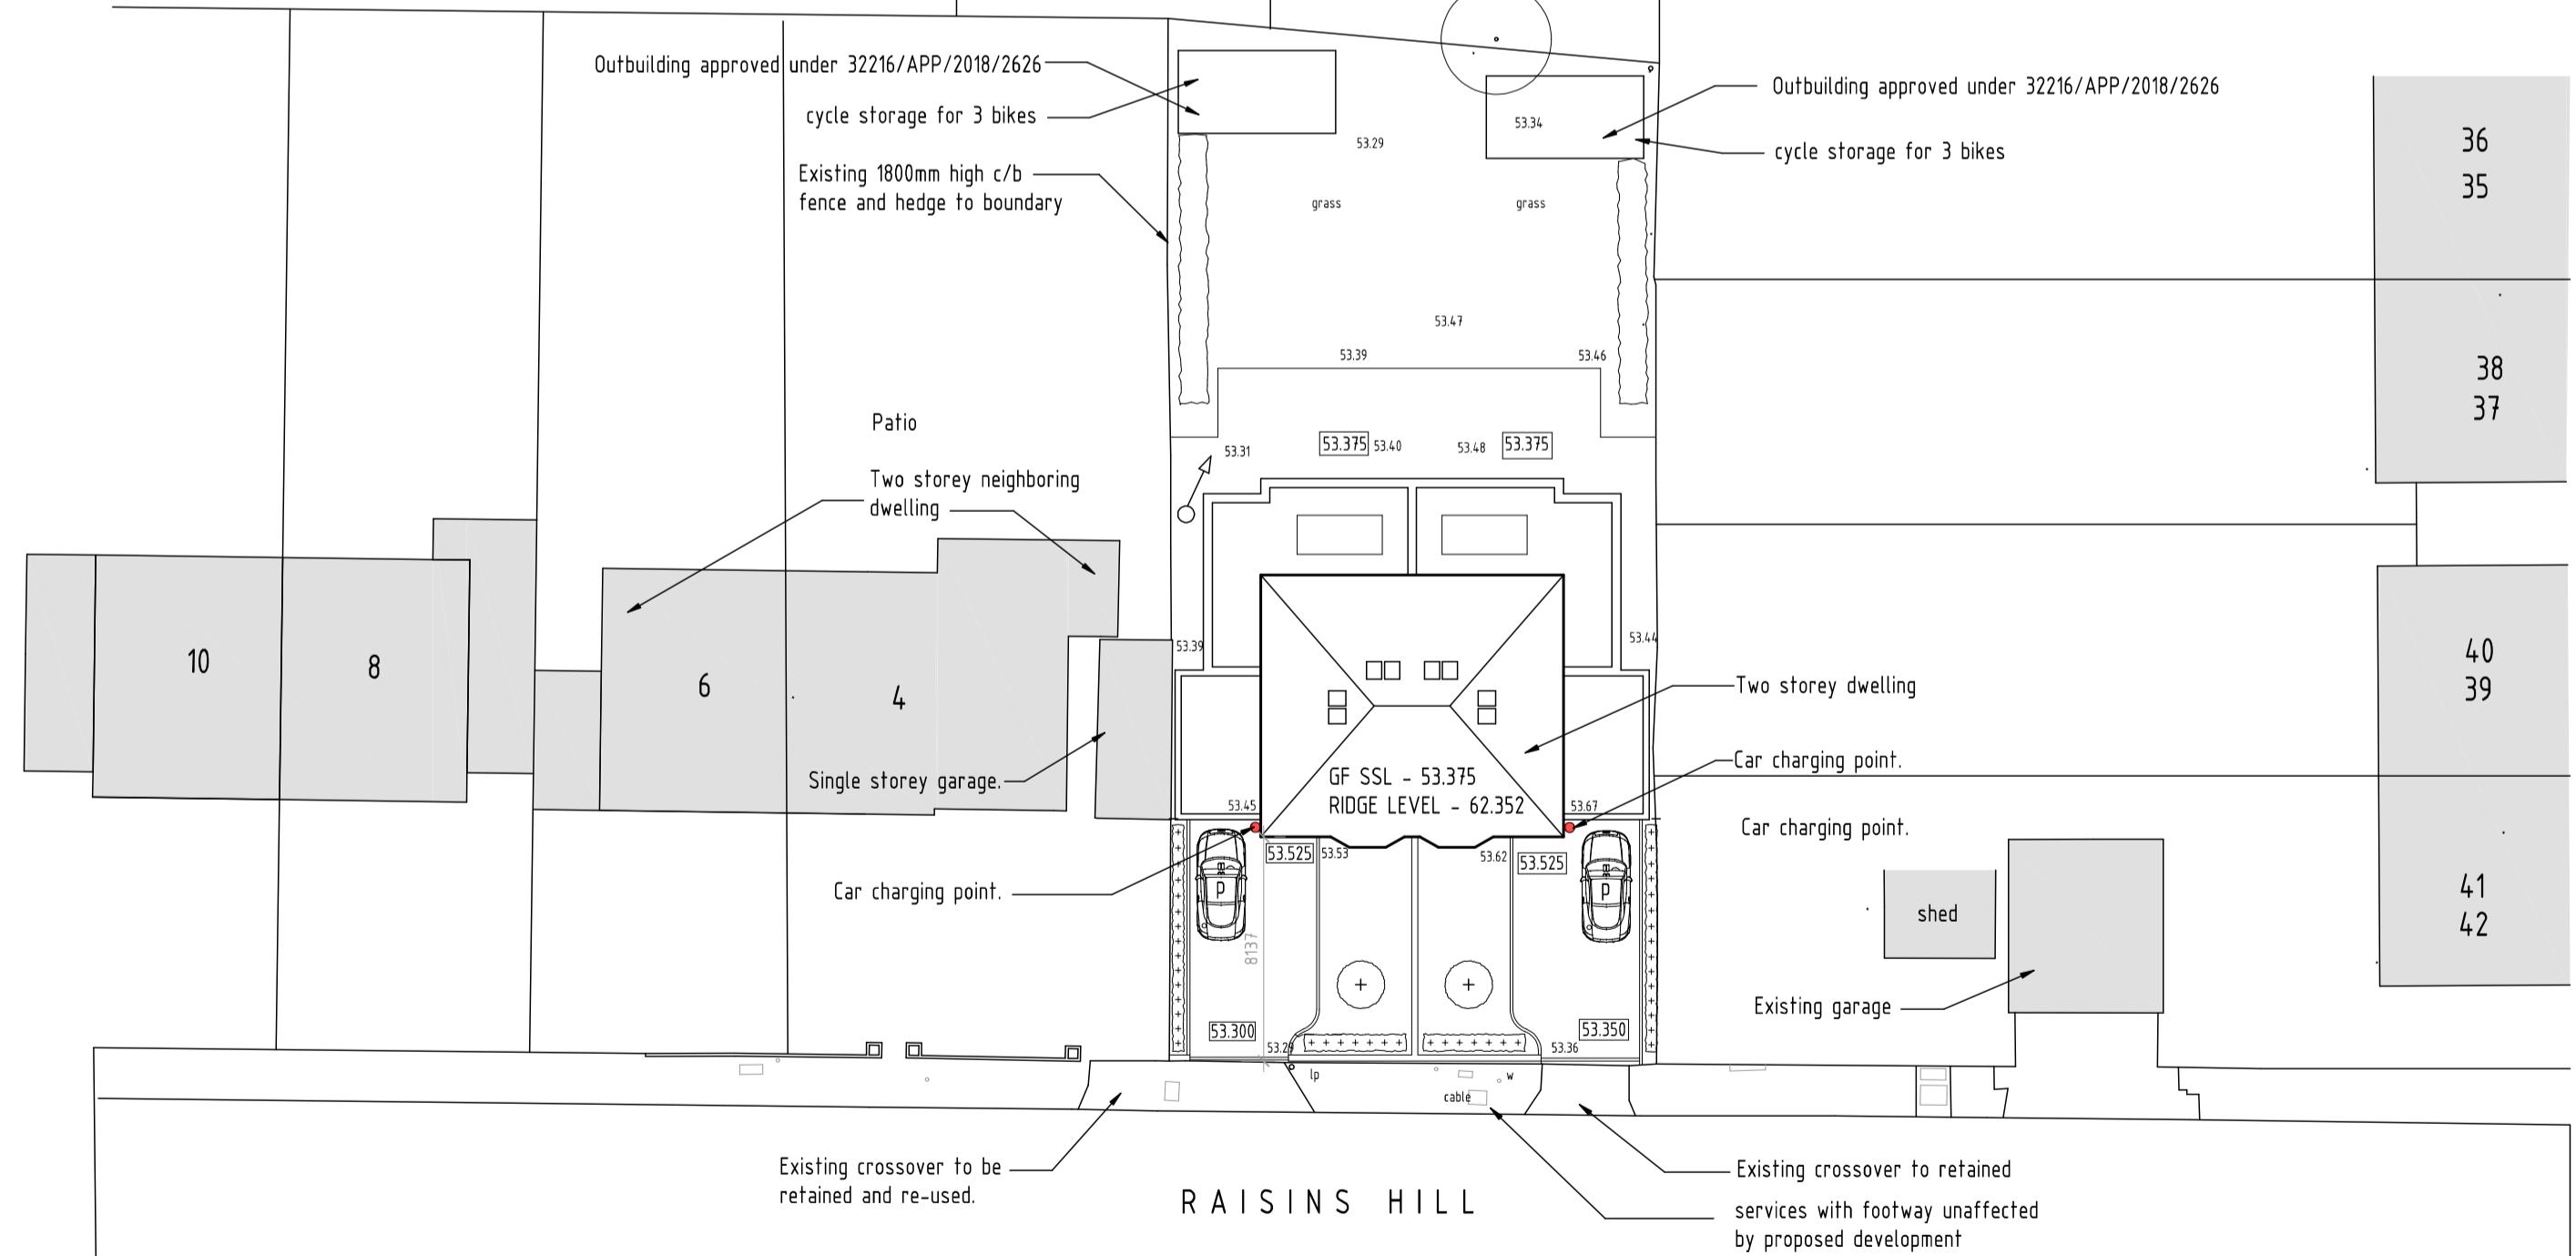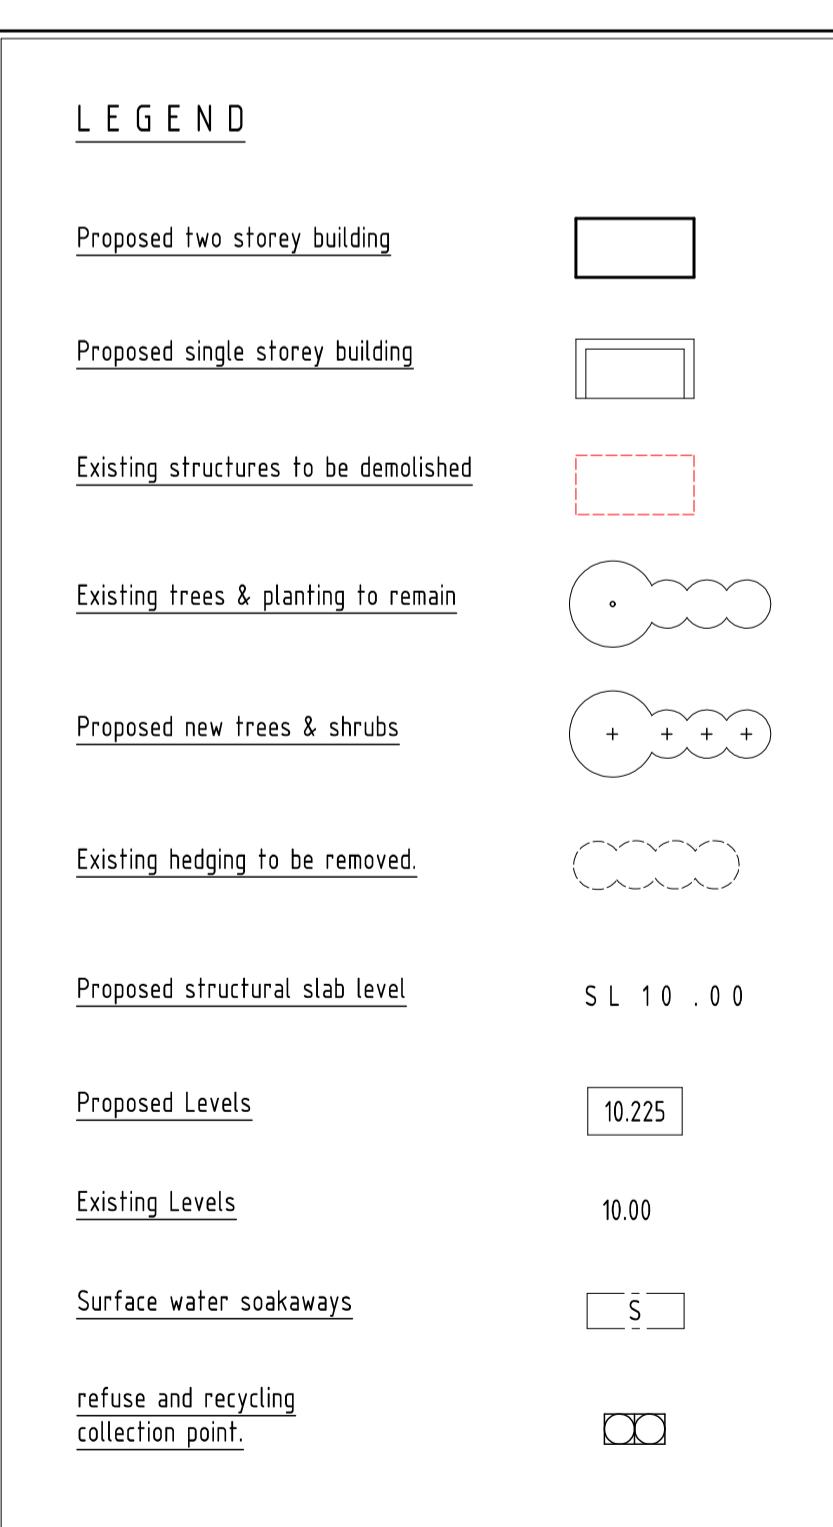

SITE LAYOUT PLAN SCALE 1:250

SCALE BAR (m)
0 5 10 15 20 25

SCALE BAR (m)

0 5 10 15 20 25

print history: Thursday, 4 January, 2024 12:16:46

C:\Users\ANDY\DATA\Team - Documents\1267\DWG\1267-1267-1 - 2 RAISINS HILL\1267-P5-1 - PROCH ADE52.dwg