


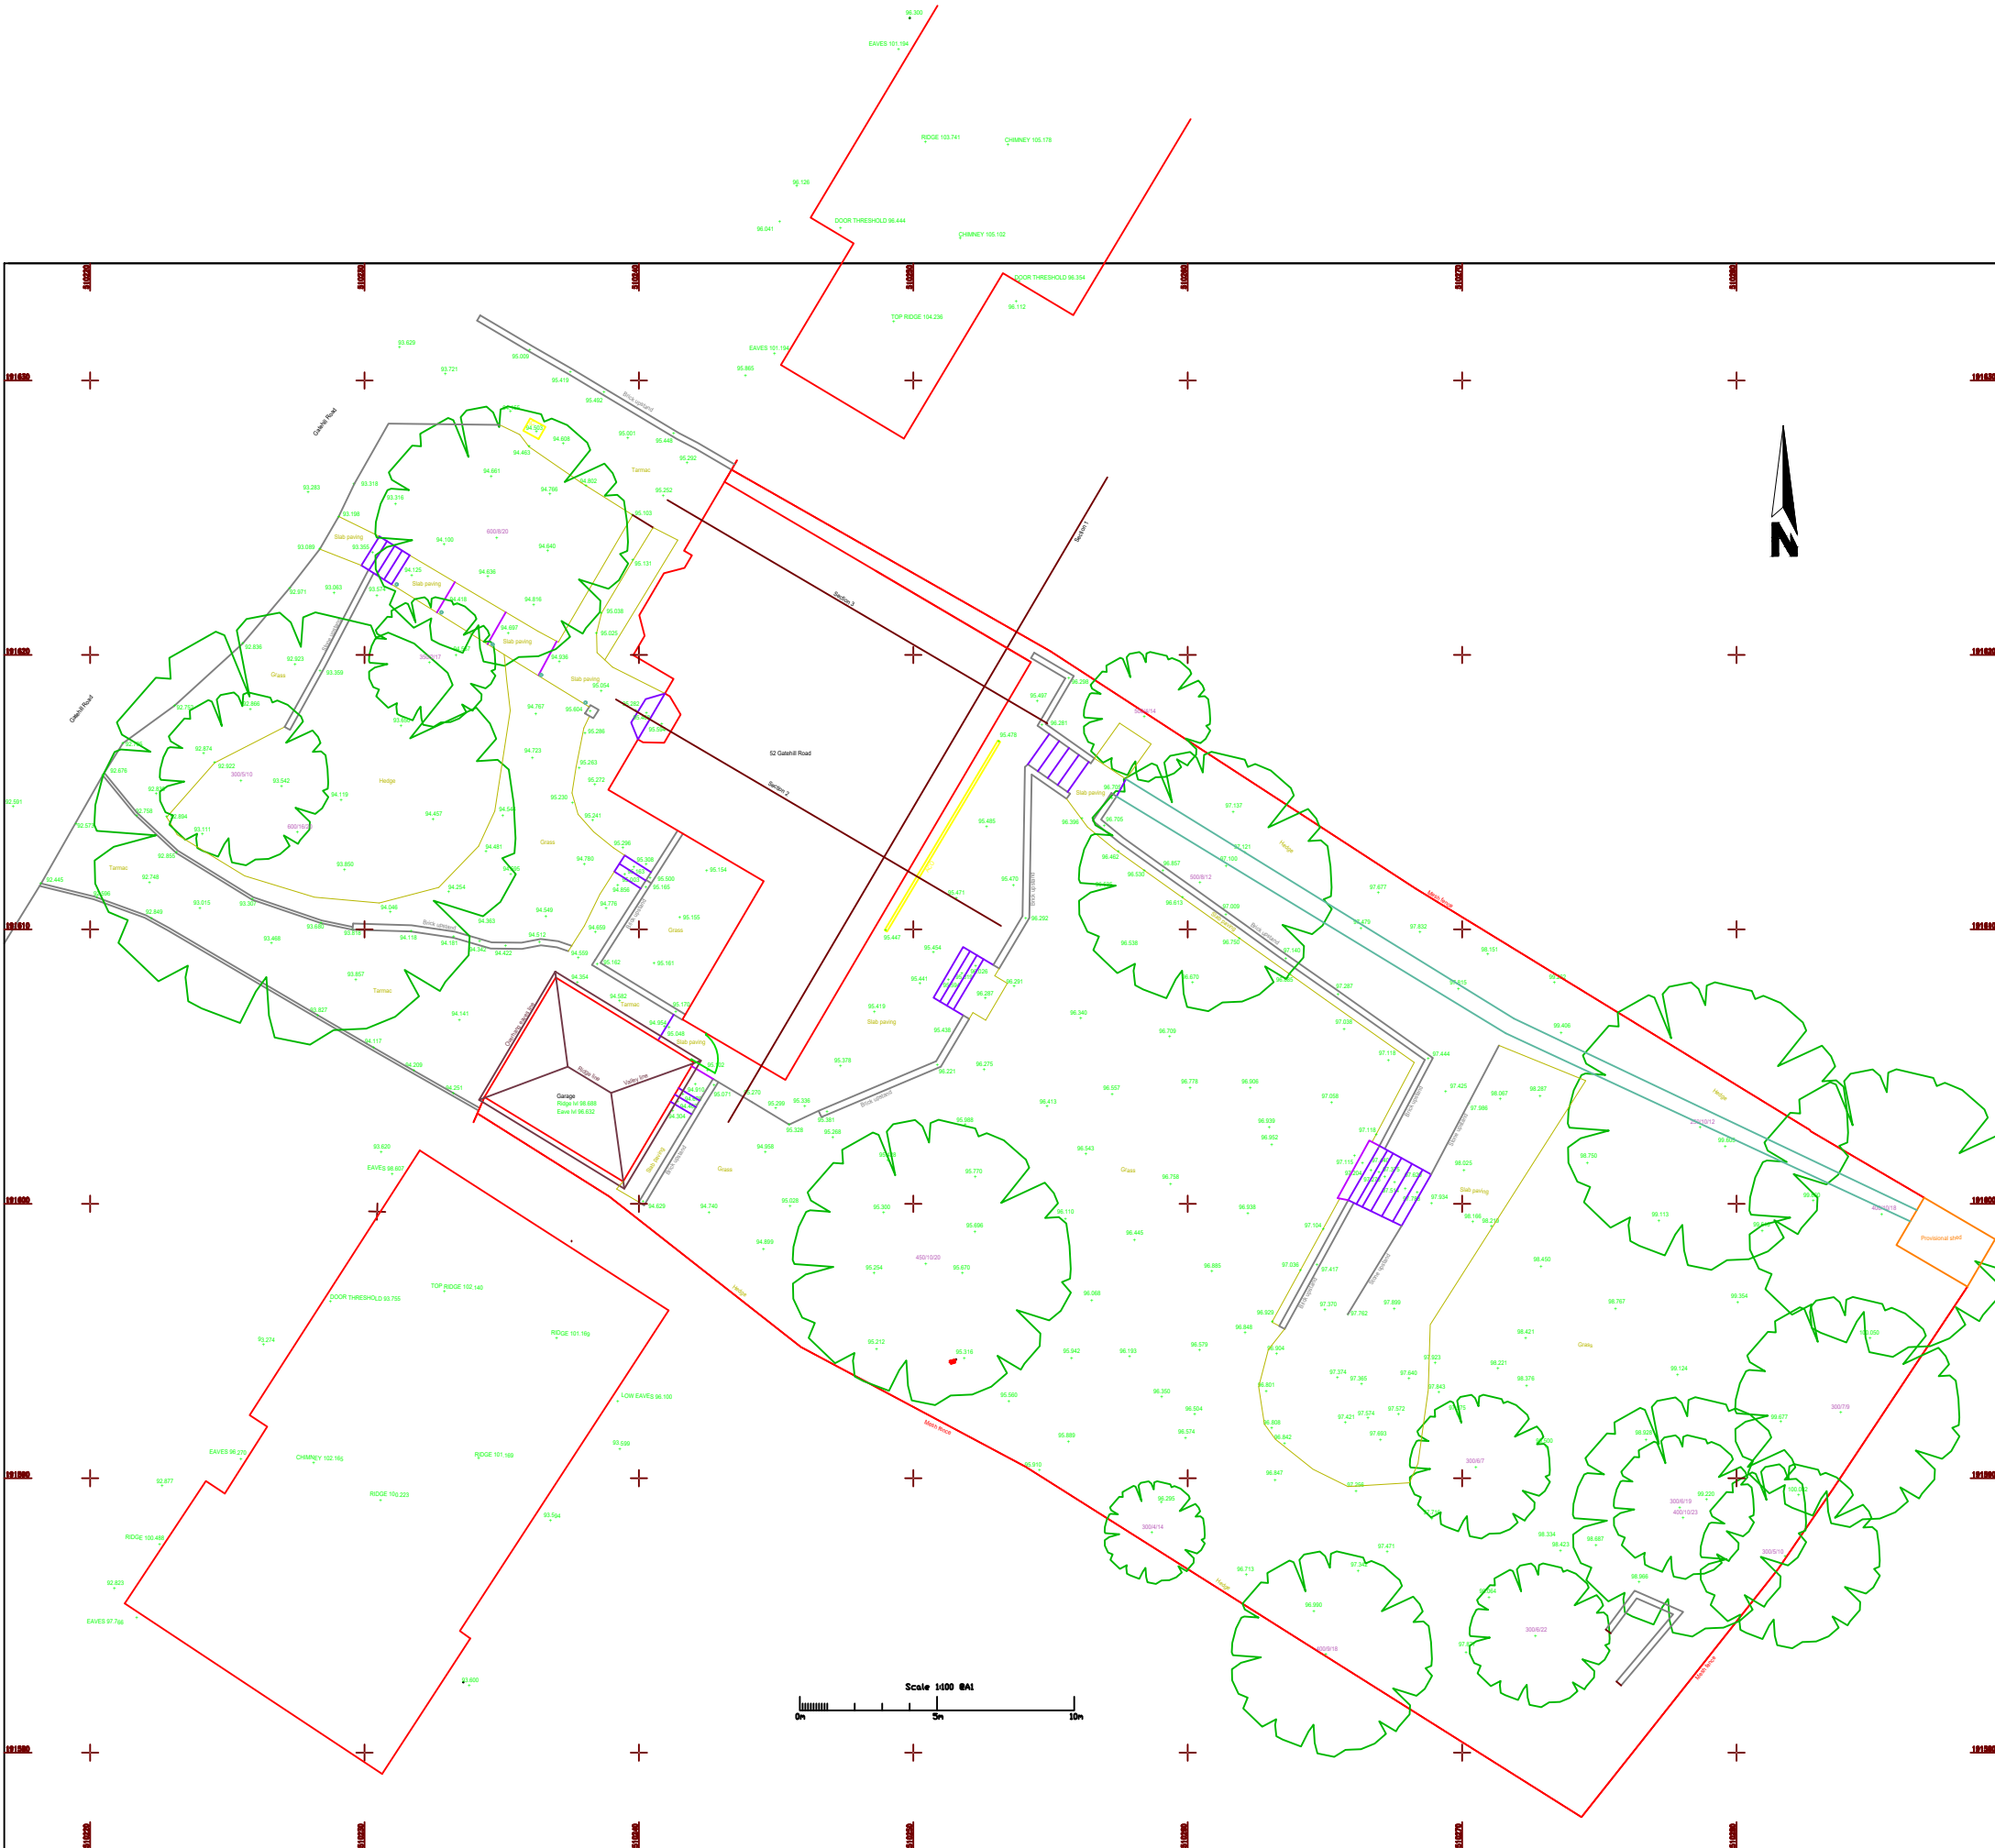

NOTES

Levels relate to a GPS derived datum.
Control established using Ordnance Survey's Active GPS Network OSG832.

DRAWING REFERENCE

Topographic Survey	10100.01
Ground floor	10100.02
First floor	10100.03
Attic plan	10100.04
Elevations	10100.05
Sections	10500.06

ABBREVIATIONS

B	Bollard
BC	Barrier Control
BT	British Telecom
ER	Earth Rod
FH	Fire Hydrant
FL	Flood Light
FP	Flag Pole
IB	Illuminated Bollard
IC	Inspection Cover
JB	Junction Box
LP	Lamp Post
RWP	Rain Water Pipe
SV	Stop Valve
WV	Water Valve
UP	Utility pole
Fr.L	Frame Level
G.L	Gully Level
S.L	Sill Level
H.L	Head Level
A.V.	Air vent

150 / 6 / 6	Tree bole diameter (mm)
	Tree spread (m)
	Tree Height (m)

LEGEND

Services	Yellow line
Step	Purple line
Surface change line	Orange line
Building	Red outline
Footpath	Blue line
Gate	Green line
Handrail	Light blue line
Kerb/upstand	Dark blue line
Landscape detail	Light green line
Plinth	Yellow line
Ramp	Red line
Roof detail	Dark red line
Stairs	Orange line
Structure	Red outline
Trees	Green outline

Topo M Surveys LTD
45
Carnegie House
Harrow
HA1 2AX
Web : topomsurveys.co.uk
Tel: 07533568649

52 Gatehill Road
Northwood
Harrow
HA6 3QP

Topographic Survey

surveyed MM/CC	drawn MM	checked MM
Scale	1:100	Date: JUNE 2021
Revisions		
		10100.01