


NOTES  
All dimensions must be checked on site and not scaled from this drawing.

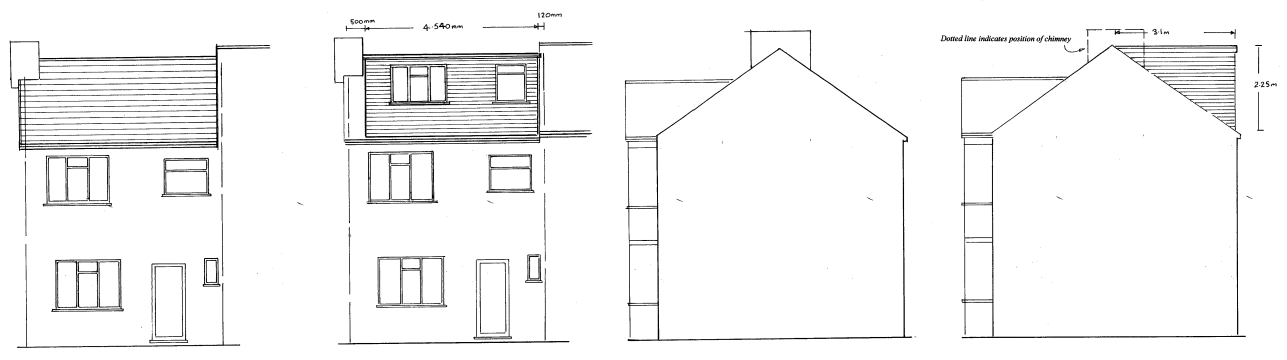


ORIGINAL REAR ELEVATION

REAR ELEVATION (AS BUILT)

ORIGINAL CHIMNEY SIDE ELEVATION

CHIMNEY SIDE ELEVATION (AS BUILT)

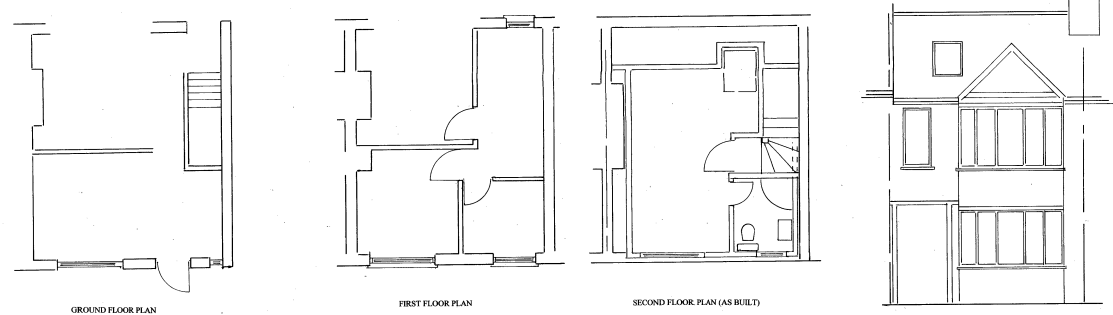


GROUND FLOOR PLAN

FIRST FLOOR PLAN

SECOND FLOOR PLAN (AS BUILT)

FRONT ELEVATION (AS BUILT)

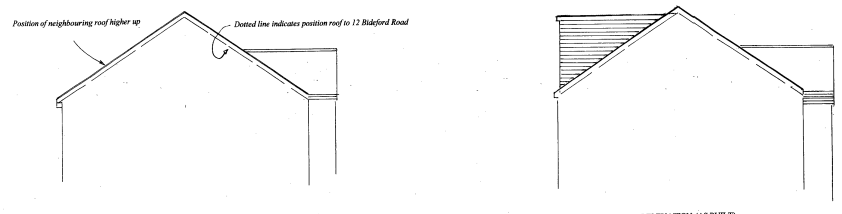

ORIGINAL SIDE ELEVATION

SIDE ELEVATION (AS BUILT)



| Revisions |      |
|-----------|------|
| A         | Date |

| Revisions |      |
|-----------|------|
| A         | Date |

Client MR T KENWAY

Job Title LOFT CONVERSION AT 12 BIDEFORD ROAD

Drawing Title ORIGINAL AND AS BUILT PLANS AND ELEVATIONS

Scale 1:50

Date July 04 Drawn by CSM

Dr No. TH 01/03 Rev. A