

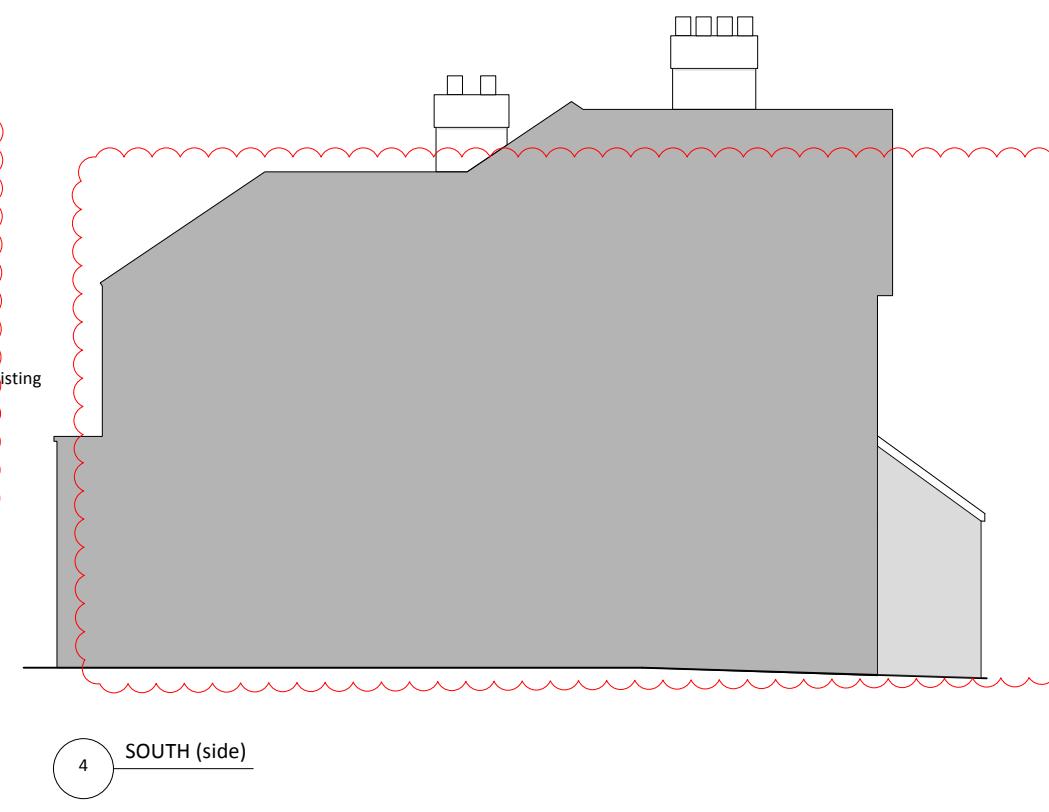
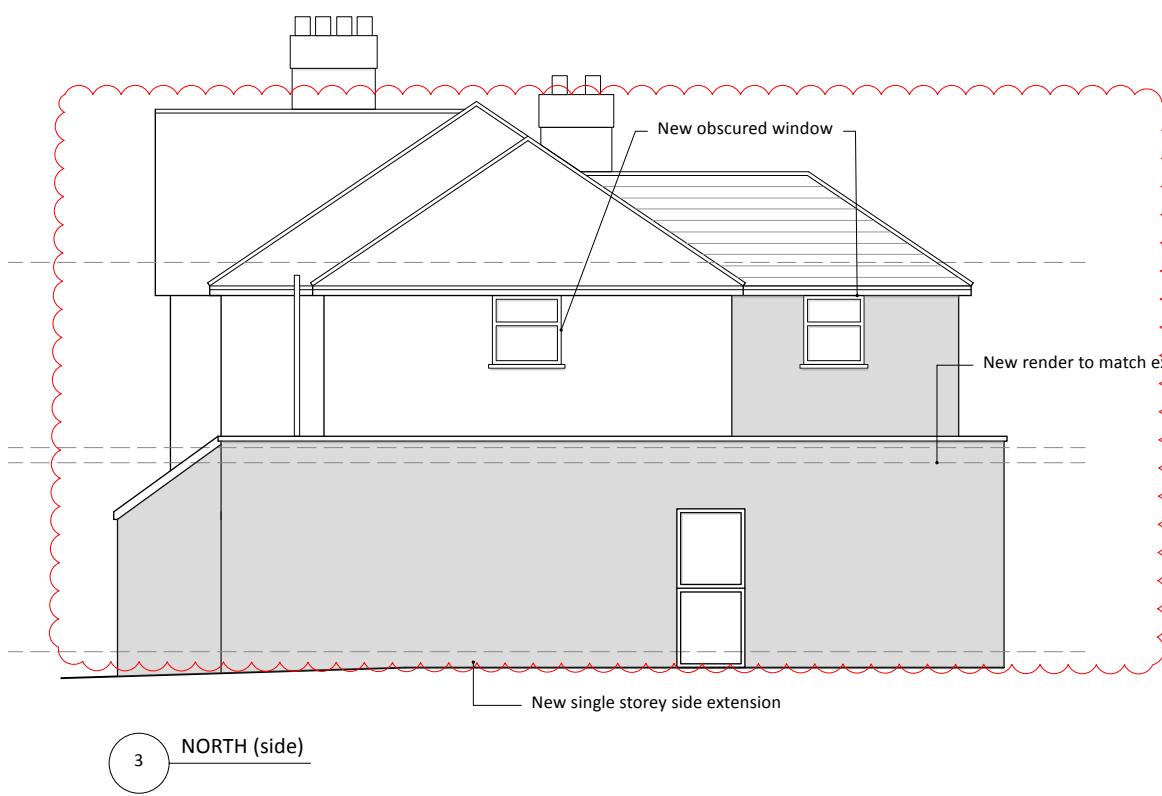


General Notes

1. New work shown shaded
2. Demolition shown dotted
3. W: Wardrobe
- Cpb: Cupboard
- RLA: Roof lantern above
- RL: Roof light/lantern below
4. All dimensions are indicative and in mm
5. If shown levels indicated in red dotted

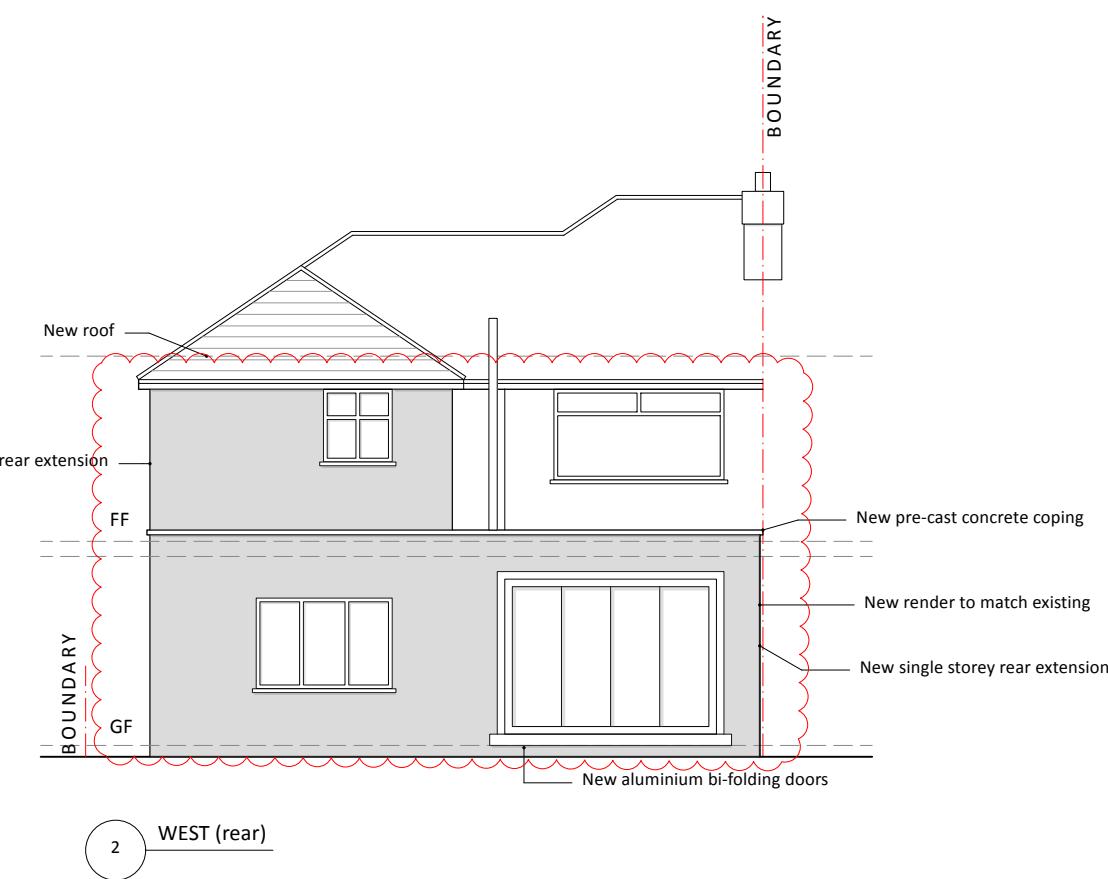

0.0 1.0 2.0 3.0 4.0 5.0 m

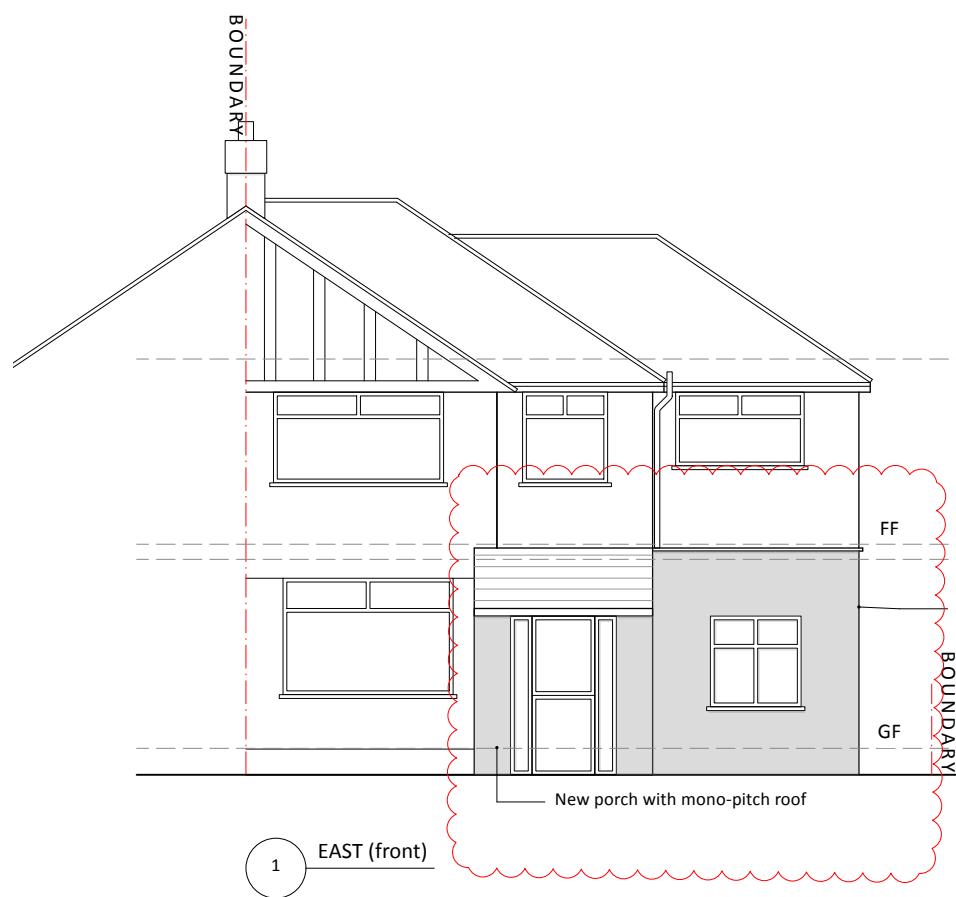

A 21/07/2025 Revisions as clouded
 ISSUE DATE REVISION

PROJECT 26 Mildred Avenue, Hayes, UB3 1TN

CLIENT Kiran Chakkal

DRAWING PROPOSED ELEVATIONS



All rights reserved in chapter IV of the copyright designs & patents act 1988 have been asserted. This drawing must not be scaled; only figured dimensions should be used. Check and verify all dimensions on site prior to commencing any work. Any discrepancies should be reported to the Architects immediately.

PROJECT # 2025.046 DWG # REV
 DATE 21/07/2025
 SCALE 1:100
 DRAWN JA CHKD JC
 C04-A

Stones Architects Ltd
 50 Coldharbour Lane Hayes Middlesex UB3 3EP
 t 020 8969 0000 e mail@stonesarchitects.co.uk w stonesarchitects.co.uk