
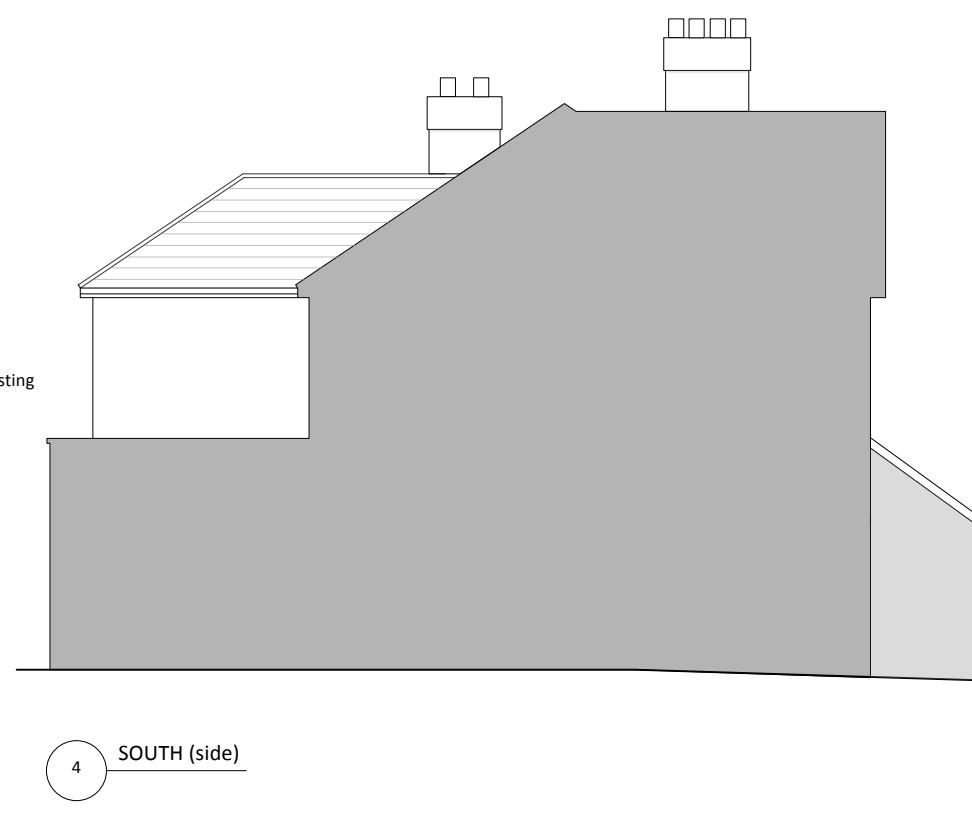
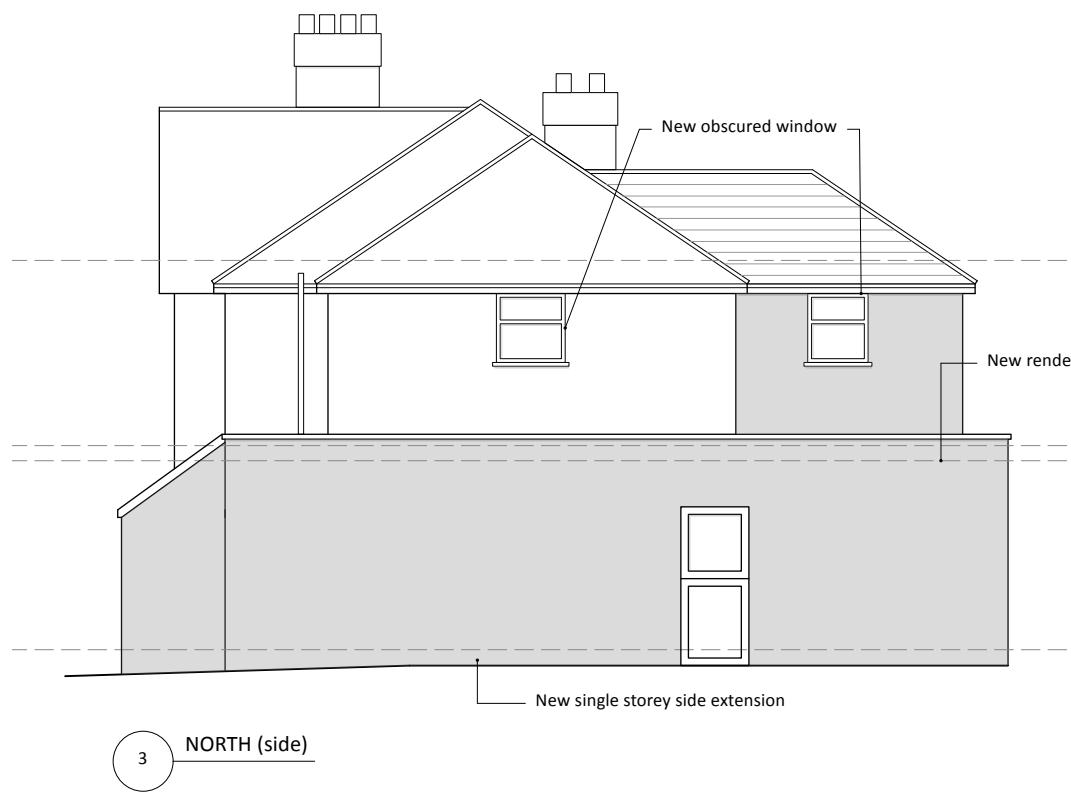
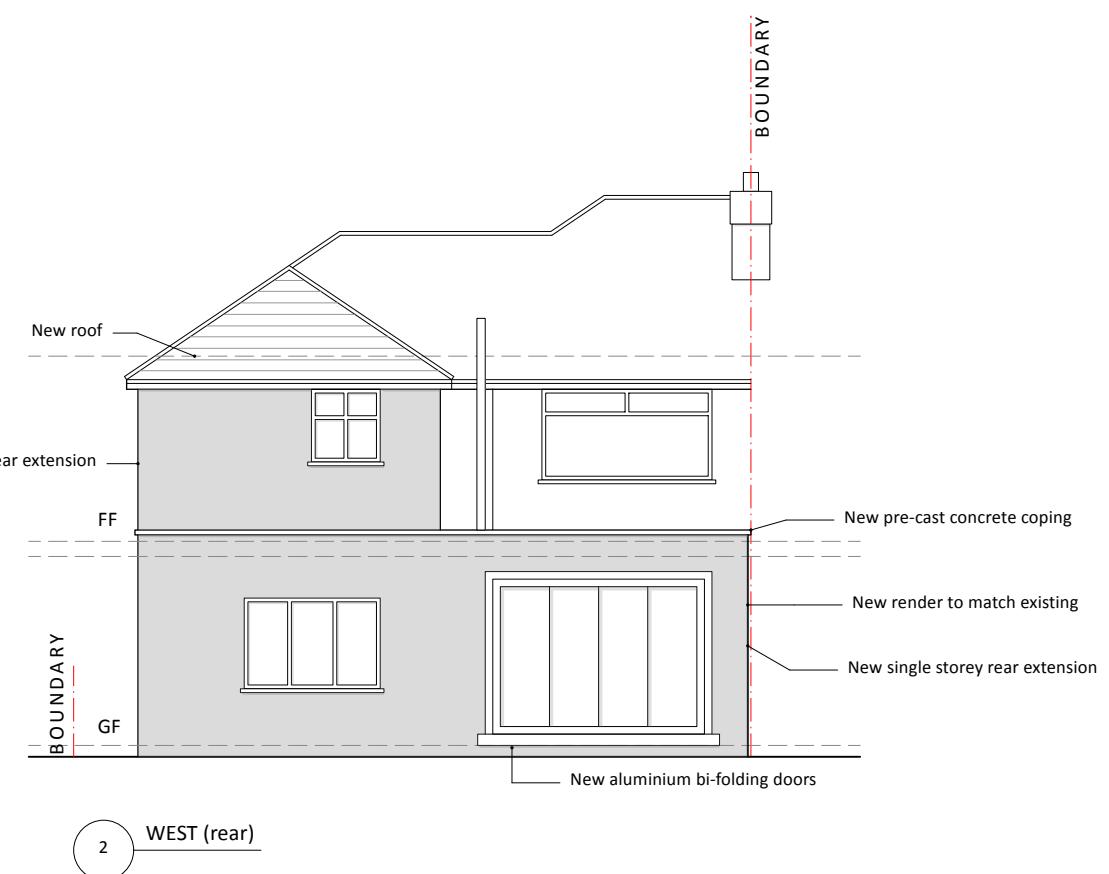


General Notes

1. New work shown shaded
2. Demolition shown dotted
3. W: Wardrobe
4. All dimensions are indicative and in mm
5. If shown levels indicated in red dotted

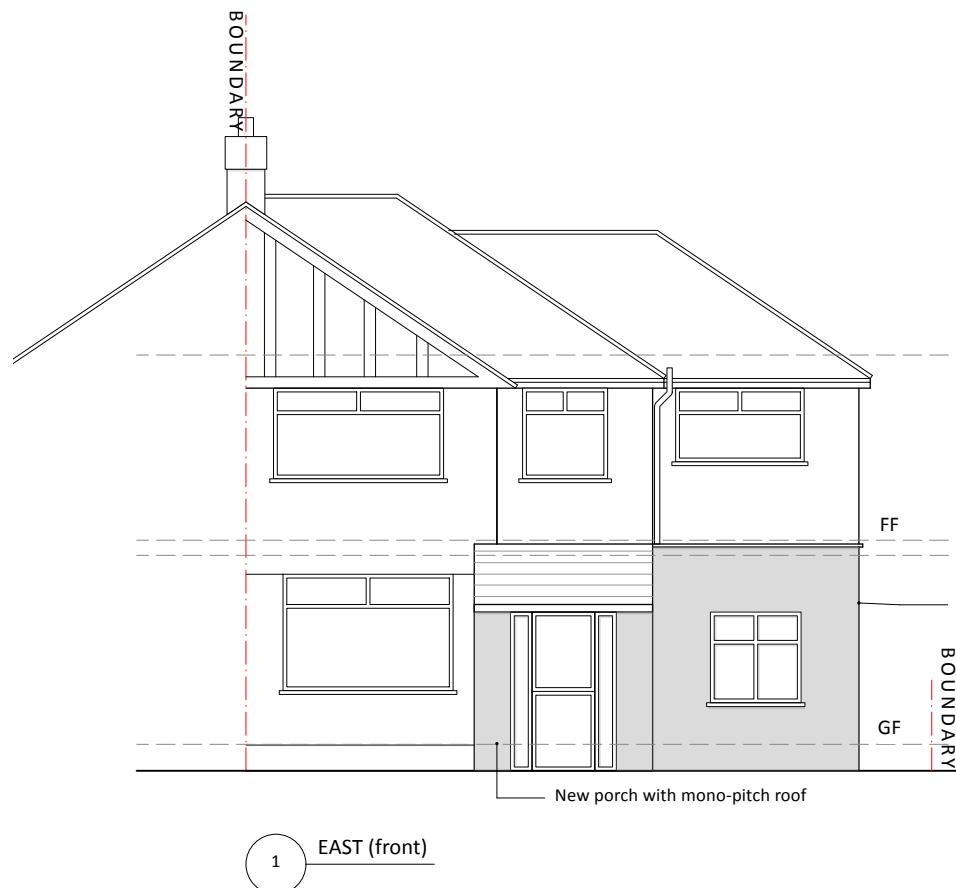

A 21/07/2025 Revisions as clouded  
 ISSUE DATE REVISION

PROJECT 26 Mildred Avenue, Hayes, UB3 1TN

CLIENT Kiran Chakkal


DRAWING PROPOSED ELEVATIONS



All rights described in chapter IV of the copyright designs & patents act 1988 have been asserted. This drawing must not be scaled; only figured dimensions should be used. Check and verify all dimensions on site prior to commencing any work. Any discrepancies should be reported to the Architects immediately.

PROJECT # 2025.046 DWG # REV  
 DATE 21/07/2025  
 SCALE 1:100  
 DRAWN JA CHKD JC  
 C04-A

0.0 1.0 2.0 3.0 4.0 5.0 m

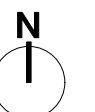

Stones Architects Ltd  
 50 Coldharbour Lane Hayes Middlesex UB3 3EP  
 t 020 8969 0000 e mail@stonesarchitects.co.uk w stonesarchitects.co.uk