



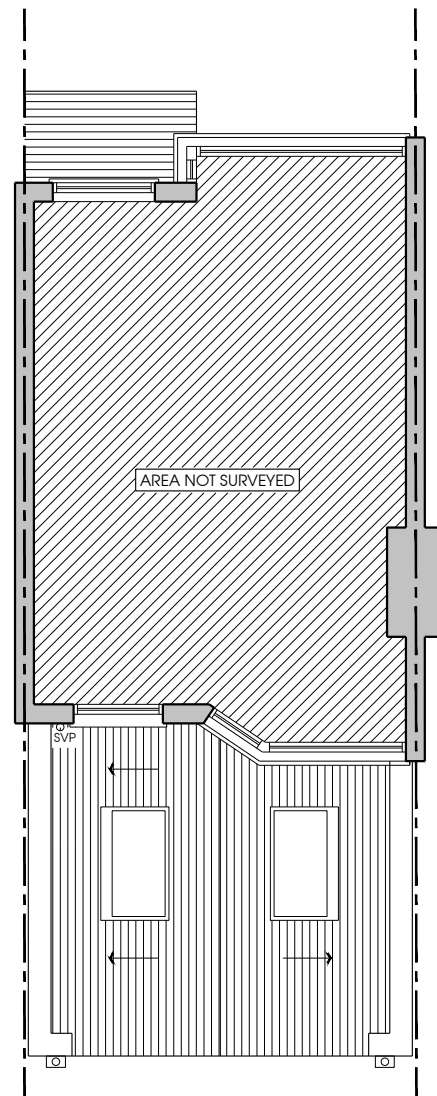

187 Carlton Avenue East, Wembley HA9 8GB
tel: 0203 3710259 mob: 07957 444257
email: info@rsdesigns.com web: www.rsdesigns.com

NOTES
THE CONTRACTORS ARE TO CHECK ALL DIMENSIONS, DRAIN RUNS AND GENERAL CONDITIONS ON THE SITE BEFORE WORK COMMENCEMENT, AND INFORM R S DESIGNS IMMEDIATELY UPON DISCOVERY OF ANY ERRORS, OMISSIONS OR DISCREPANCIES. ALL WORKS ARE TO BE CARRIED OUT IN ACCORDANCE WITH CURRENT BUILDING REGULATIONS, BRITISH STANDARDS, CODE OF PRACTICE AND LOCAL AUTHORITY REQUIREMENTS. DO NOT SCALE FROM THIS DRAWING WITHOUT FIRST OBTAINING WRITTEN AUTHORIZATION FROM R S DESIGNS.
THIS DRAWING IS THE PROPERTY OF R S DESIGNS AND IS ISSUED ON THE CONDITION THAT IT IS NOT REPRODUCED, DISCLOSED OR COPIED TO ANY UNAUTHORISED PERSON IN WHOLE OR PART WITHOUT PRIOR WRITTEN CONSENT.




SCALE 1:100
0 1000 2000 5000

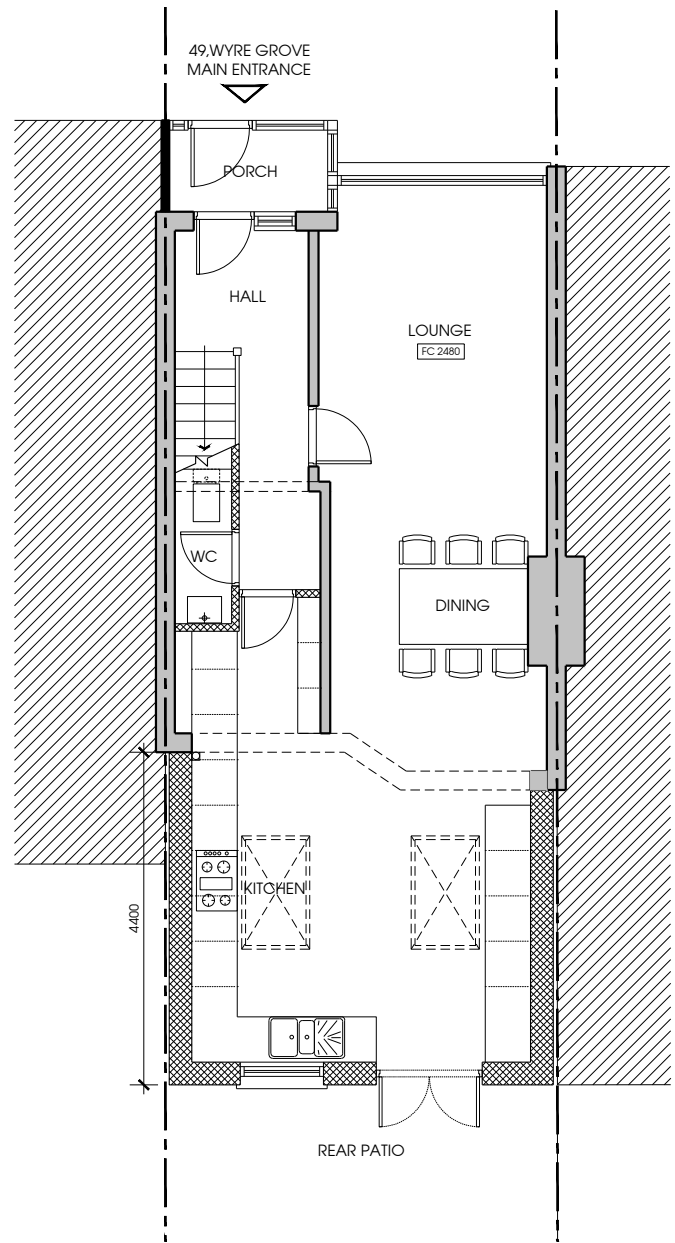

01 PROPOSED GROUND FLOOR PLAN
1 : 100

02 PROPOSED FIRST FLOOR PLAN
1 : 100

03 PROPOSED REAR ELEVATION
1 : 100

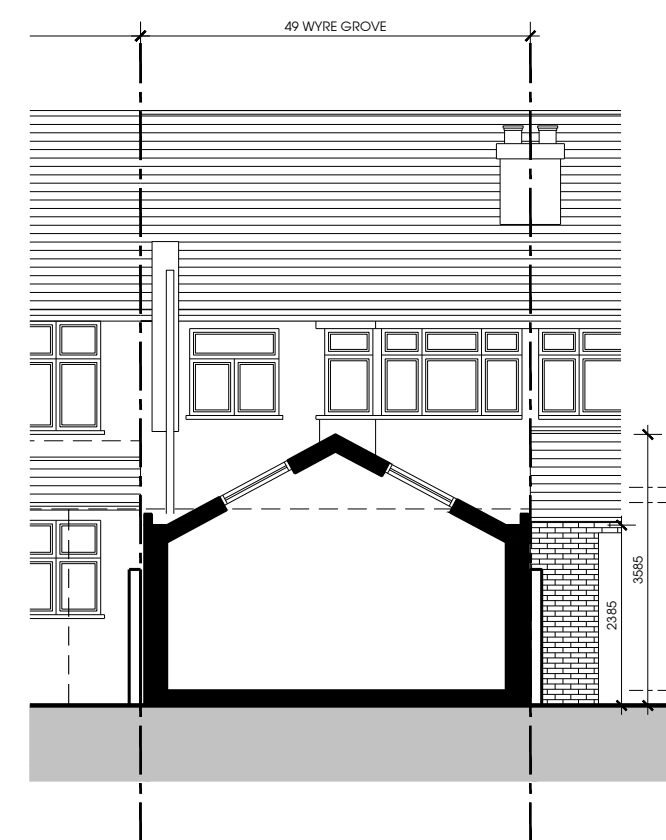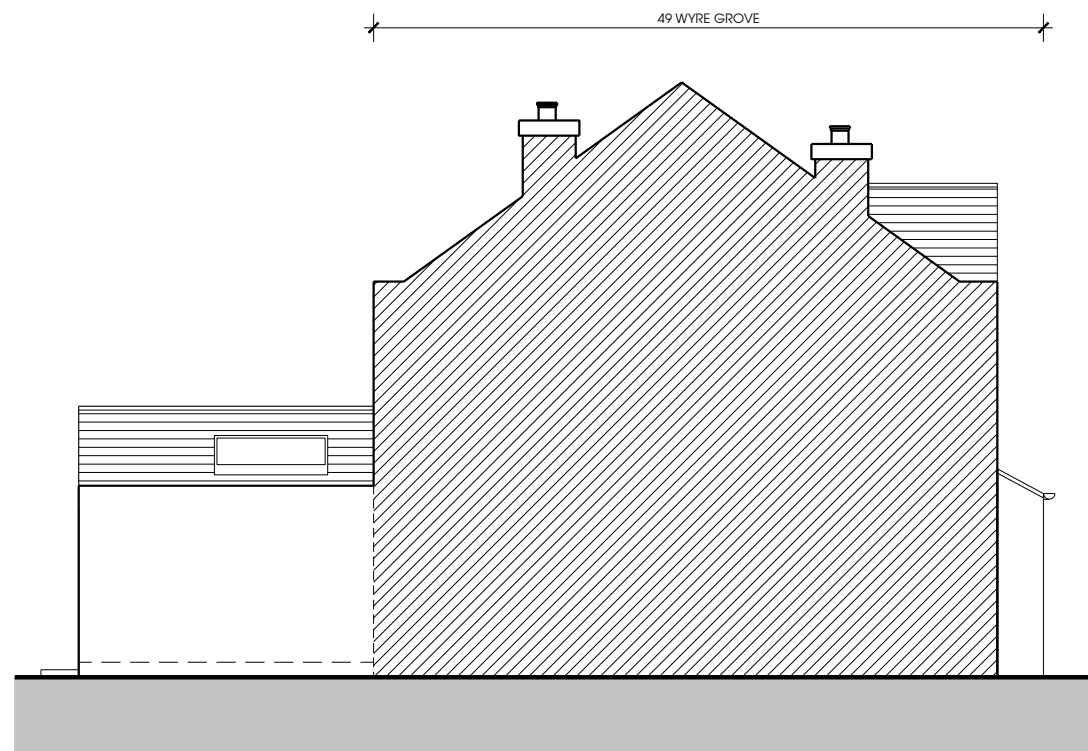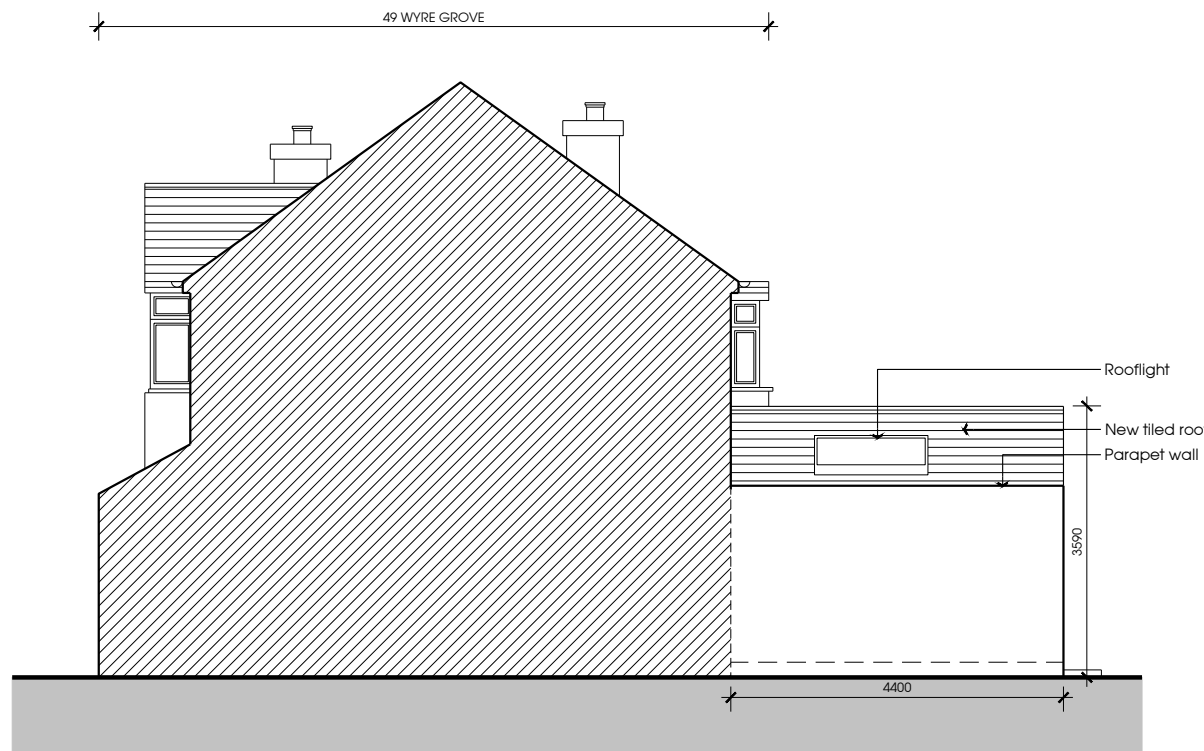

04 PROPOSED FLANK ELEVATION
1 : 100

05 PROPOSED FLANK ELEVATION
1 : 100

06 PROPOSED SECTION
1 : 100

A 19.11.18 Amended to As Built
REV: DATE: DESCRIPTION:

CLIENT:
MR P K RODA

PROJECT:
49 WYRE GROVE
HAYES
UB3 4PH

TITLE:
PROPOSED FLOOR PLANS
AND ELEVATIONS

SCALE: 1:100 @ A2 DATE: NOV. 2017

DRAWN: KM CHECKED: SP AUTHORIZED: SP

DRAWING No: RSD2352 - 100 REVISION: A

ISSUE:

PLANNING