

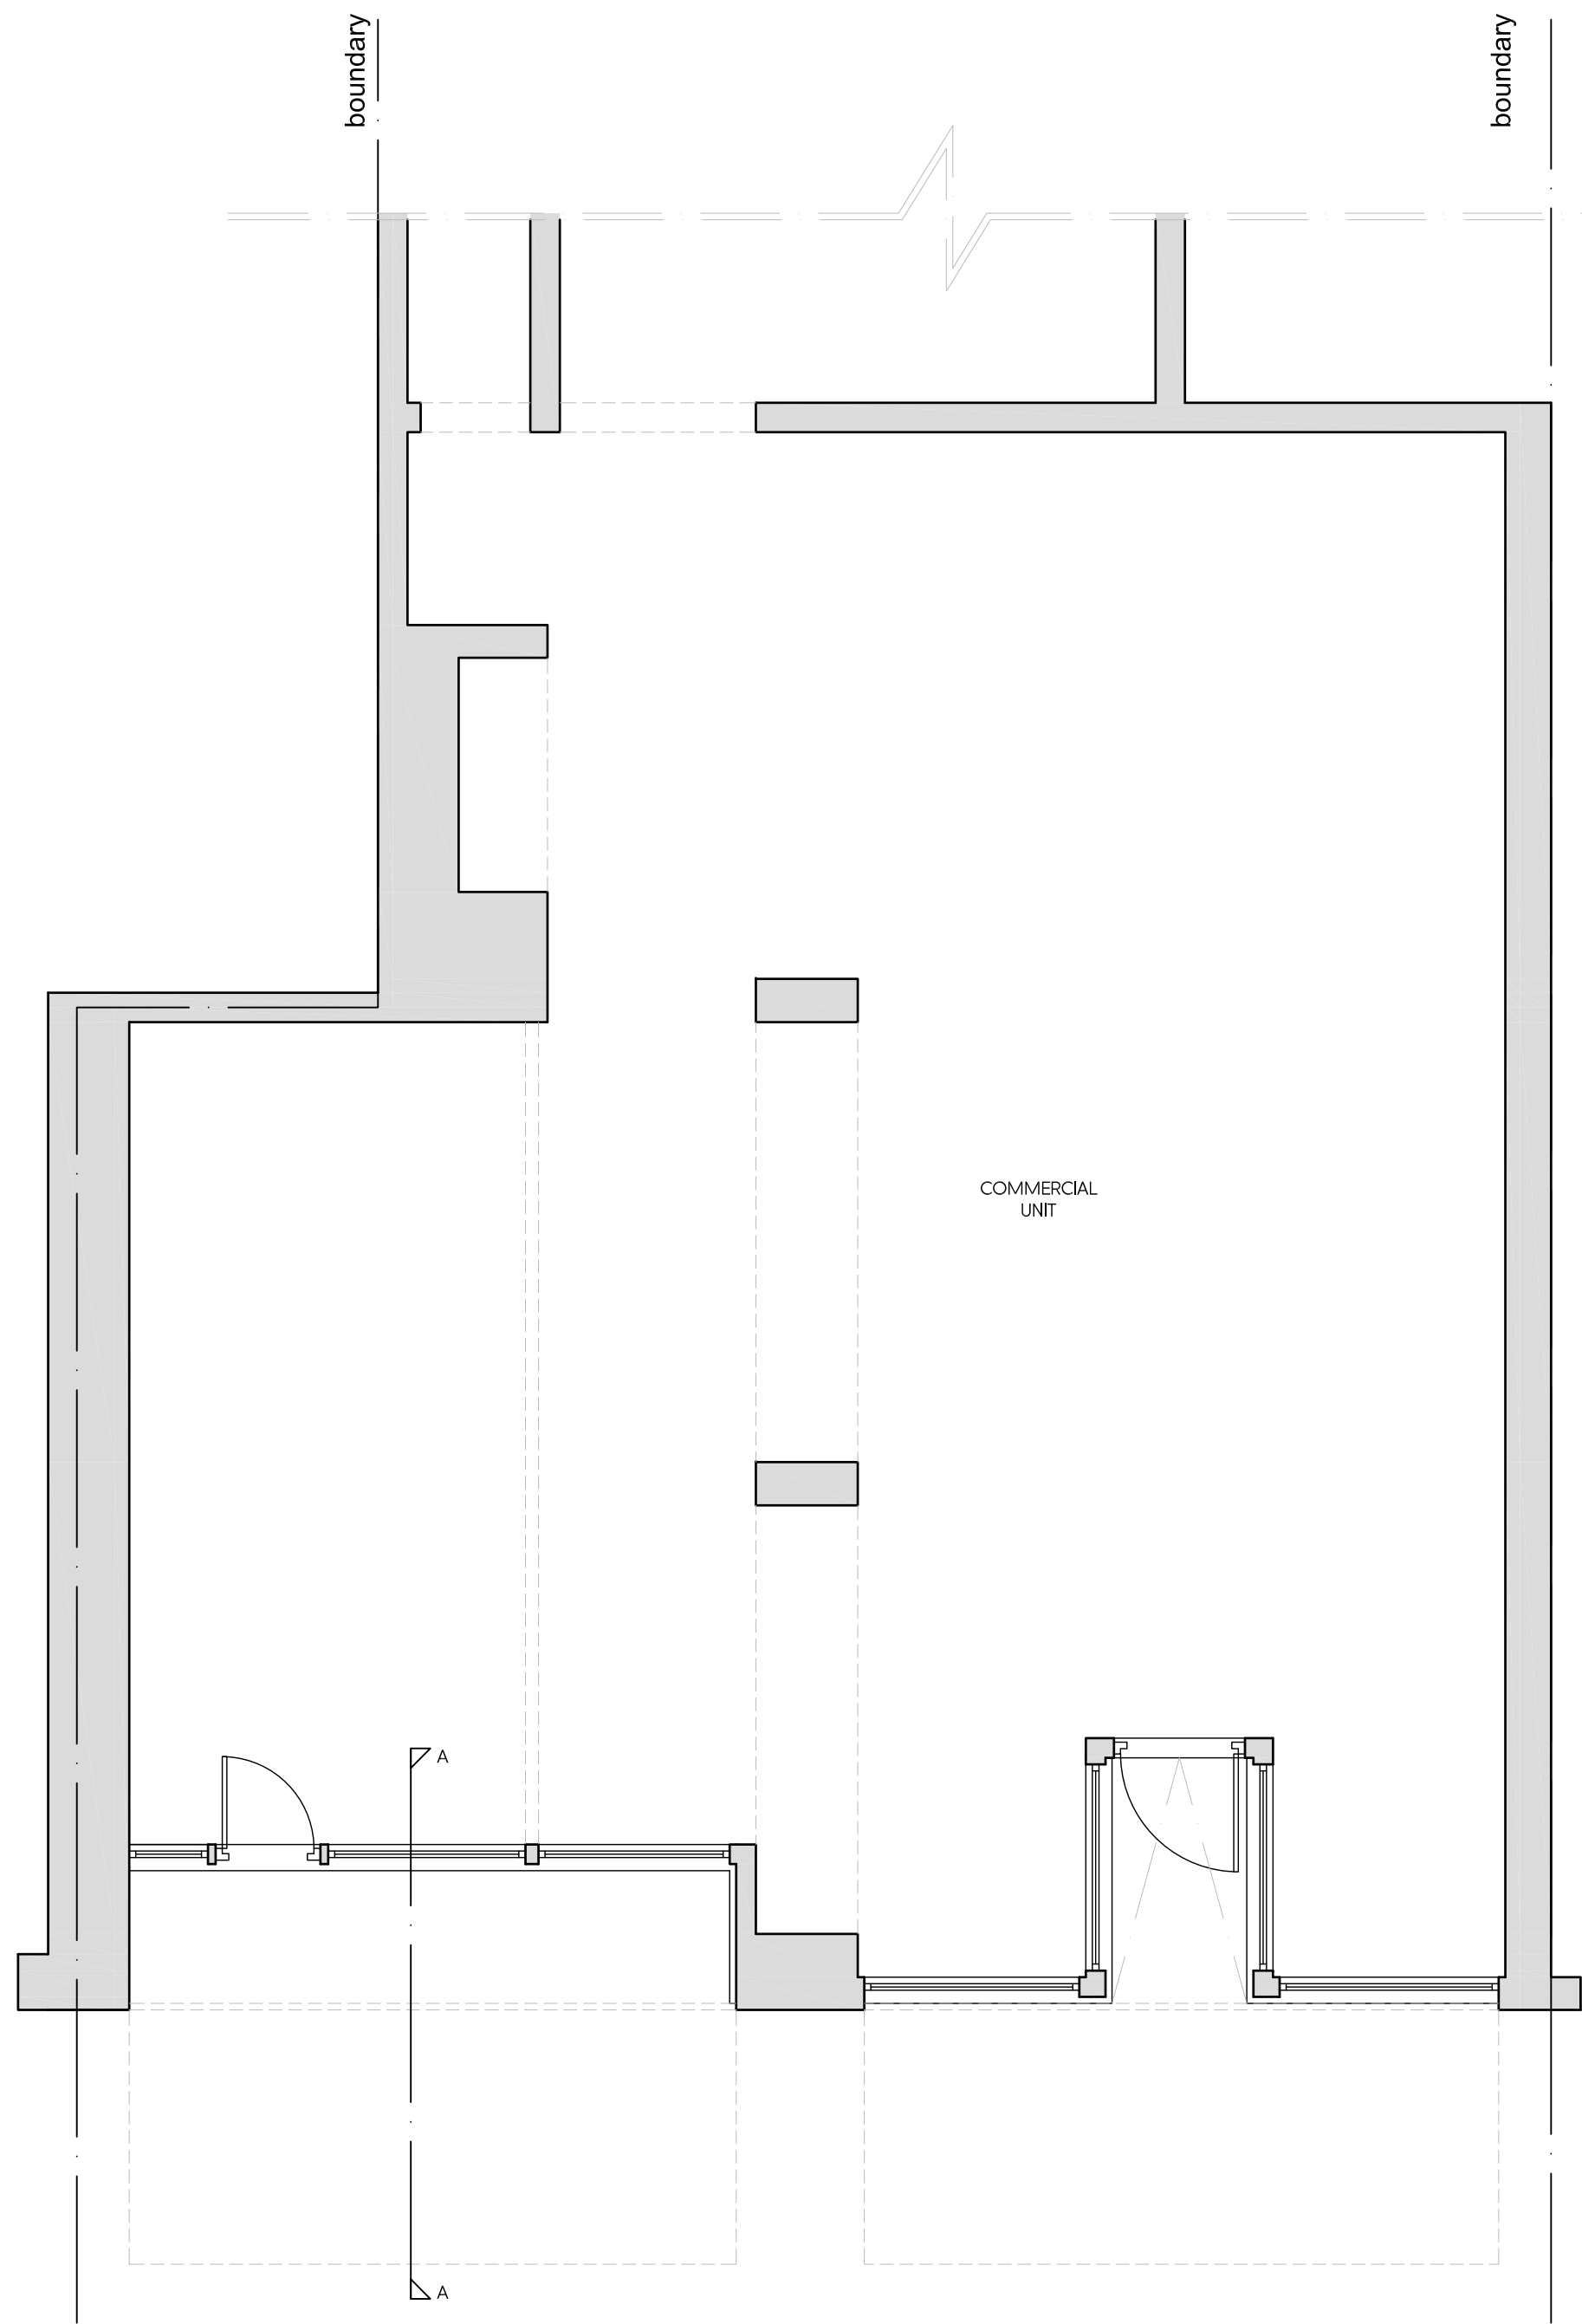
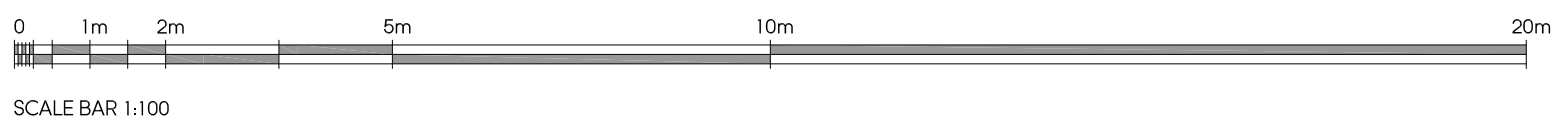


PRE-EXISTING GROUND FLOOR PLAN

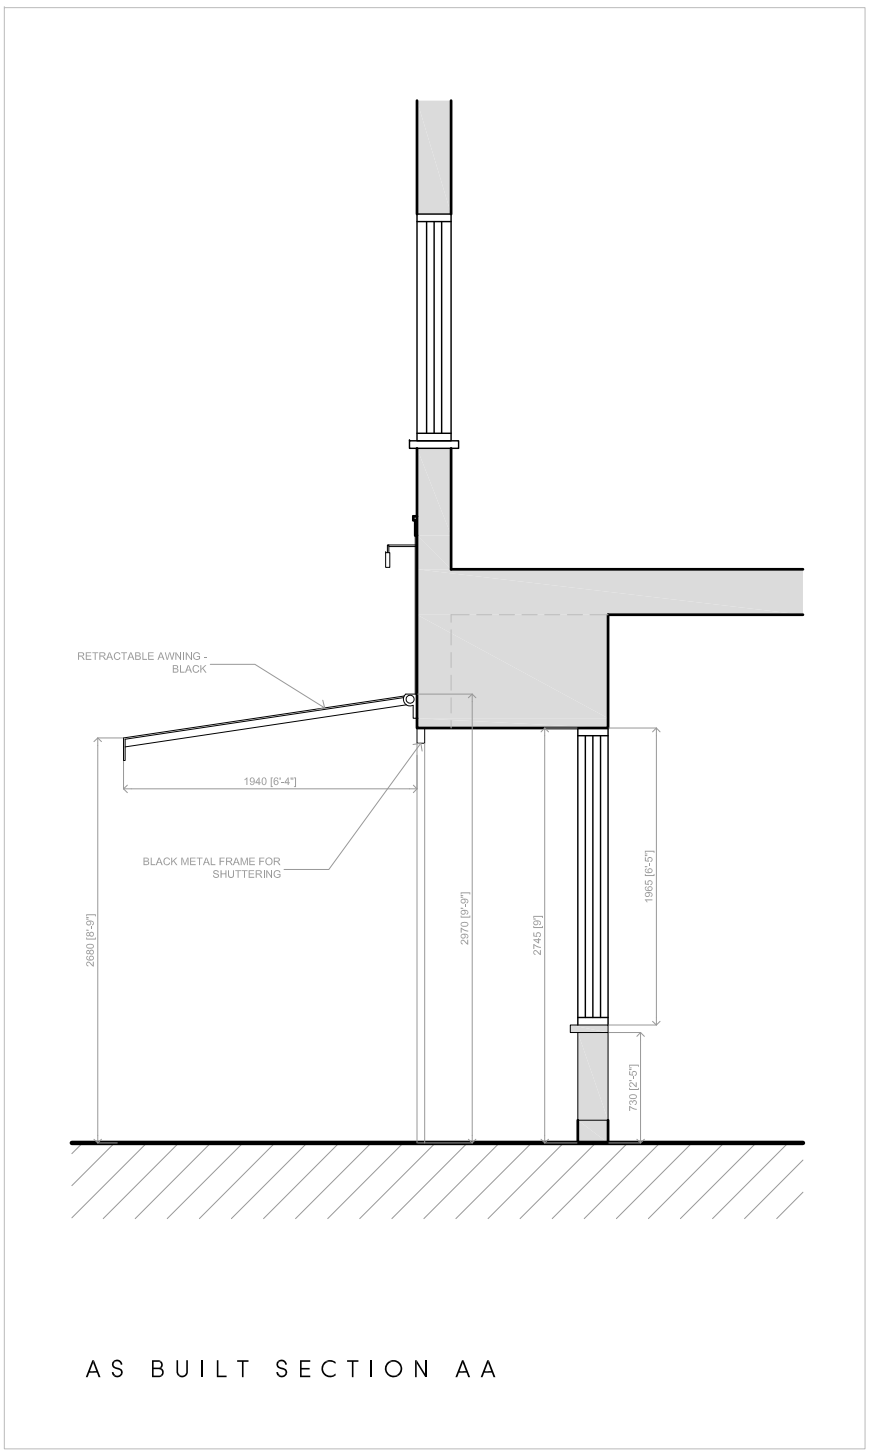

AS BUILT GROUND FLOOR PLAN

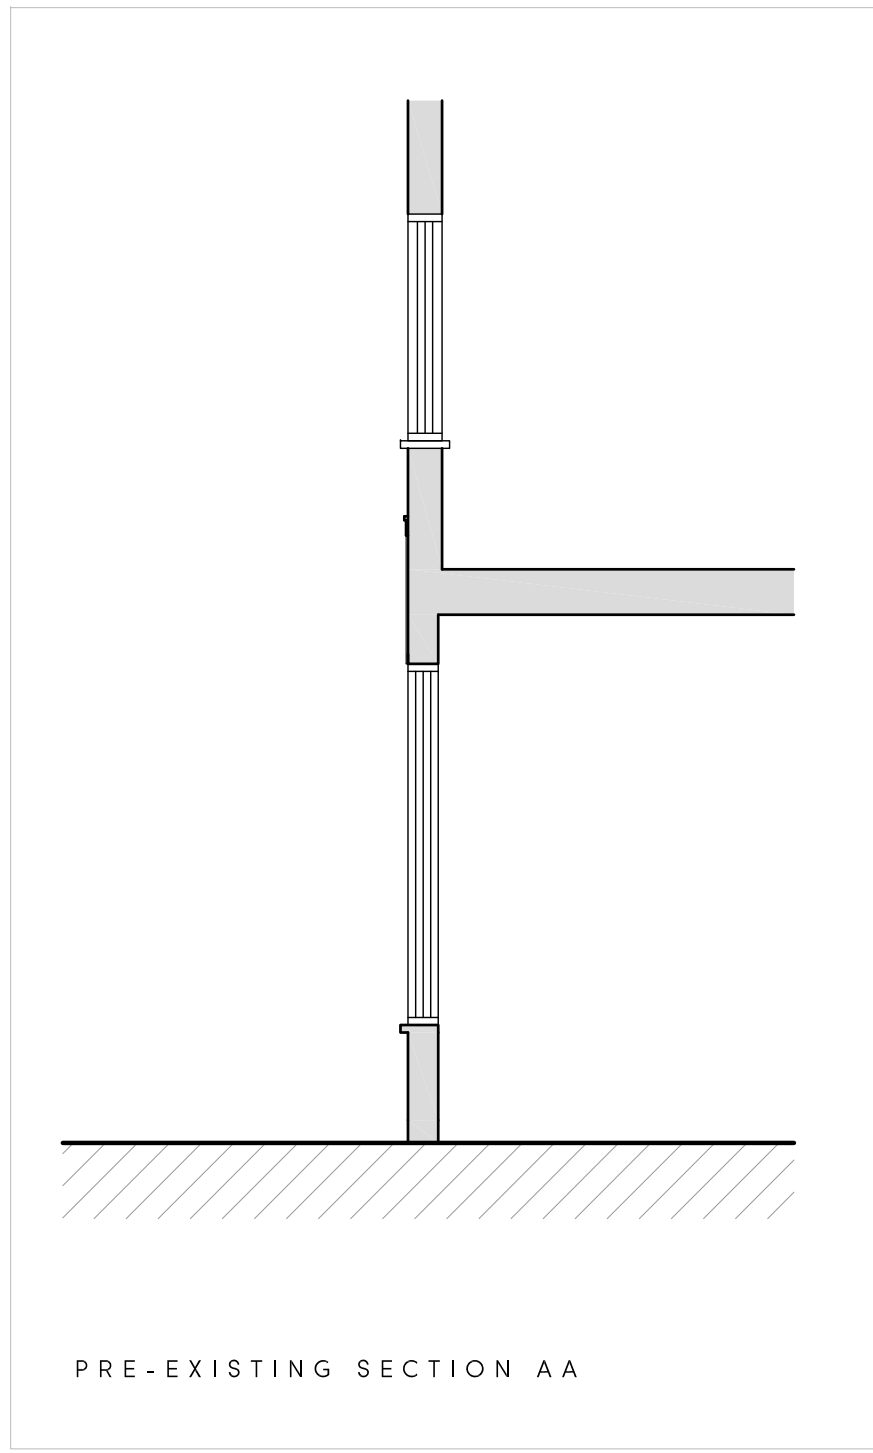

LOCATION PLAN
SCALE 1:1250



PRE-EXISTING FRONT ELEVATION



AS BUILT FRONT ELEVATION

Rev.	Date	Description	Init.
-	-	-	-

Client
MR PATEL

Project Title
ALTERATIONS TO SHOP FRONT
122-124 FIELD END ROAD, EASTCOTE, HA5 1RL
Drawing Title

PRE-EXISTING & AS BUILT PLANS, ELEVATIONS & SECTION AA		
Cad File	Sheet Size	Scale
P001	A1	1:50
Drawn by	Drawing Date	Approved by
BR	JAN 2024	-
Project No.	Drawing No.	Revision
0226	P201	-

BR ARCHITECTURE

This drawing is property of BR Architecture © and must not be copied or otherwise reproduced. All dimensions must be checked on site before commencing work. No dimensions to be scaled from this drawing. This drawing was produced using AutoCad 2010.

PLANNING ISSUE