


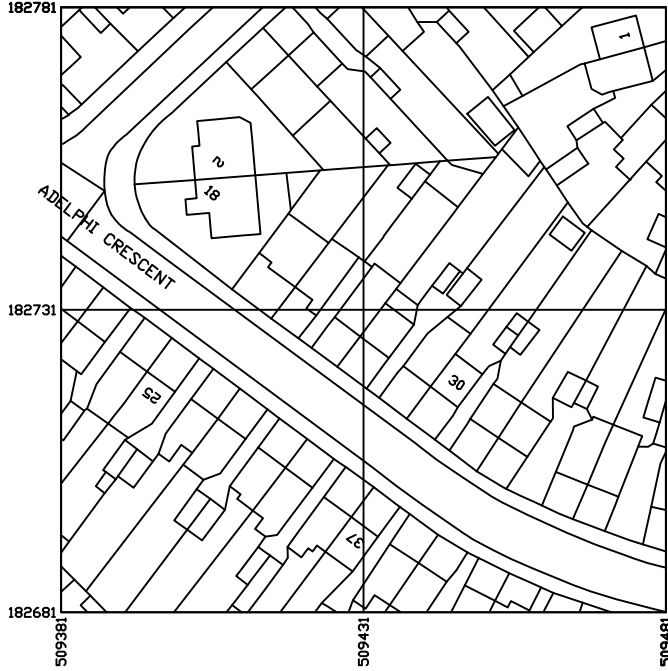

Produced on 23 July 2023 from the Ordnance Survey National Geographic Database and incorporating surveyed revision available at this date.
This map shows the area bounded by 509381 182681, 509481 182681, 509481 182781, 509381 182781, 509381 182681
Crown copyright and database rights 2023 OS 100054135. Supplied by copla ltd trading as UKPlanningMaps.com a licensed Ordnance Survey partner (OS 1000
Data licence expires 23 July 2024. Unique plan reference: vie//979767/1320591



1

Site Location Plan

SCALE: 1:1250

2

As Built Block Plan

SCALE: 1:500

Notes:

1. THIS DRAWING IS COPYRIGHTED AND IT MAY NOT BE REPRODUCED IN WHOLE OR PART OR USED FOR THE MANUFACTURE OF ANY ARTICLE WITHOUT THE EXPRESS PERMISSION OF THE COPYRIGHT HOLDERS.
2. WORK TO FIGURED DIMENSIONS ONLY.
3. THIS DRAWING IS TO BE READ IN CONJUNCTION WITH ALL RELEVANT ARCHITECT'S AND ENGINEER'S DRAWINGS AND SPECIFICATIONS.
4. ALL PROPOSED MATERIALS ARE TO MATCH THE EXISTING. BRICKWORK TO MATCH AS CLOSELY TO THE EXISTING, ROOF TILES TO MATCH EXISTING, GLAZING TO MATCH EXISTING.
5. GLAZING SHOWN ON THE BOUNDARY IS TO CONTAIN OBSCURED GLASS

REV:	DESCRIPTION:	BY:	DATE:
------	--------------	-----	-------

STATUS: Planning



CLIENT: Mr S Yadav
24 Adelphi Crescent
Hayes
UB4 8LZ

ARCHITECT: MSD Design & Build
E: msdbuilddesign@gmail.com
T: 07849966744

SITE: 24 Adelphi Crescent
Hayes

TITLE: SLP & Proposed Block Plan

SCALE AT A3: As Stated	DATE: Jul 2023	DRAWN: HD	CHECKED: HD
---------------------------	-------------------	--------------	----------------

PROJECT NO: 24AC	DRAWING NO: 24AC/001/PL	REVISION: A
---------------------	----------------------------	----------------