
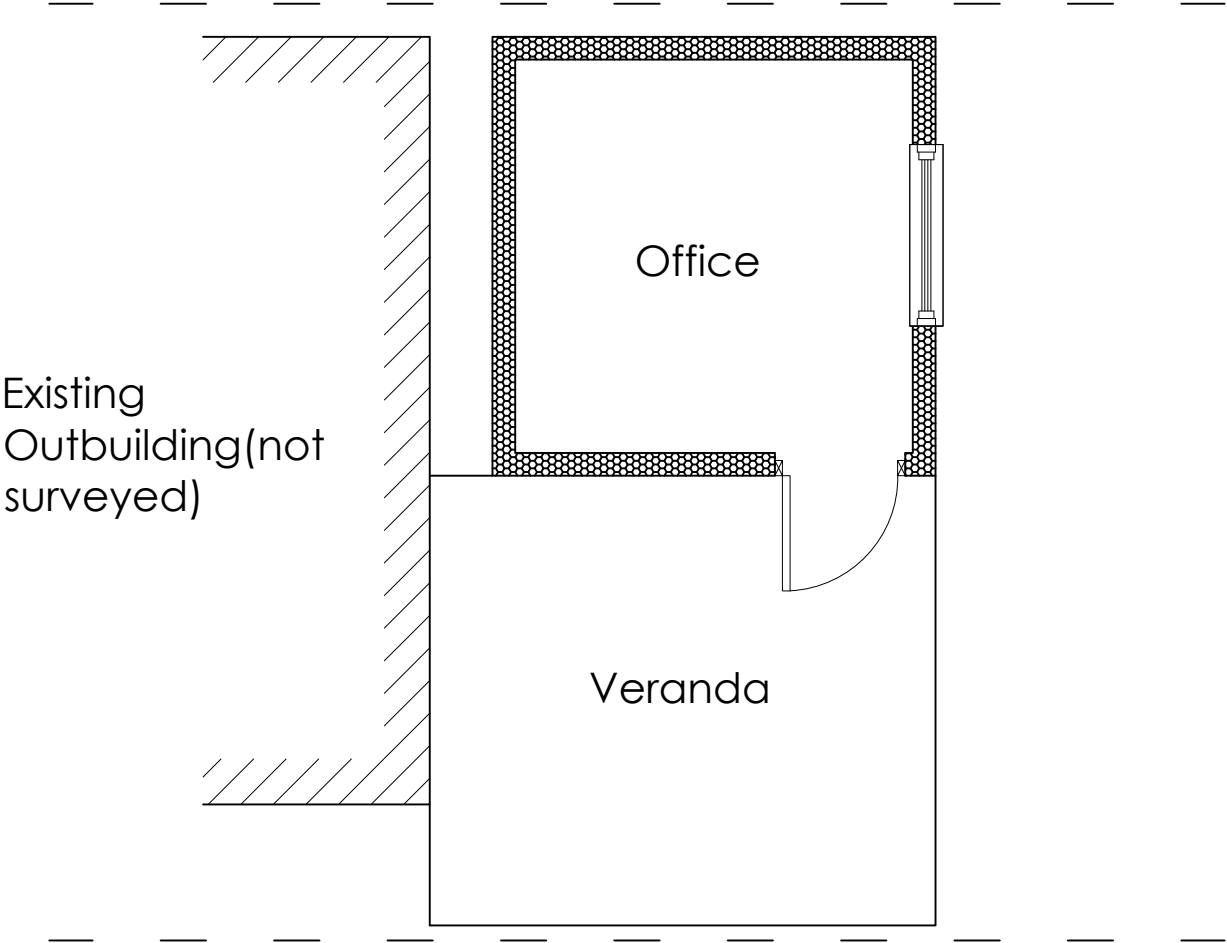


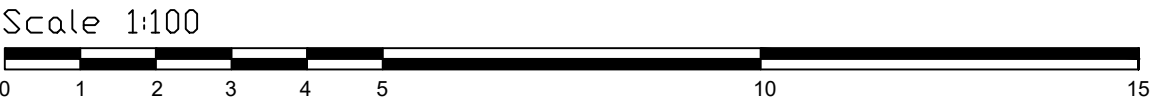

1 As Built Floor Plan

SCALE: 1:50

Notes:

- 1. THIS DRAWING IS COPYWRITTEN AND IT MAY NOT BE REPRODUCED IN WHOLE OR PART OR USED FOR THE MANUFACTURE OF ANY ARTICLE WITHOUT THE EXPRESS PERMISSION OF THE COPYRIGHT HOLDERS.
- 2. WORK TO FIGURED DIMENSIONS ONLY.
- 3. THIS DRAWING IS TO BE READ IN CONJUNCTION WITH ALL RELEVANT ARCHITECTS AND ENGINEER'S DRAWINGS AND SPECIFICATIONS.
- 4. ALL PROPOSED MATERIALS ARE TO MATCH THE EXISTING. BRICKWORK TO MATCH AS CLOSELY TO THE EXISTING, ROOF TILES TO MATCH EXISTING, GLAZING TO MATCH EXISTING.
- 5. GLAZING SHOWN ON THE BOUNDARY IS TO CONTAIN OBSCURED GLASS

REV:	DESCRIPTION:	BY:	DATE:
------	--------------	-----	-------

STATUS: Planning



CLIENT: Mr S Yadav
24 Adelphi Crescent
Hayes
UB4 8LZ

ARCHITECT: MSD Design & Build
E: msdbuilddesign@gmail.com
T: 07849966744

SITE: 24 Adelphi Crescent
Hayes

TITLE: As Built Floor Plans

SCALE AT A3: 1:100	DATE: Nov 2025	DRAWN: HD	CHECKED: HD
PROJECT NO: 24AC	DRAWING NO: 24AC/002/PL	REVISION: A	