



Scale 1:50

0 1 2 3 4 5

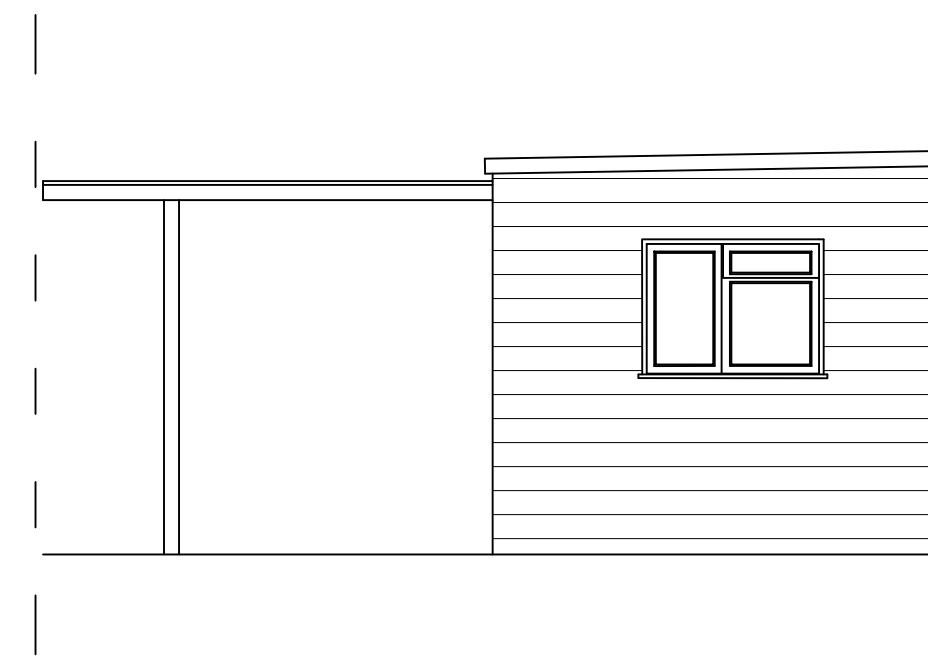


1 As Built Side Elevation

SCALE: 1:50

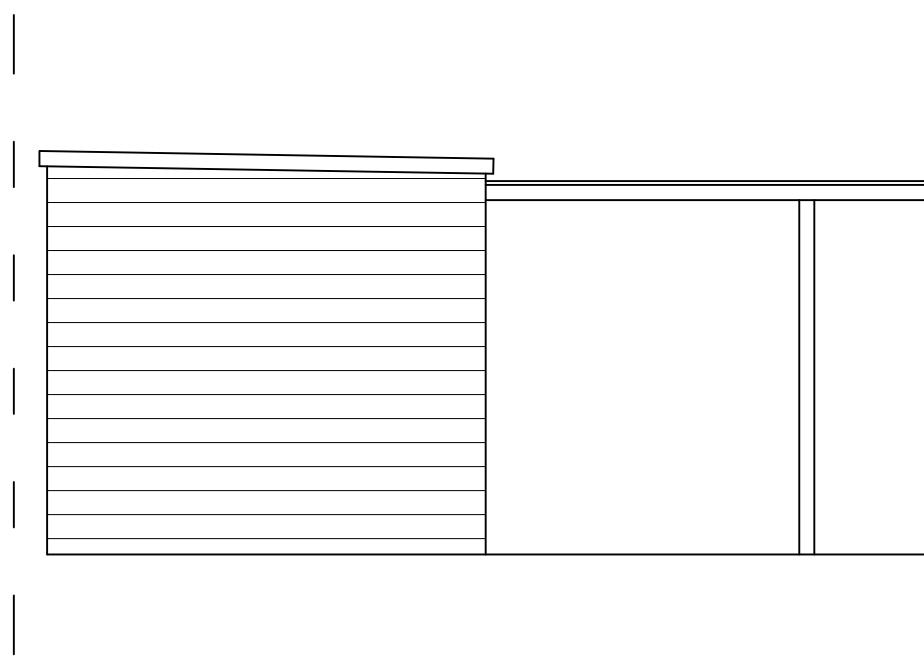


1 As Built Side Elevation

SCALE: 1:50

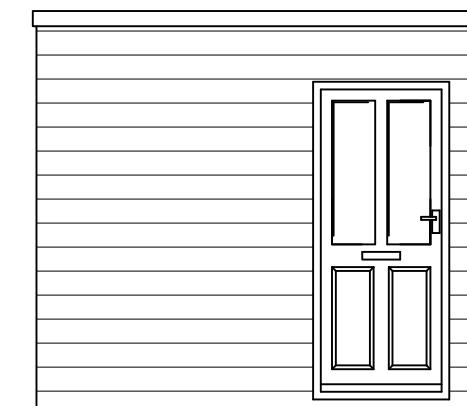

1 As Built Front Elevation

SCALE: 1:50

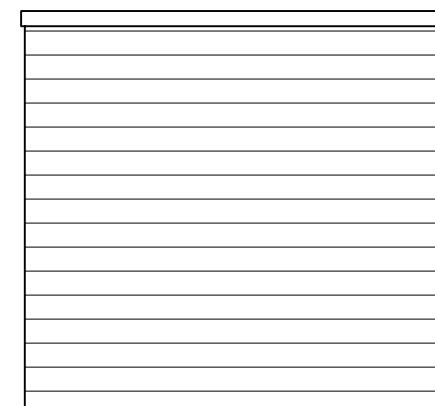

1 As Built Rear Elevation

SCALE: 1:50

Notes:

1. THIS DRAWING IS COPYRIGHTED AND IT MAY NOT BE REPRODUCED IN WHOLE OR PART OR USED FOR THE MANUFACTURE OF ANY ARTICLE WITHOUT THE EXPRESS PERMISSION OF THE COPYRIGHT HOLDERS.
2. WORK TO FIGURED DIMENSIONS ONLY.
3. THIS DRAWING IS TO BE READ IN CONJUNCTION WITH ALL RELEVANT ARCHITECTS AND ENGINEER'S DRAWINGS AND SPECIFICATIONS.
4. ALL PROPOSED MATERIALS ARE TO MATCH THE EXISTING. BRICKWORK TO MATCH AS CLOSELY TO THE EXISTING, ROOF TILES TO MATCH EXISTING, GLAZING TO MATCH EXISTING.
5. GLAZING SHOWN ON THE BOUNDARY IS TO CONTAIN OBSCURED GLASS

REV: DESCRIPTION: BY: DATE:
STATUS: Planning



MSD Design + Build

CLIENT: Mr S Yadav
24 Adelphi Crescent
Hayes
UB4 8LZ

ARCHITECT: MSD Design & Build
E: msdbuilddesign@gmail.com
T: 07849966744

SITE: 24 Adelphi Crescent
Hayes

TITLE: As built Elevations

SCALE AT A3: DATE: DRAWN: CHECKED:
1:50 Nov 2025 HD HD

PROJECT NO: DRAWING NO: REVISION:
24AC 24AC/003/PL A